




359+50

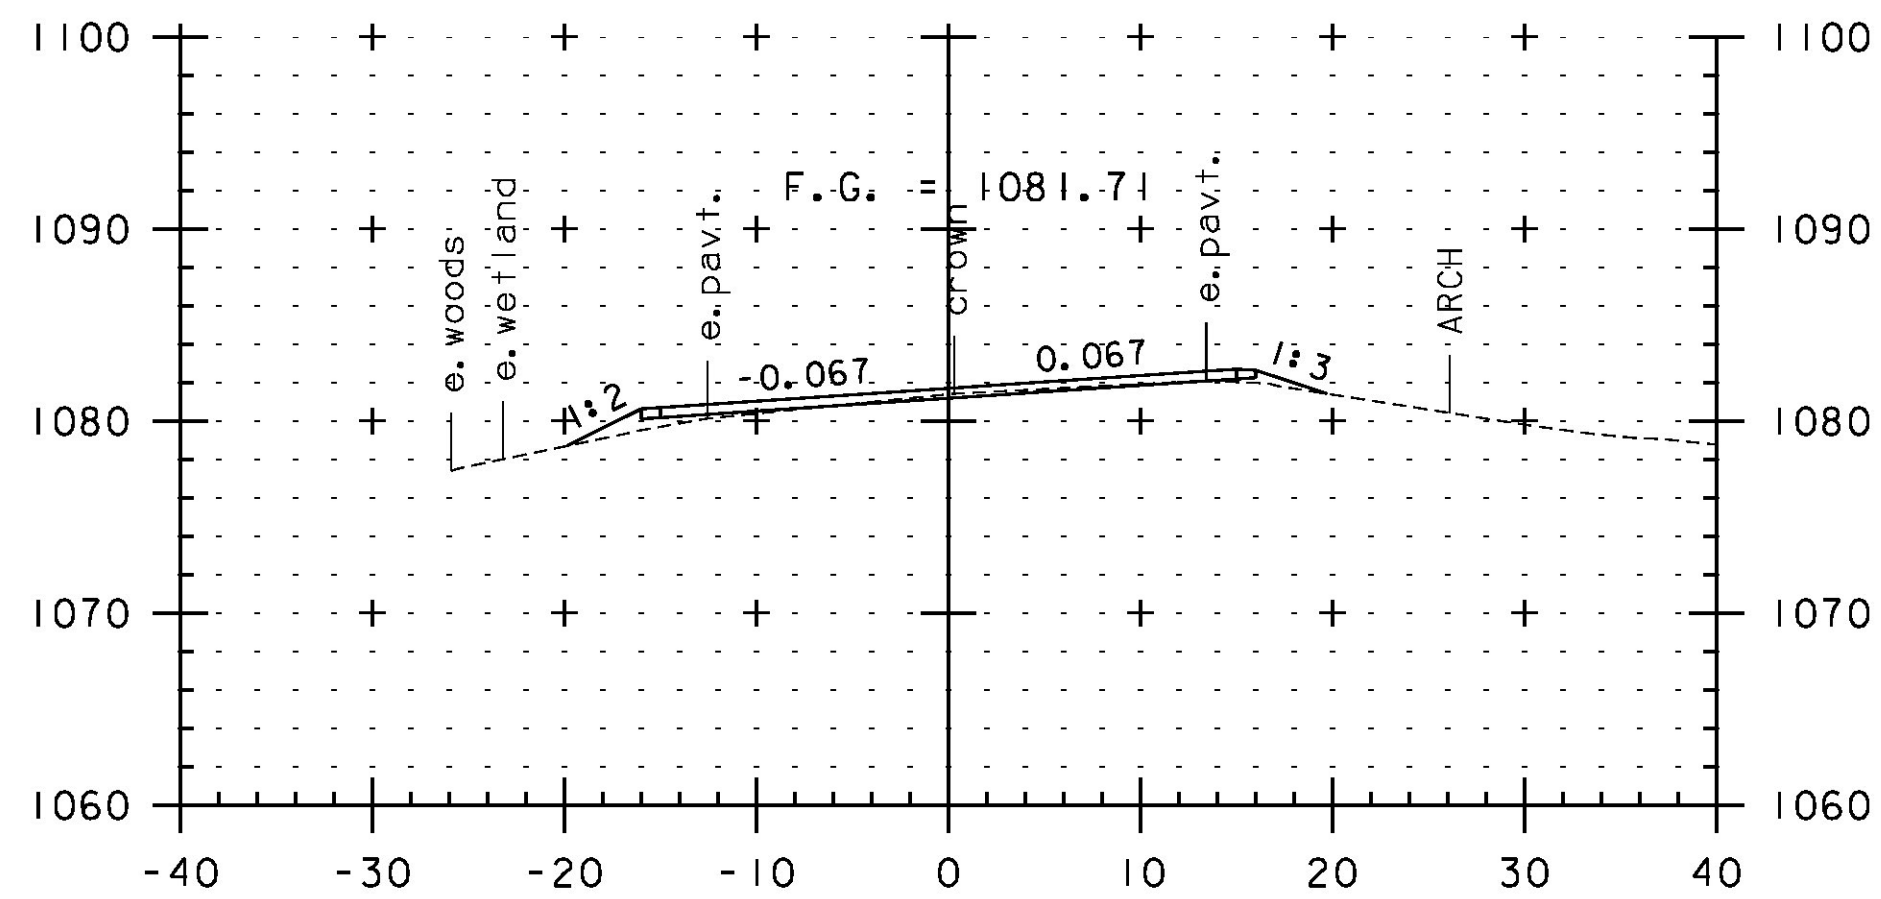


361+00

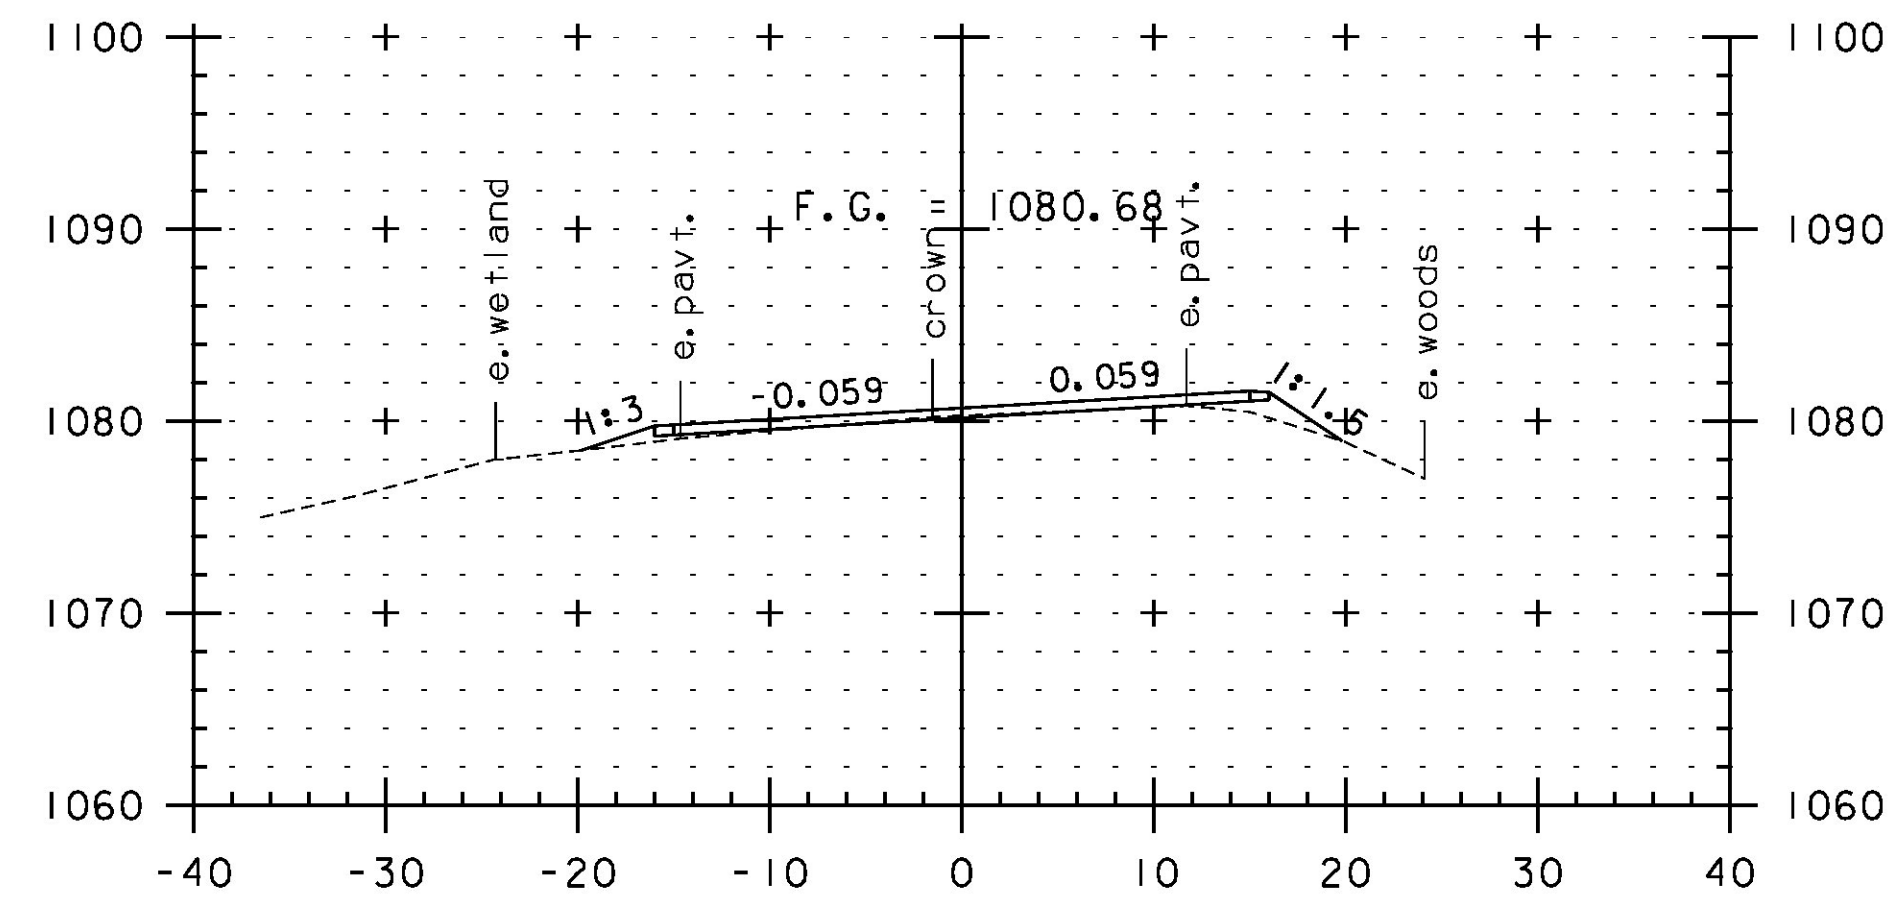


362+50

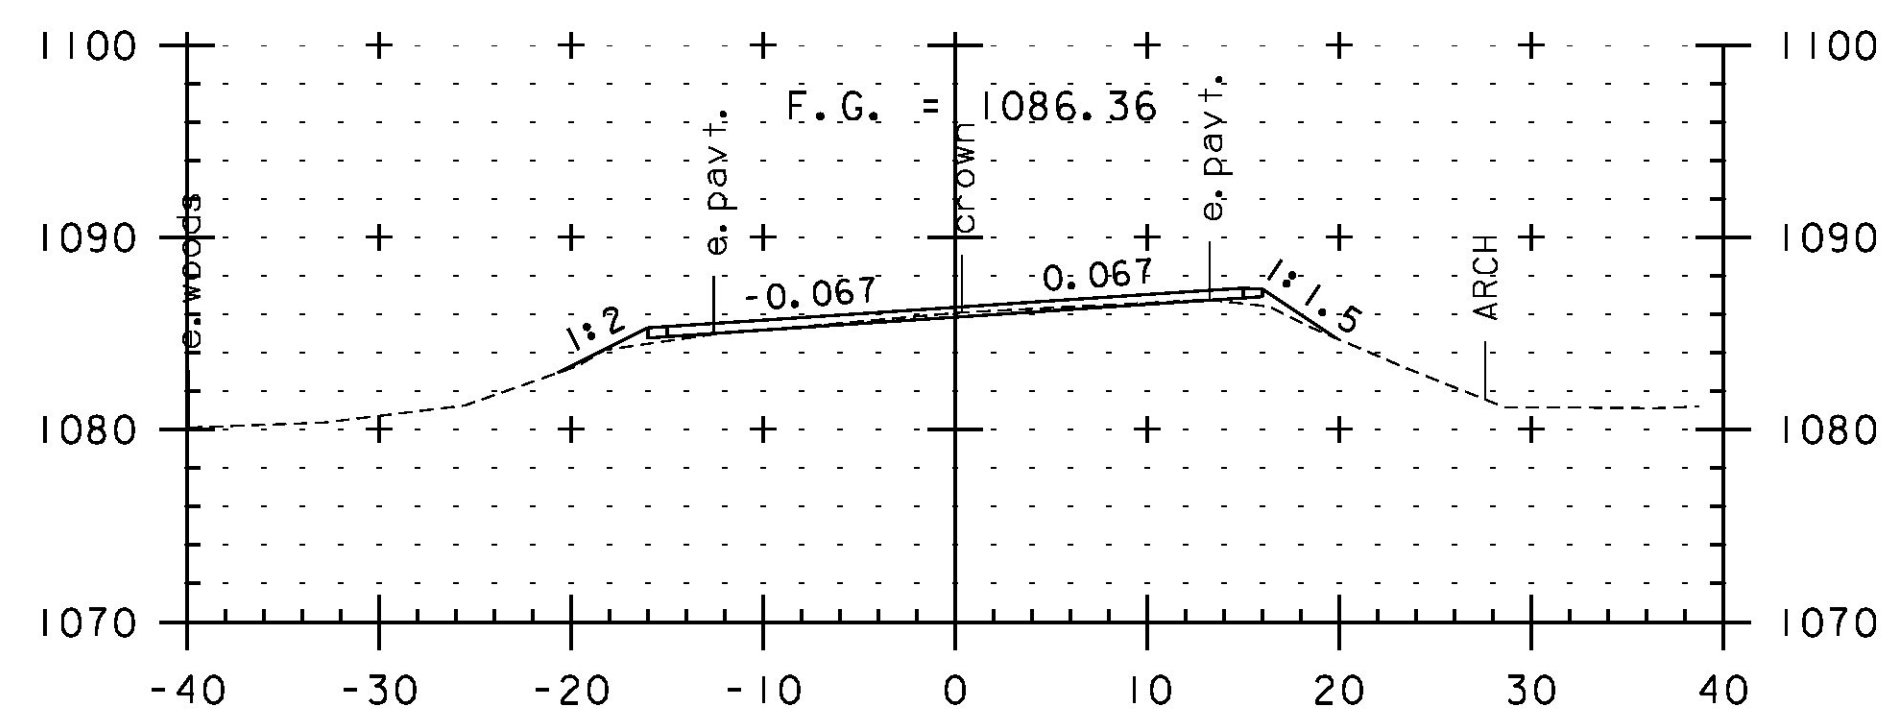


359+00

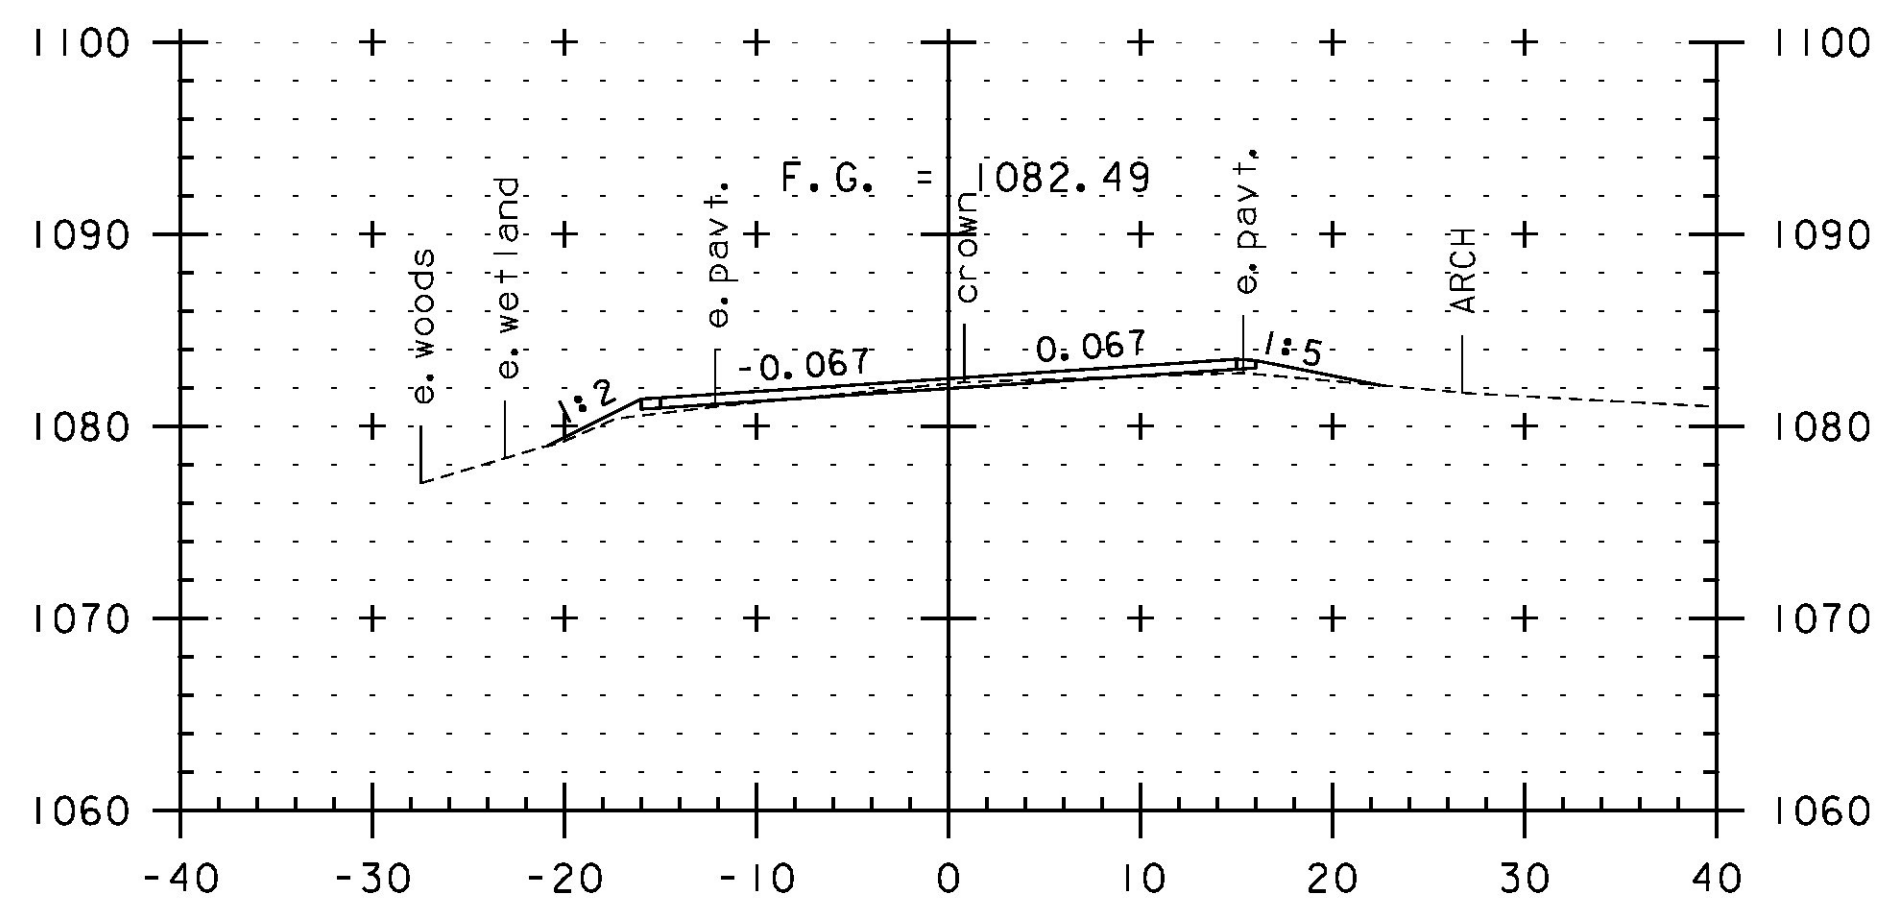


360+50

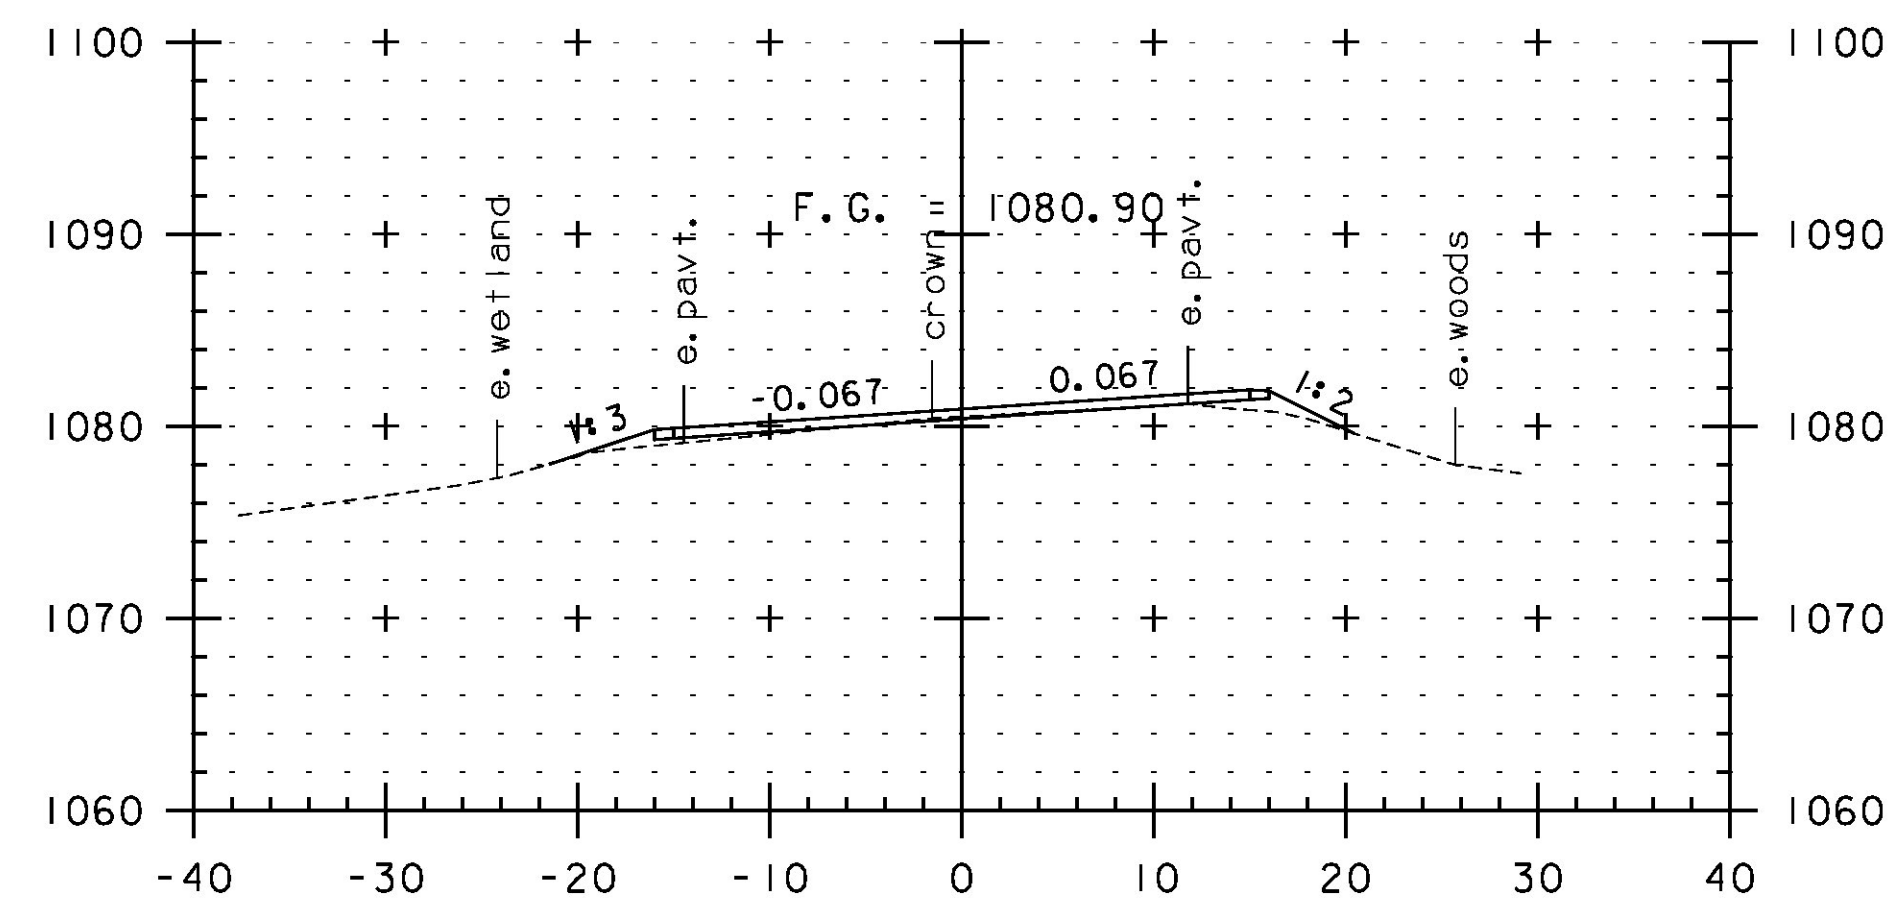


362+00

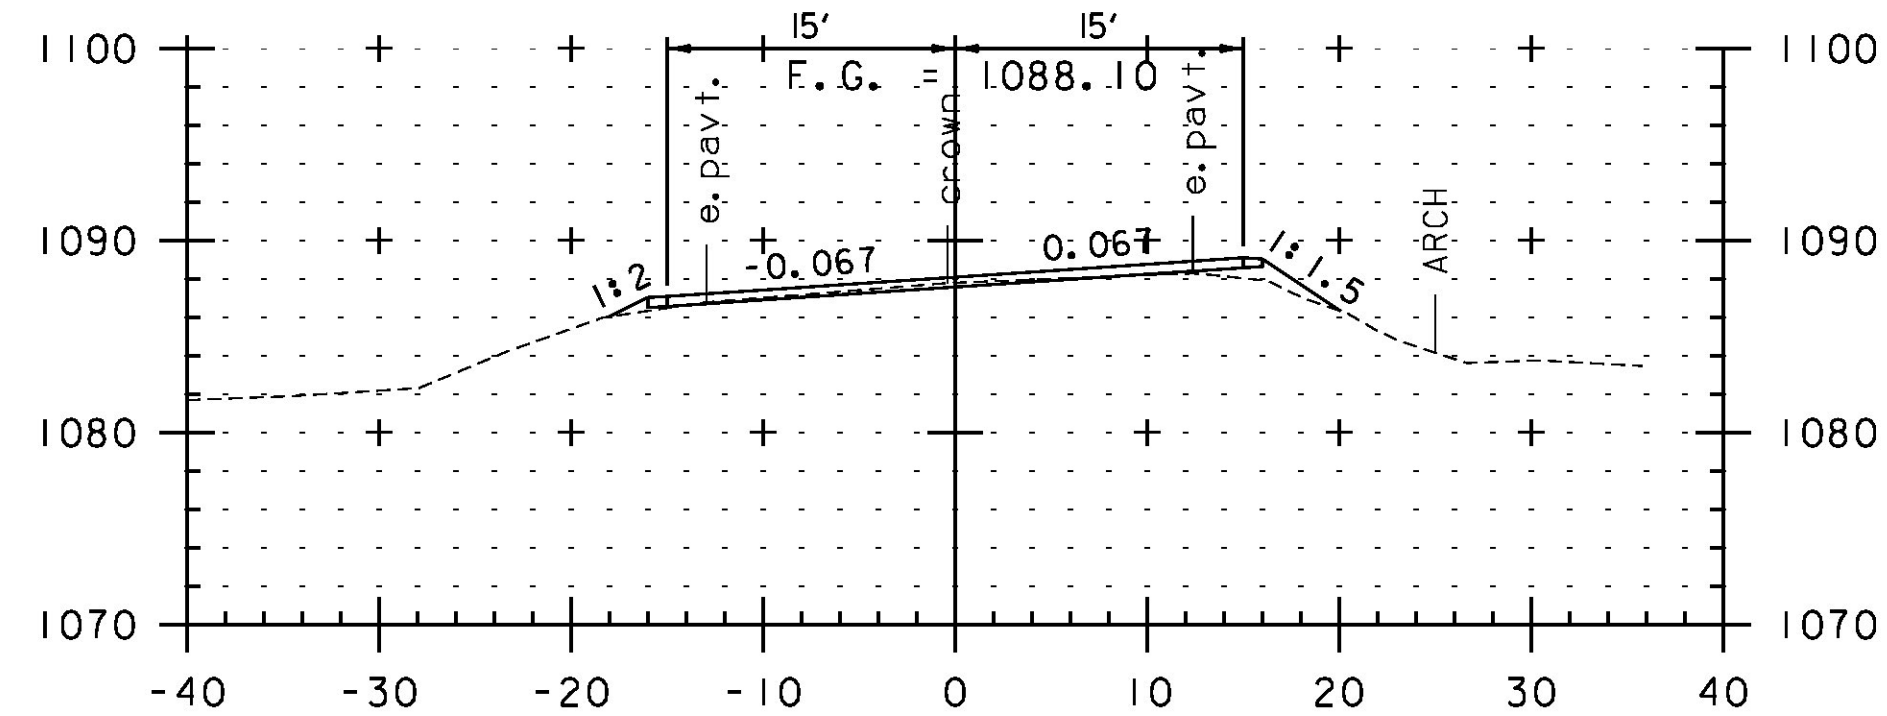

358+50

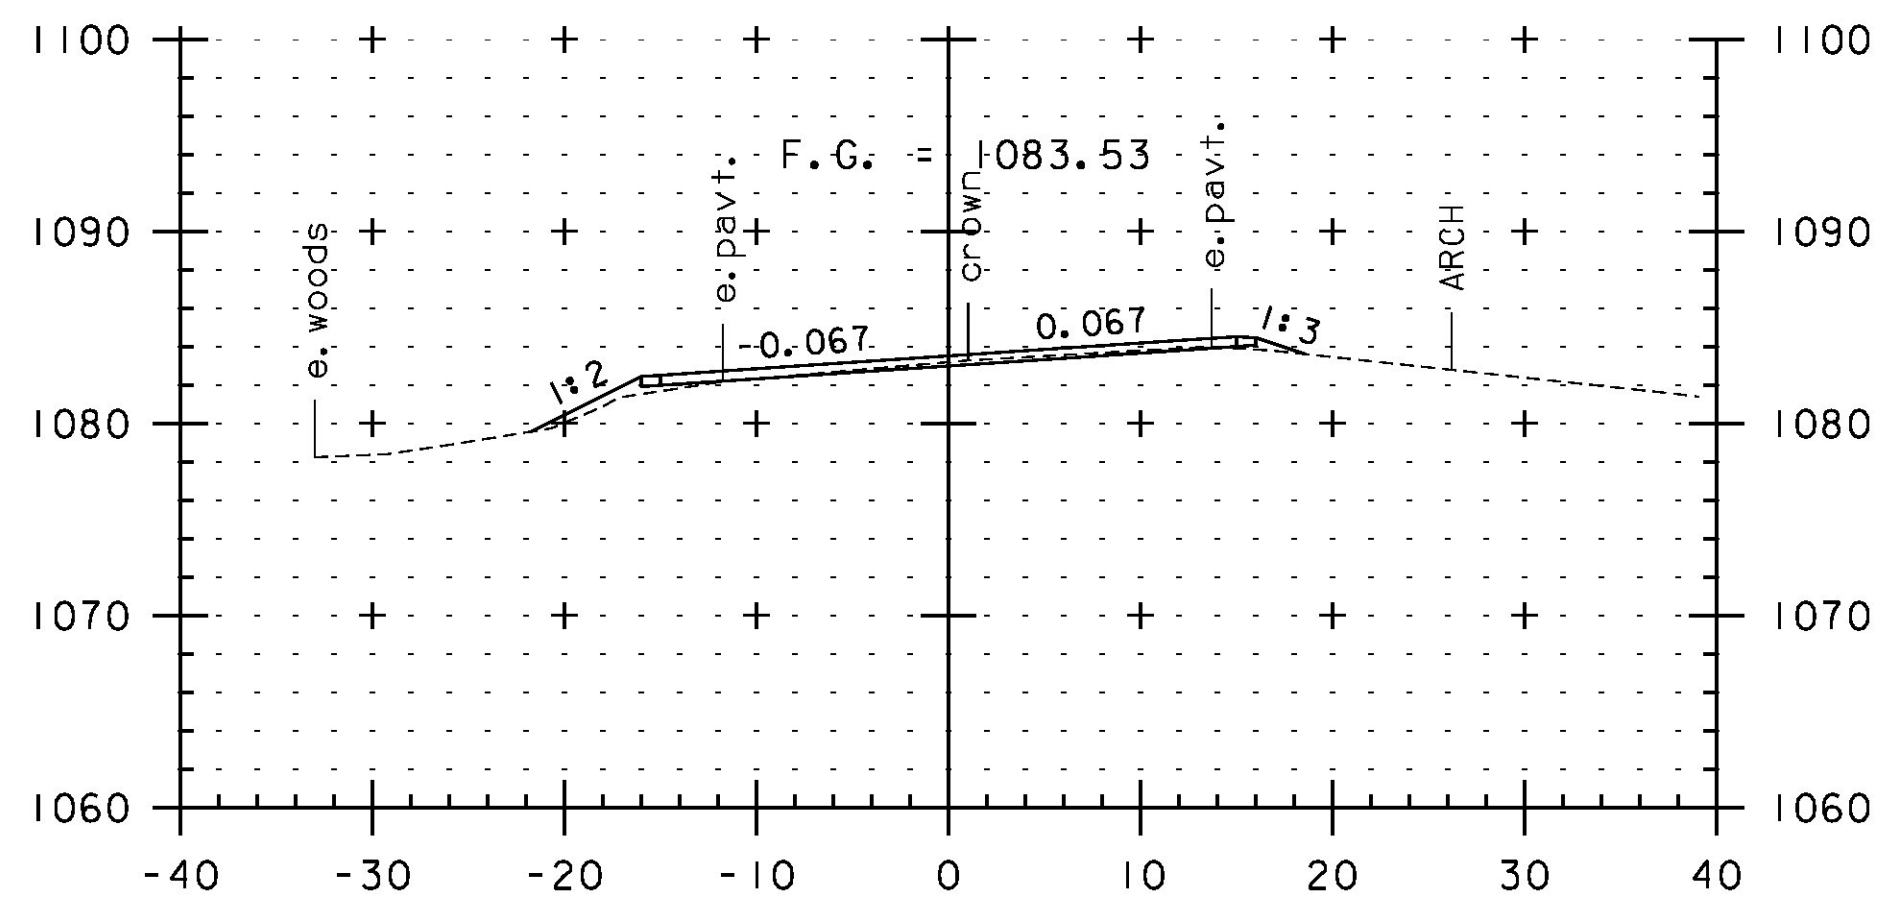

360+00

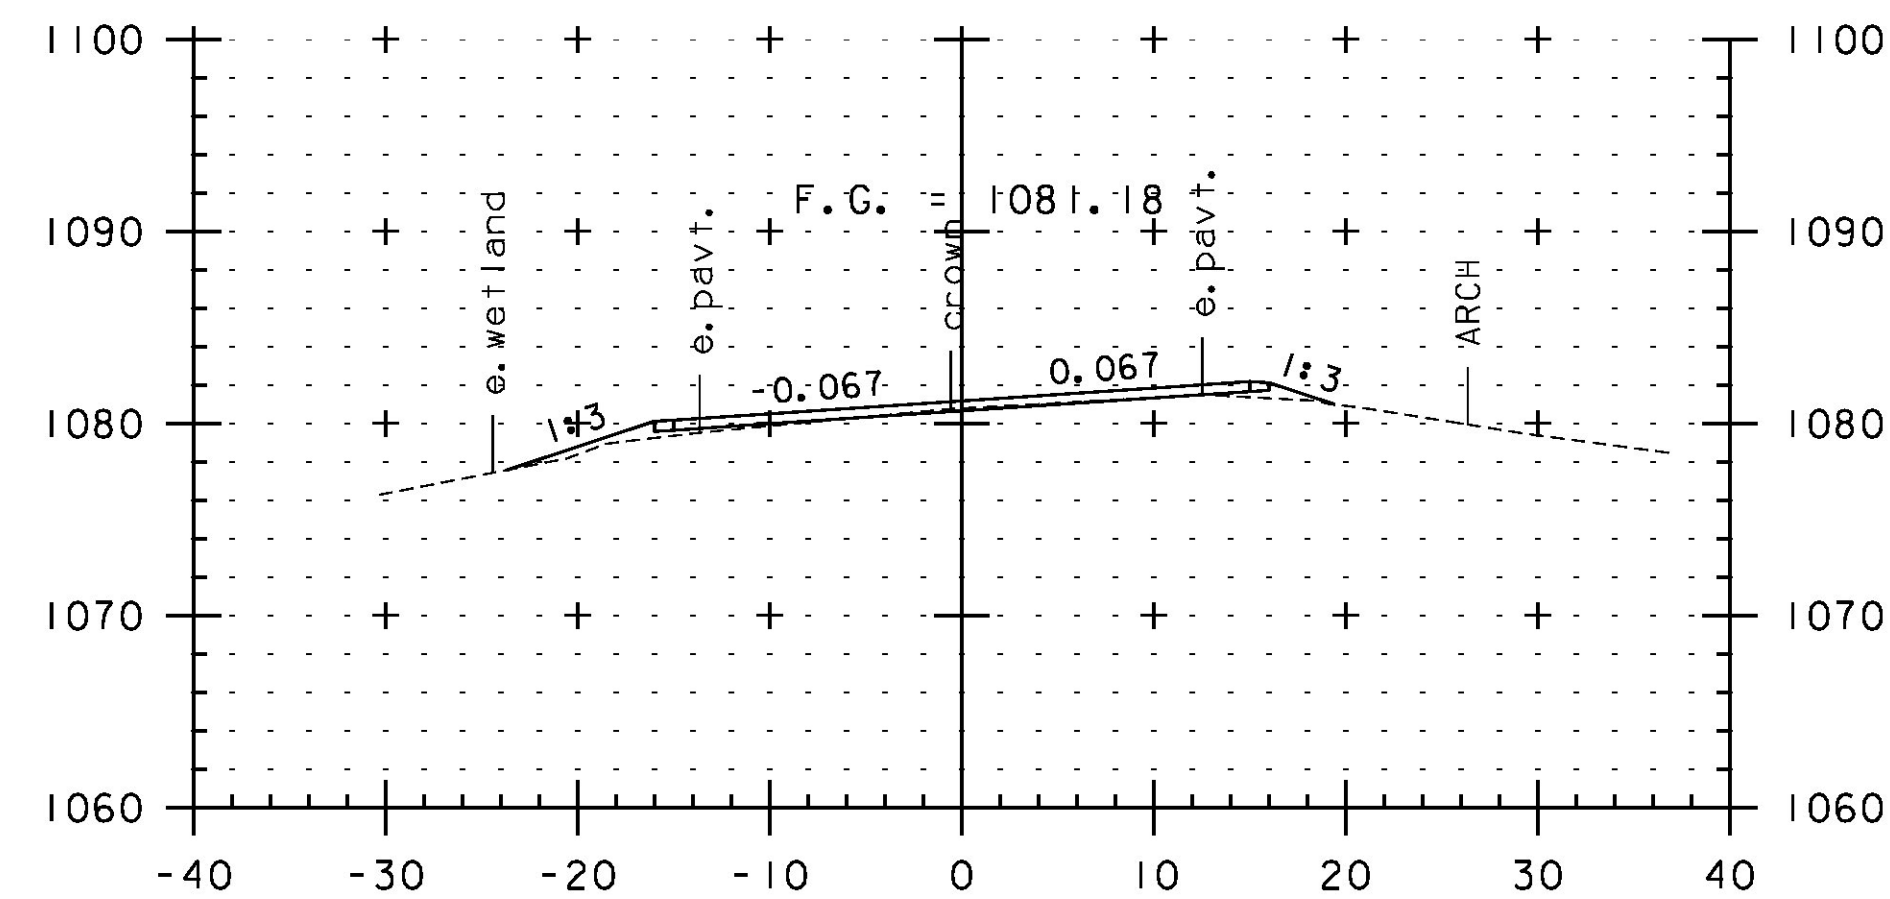

361+50



SCALE IN FEET

STA. 358+50 TO STA. 362+50

PROJECT NAME: JAY-TROY  
PROJECT NUMBER: STP 2315(I)

FILE NAME: z10b232xs.dgn  
PROJECT LEADER: P. SHEDD  
DESIGNED BY: N. LEMAY  
CROSS SECTION SHEET 82

PLOT DATE: 5/16/2014  
DRAWN BY: W. GORDON  
CHECKED BY: P. SHEDD  
SHEET 218 OF 244