




364+00

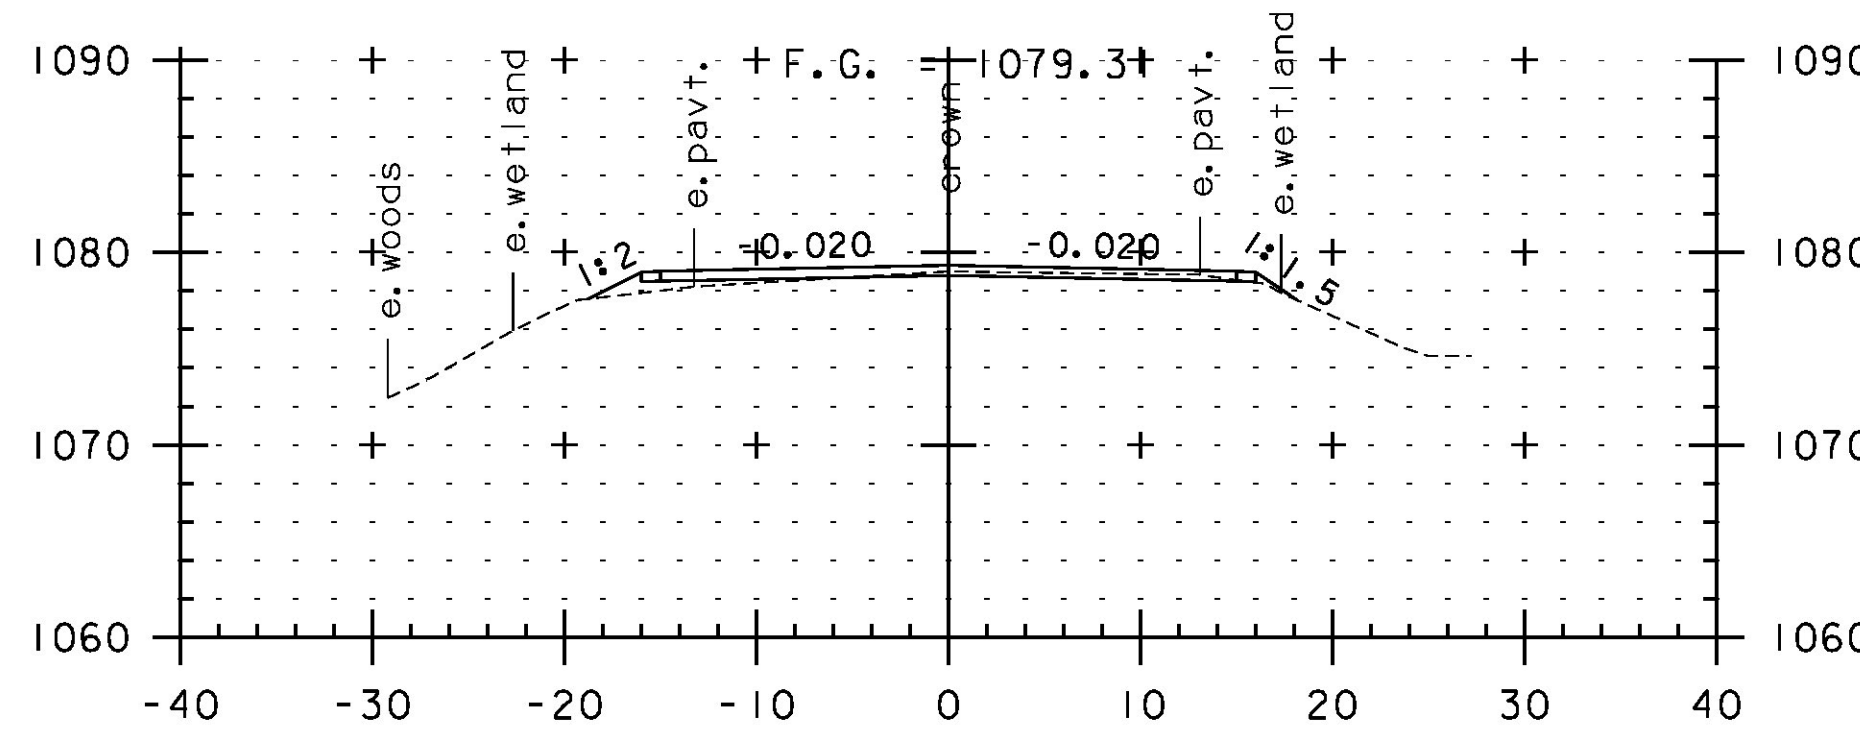


365+50

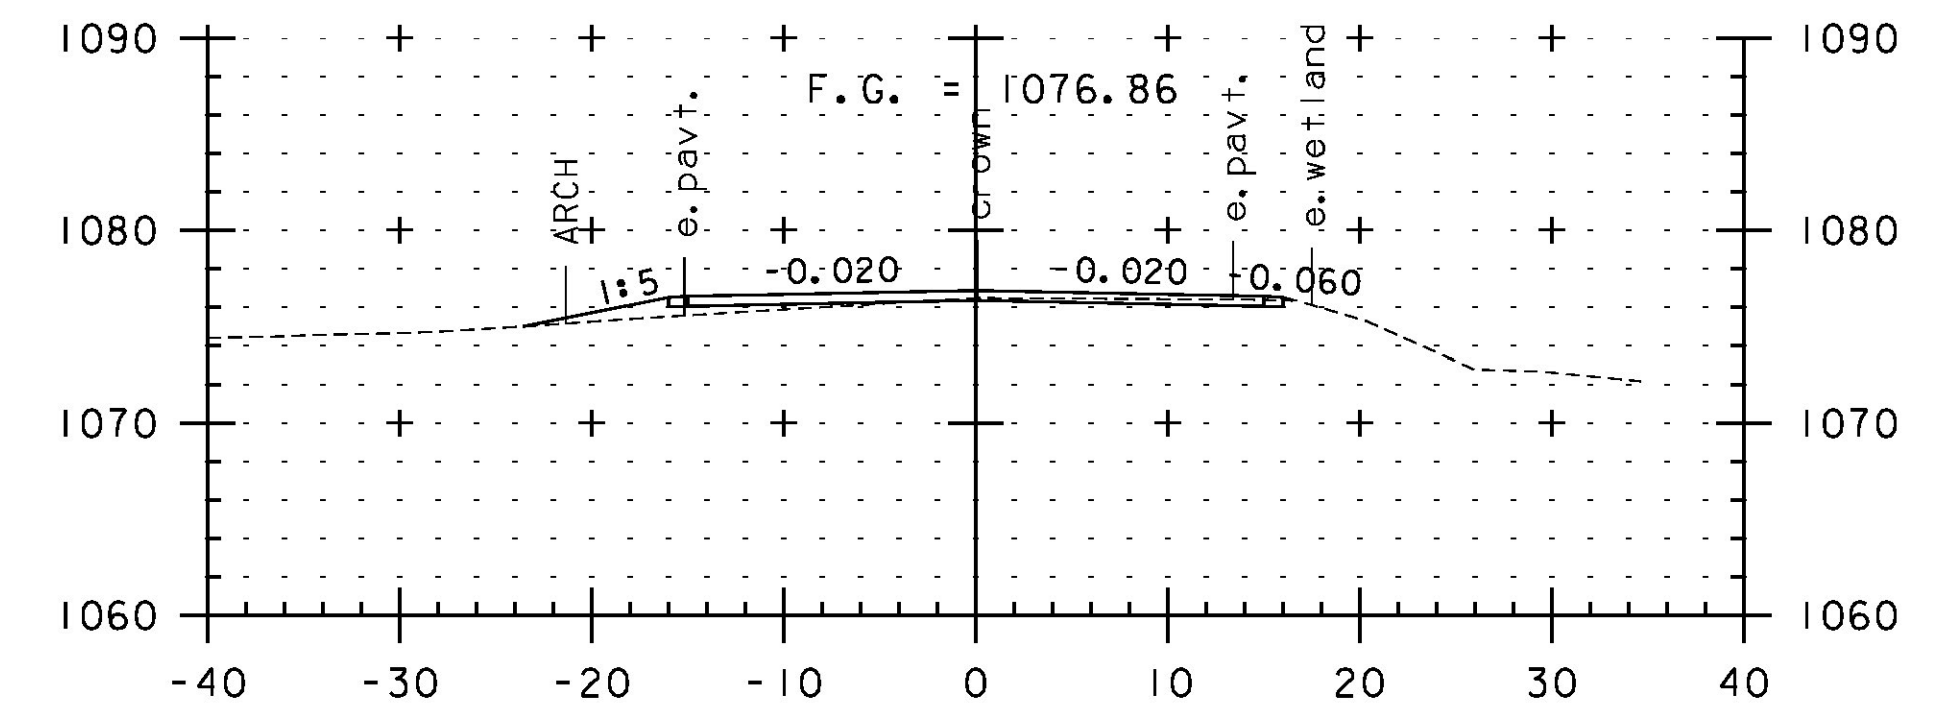


367+00

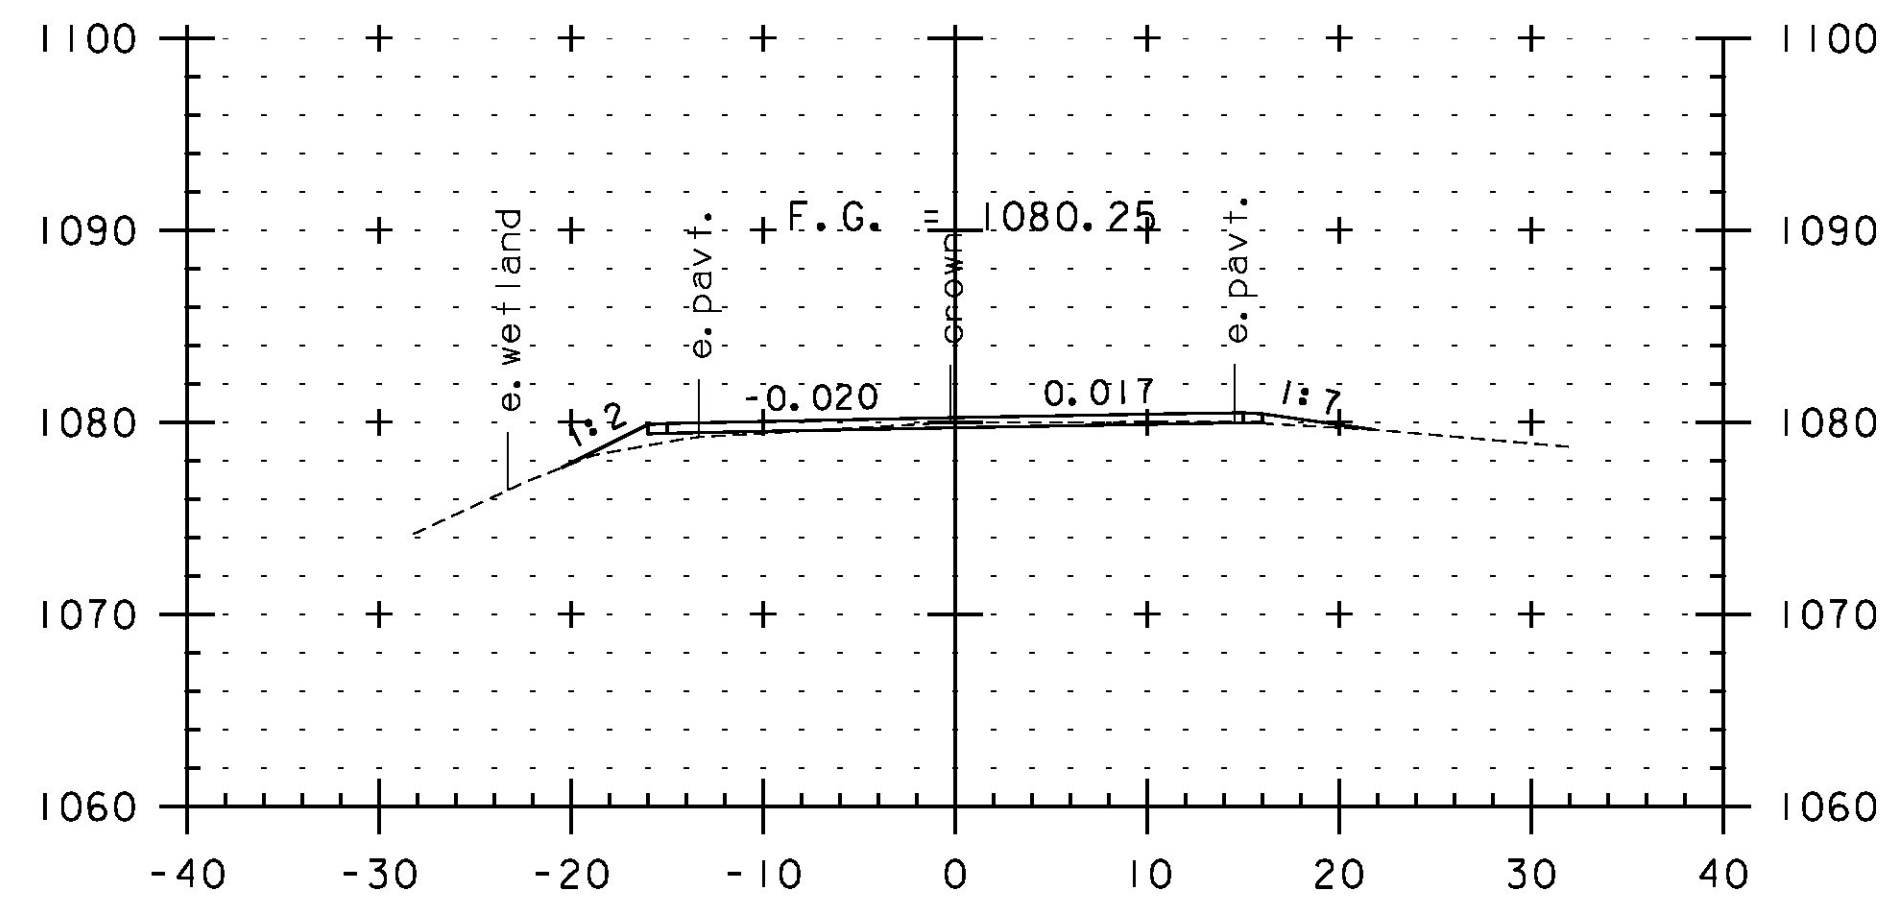


363+50

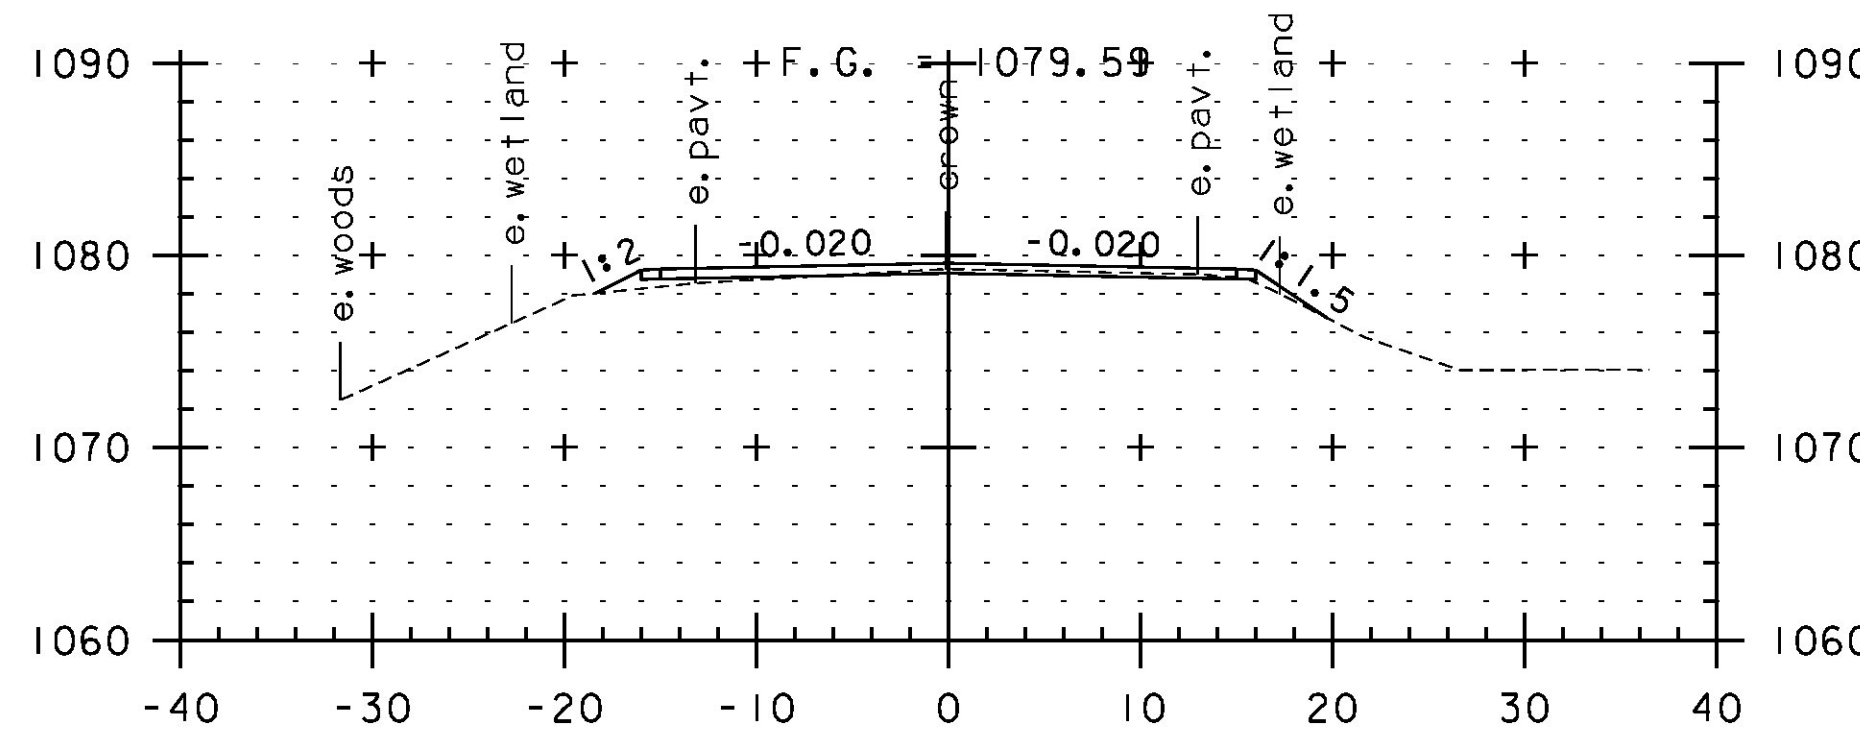


365+00

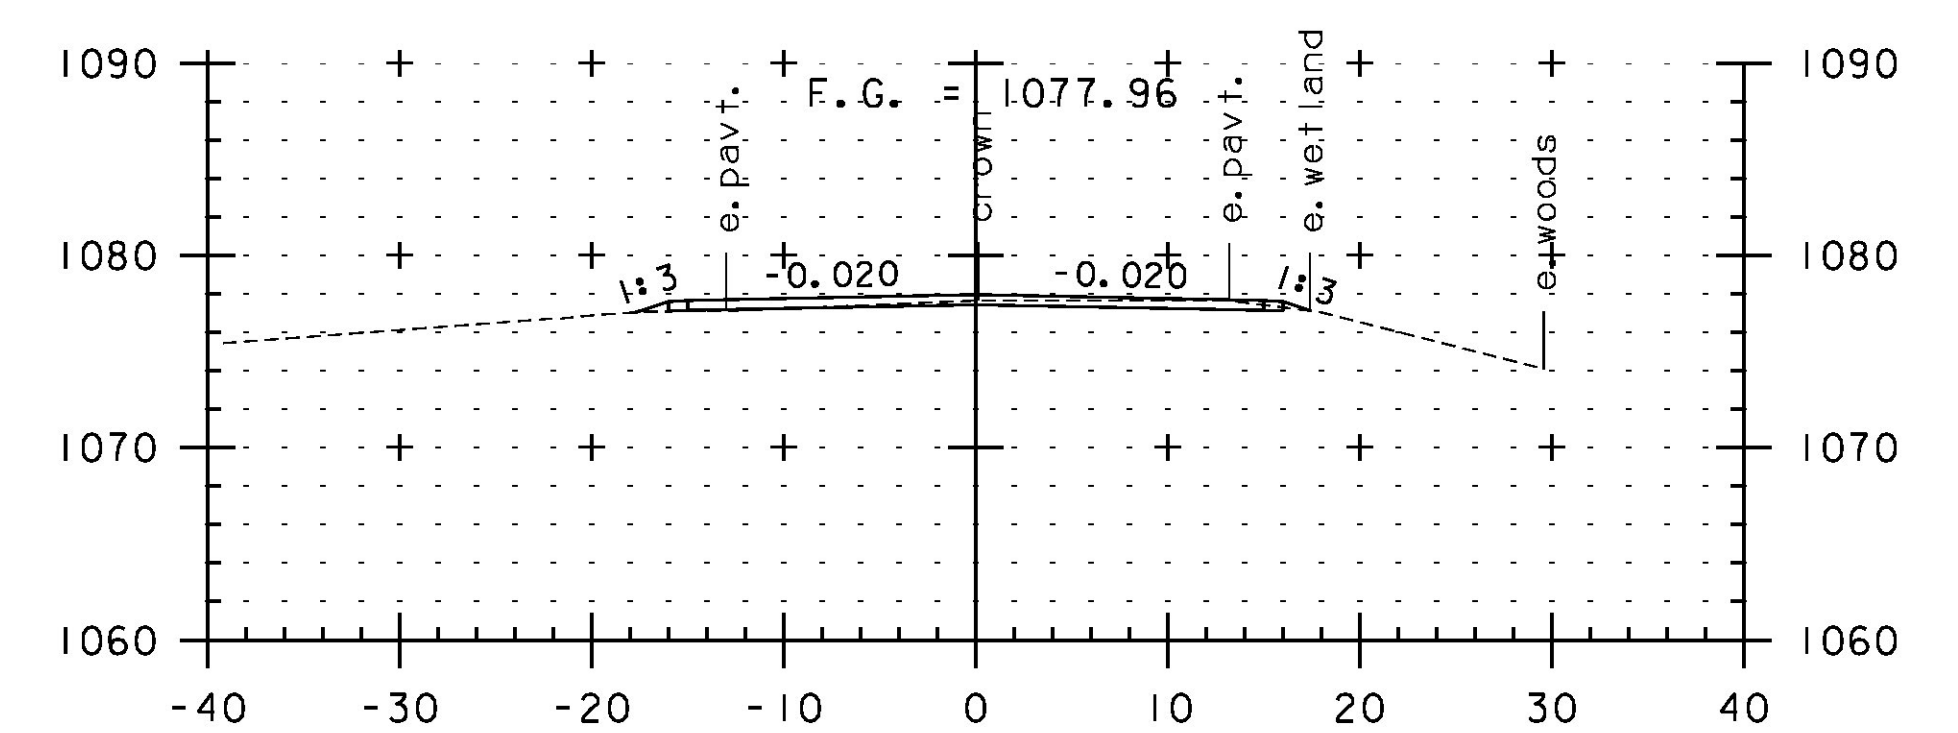


366+50

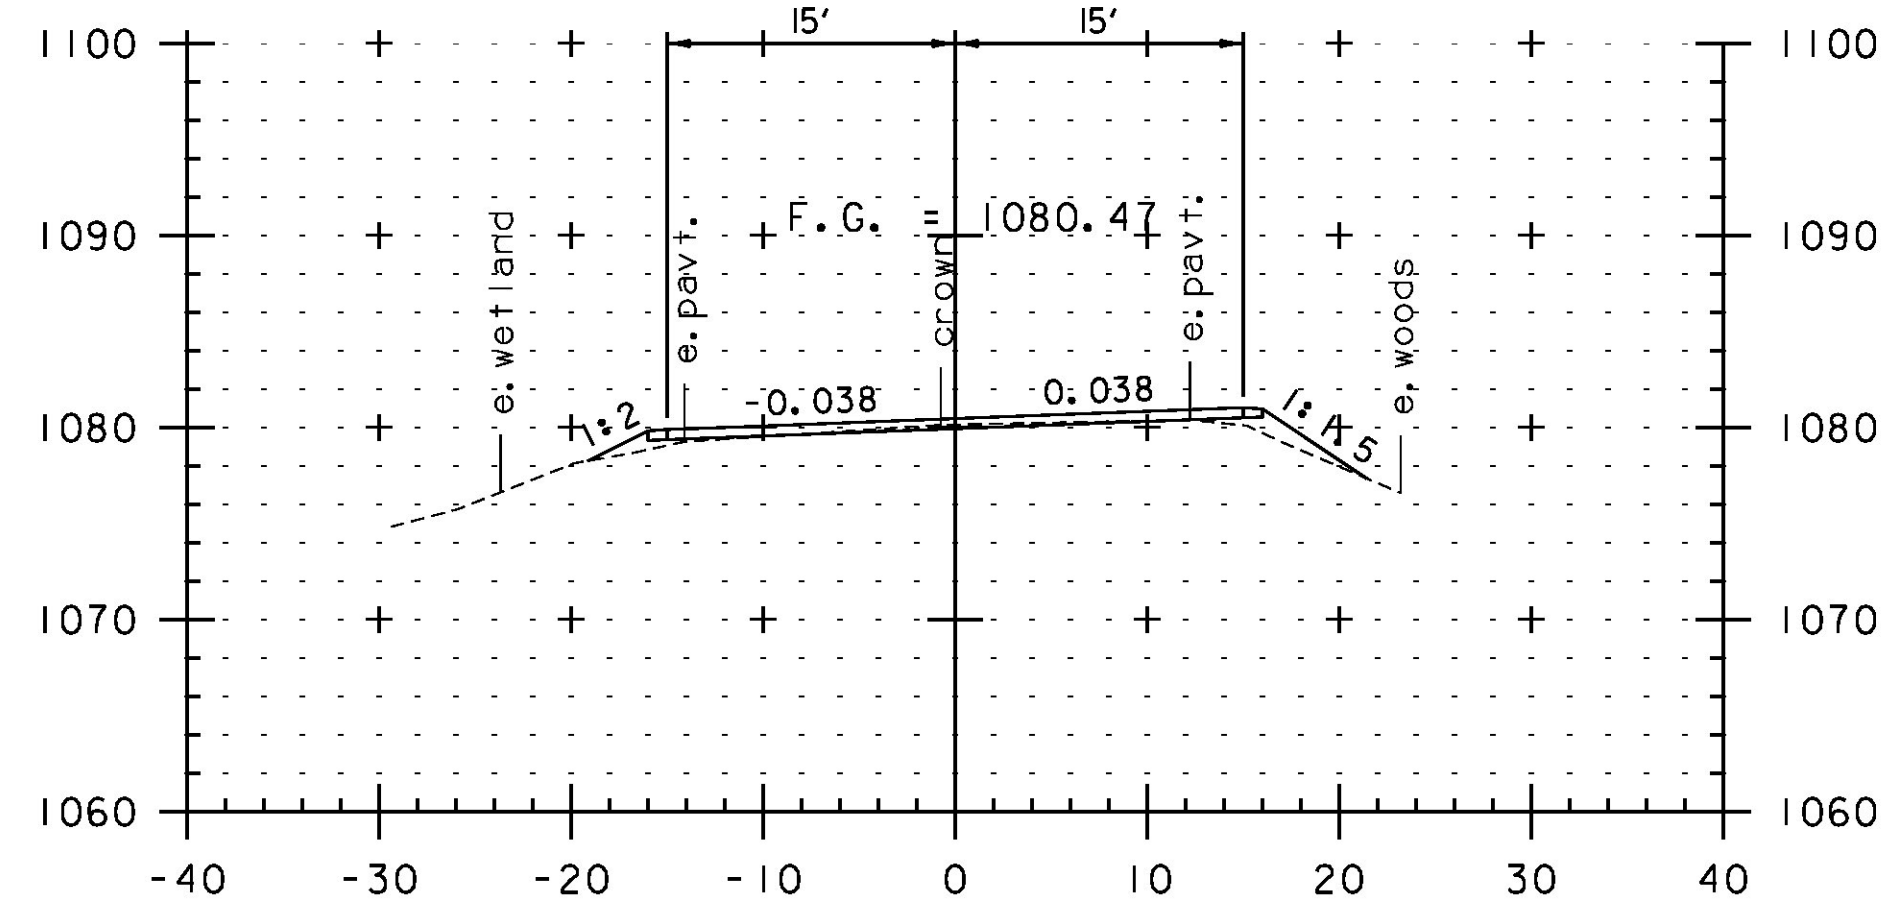

363+00

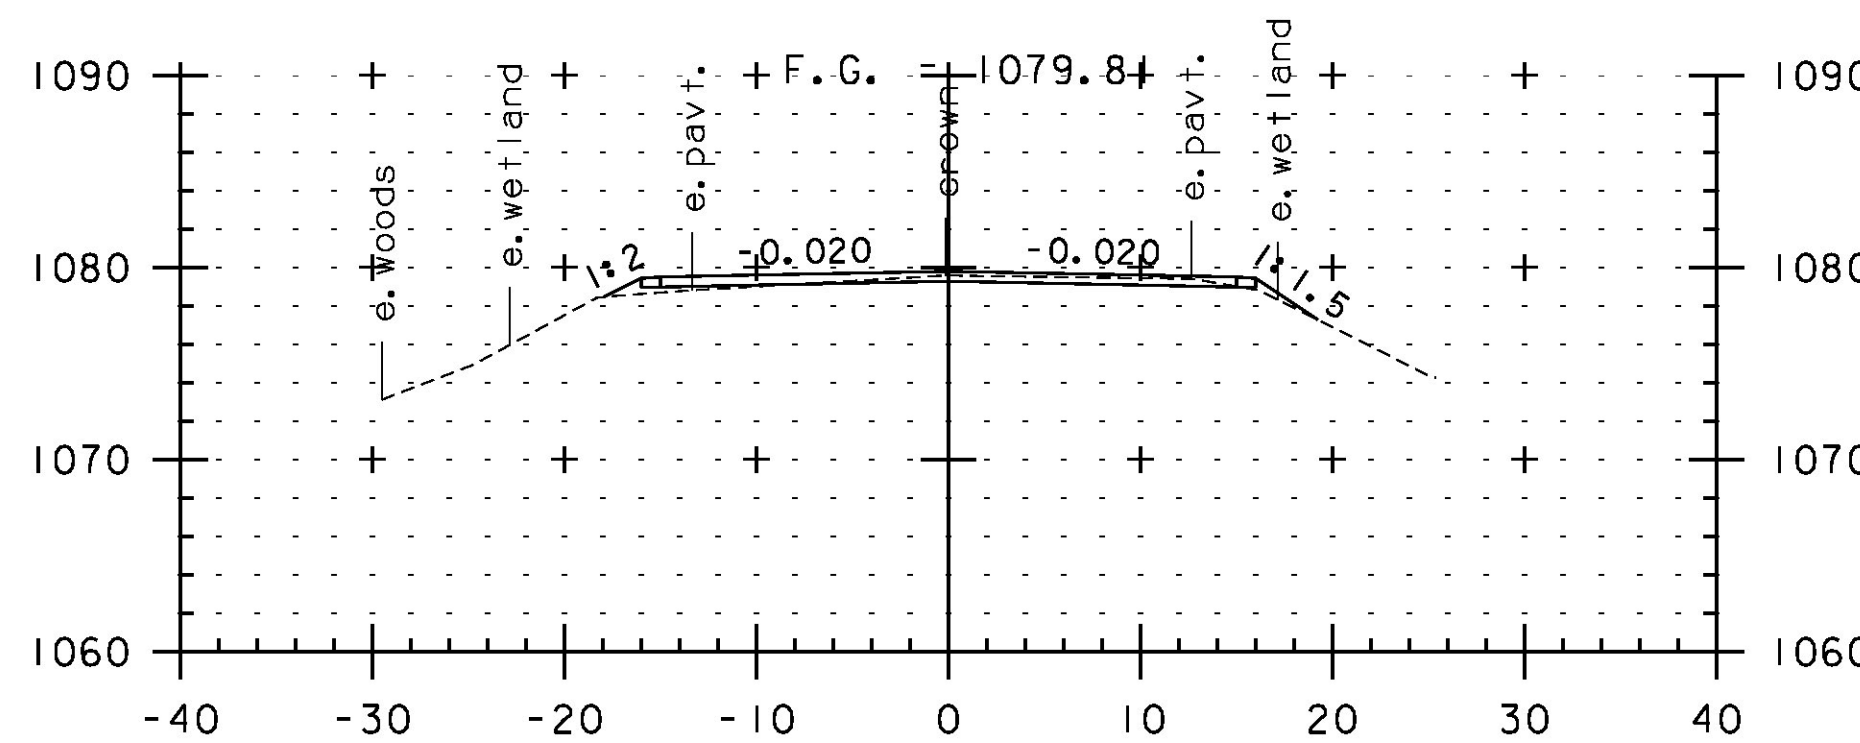

364+50

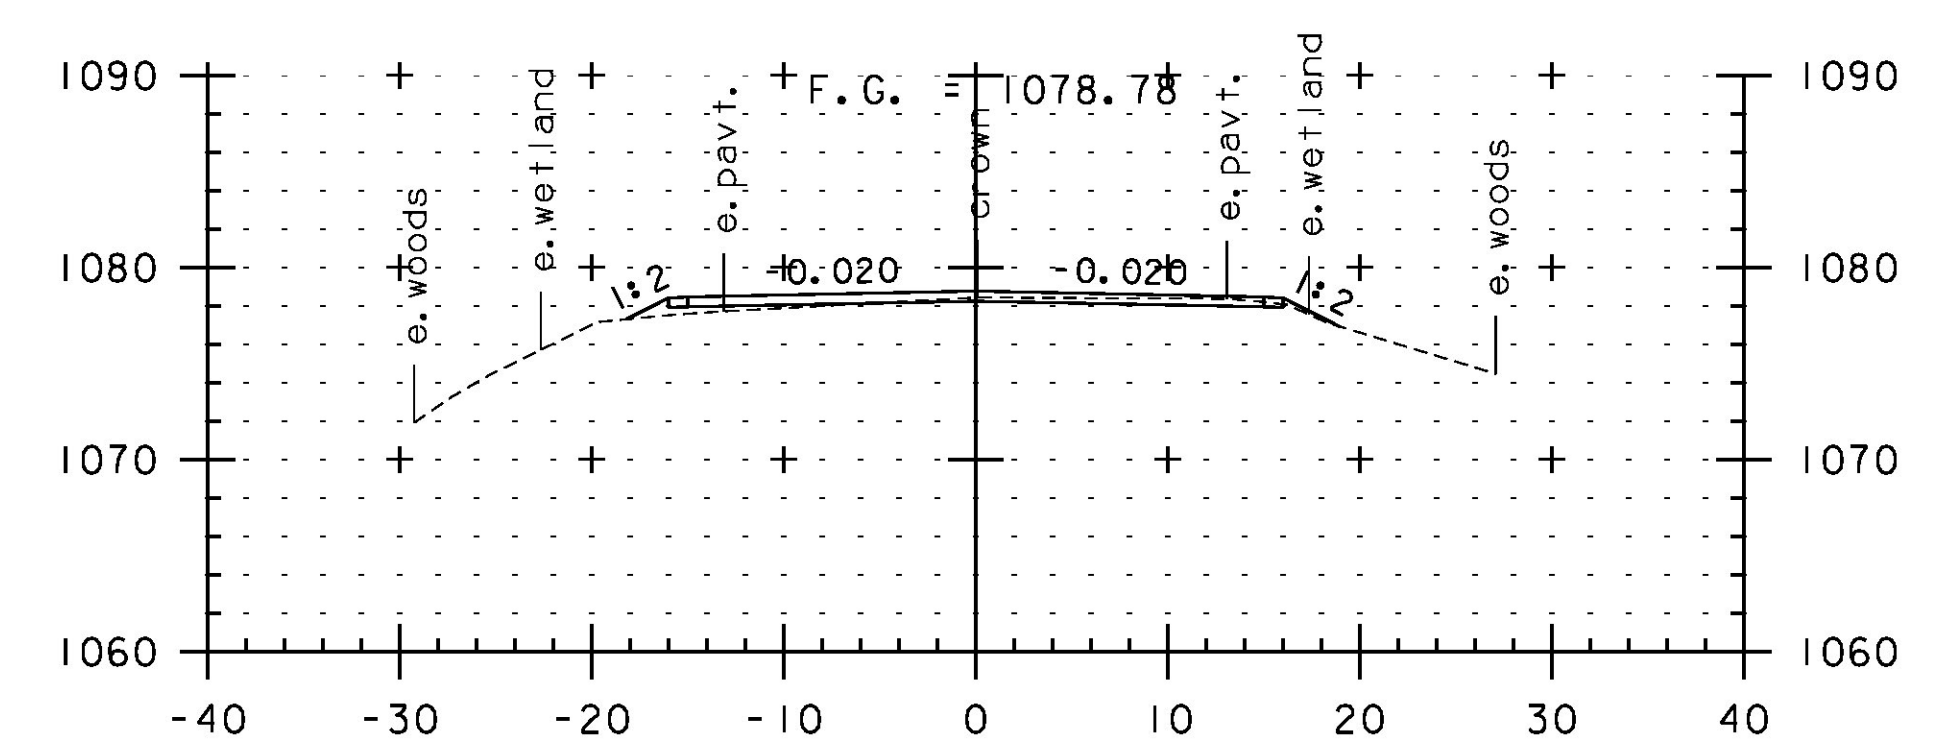

366+00



STA. 363+00 TO STA. 367+00

PROJECT NAME:	JAY-TROY	PLOT DATE:	5/16/2014
PROJECT NUMBER:	STP 2315(I)	DRAWN BY:	W. GORDON
FILE NAME:	z10b232xs.dgn	CHECKED BY:	P. SHEDD
PROJECT LEADER:	P. SHEDD	CROSS SECTION SHEET	83
DESIGNED BY:	N. LEMAY		SHEET 219 OF 244