




368+50

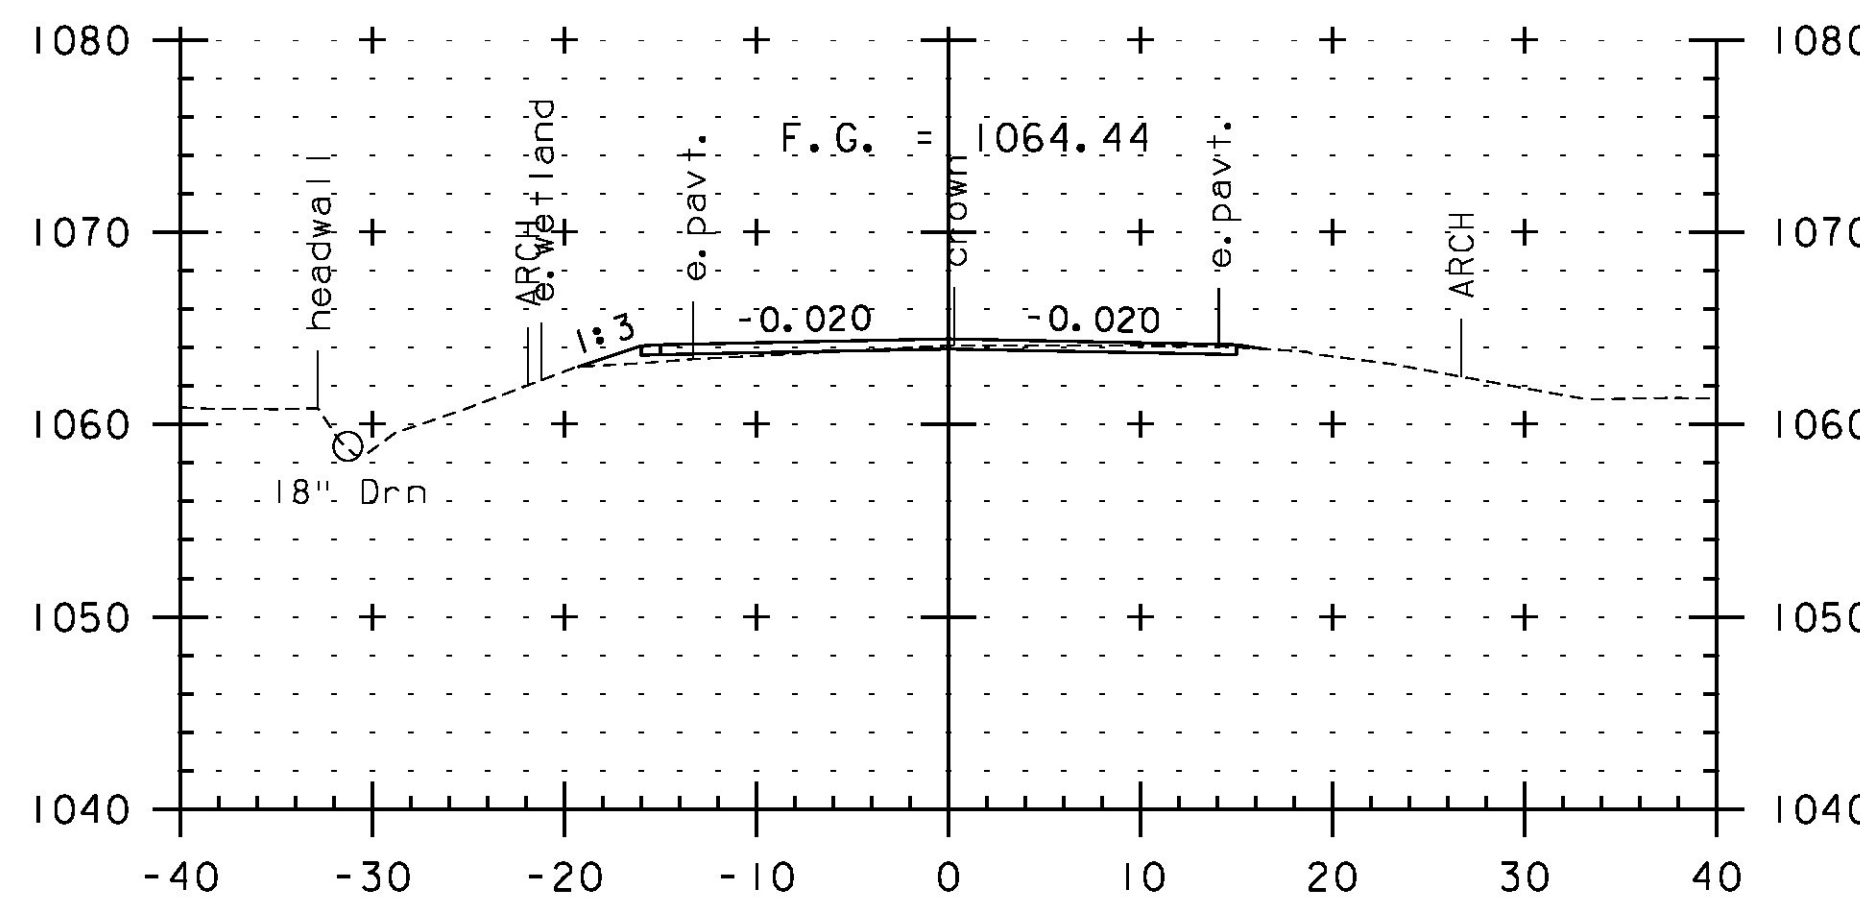


370+00

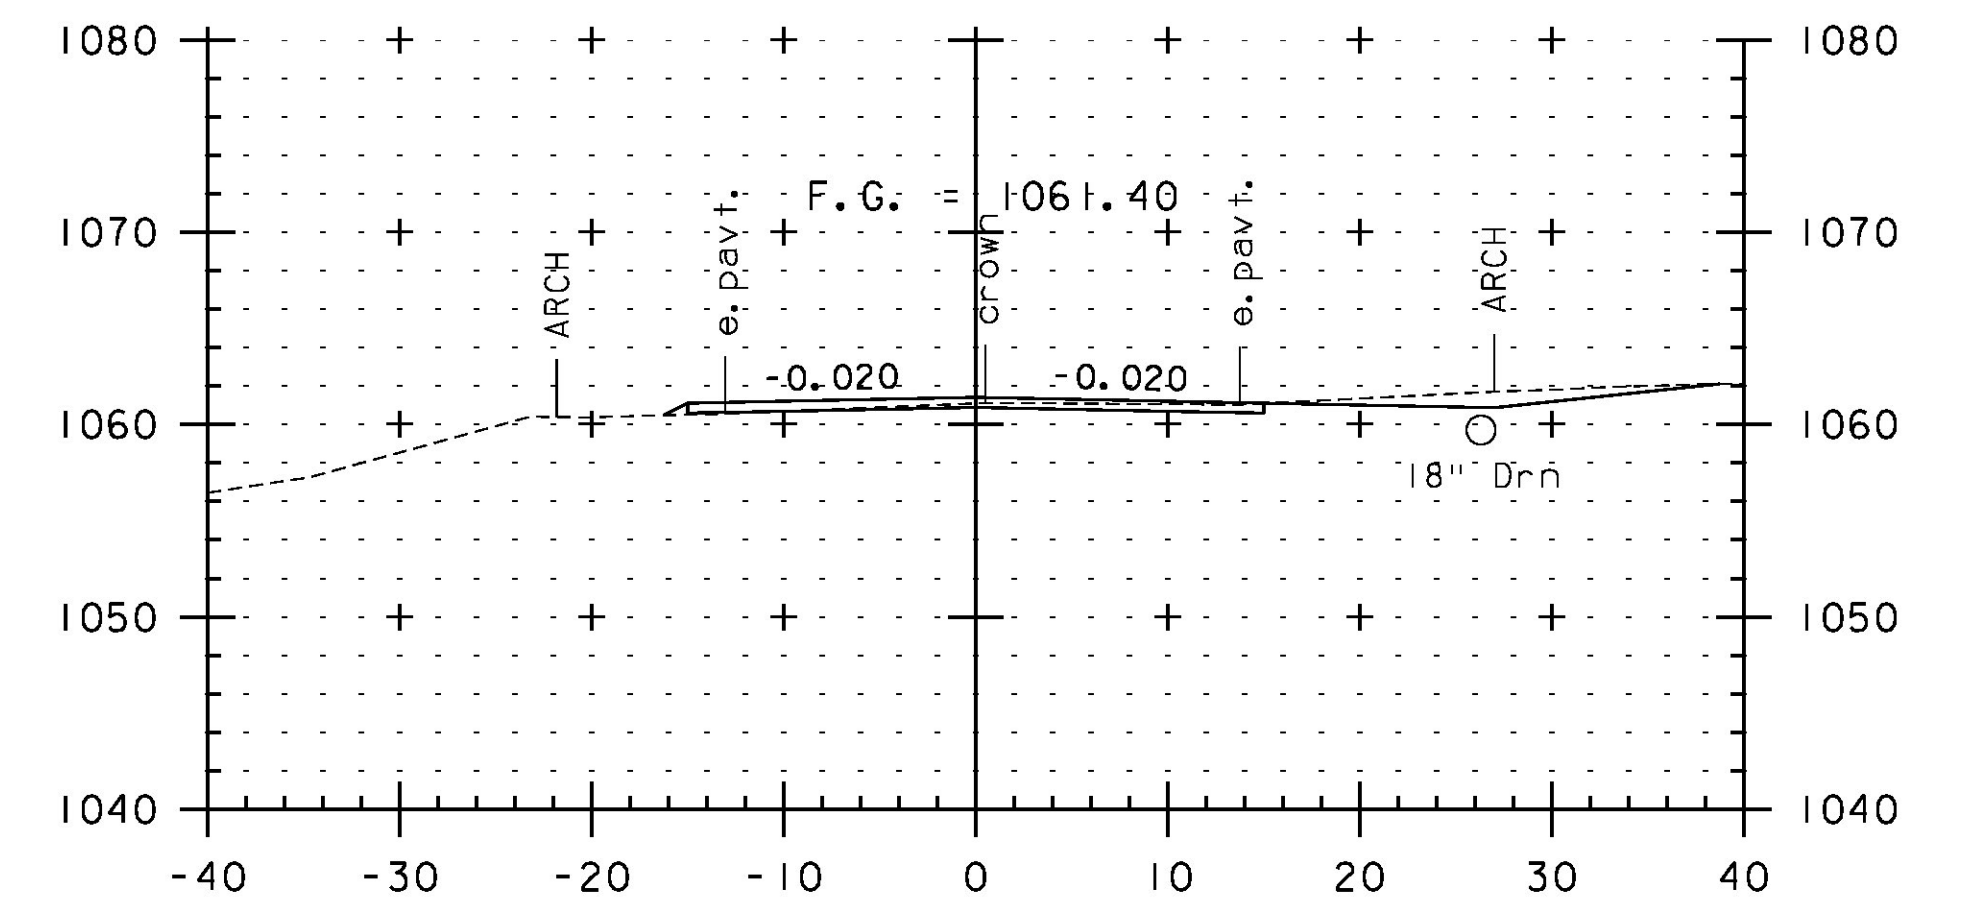


370+50

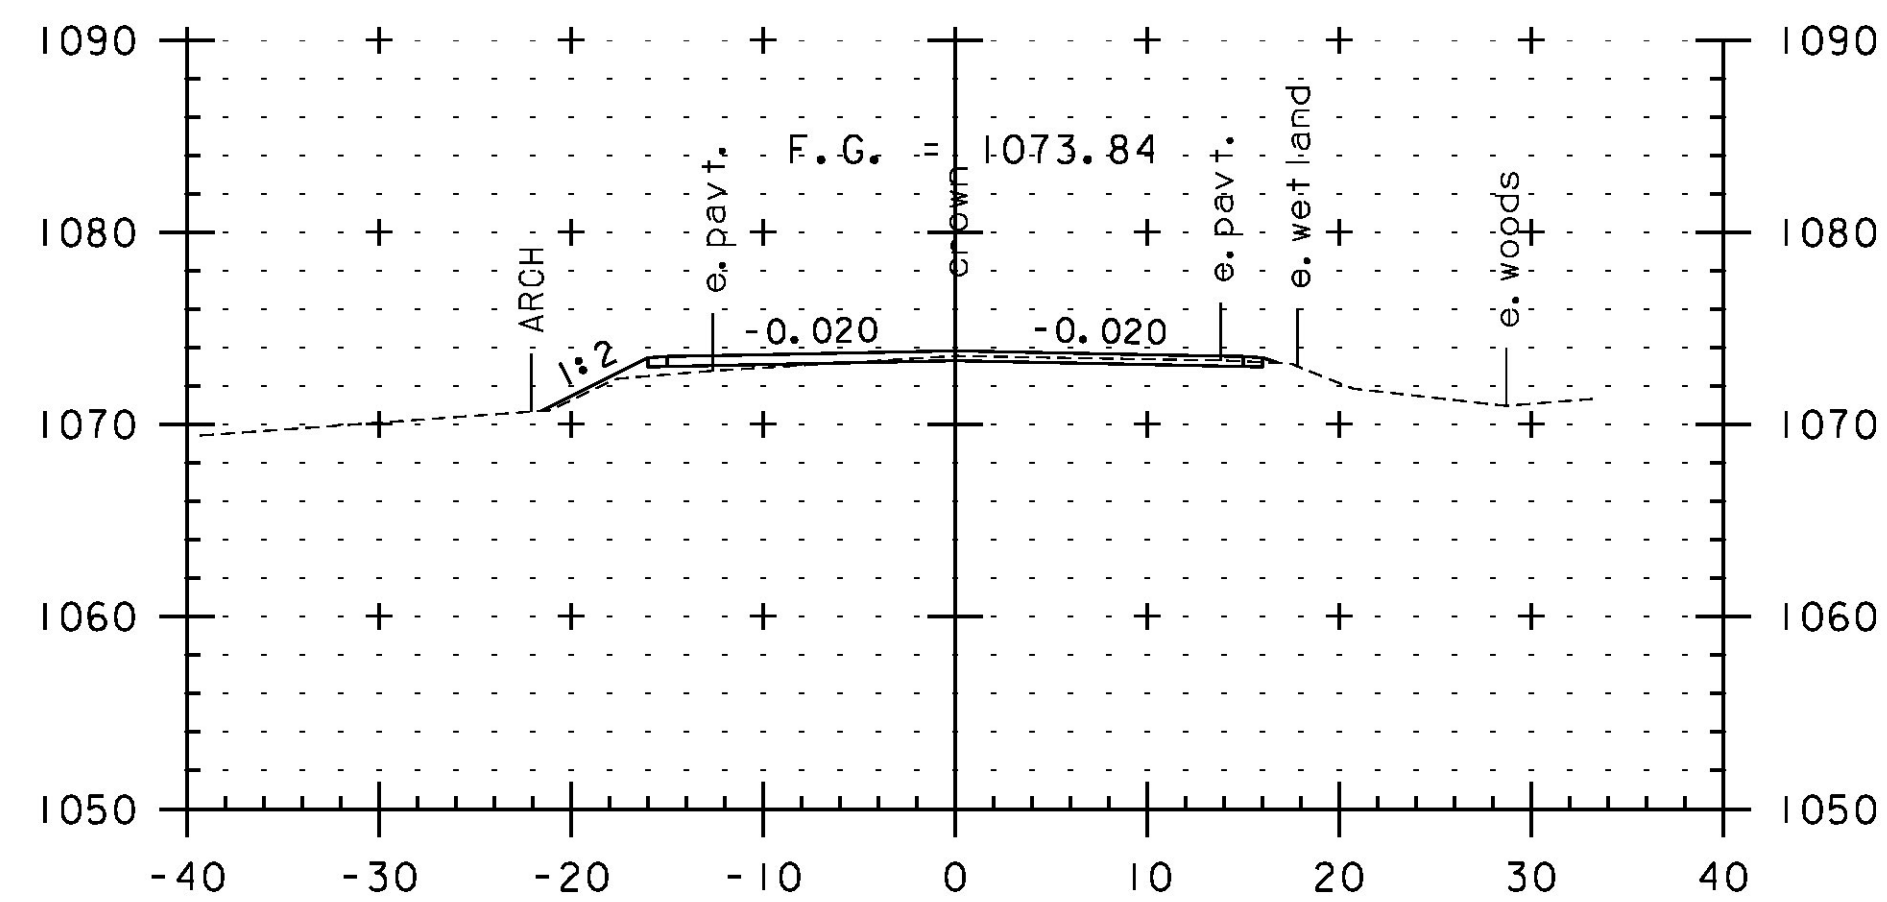


368+00

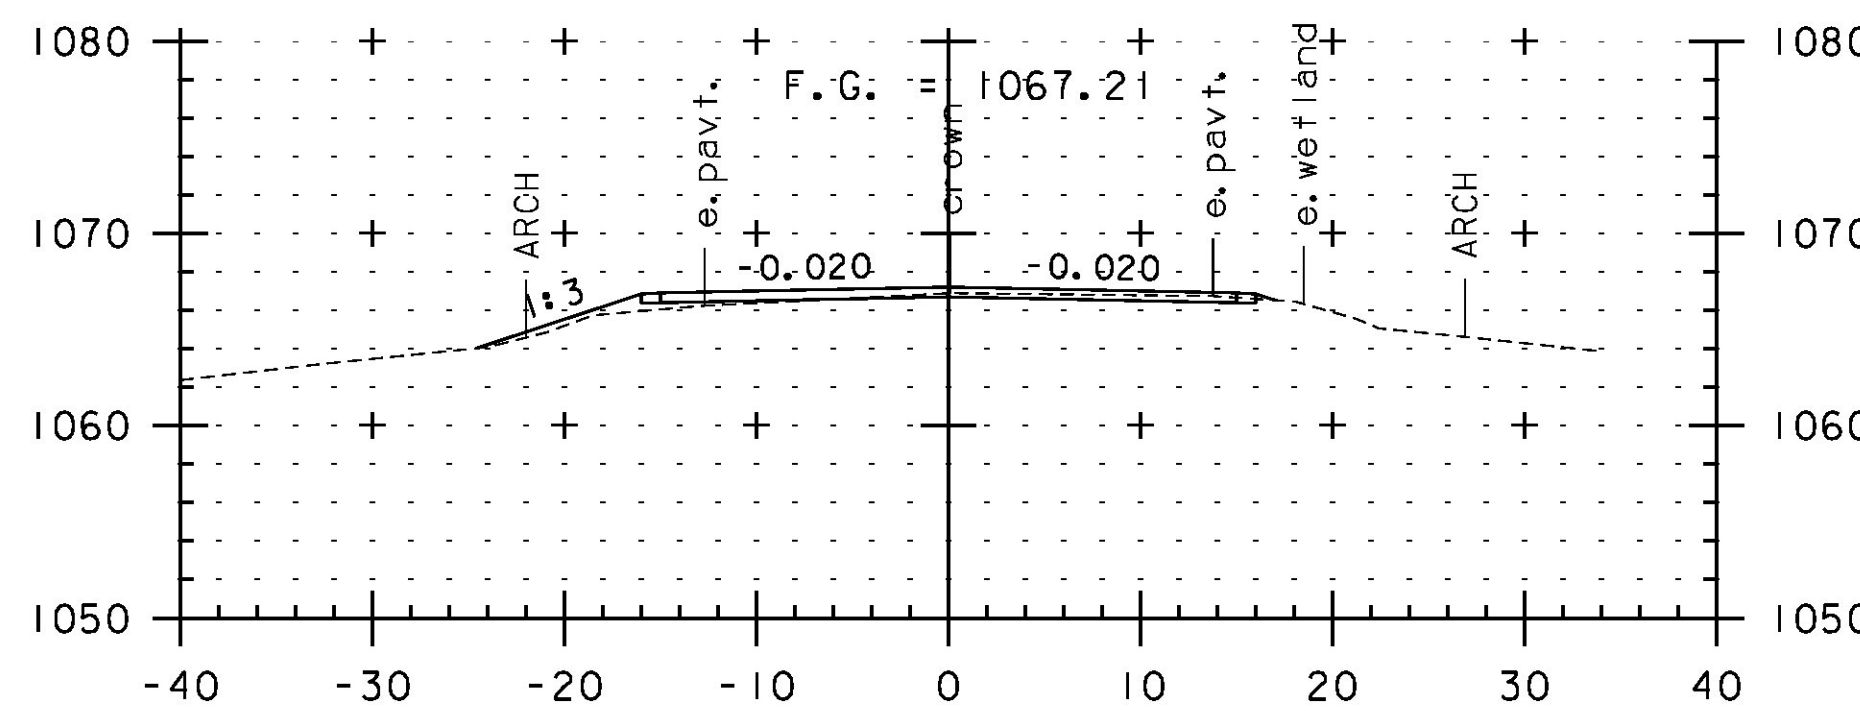


369+50

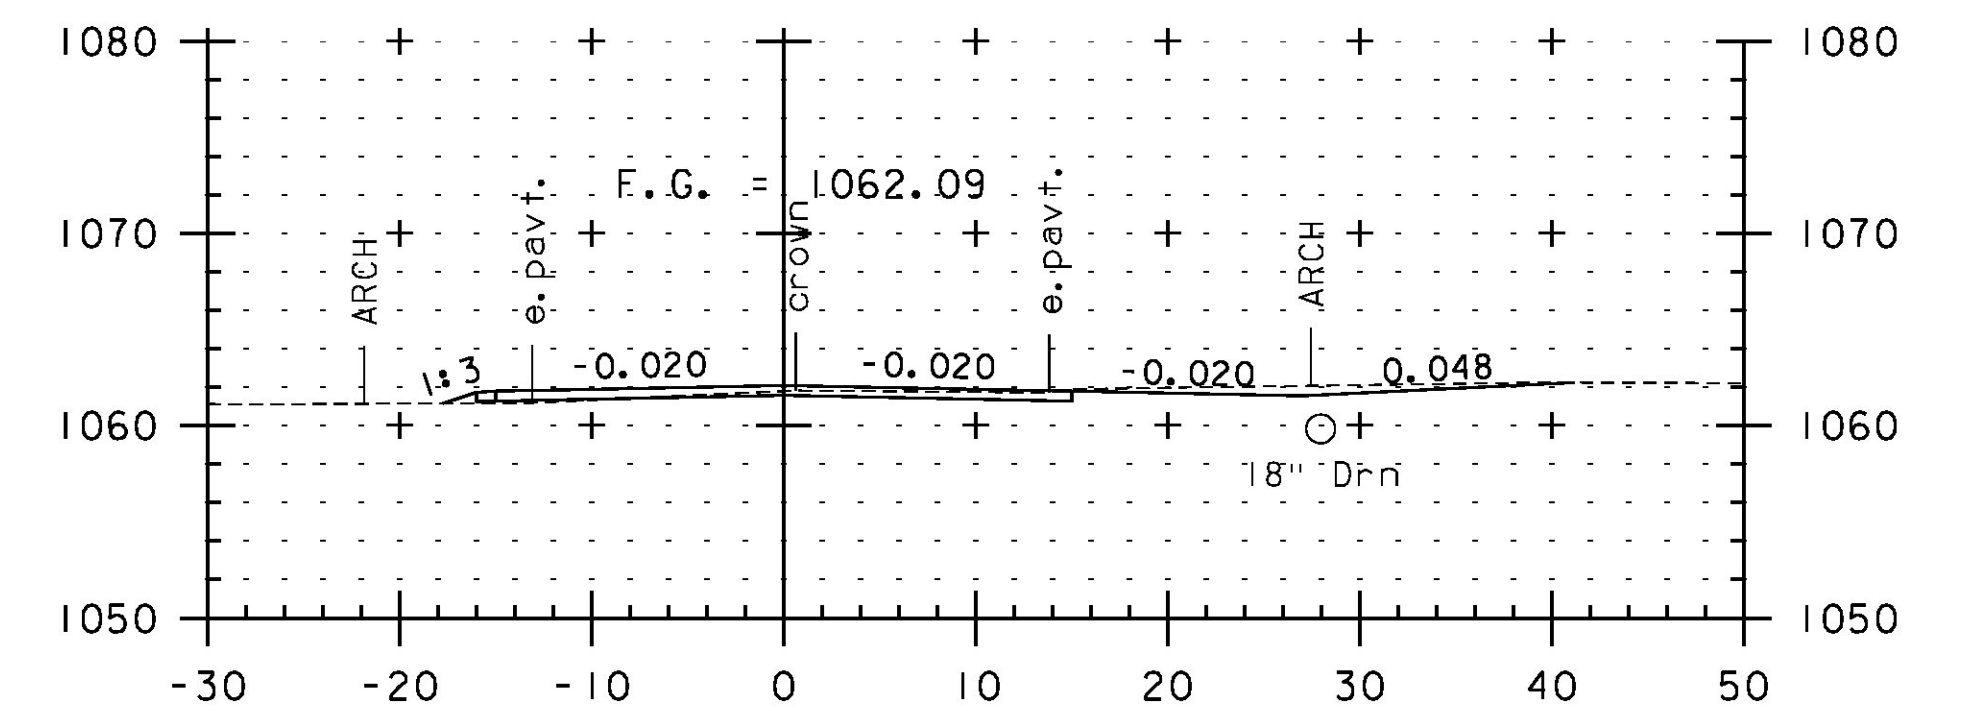


370+39
TH 1 RT

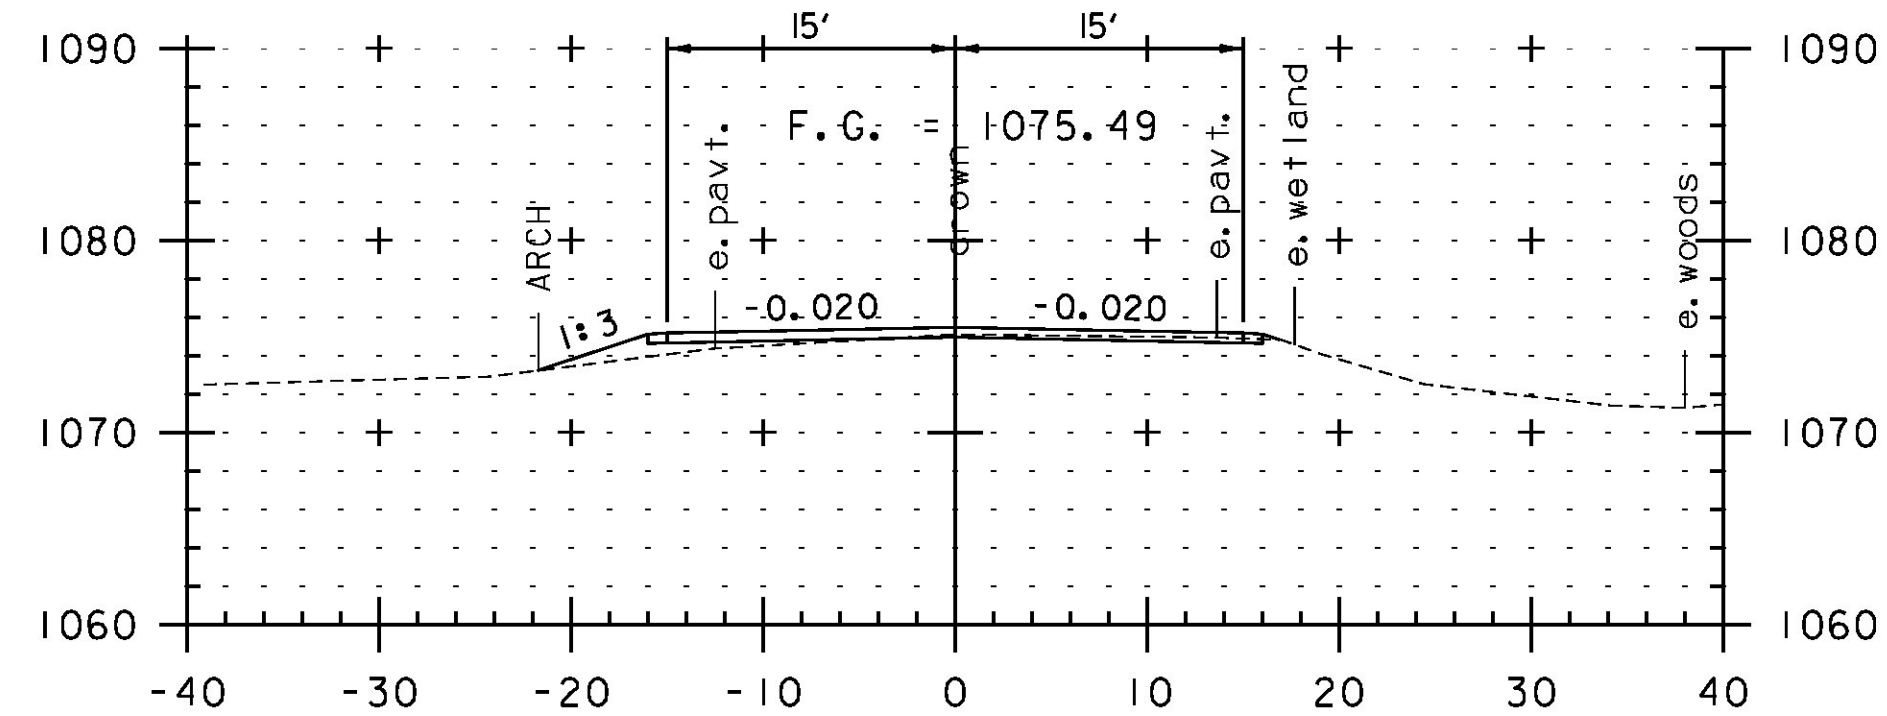

367+50

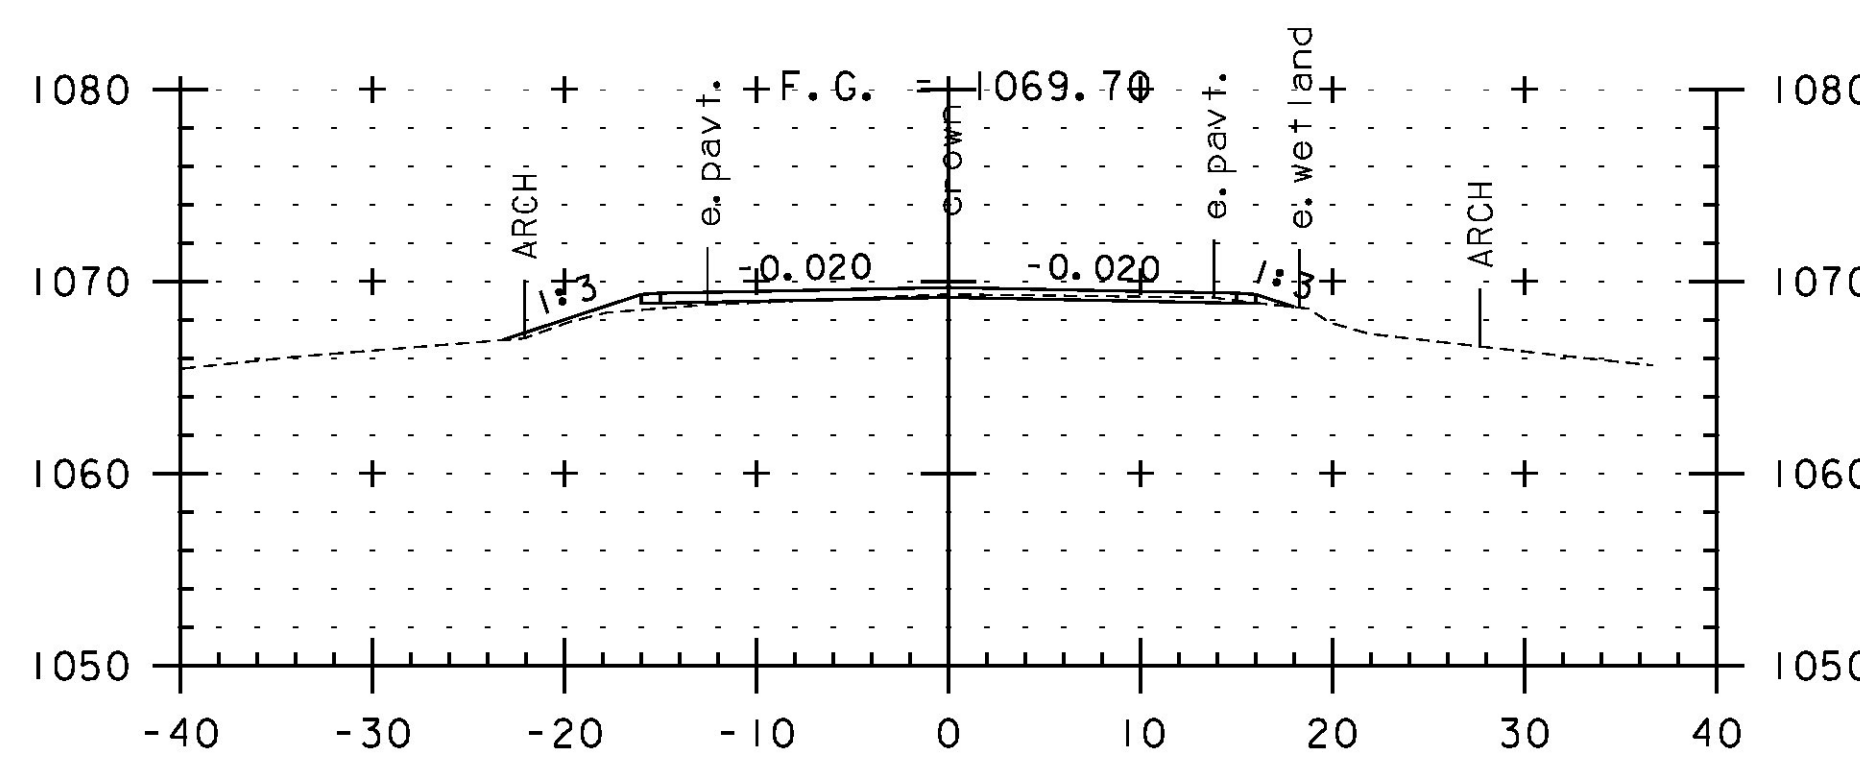

369+00

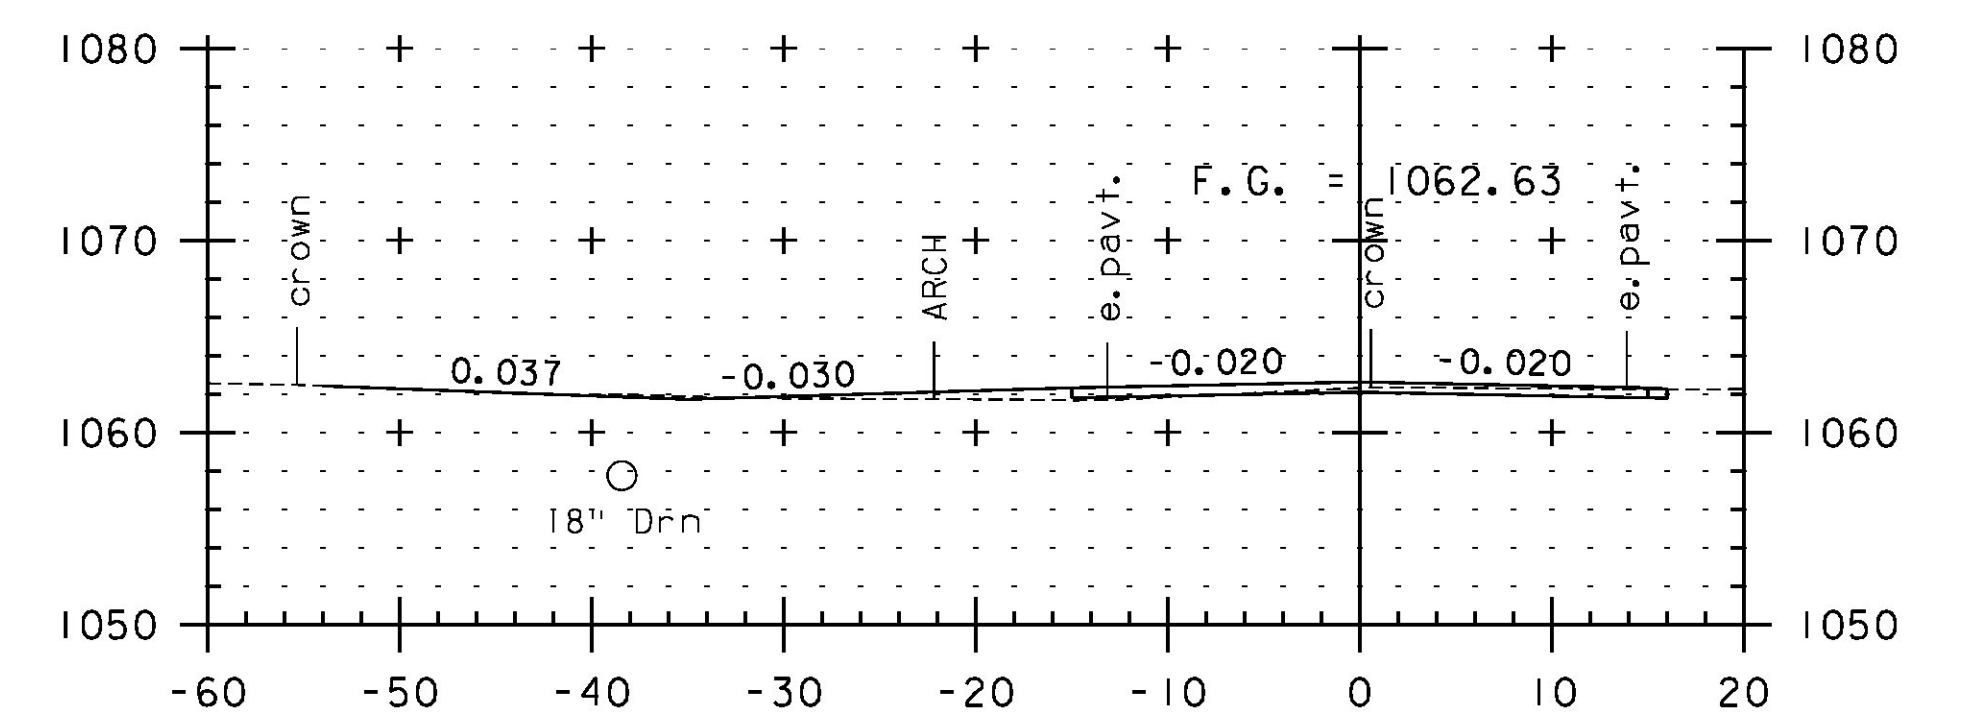

370+30
TH 3 LT



SCALE IN FEET

STA. 367+50 TO STA. 370+50

PROJECT NAME: JAY-TROY
PROJECT NUMBER: STP 2315(I)

FILE NAME: z10b232xs.dgn
PROJECT LEADER: P. SHEDD
DESIGNED BY: N. LEMAY
CROSS SECTION SHEET 84

PLOT DATE: 5/16/2014
DRAWN BY: W. GORDON
CHECKED BY: P. SHEDD
SHEET 220 OF 244