




372+00

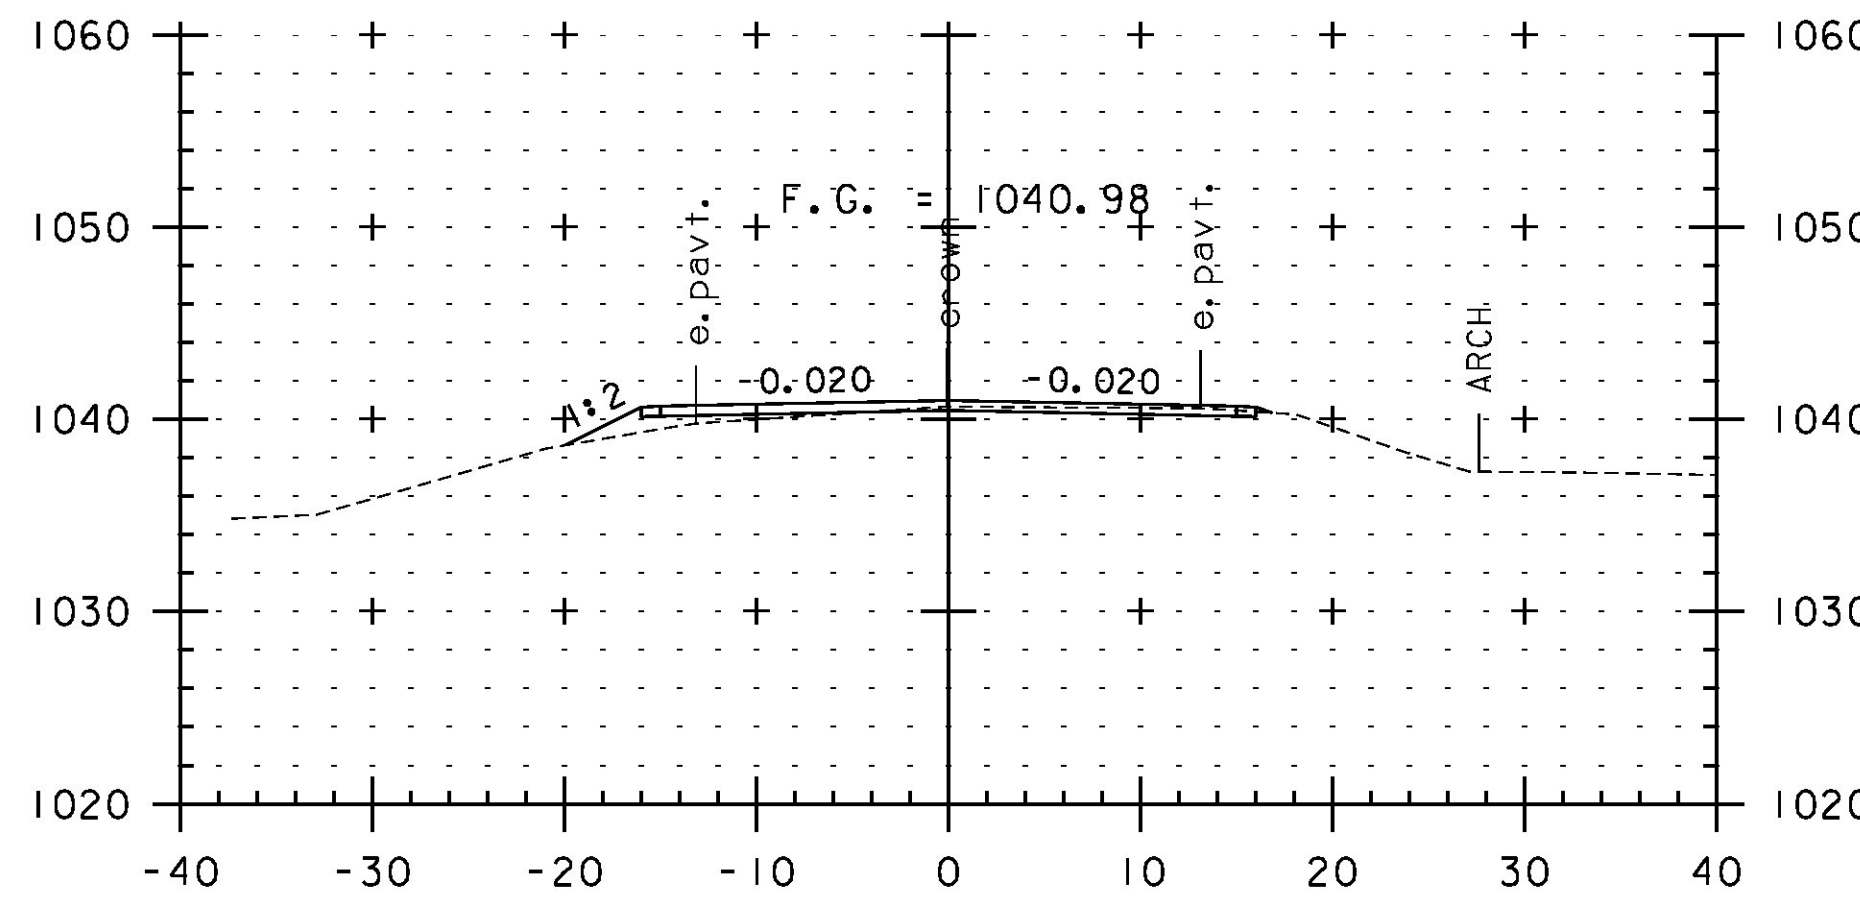


373+50

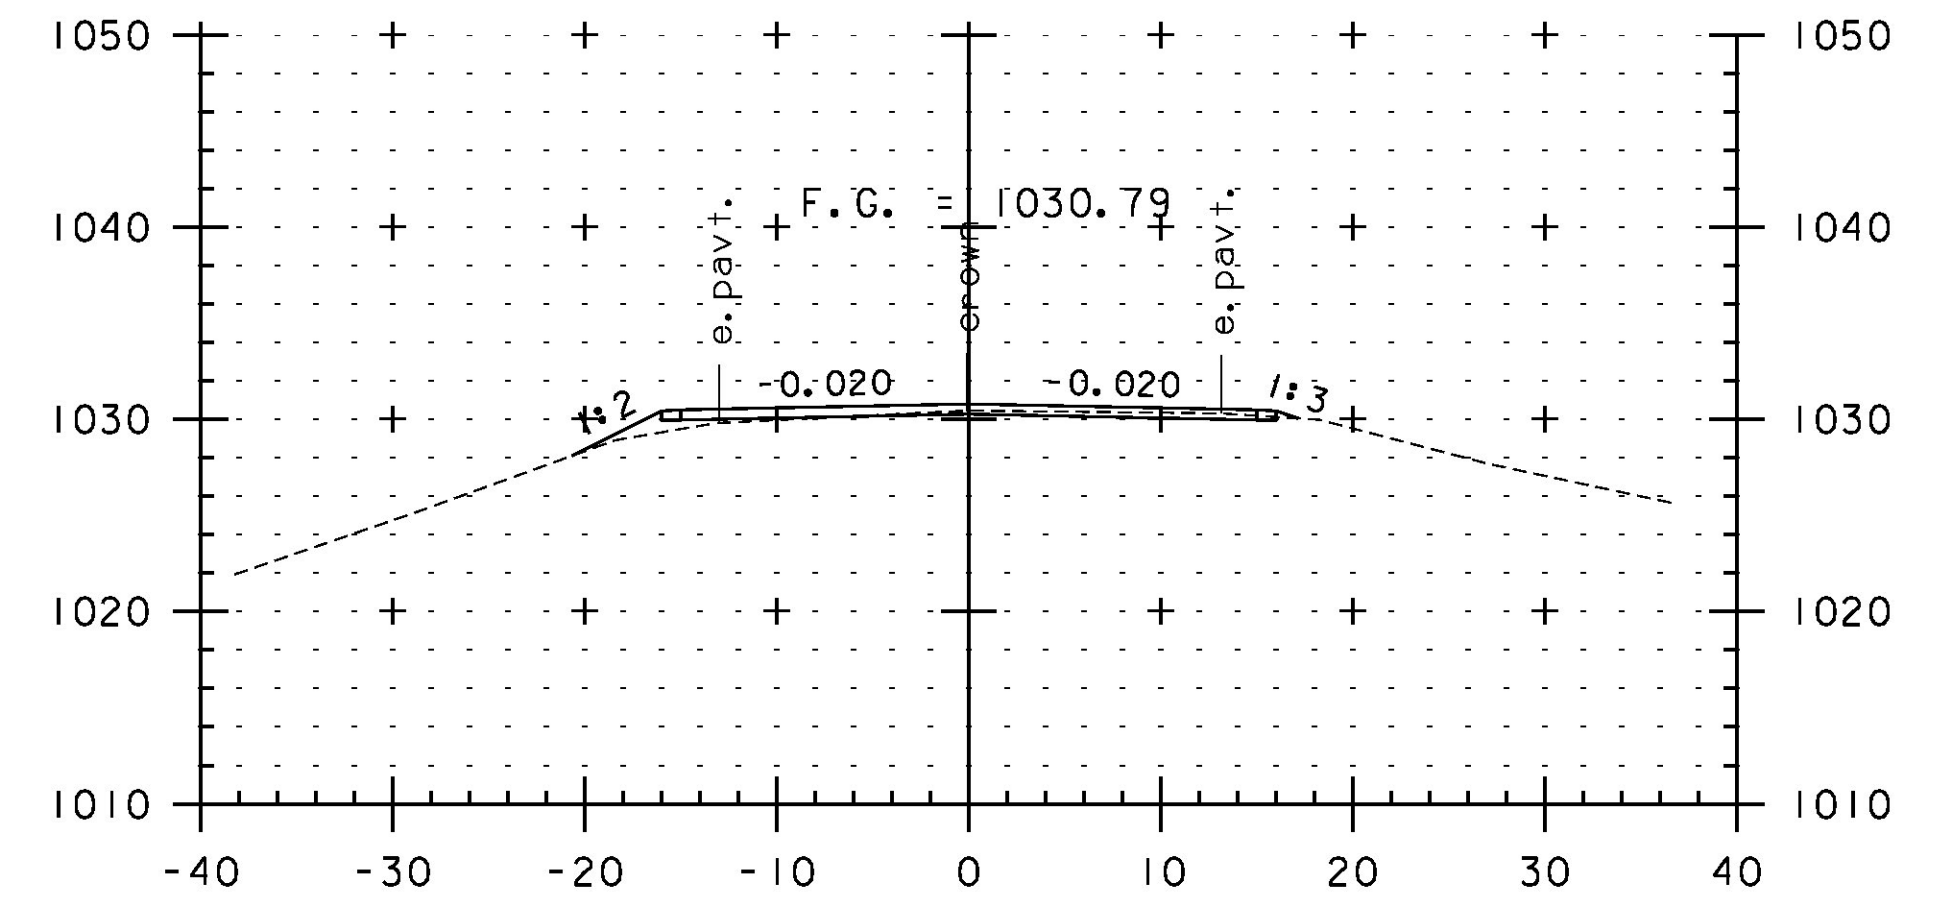


375+00

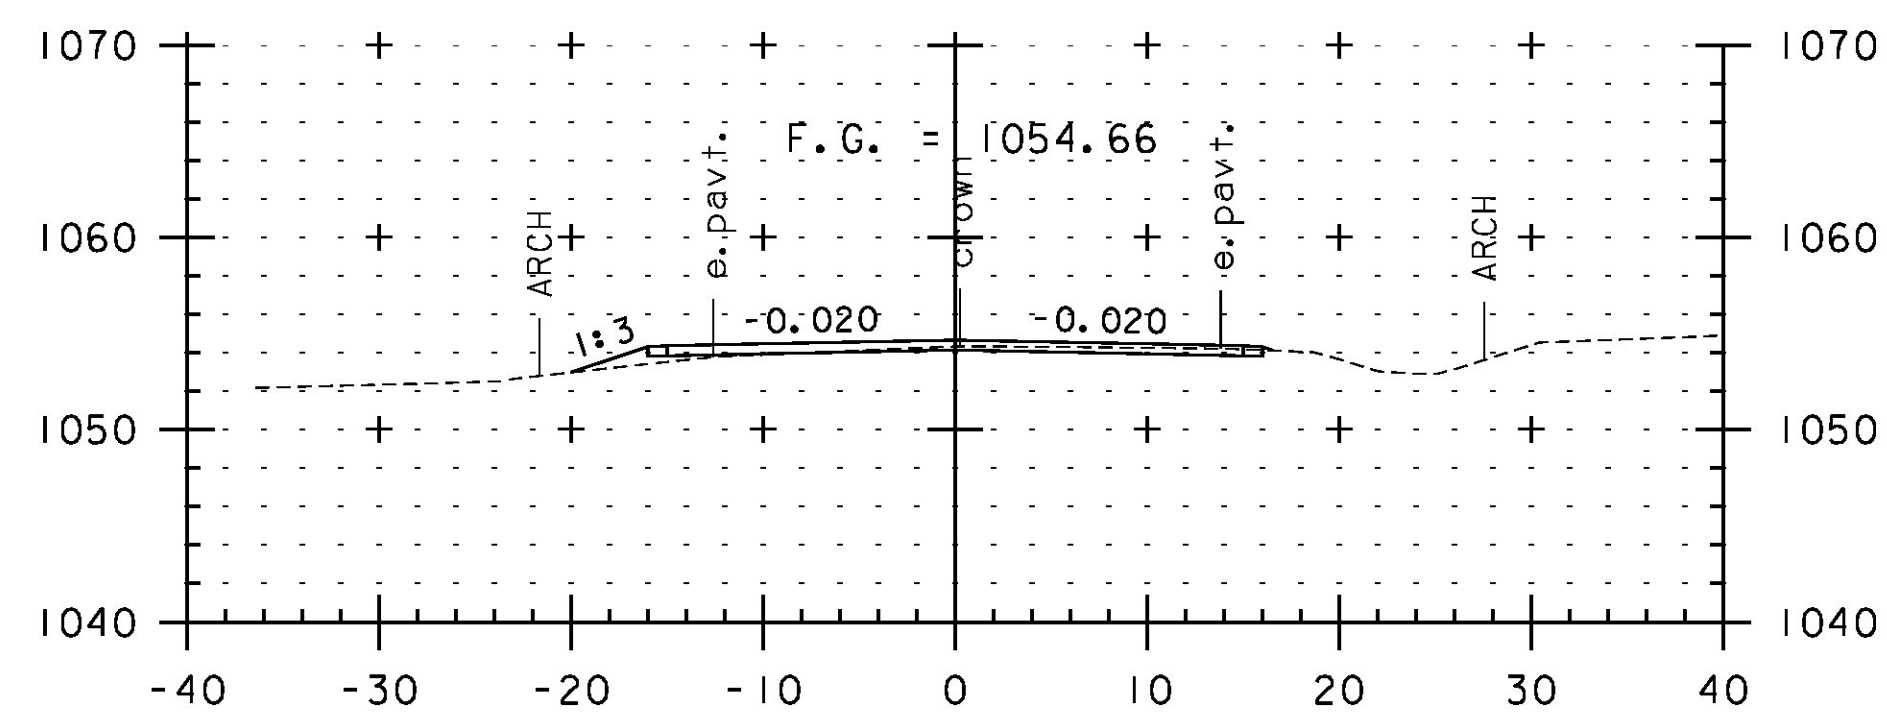


371+50

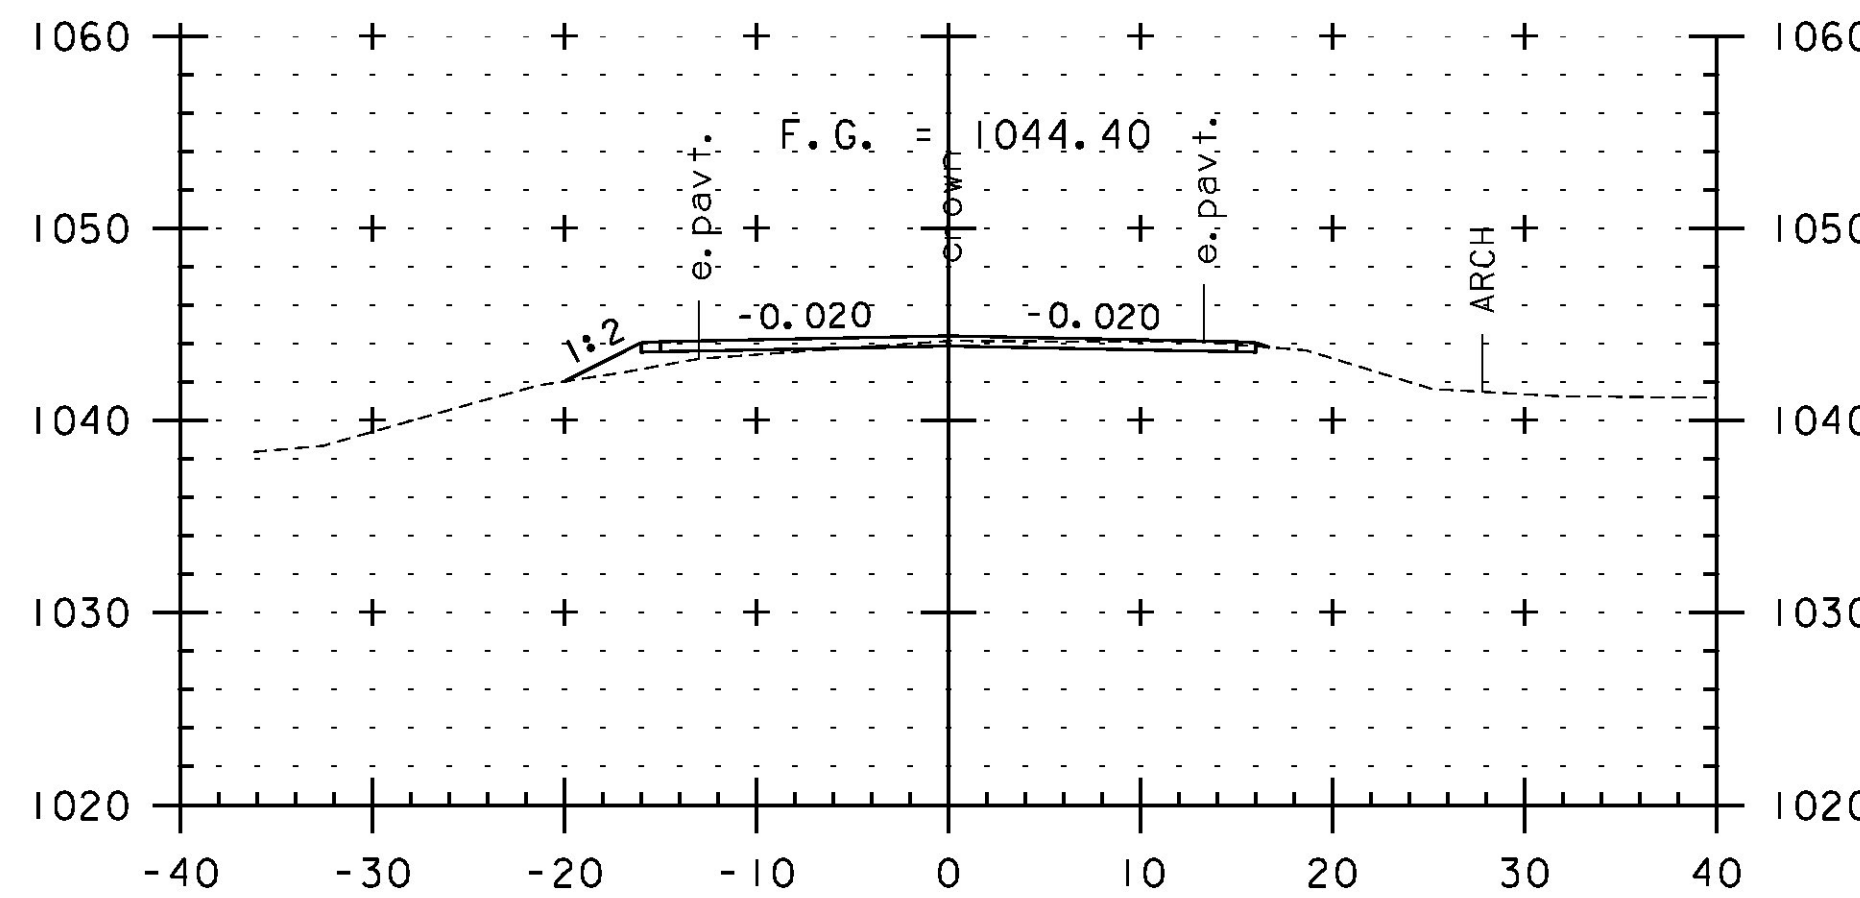


373+00

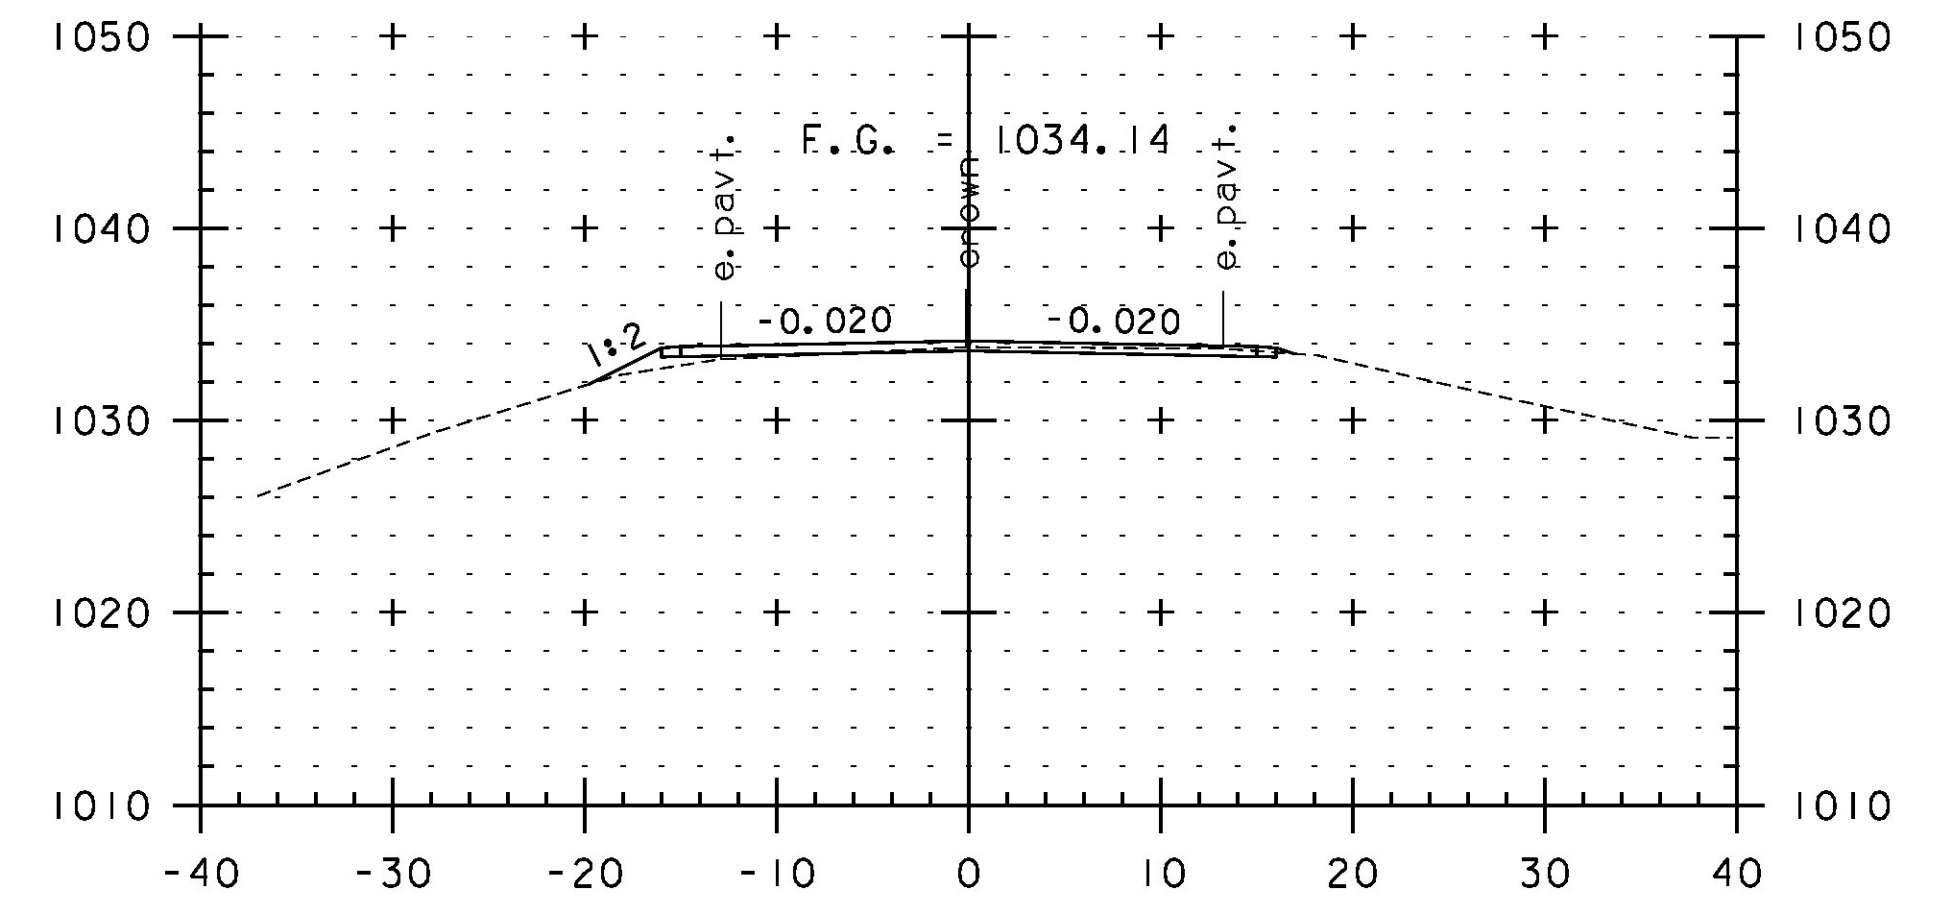


374+50

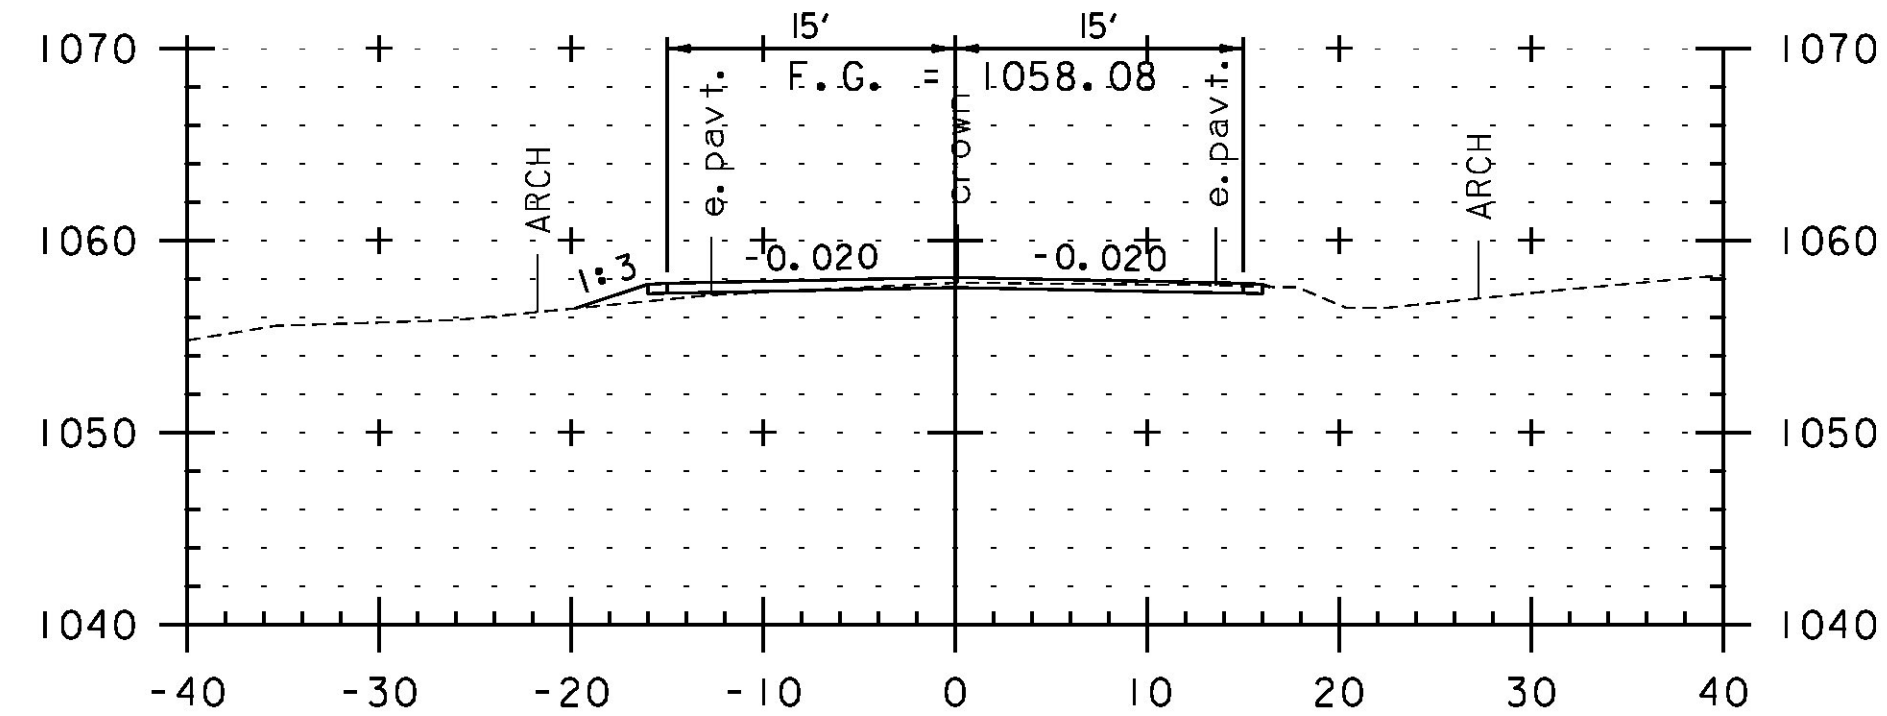

371+00

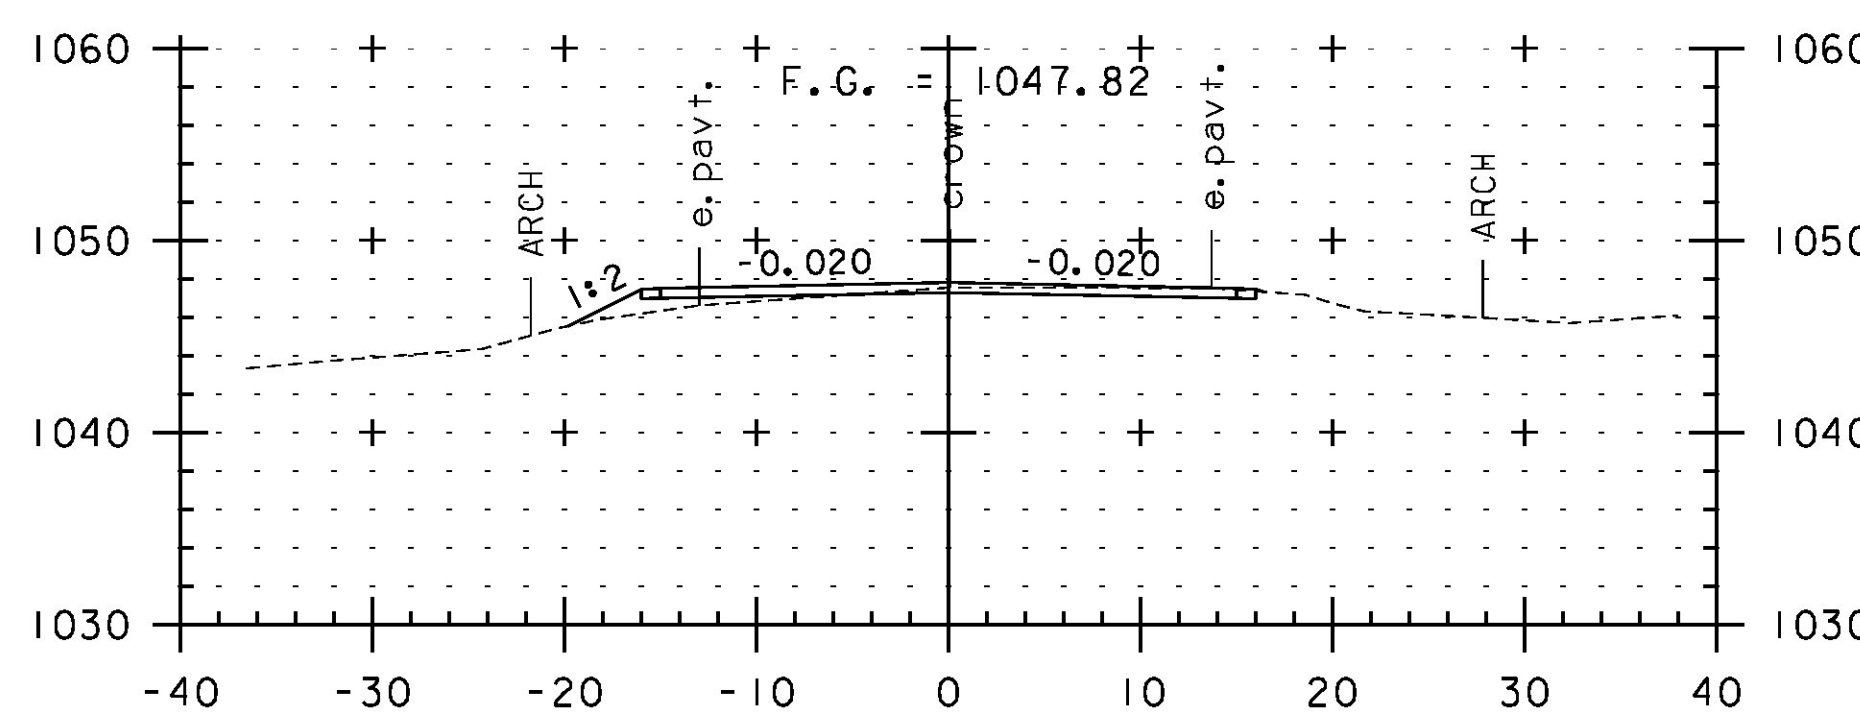

372+50

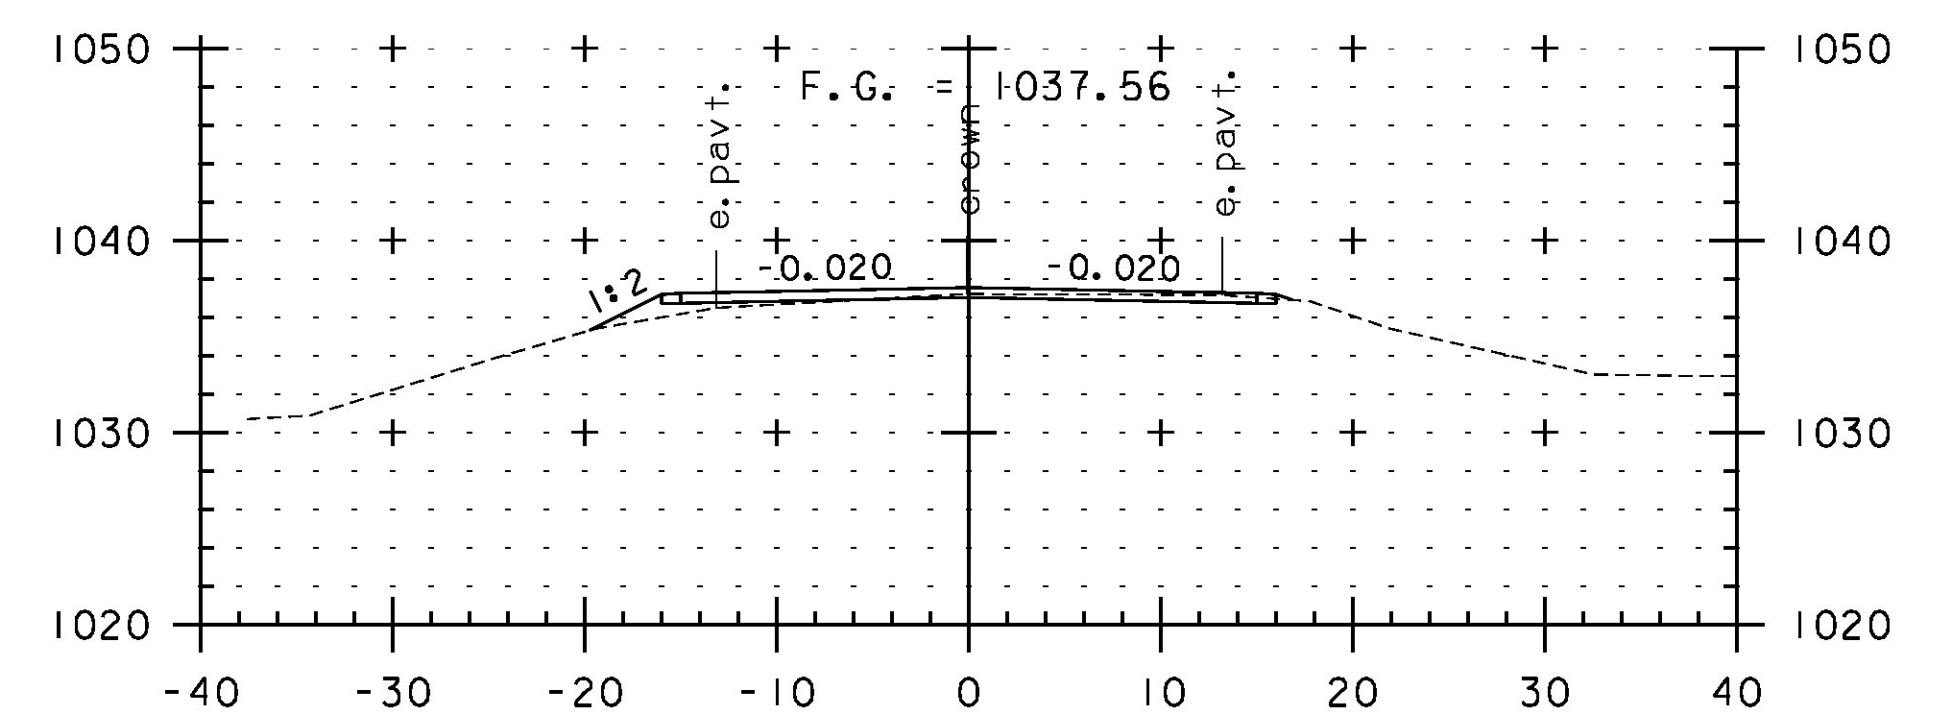

374+00



SCALE IN FEET

STA. 371+00 TO STA. 375+00

PROJECT NAME:	JAY-TROY	PLOT DATE:	5/16/2014
PROJECT NUMBER:	STP 2315(I)	DRAWN BY:	W. GORDON
FILE NAME:	z10b232xs.dgn	CHECKED BY:	P. SHEDD
PROJECT LEADER:	P. SHEDD	CROSS SECTION SHEET	85
DESIGNED BY:	N. LEMAY	SHEET	221 OF 244