




381+00

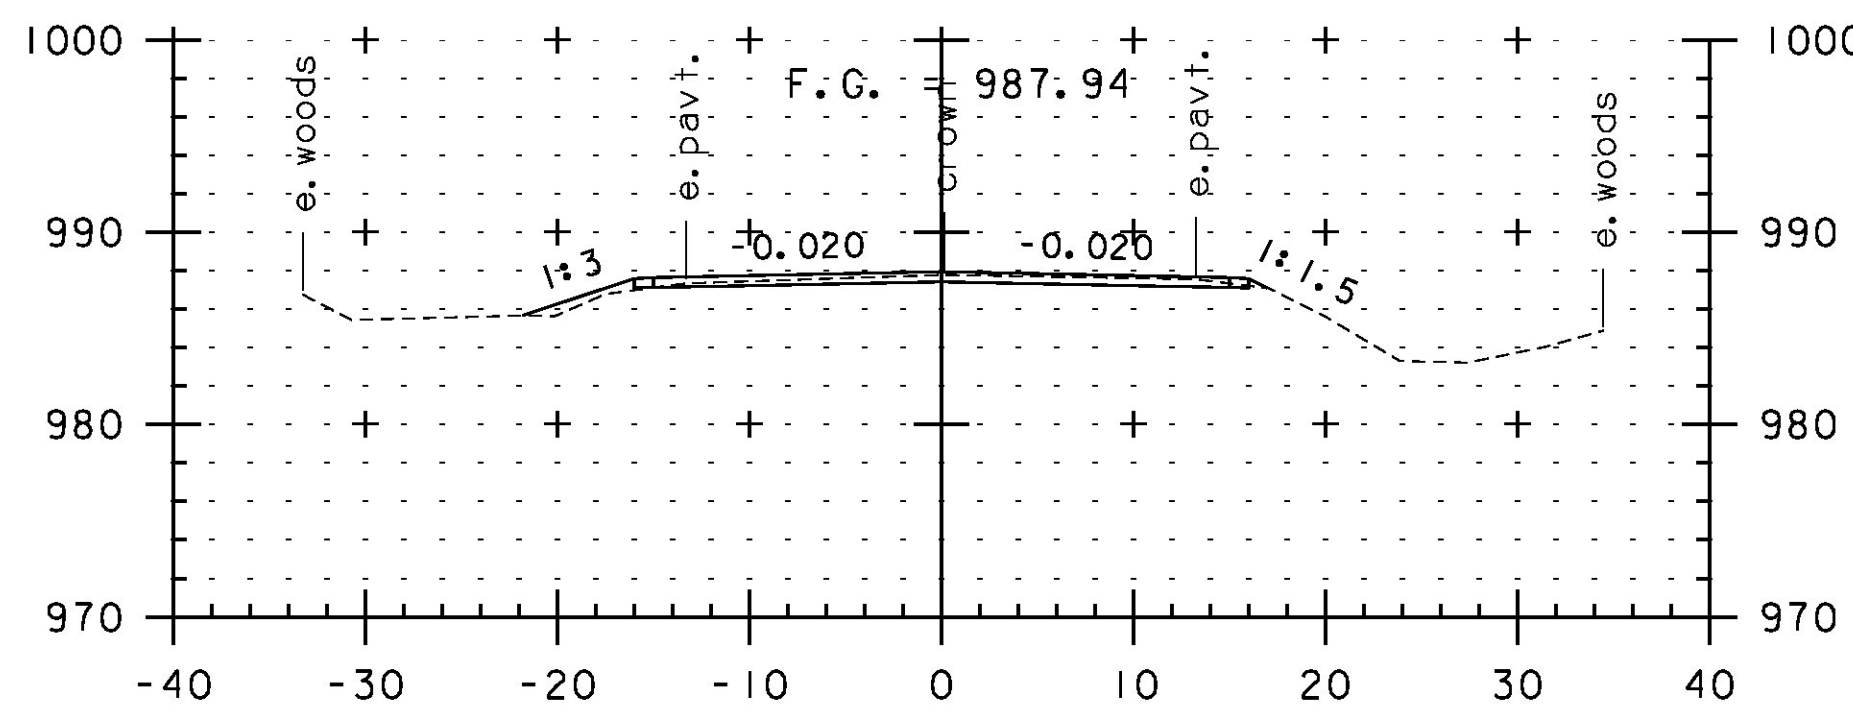


382+50

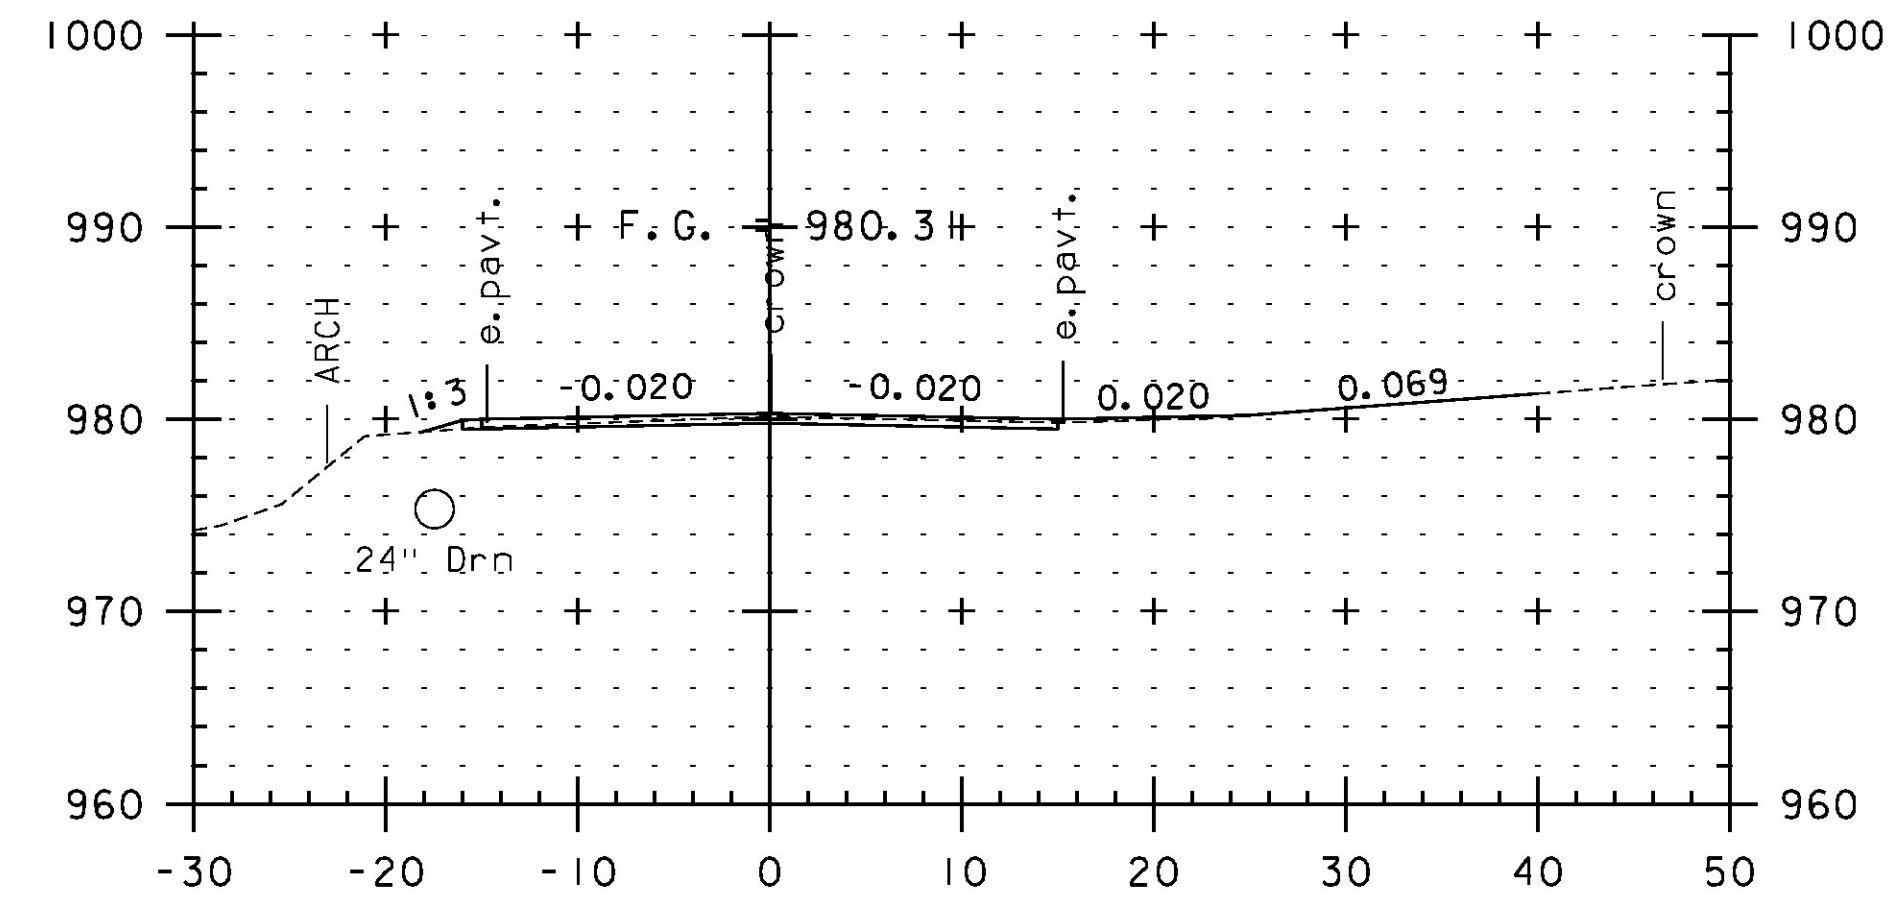


383+92
TH 46 RT

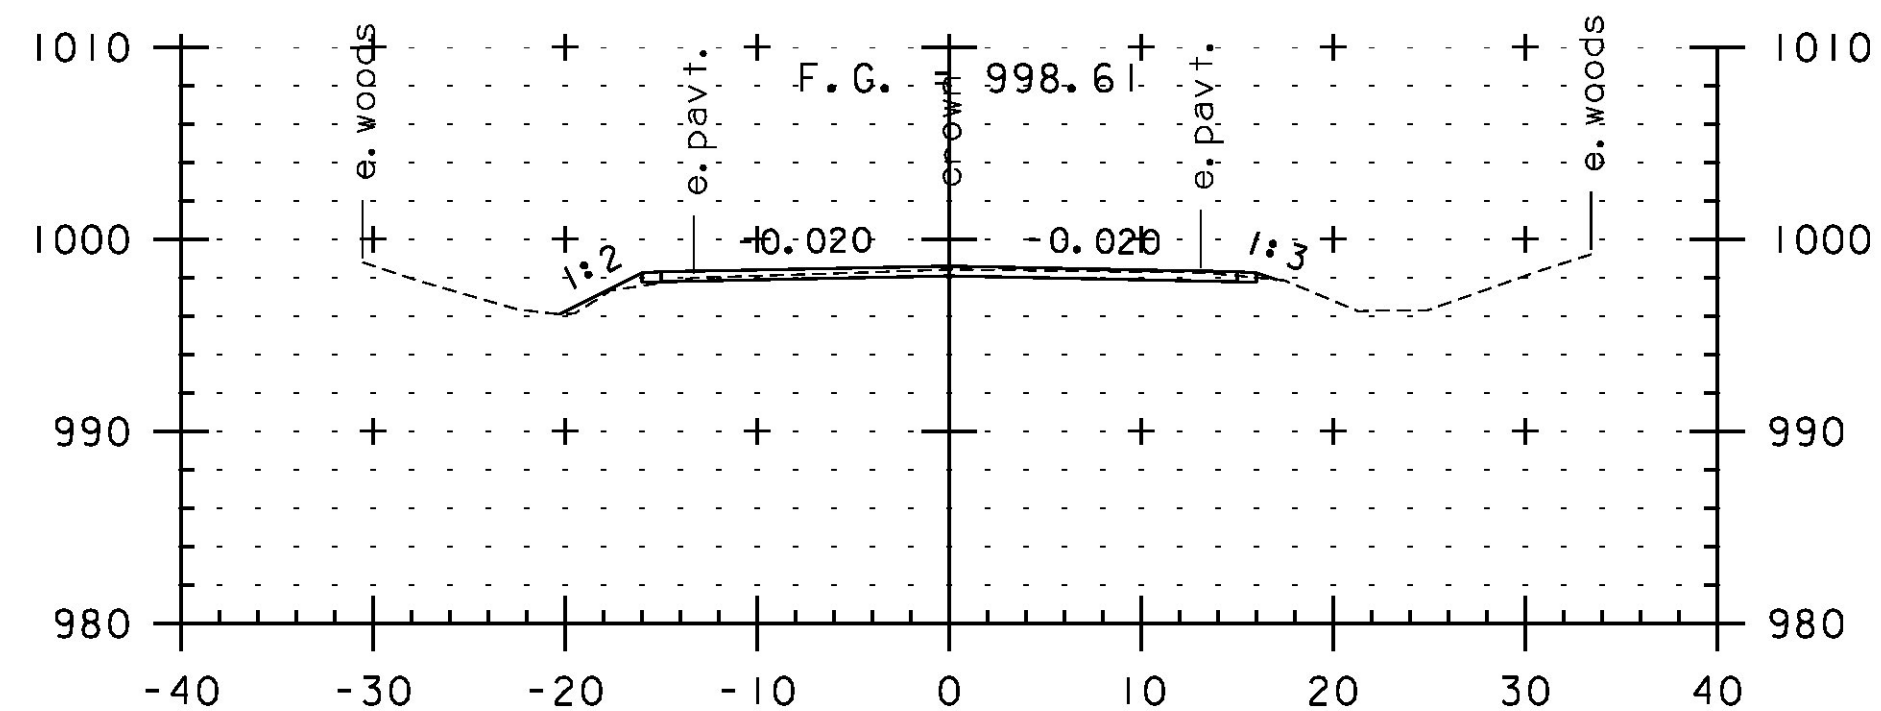


380+50

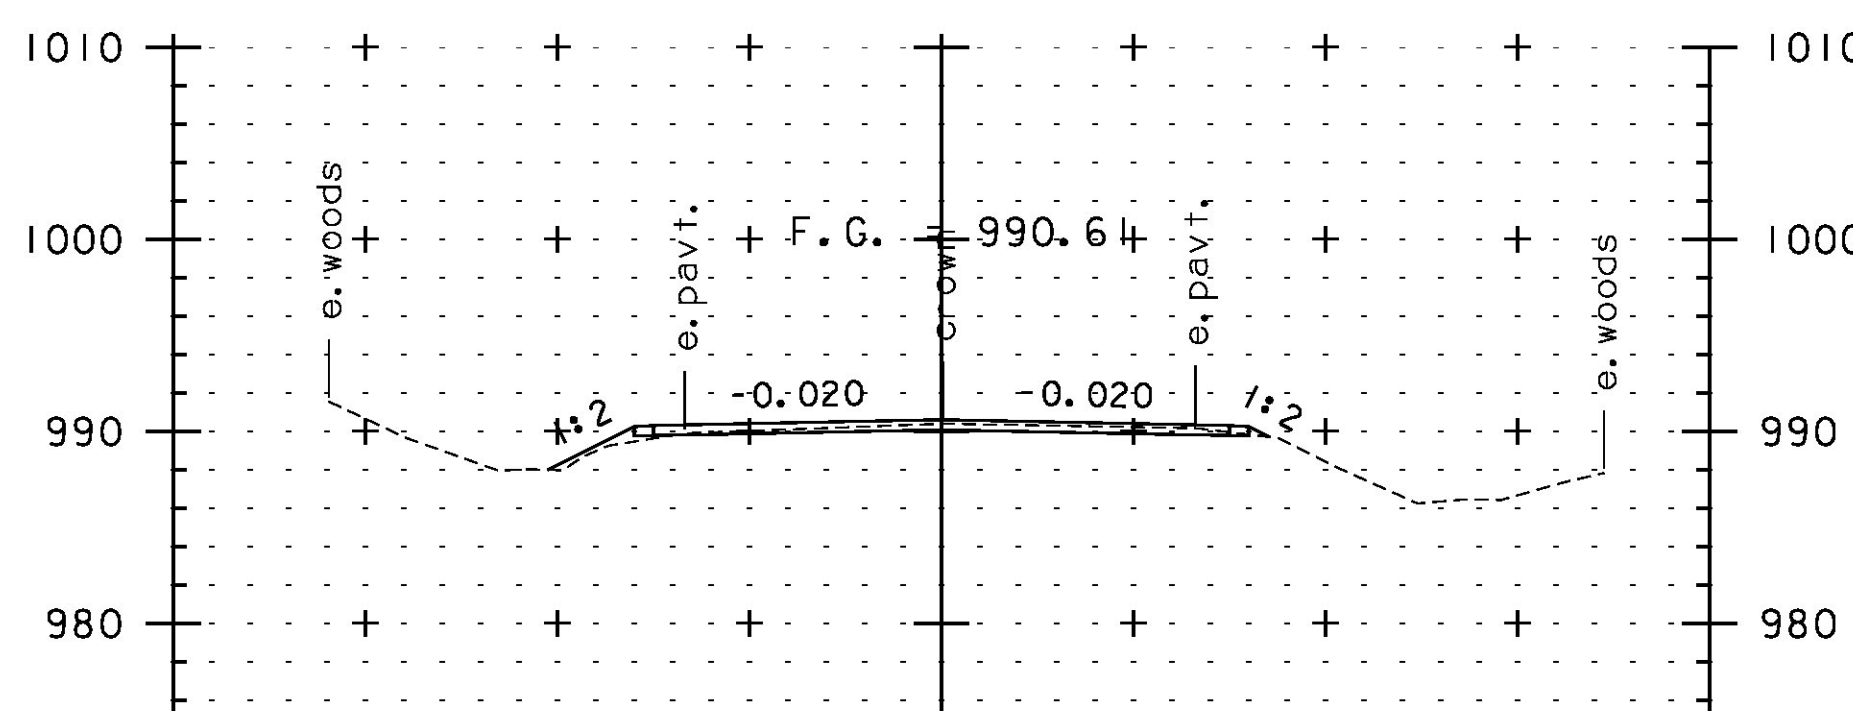


382+00

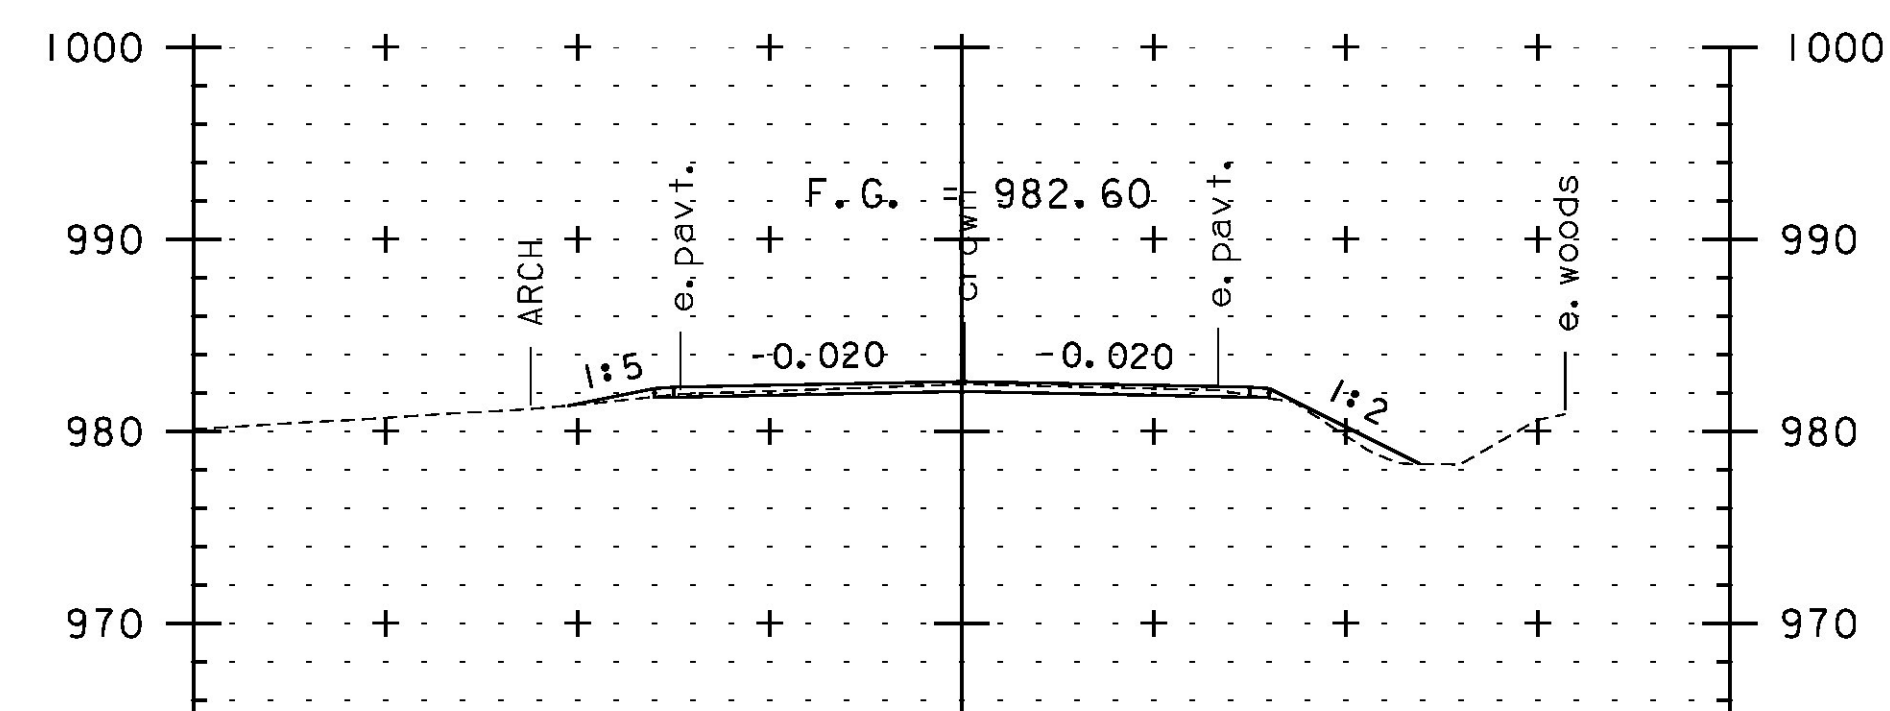


383+50

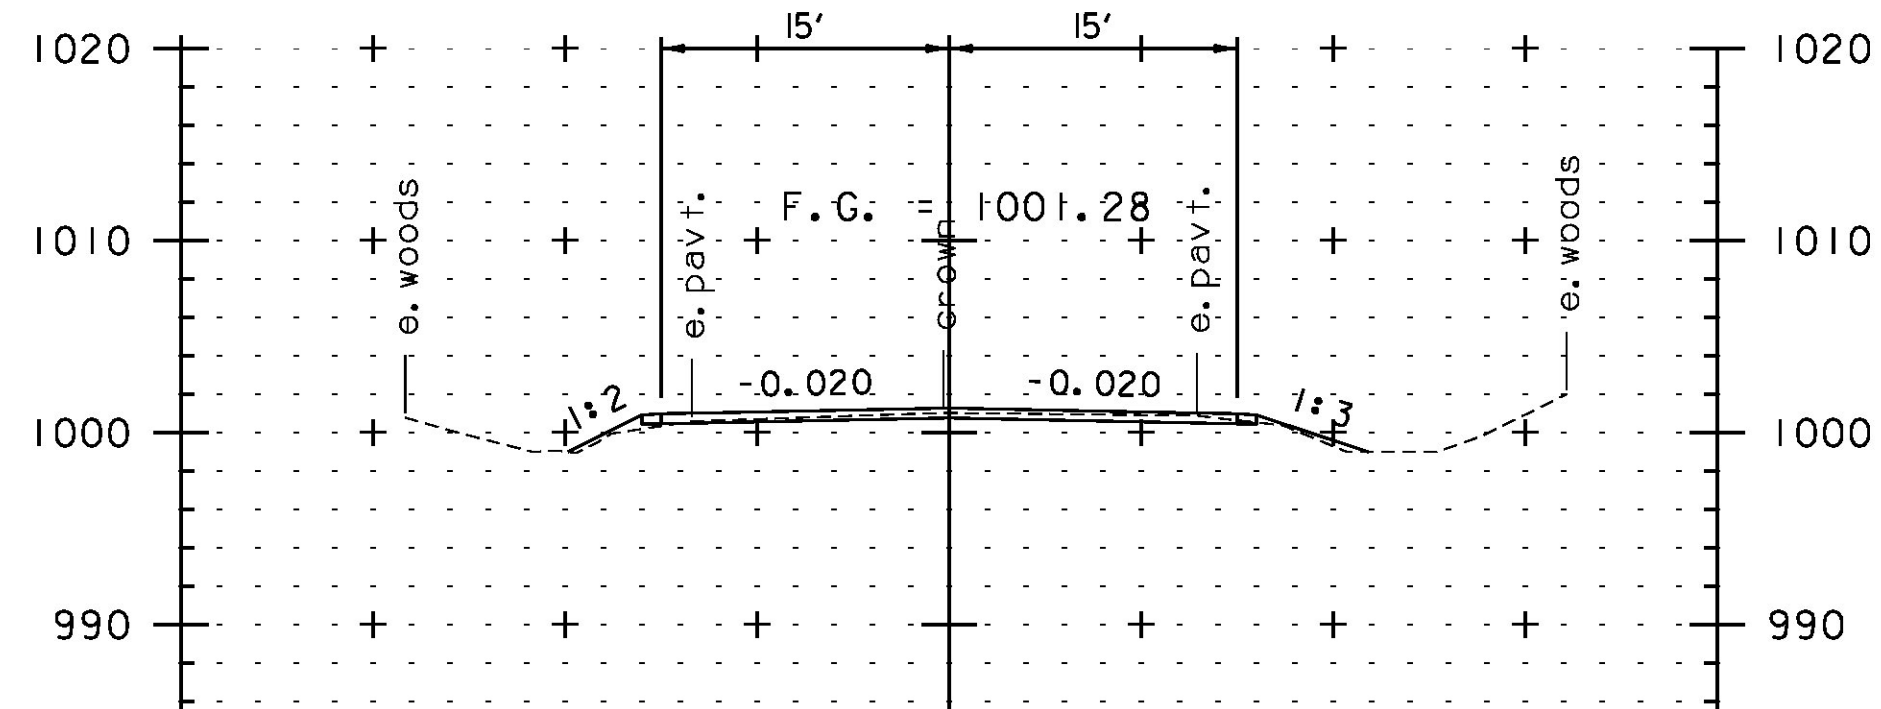

380+00

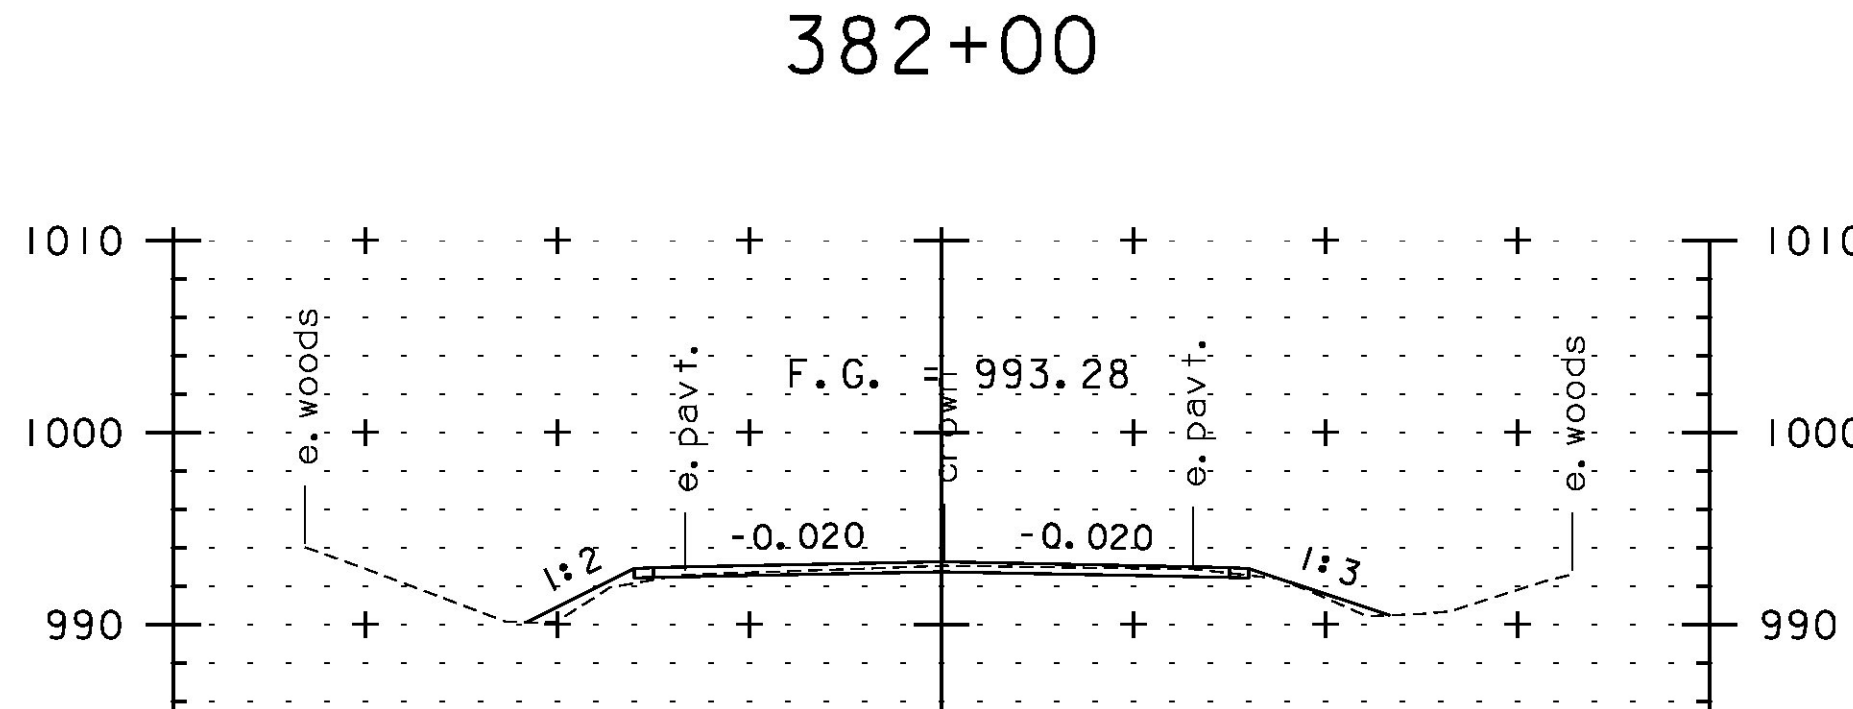

381+50

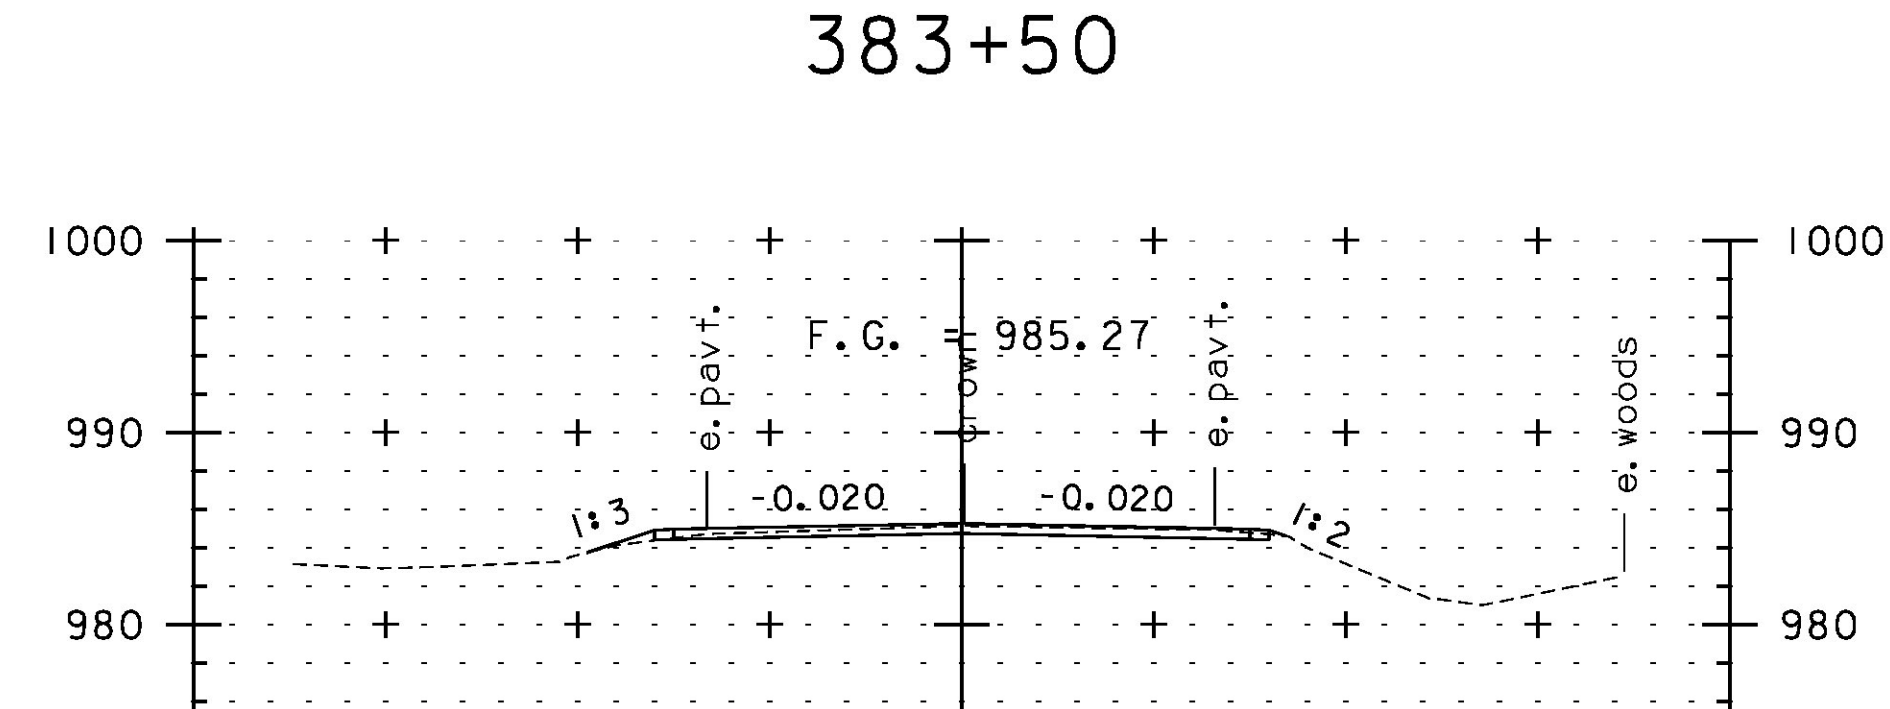

383+00



STA. 380+00 TO STA. 383+92

PROJECT NAME: JAY-TROY
PROJECT NUMBER: STP 2315(I)

FILE NAME: z10b232xs.dgn
PROJECT LEADER: P. SHEDD
DESIGNED BY: N. LEMAY
CROSS SECTION SHEET 87

PLOT DATE: 5/16/2014
DRAWN BY: W. GORDON
CHECKED BY: P. SHEDD
SHEET 223 OF 244