




385+00

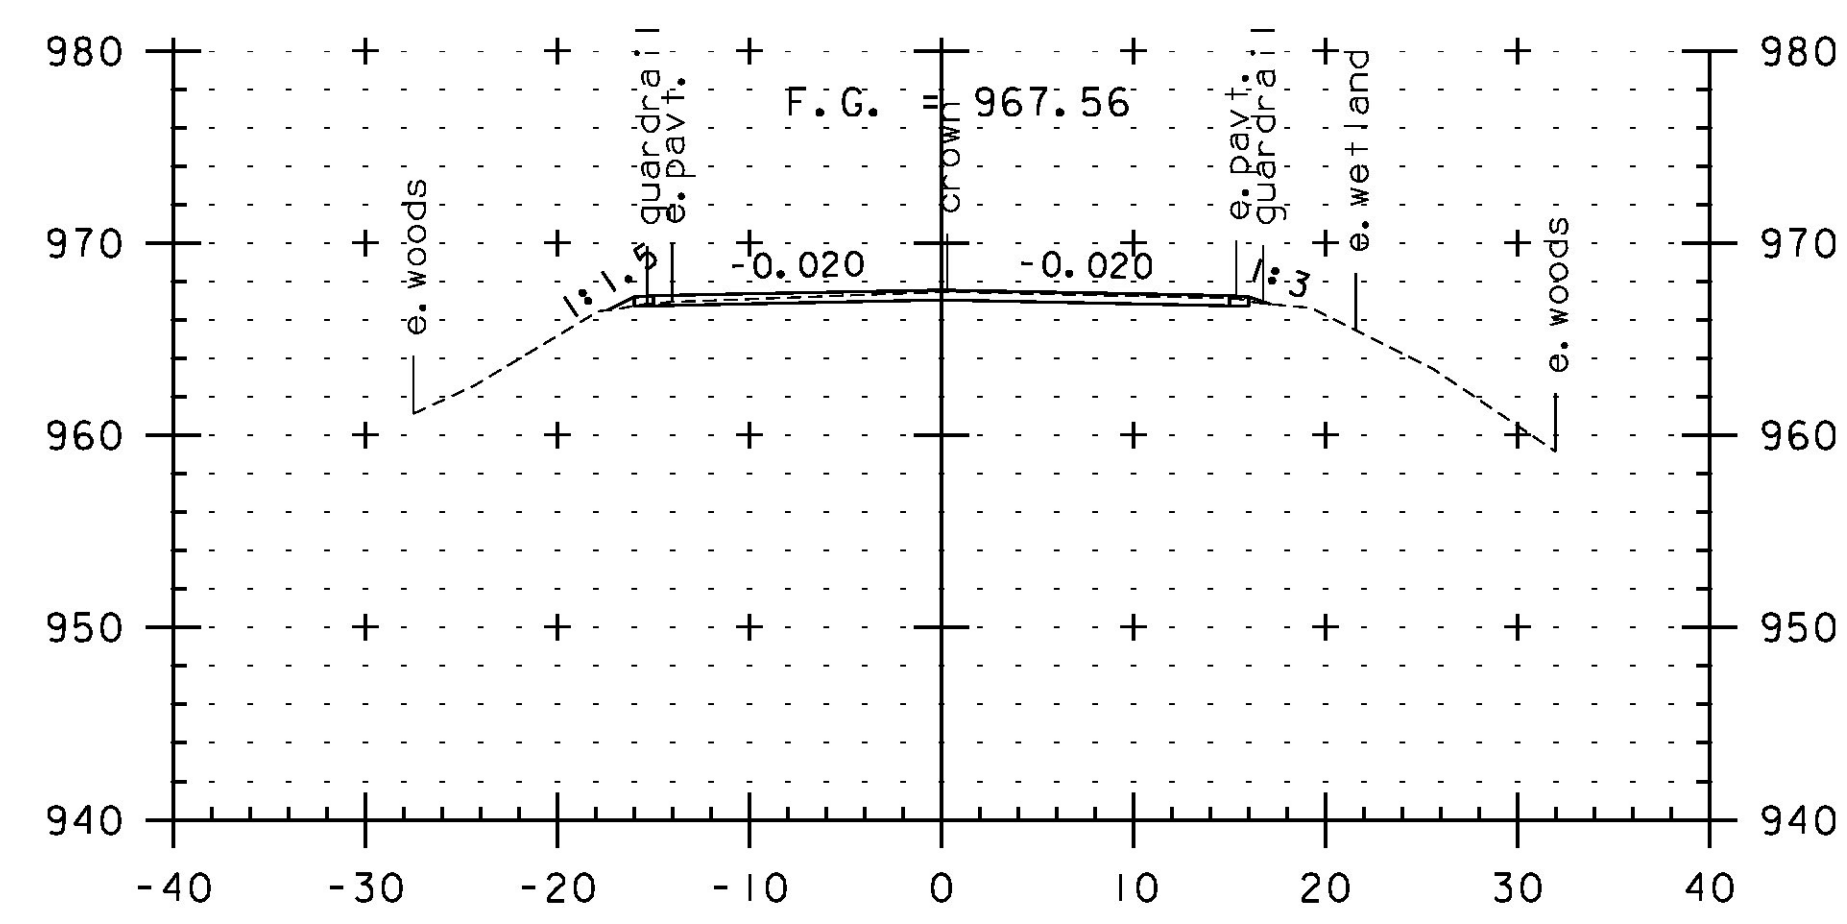


386+50

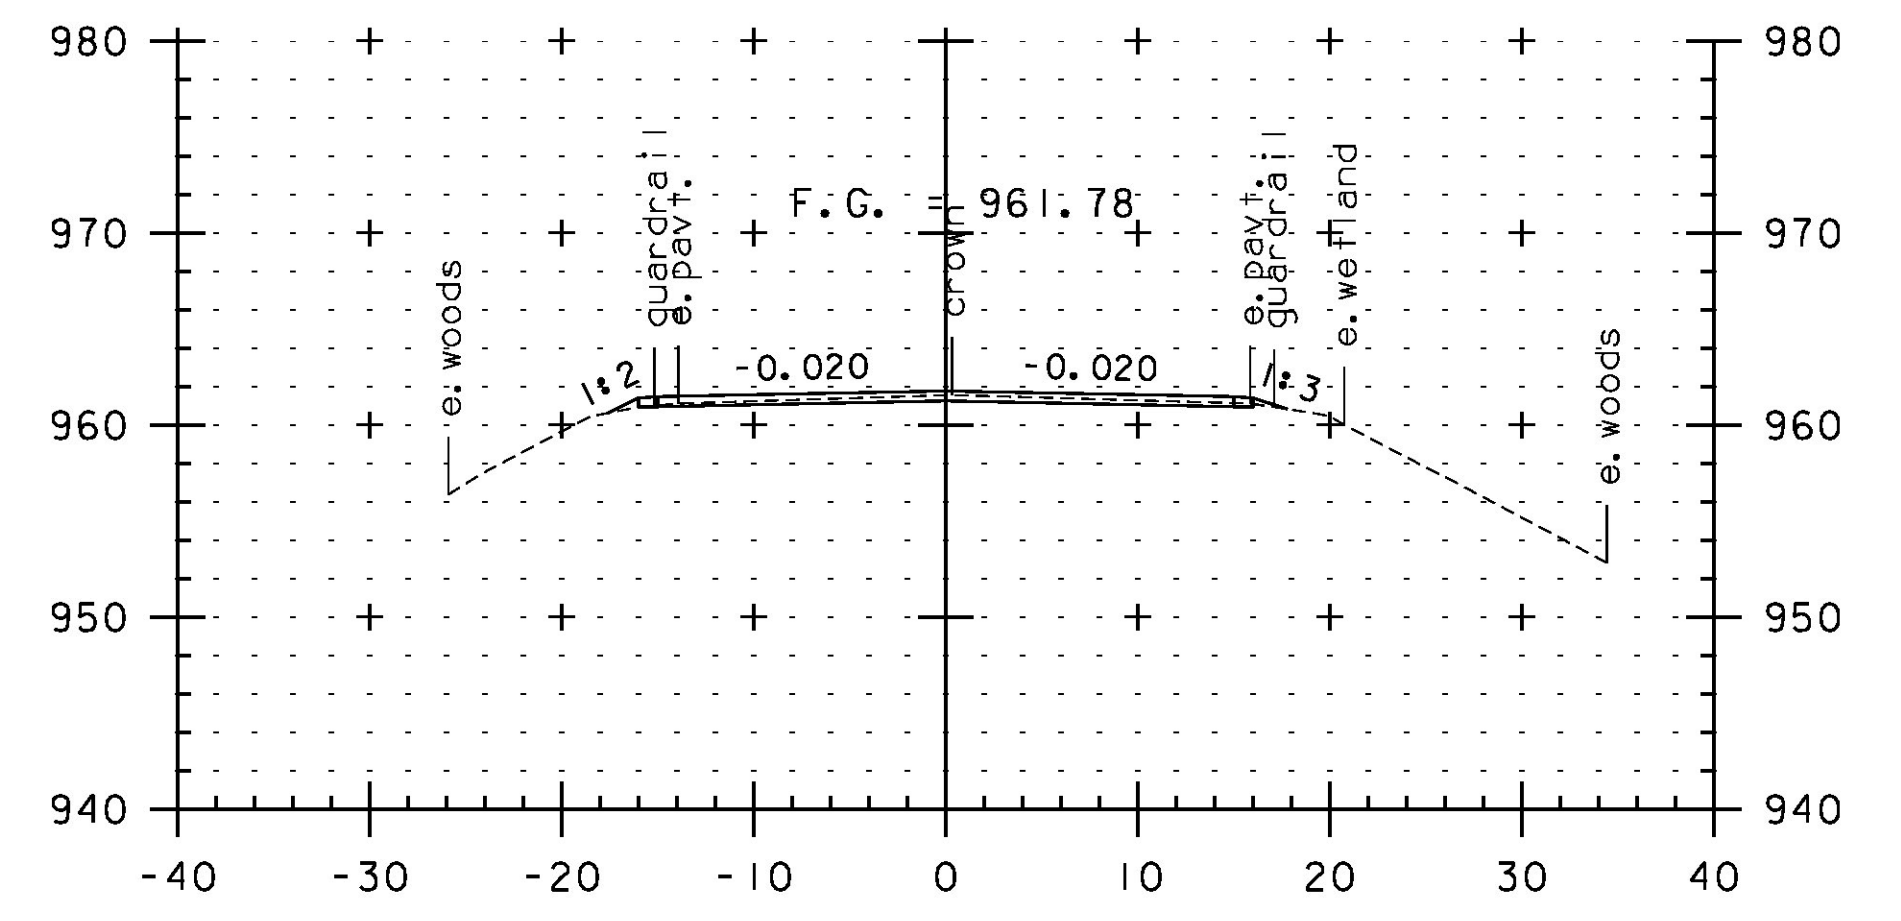


388+00

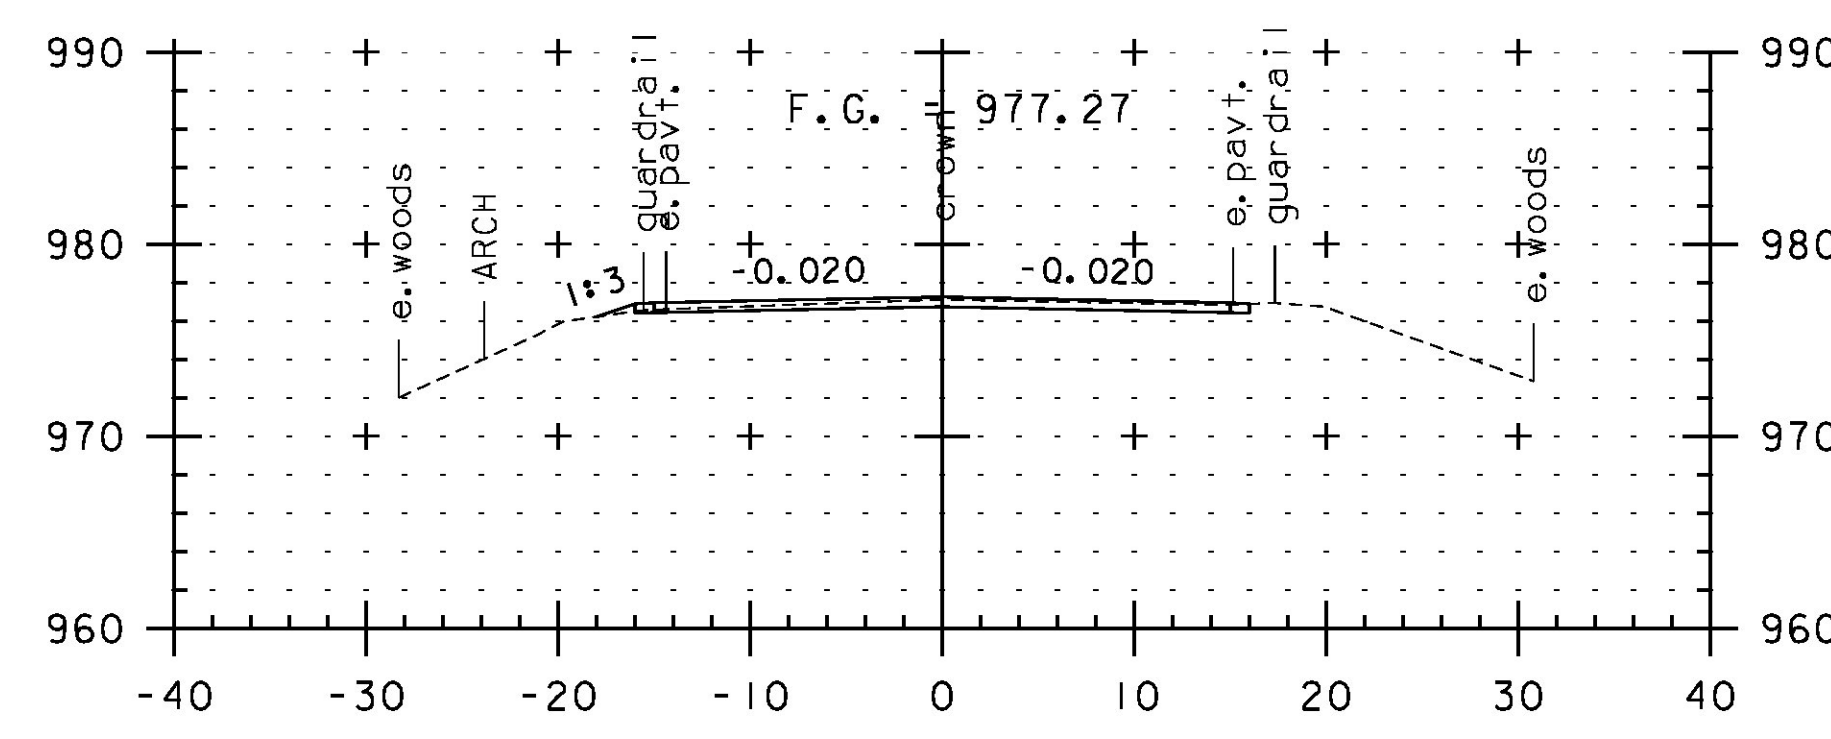


384+50

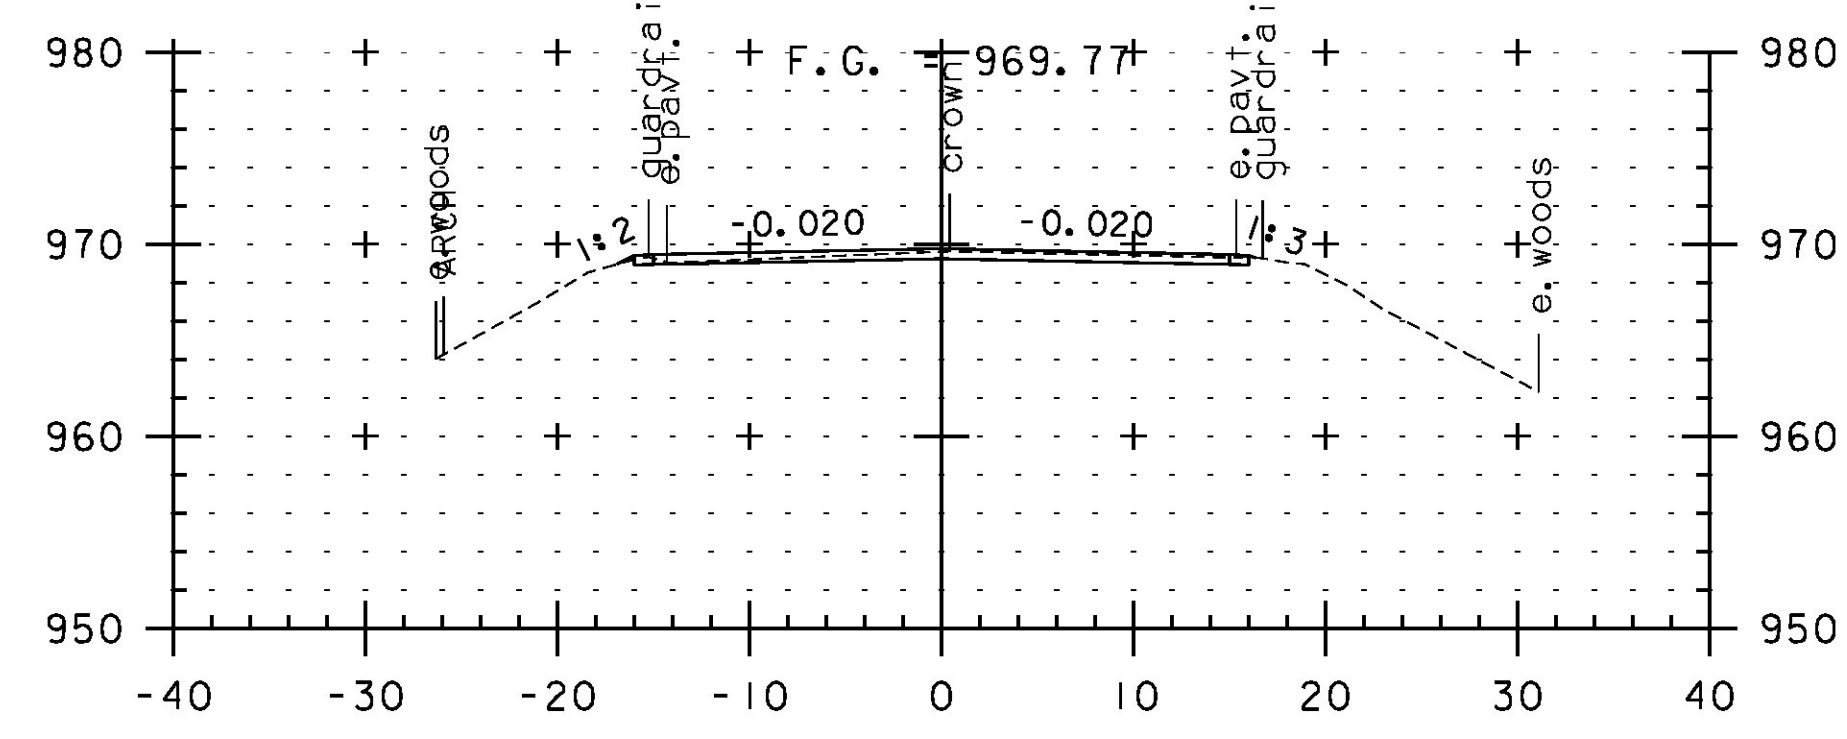


386+00

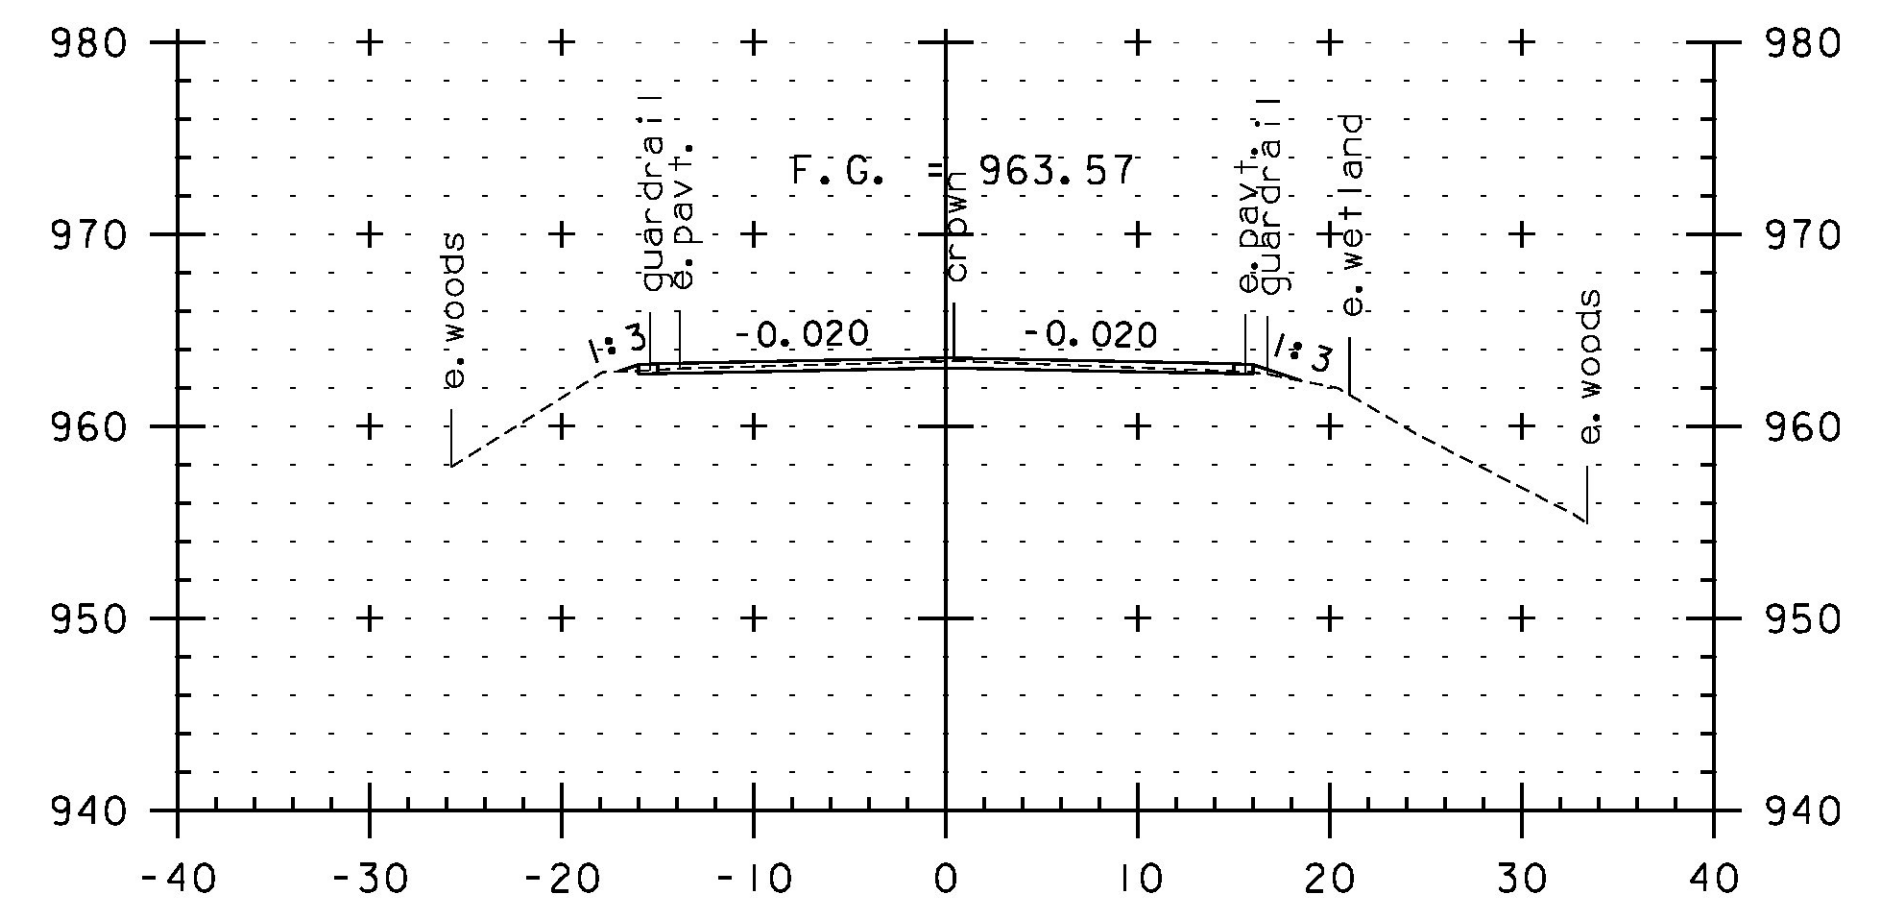


387+50

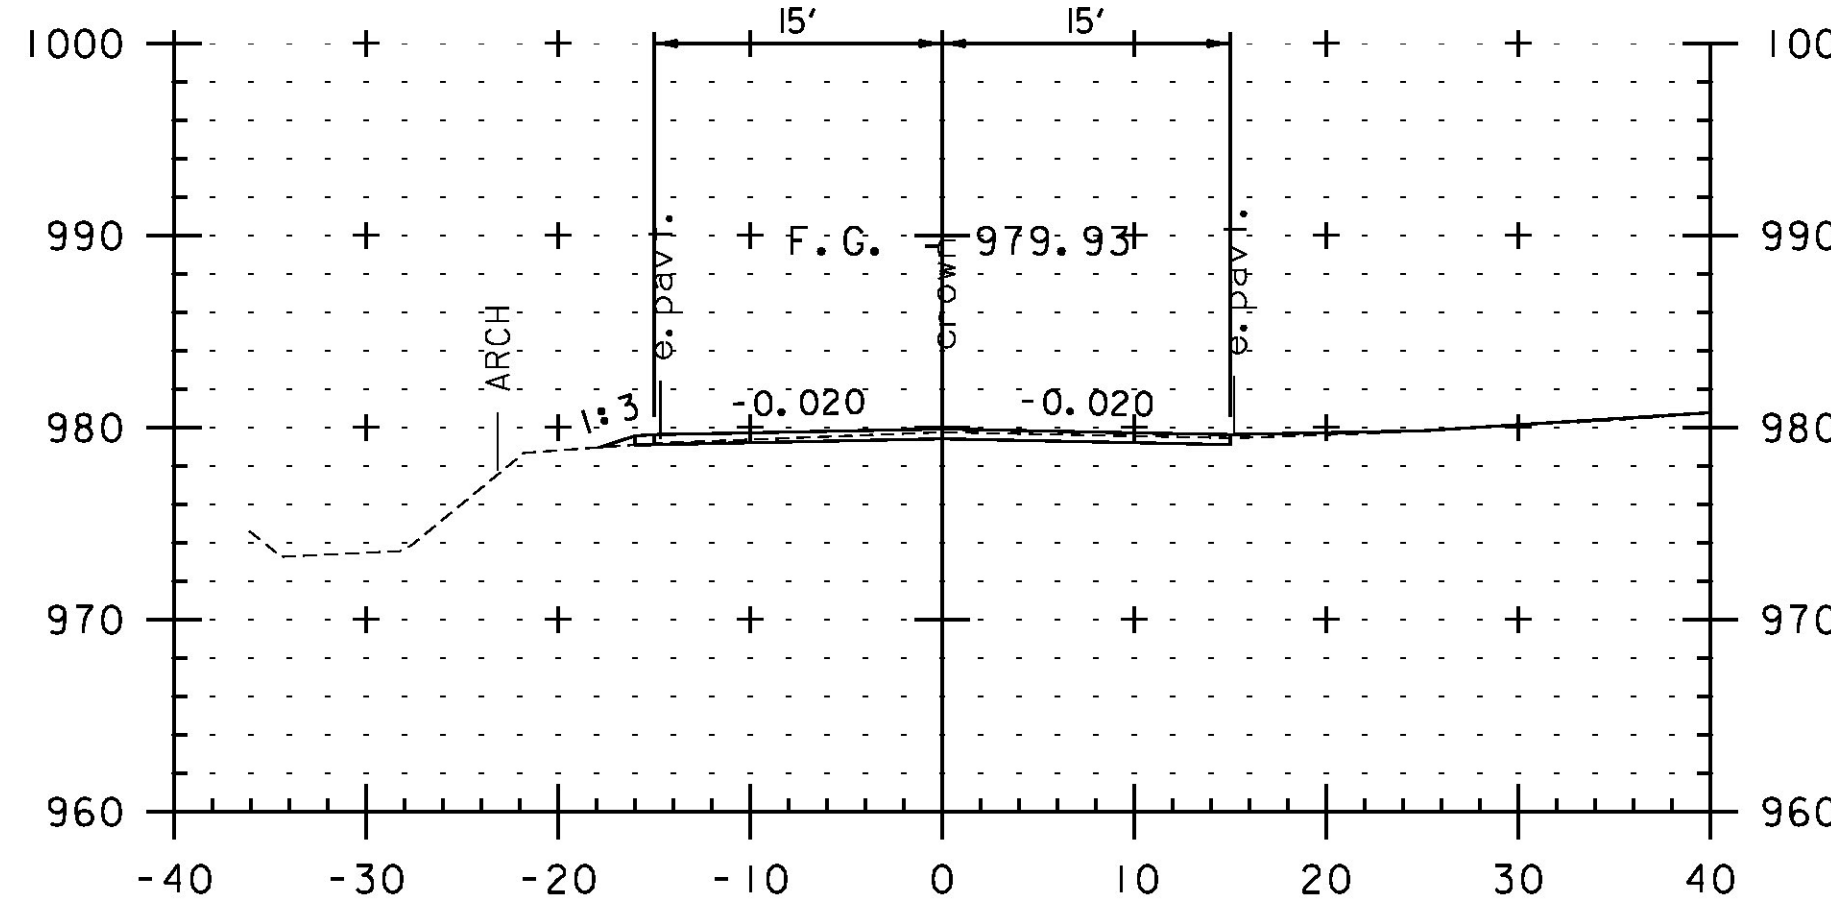


384+00

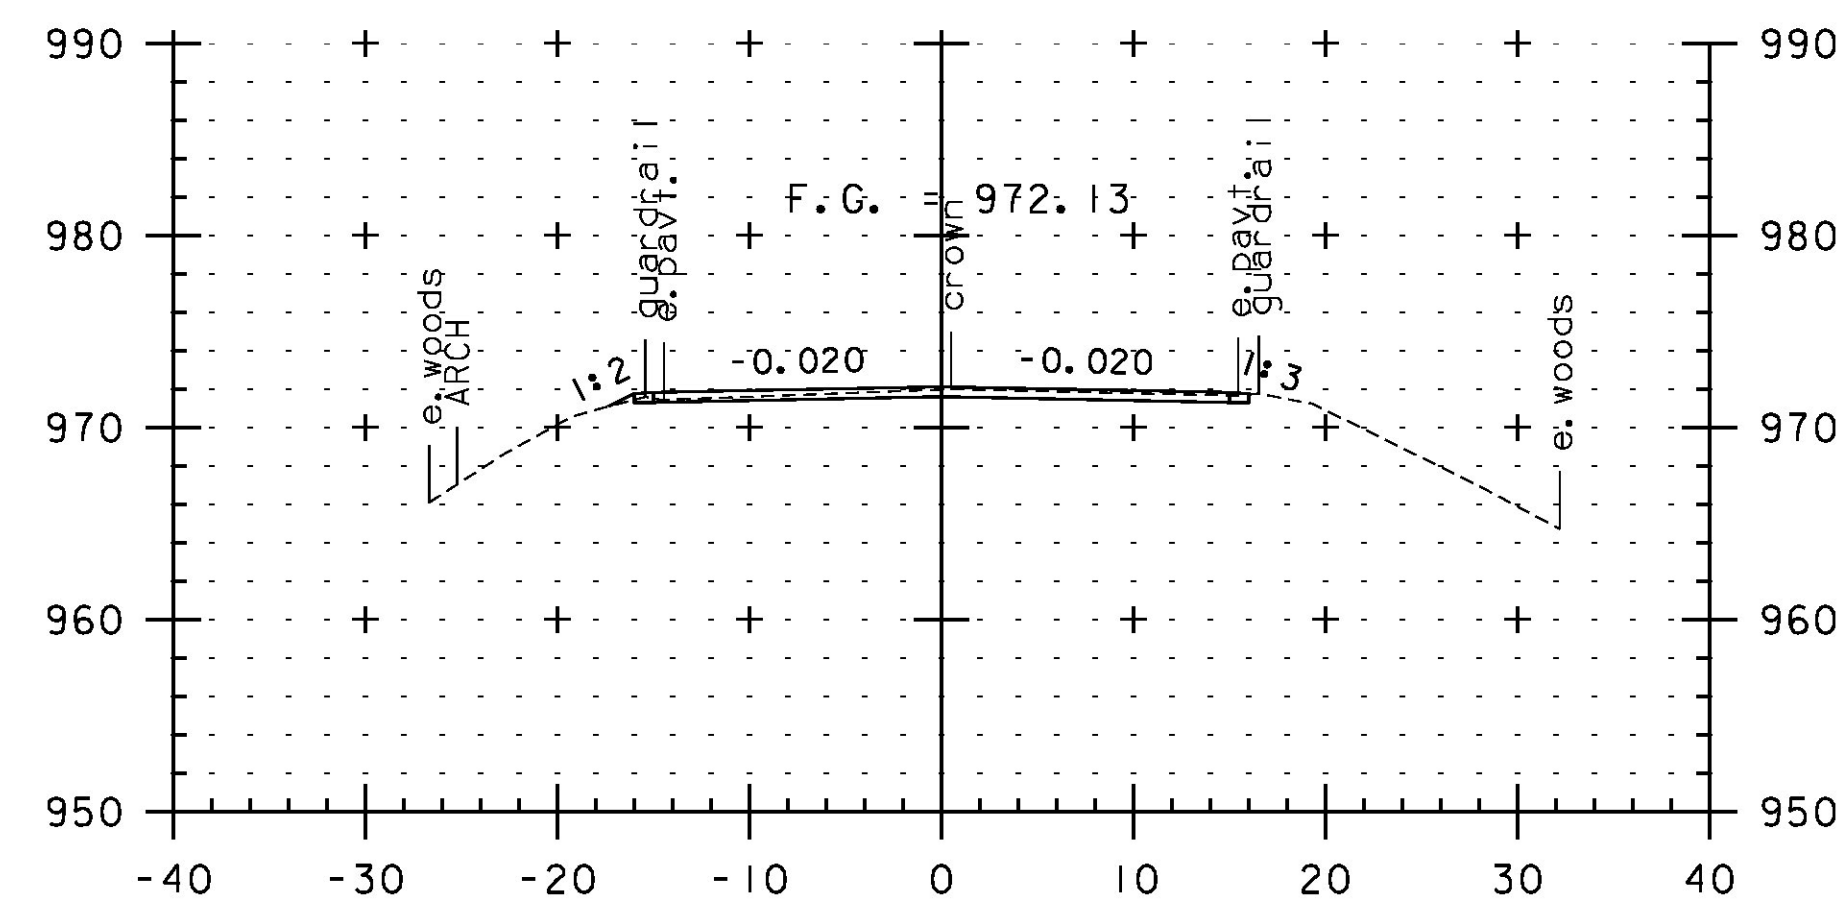

385+50

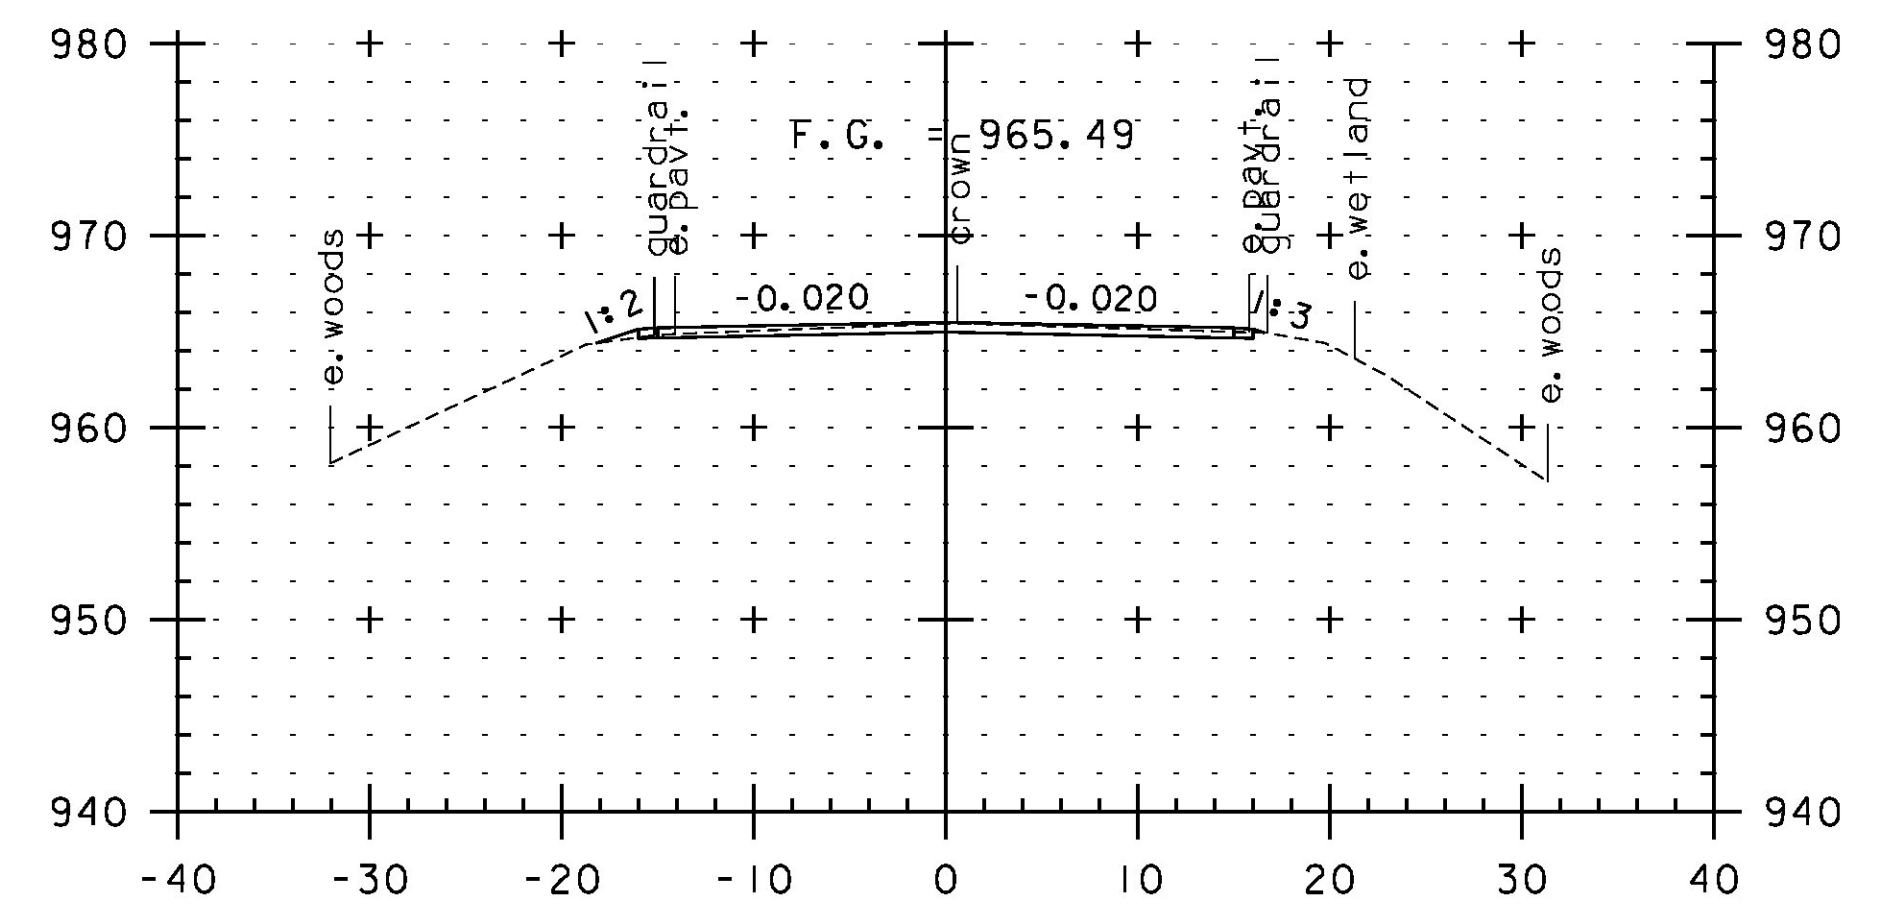

387+00

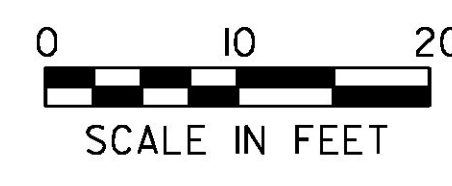

SCALE IN FEET

STA. 384+00 TO STA. 388+00

PROJECT NAME:	JAY-TROY	PLOT DATE:	5/16/2014
PROJECT NUMBER:	STP 2315(1)	DRAWN BY:	W. GORDON
FILE NAME:	z10b232xs.dgn	CHECKED BY:	P. SHEDD
PROJECT LEADER:	P. SHEDD	CROSS SECTION SHEET	88
DESIGNED BY:	N. LEMAY	SHEET	224 OF 244