




394+00

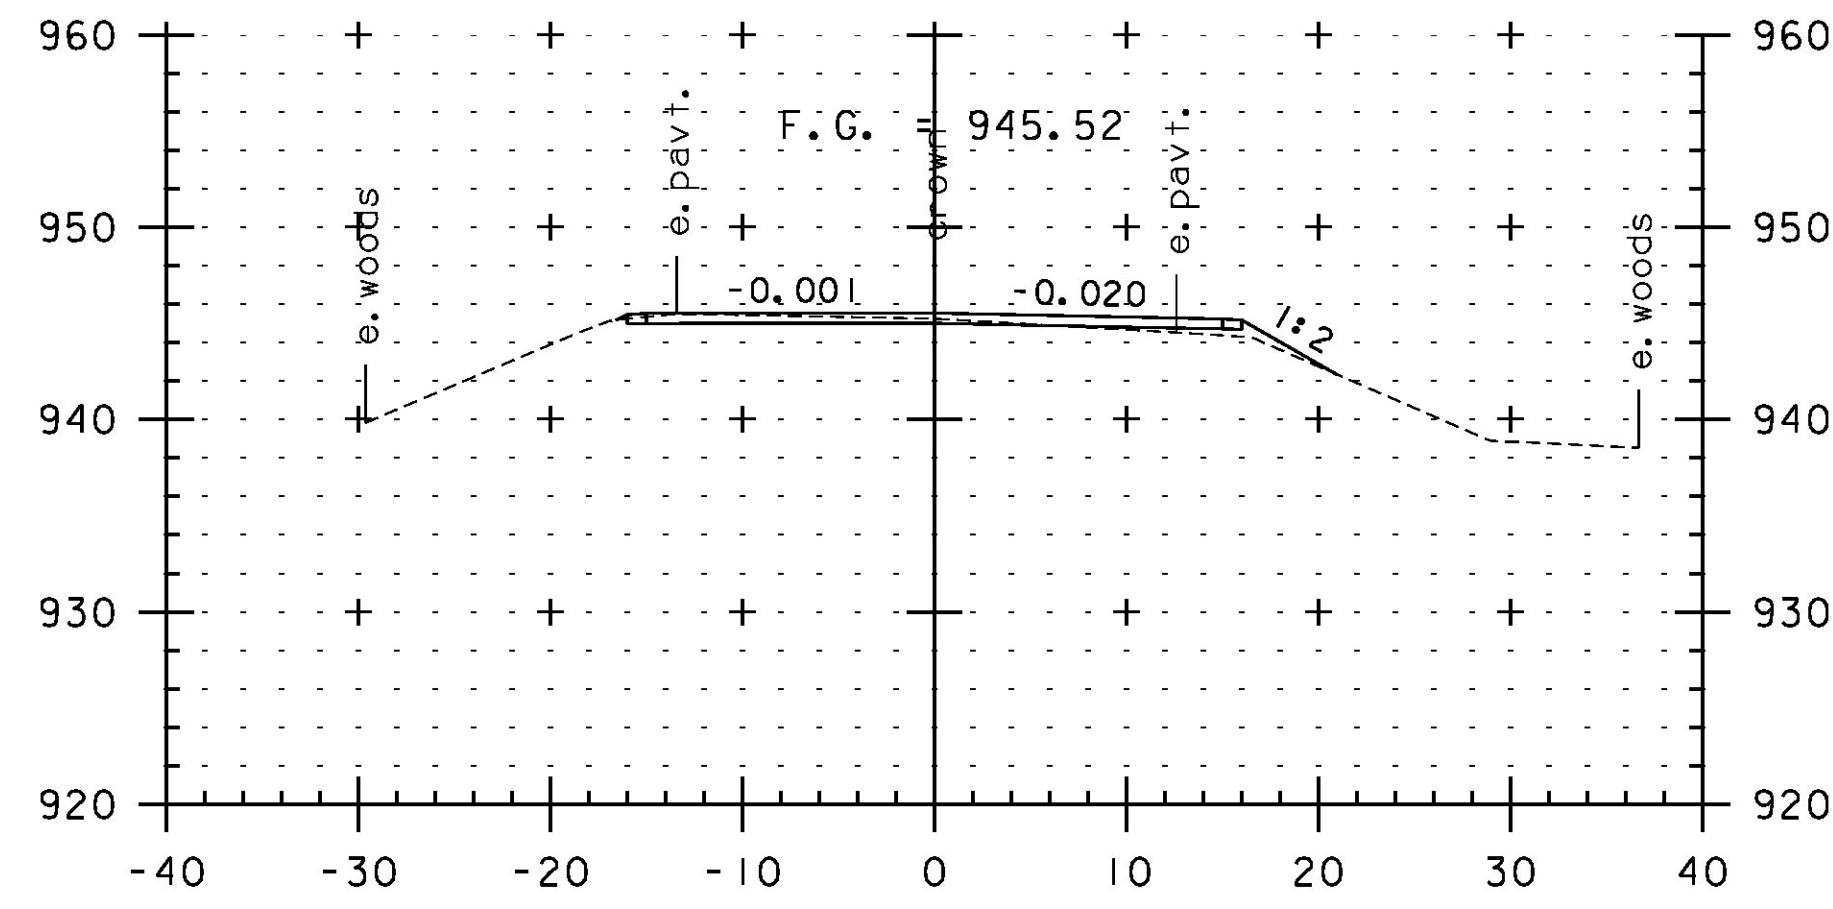


395+50

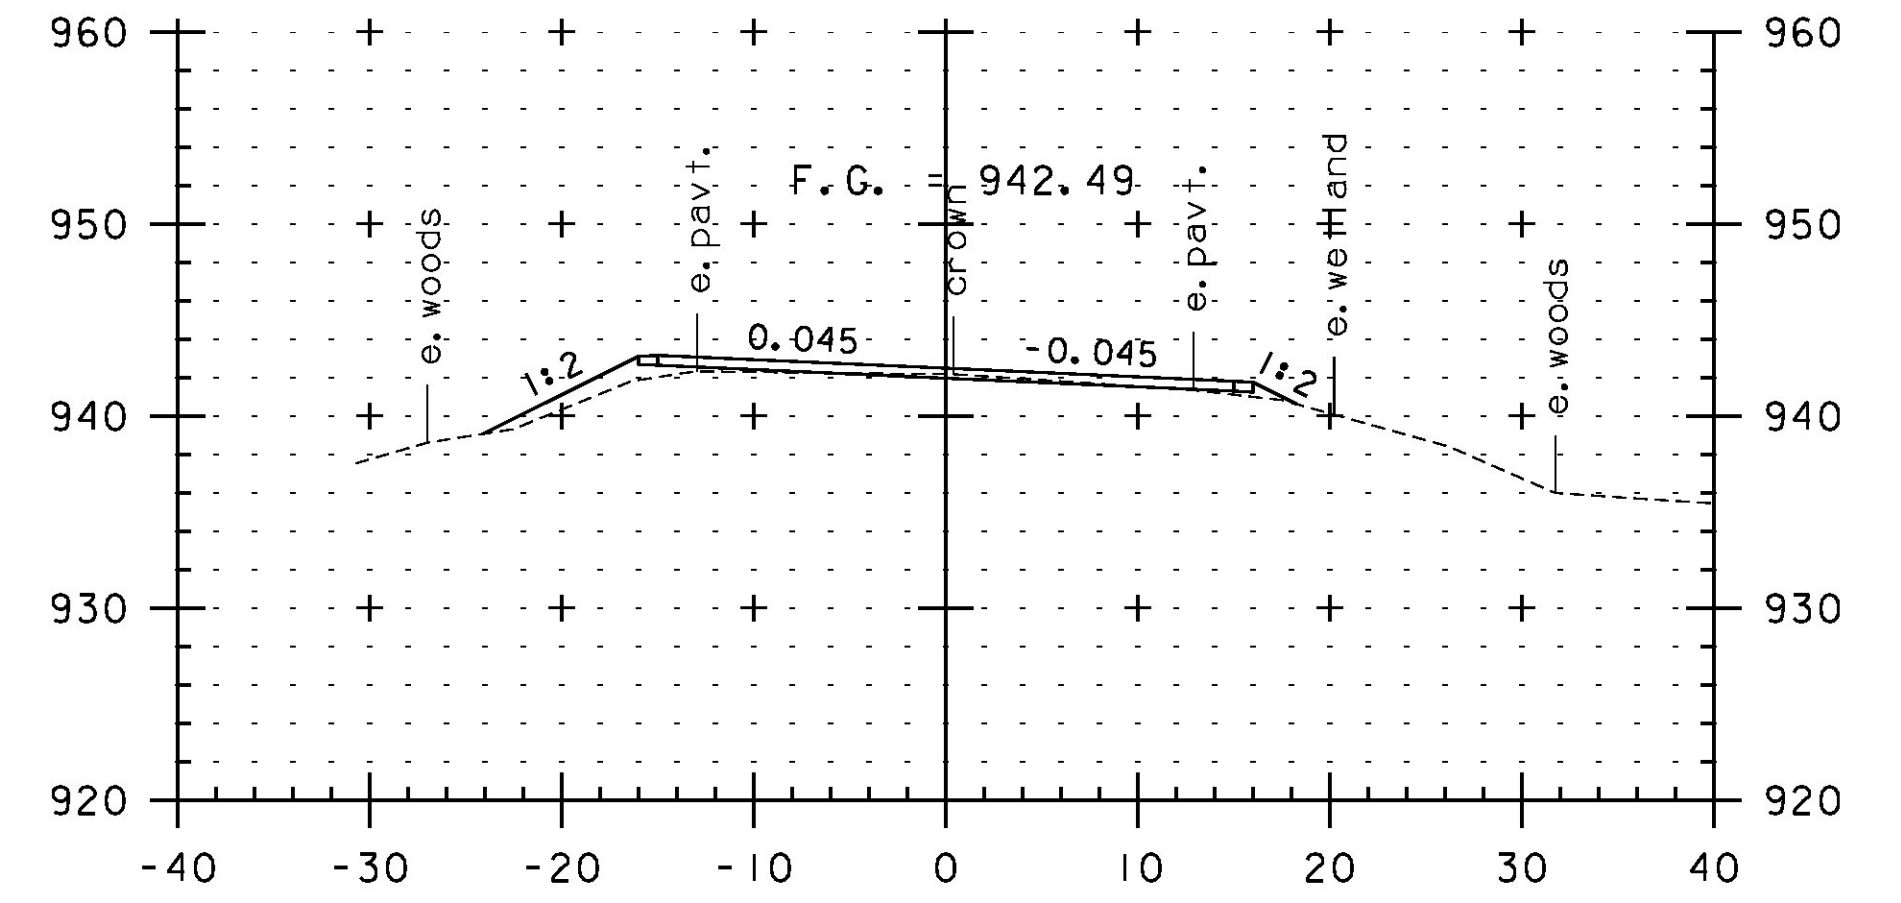


397+00

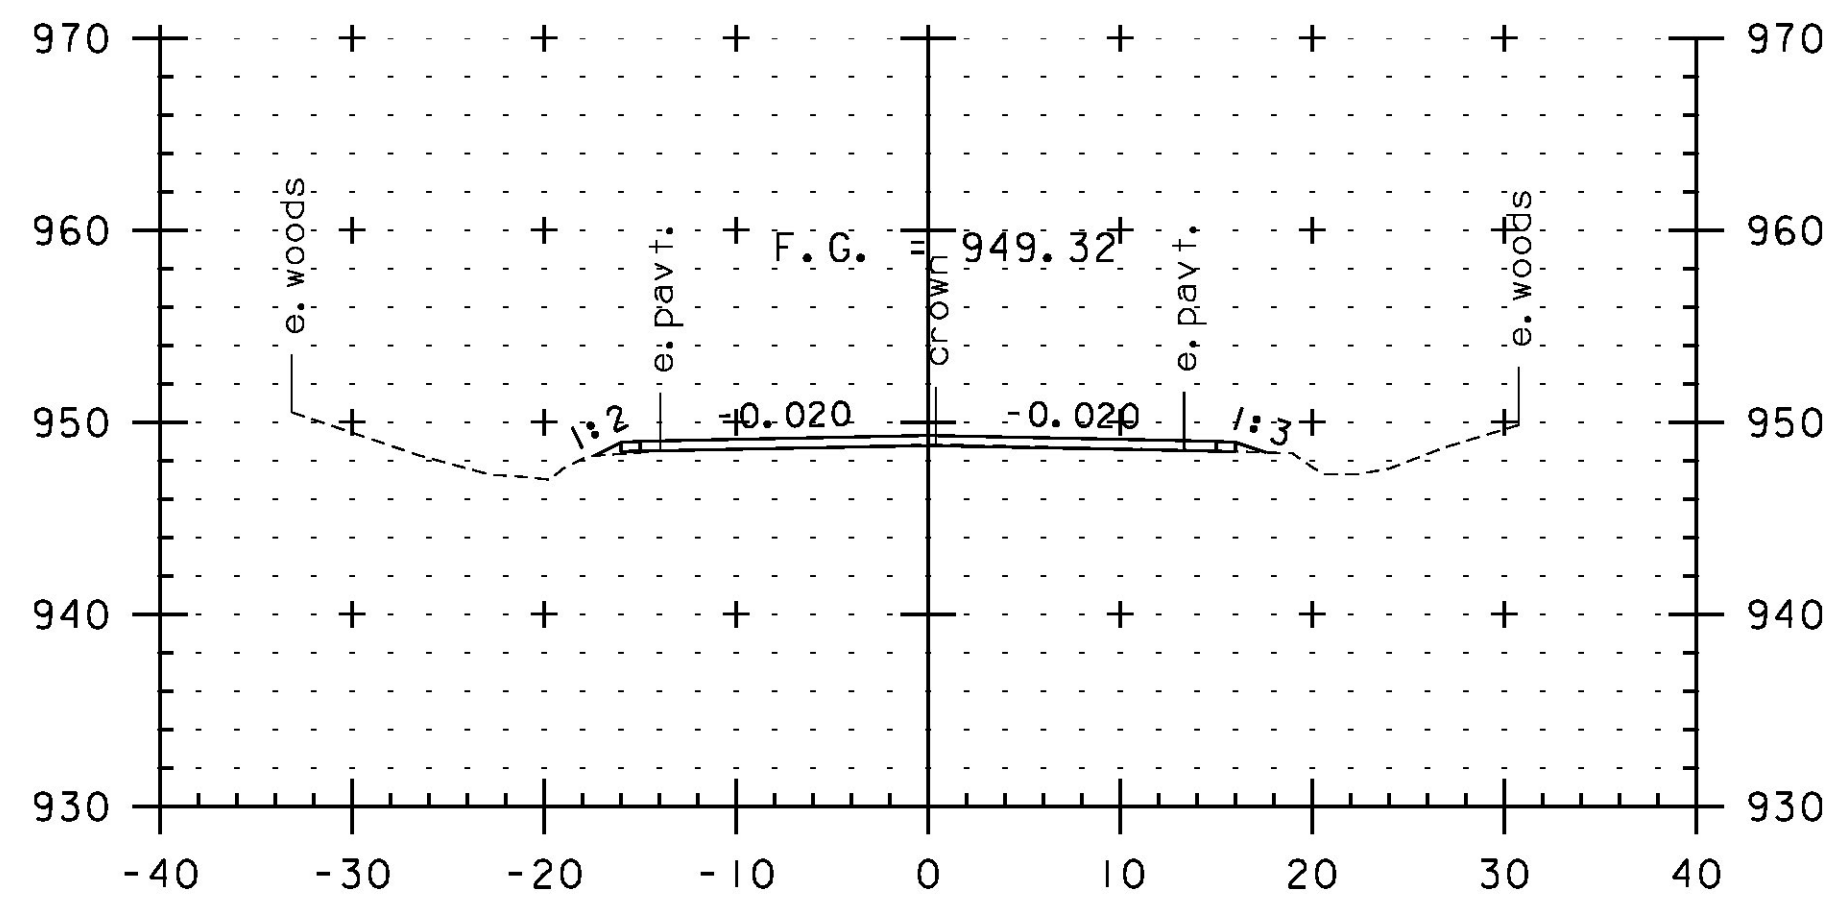


393+50

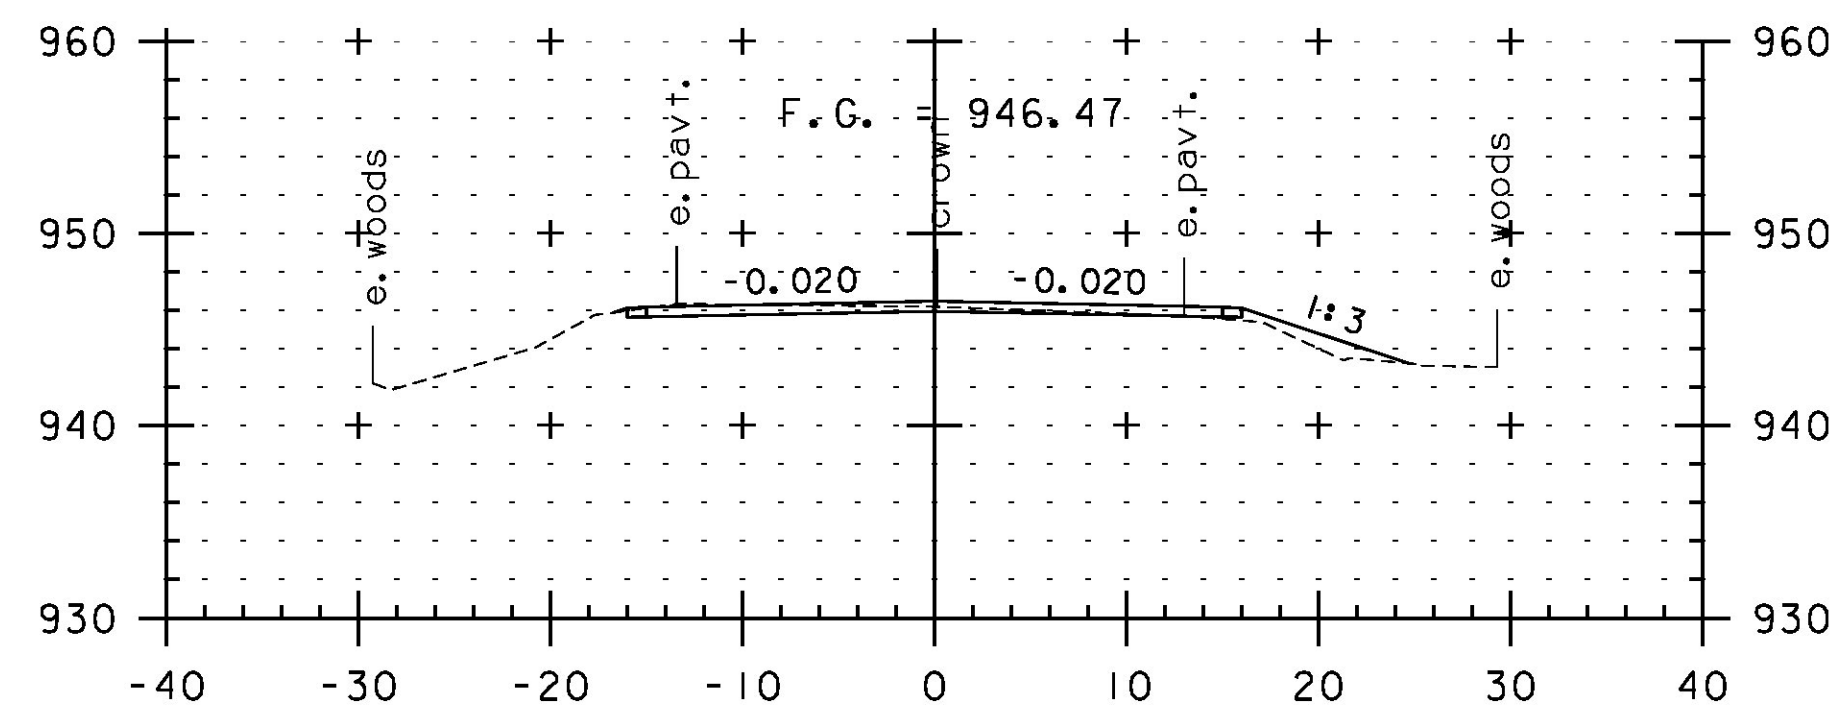


395+00

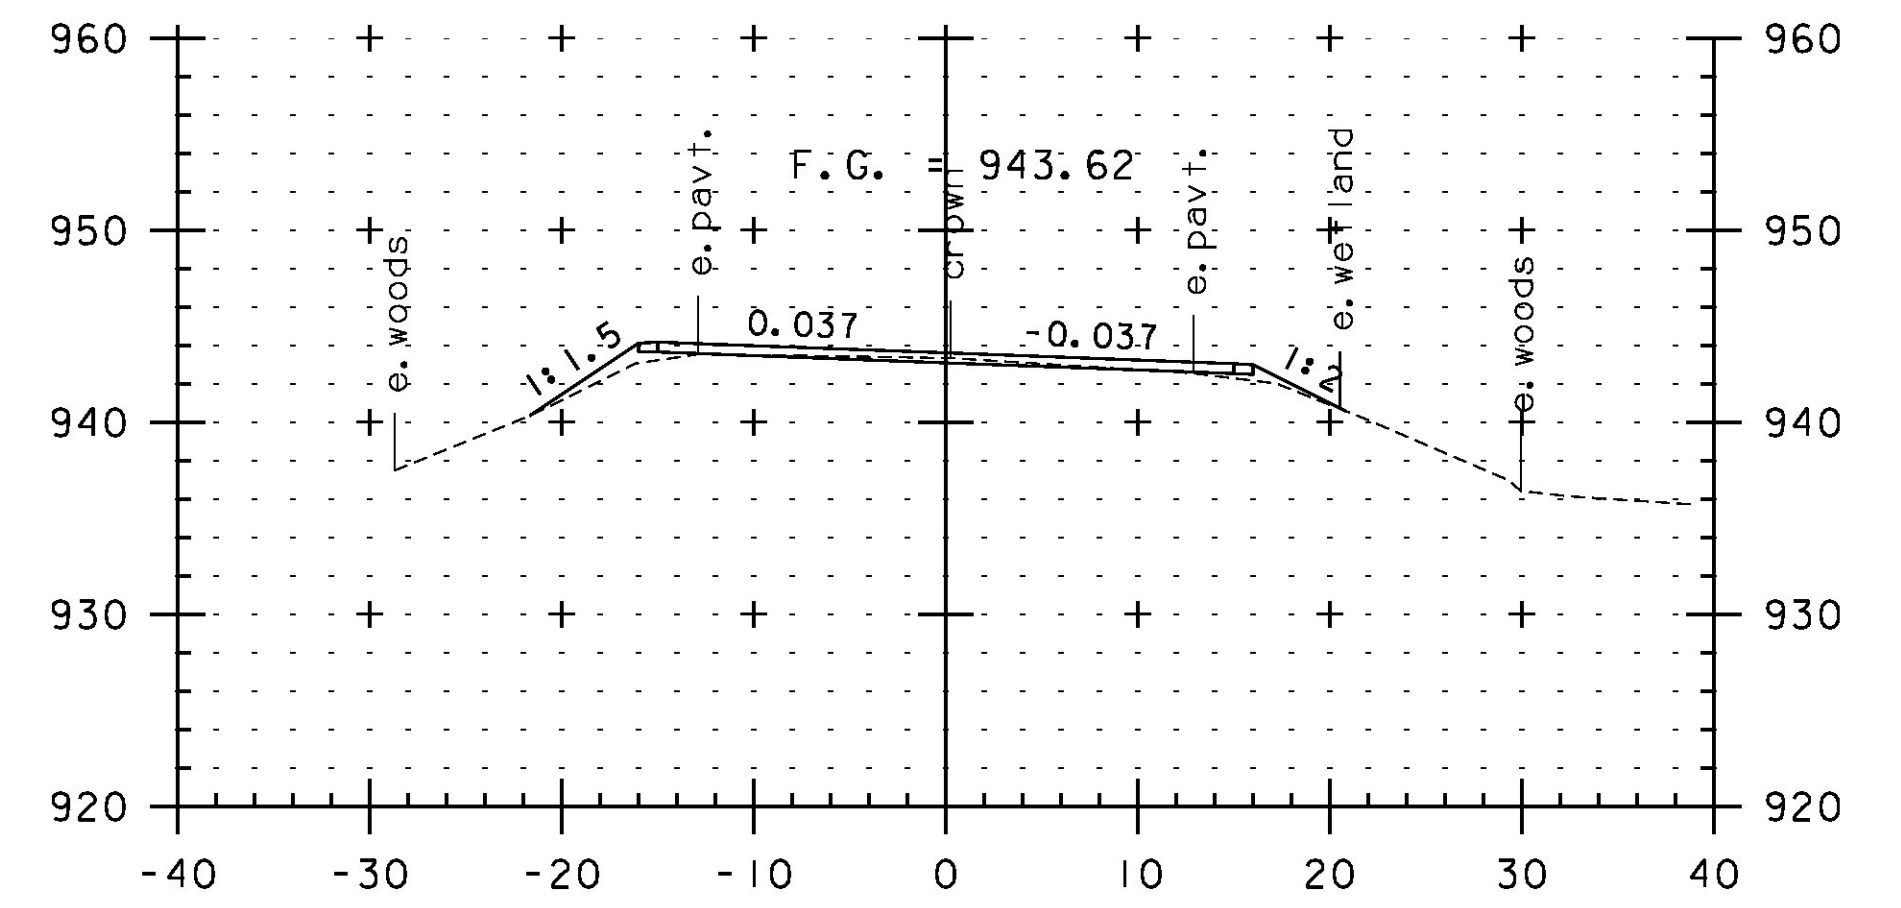


396+50

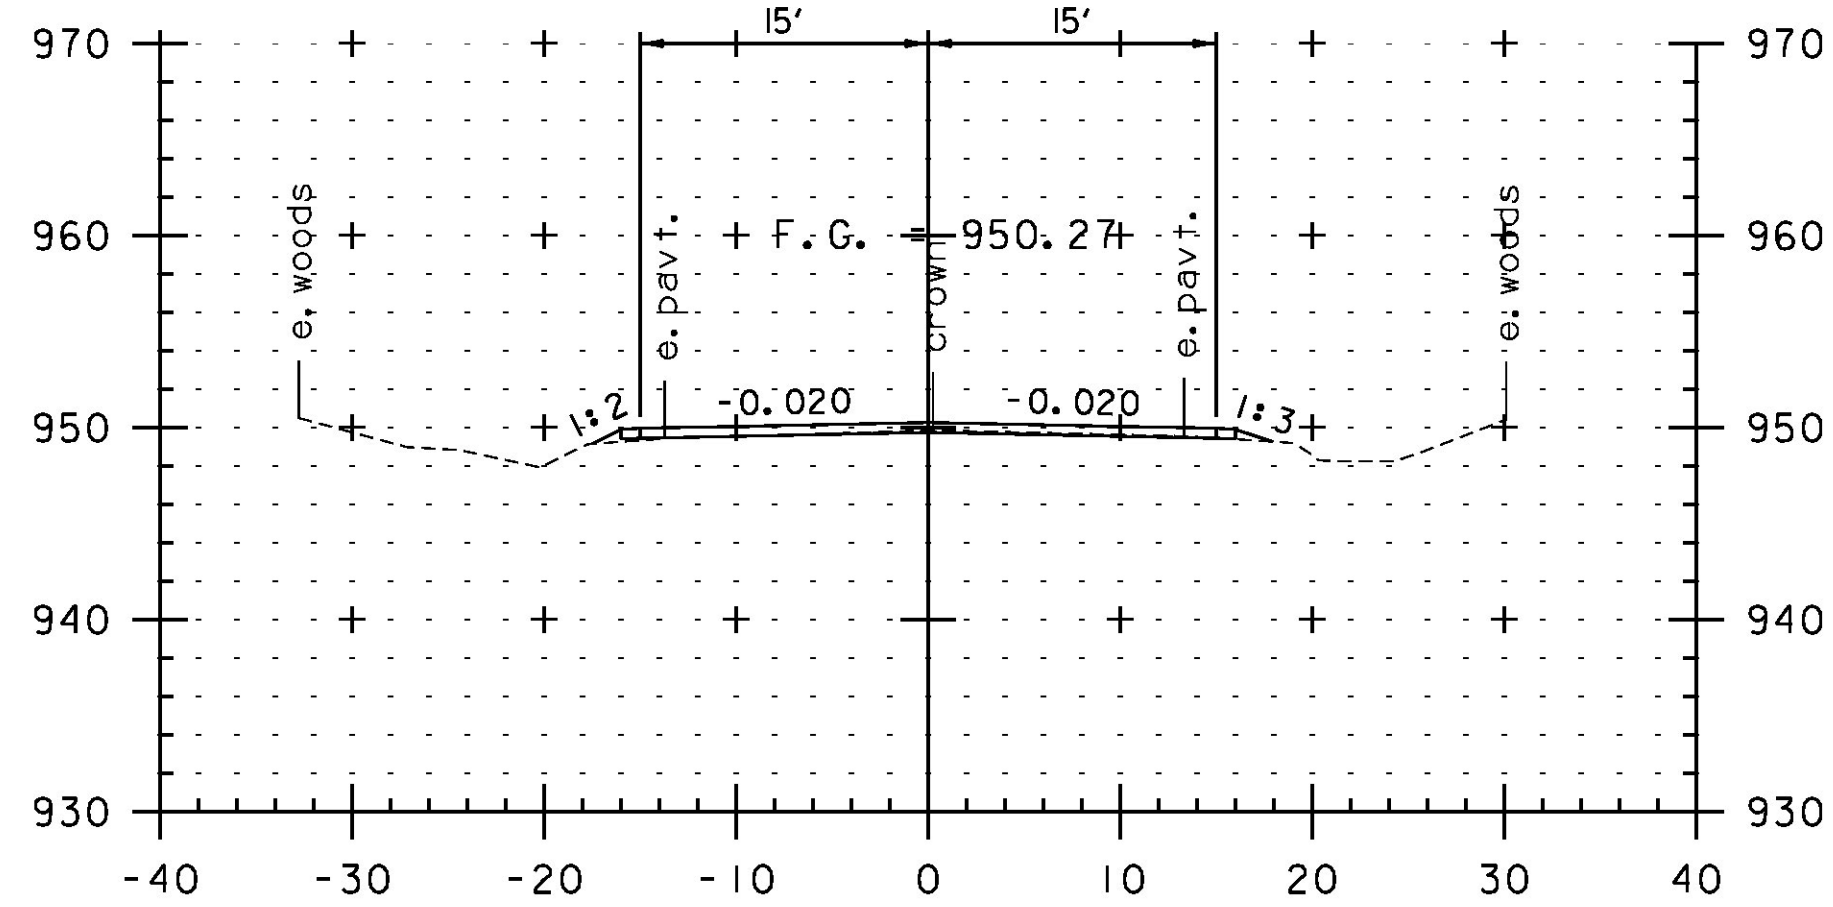

393+00

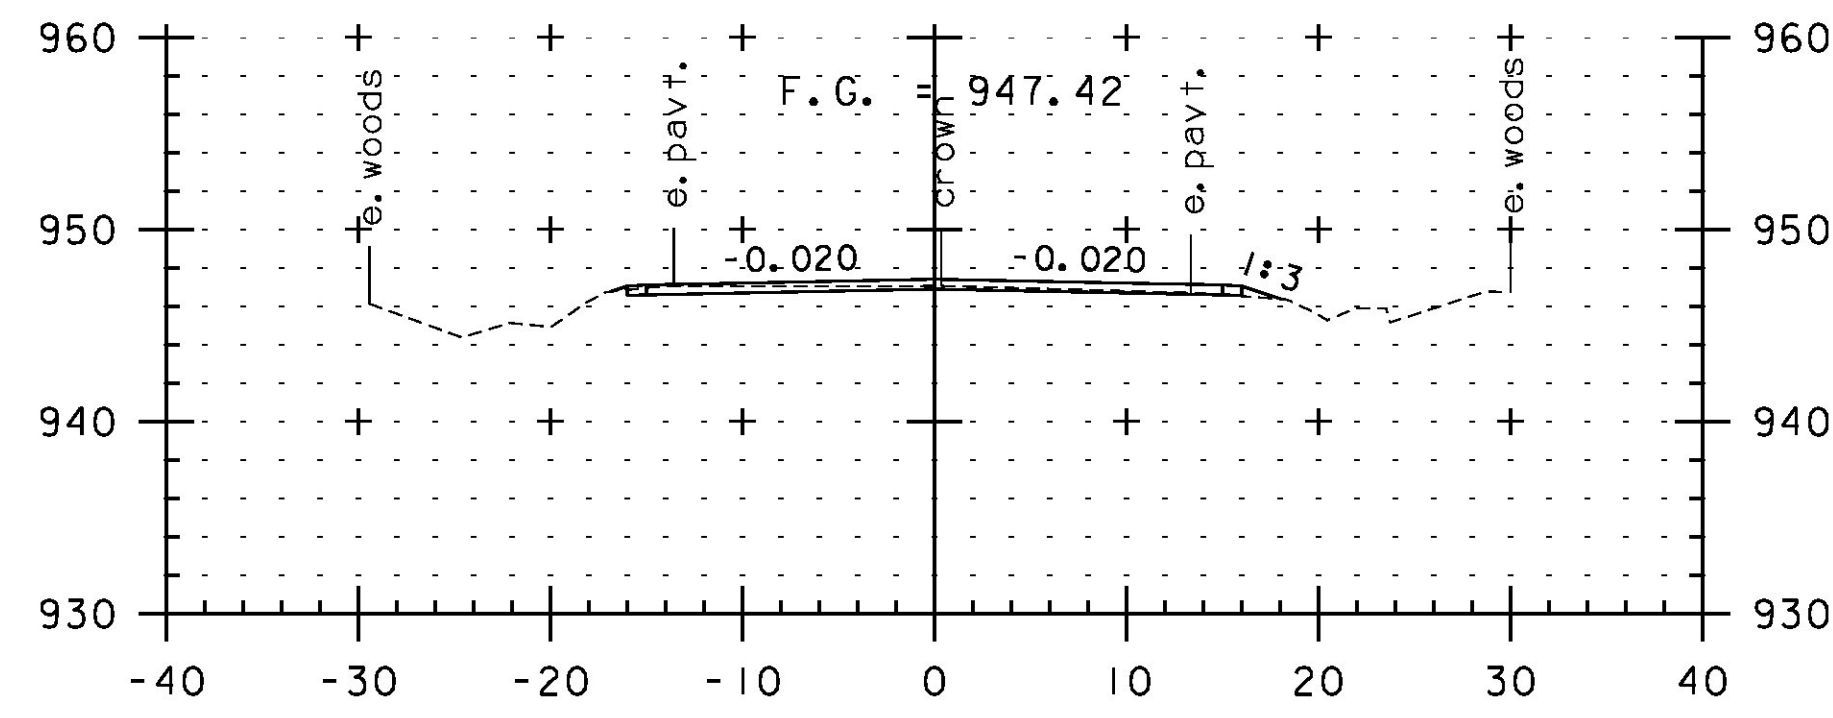

394+50

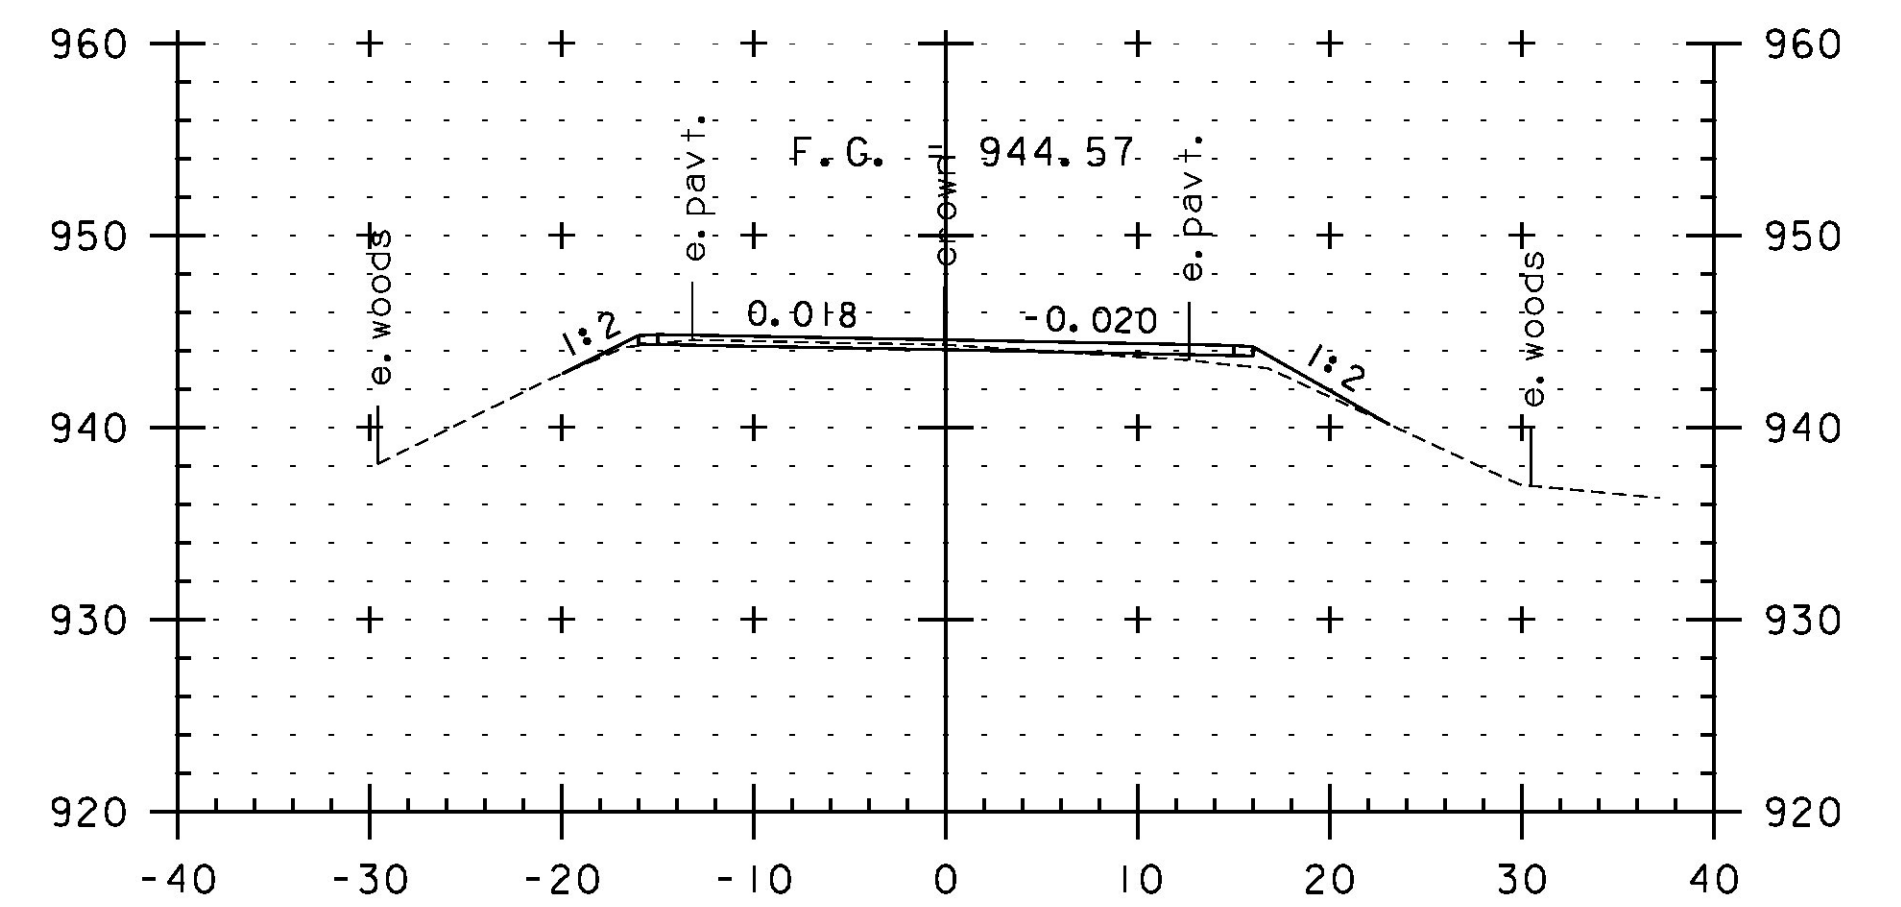

396+00



STA. 393+00 TO STA. 397+00

PROJECT NAME: JAY-TROY
PROJECT NUMBER: STP 2315(I)

FILE NAME: z10b232xs.dgn
PROJECT LEADER: P. SHEDD
DESIGNED BY: N. LEMAY
CROSS SECTION SHEET 90

PLOT DATE: 5/16/2014
DRAWN BY: W. GORDON
CHECKED BY: P. SHEDD
SHEET 226 OF 244