




398+50

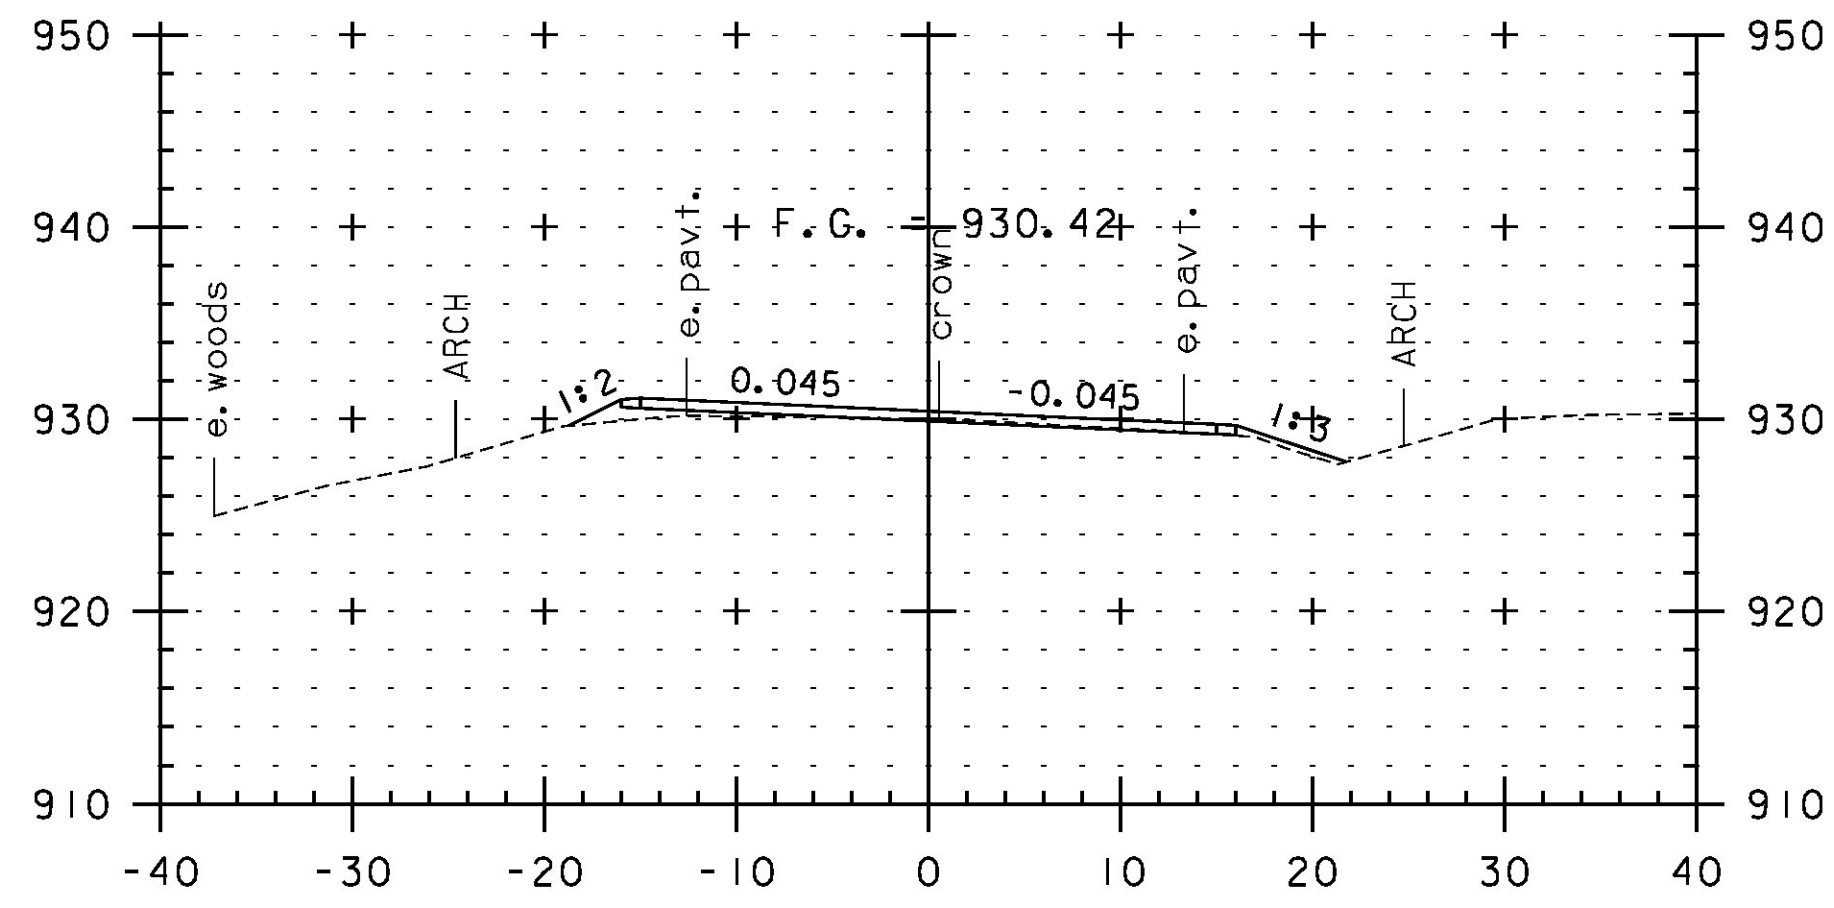


400+00

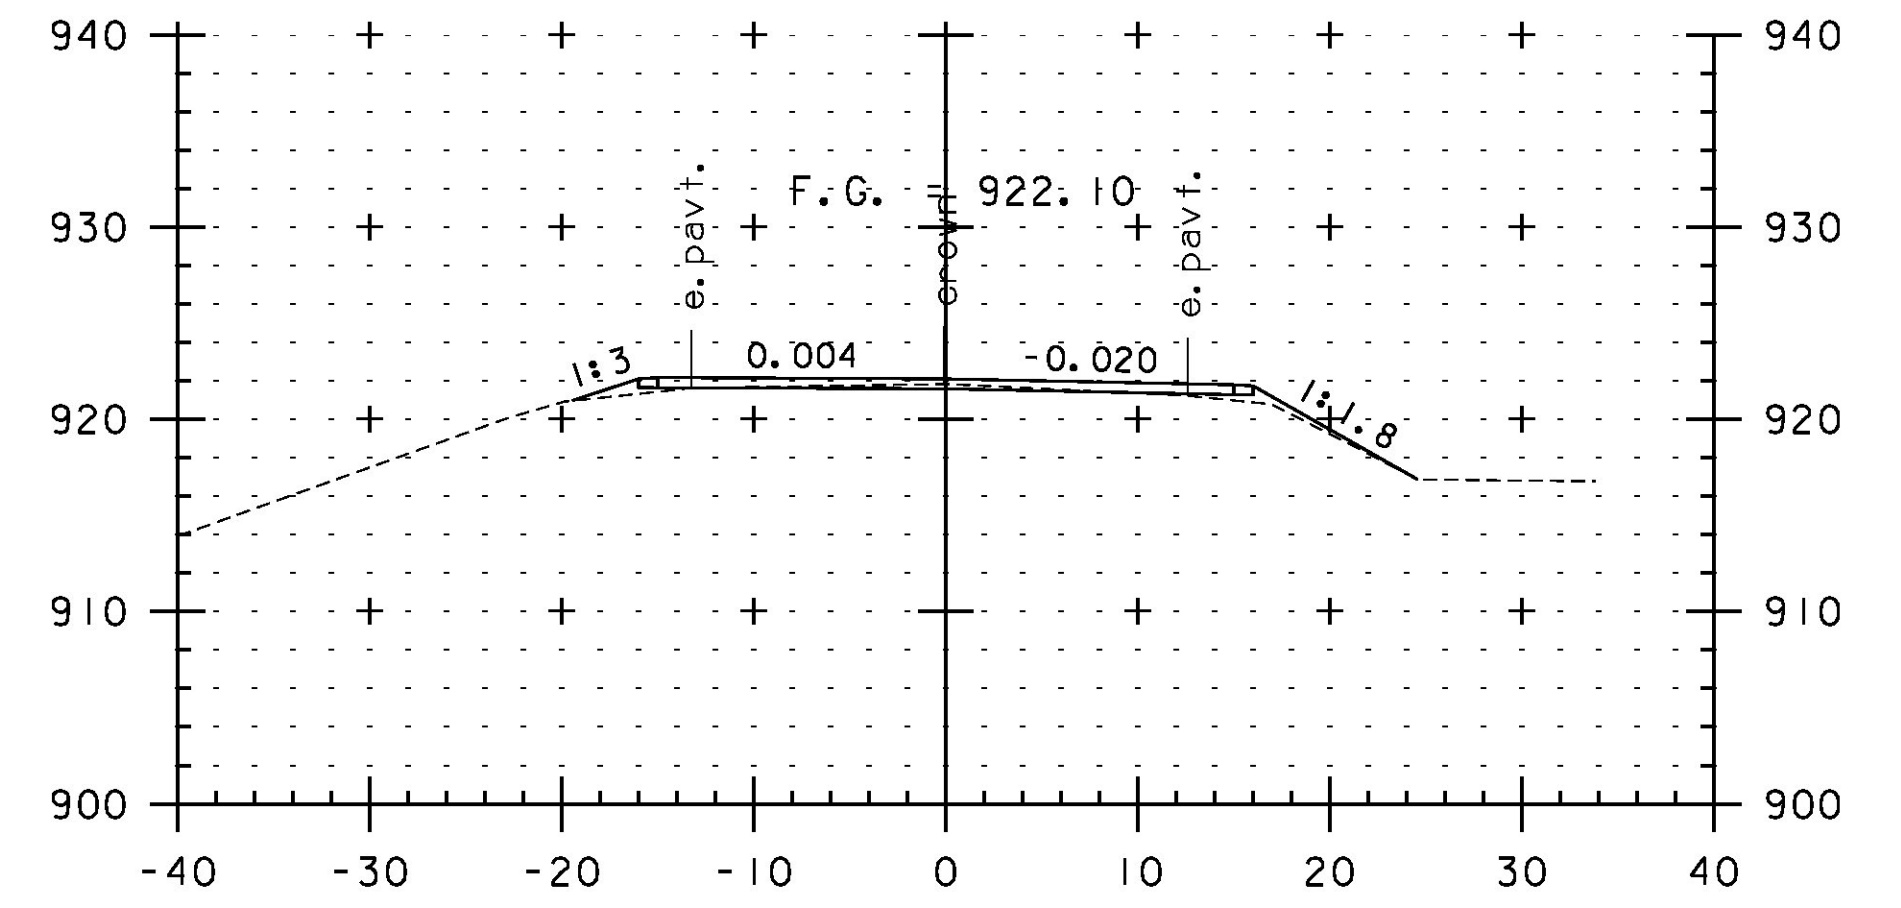


401+50

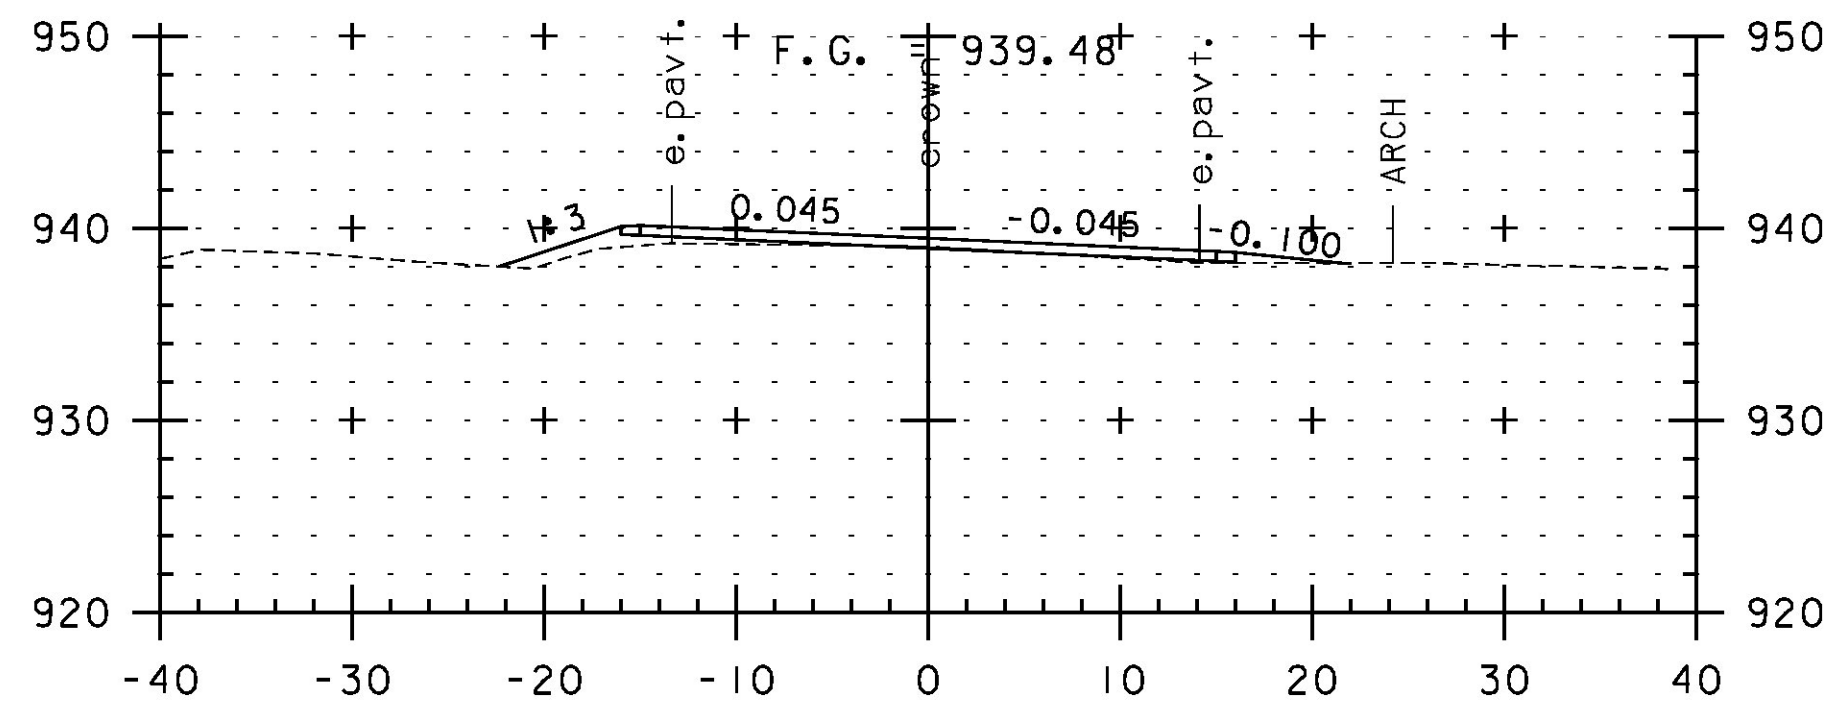


398+00

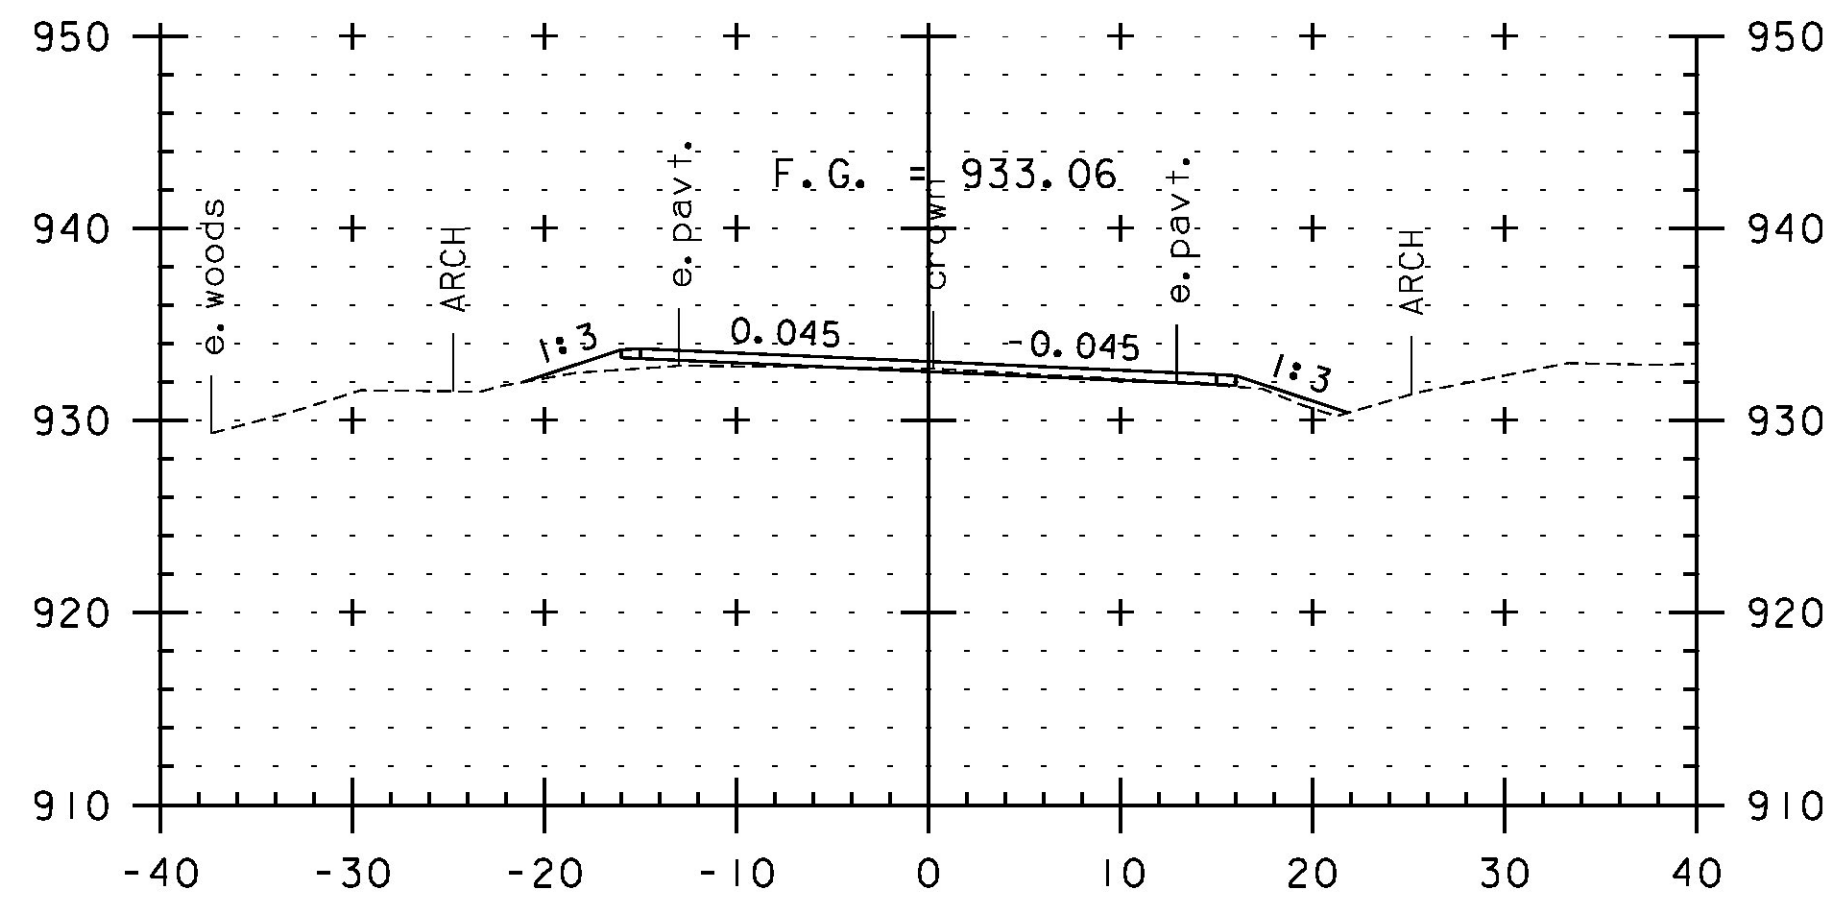


399+50

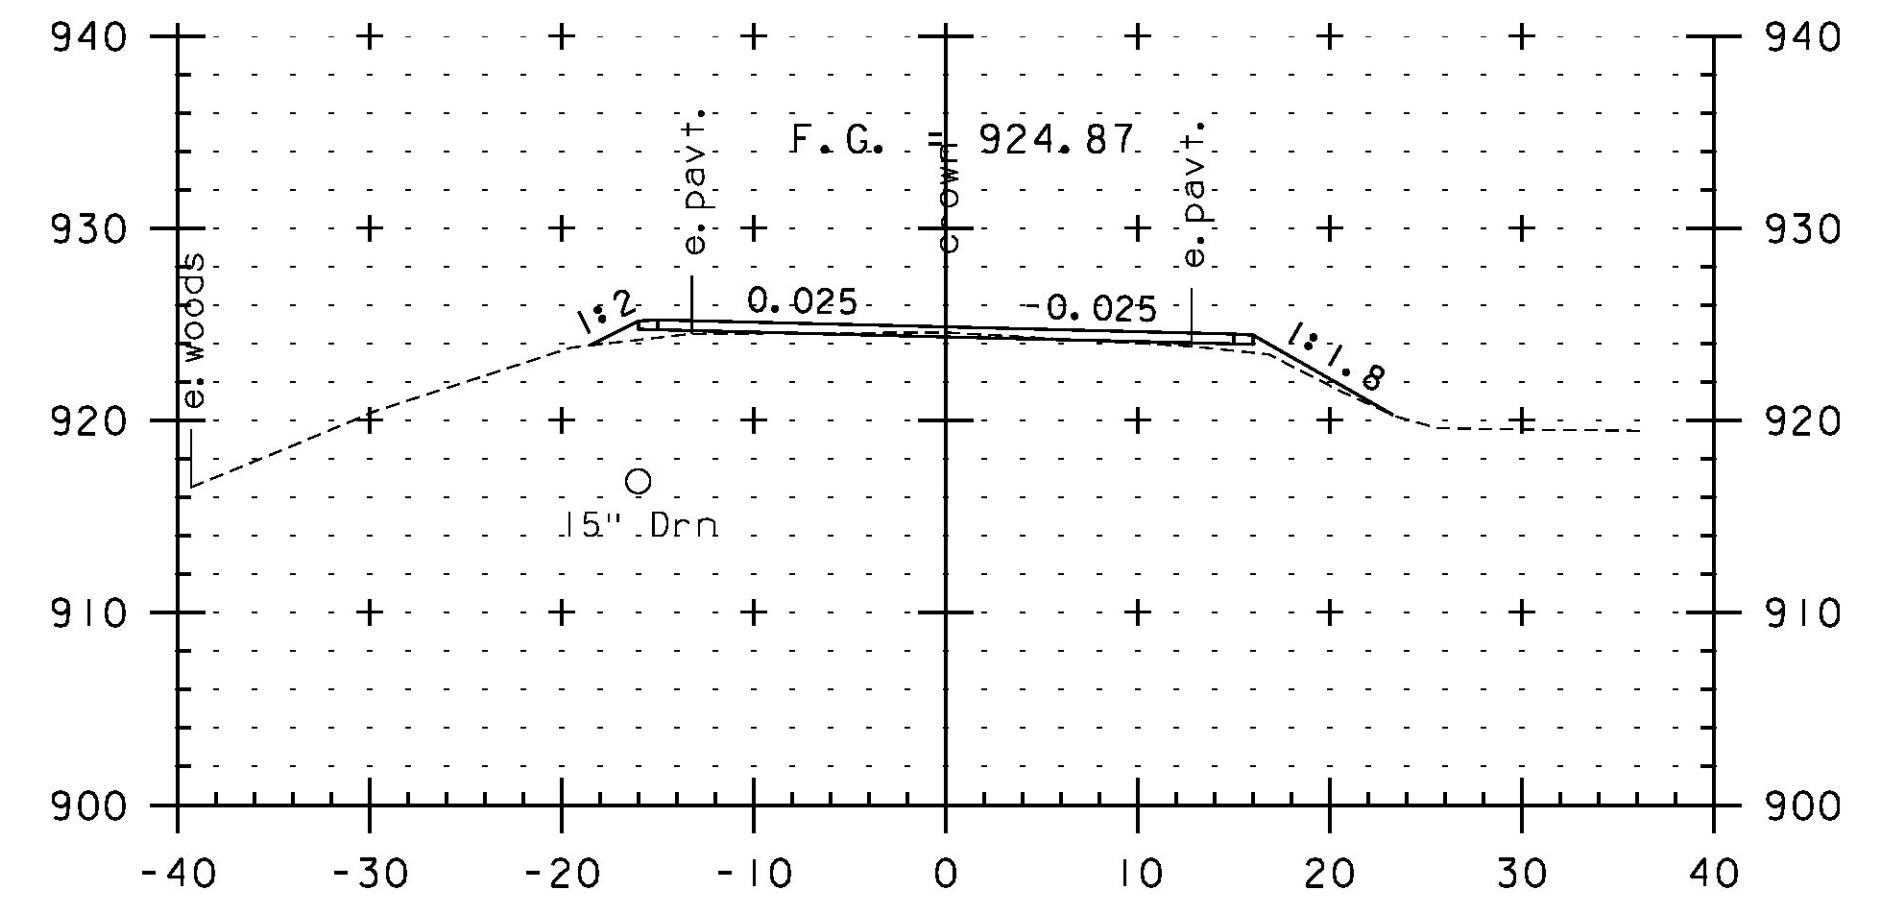


401+00

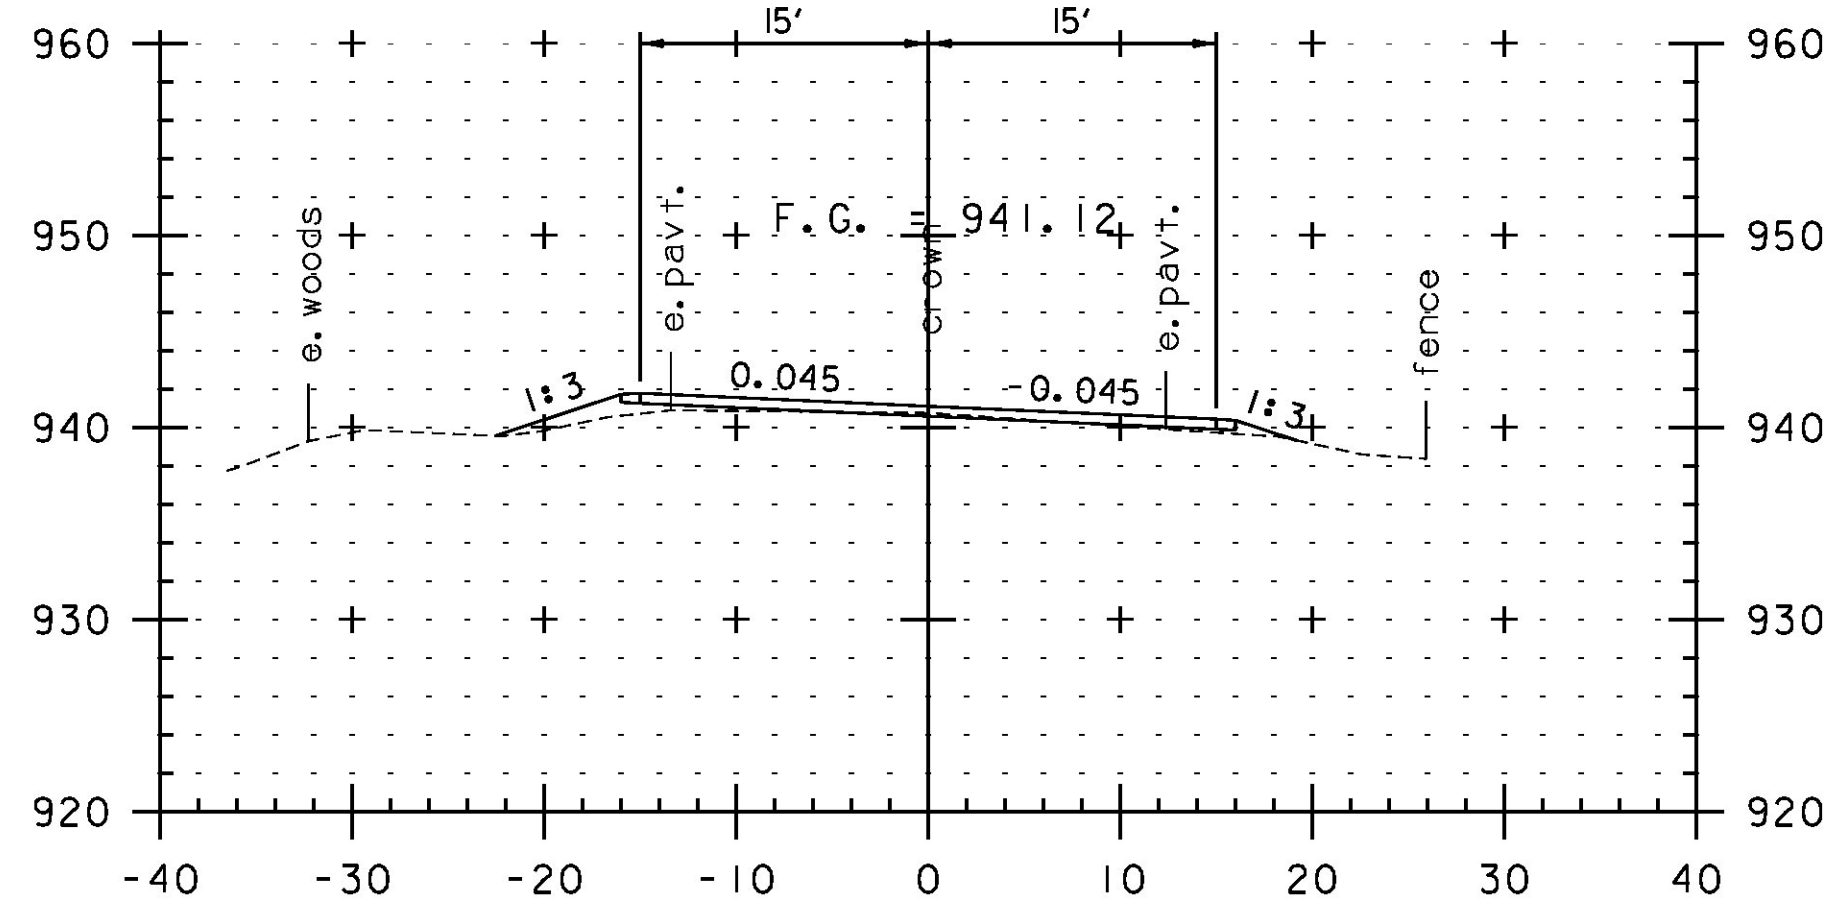


397+50

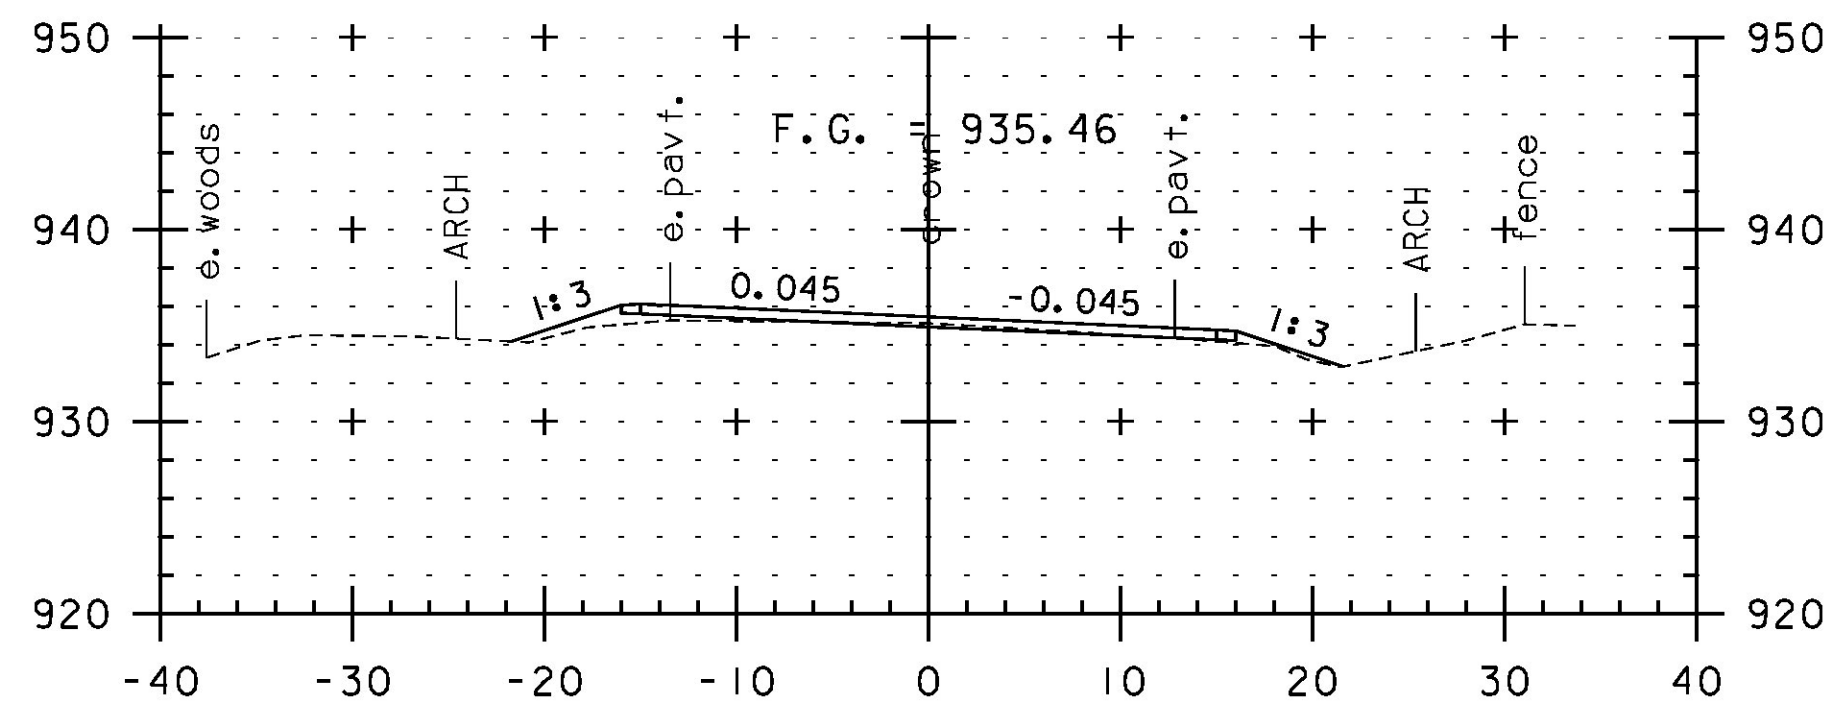

399+00

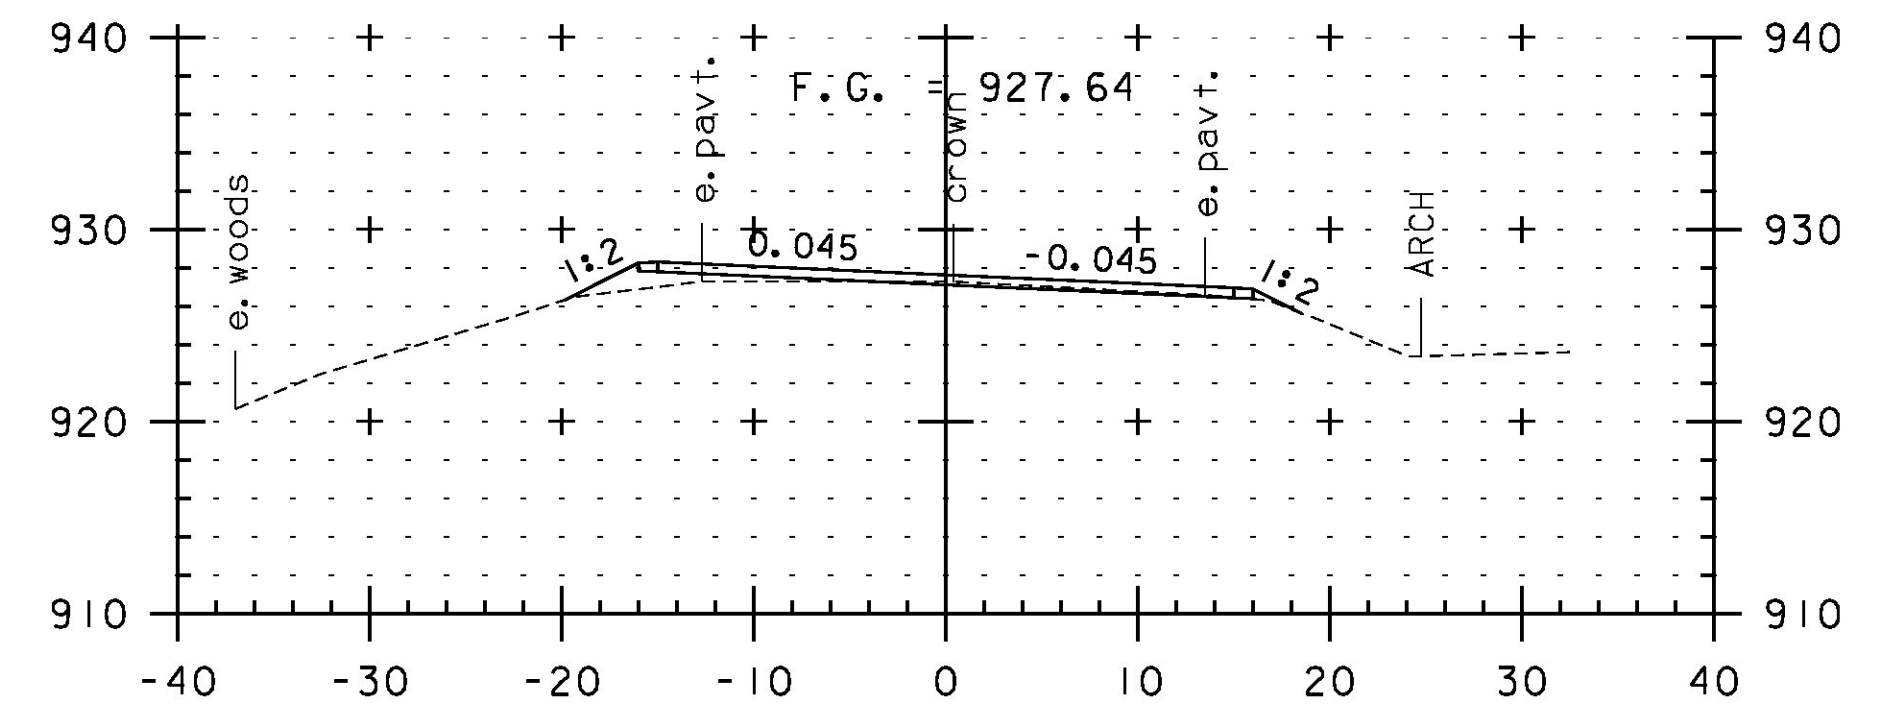

400+50

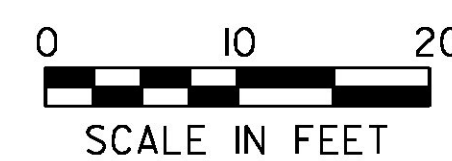

SCALE IN FEET

STA. 397+50 TO STA. 401+50

PROJECT NAME:	JAY-TROY	PLOT DATE:	5/16/2014
PROJECT NUMBER:	STP 2315(I)	DRAWN BY:	W. GORDON
FILE NAME:	z10b232xs.dgn	DESIGNED BY:	N. LEMAY
PROJECT LEADER:	P. SHEDD	CHECKED BY:	P. SHEDD
CROSS SECTION SHEET 91		SHEET	227 OF 244