




403+00

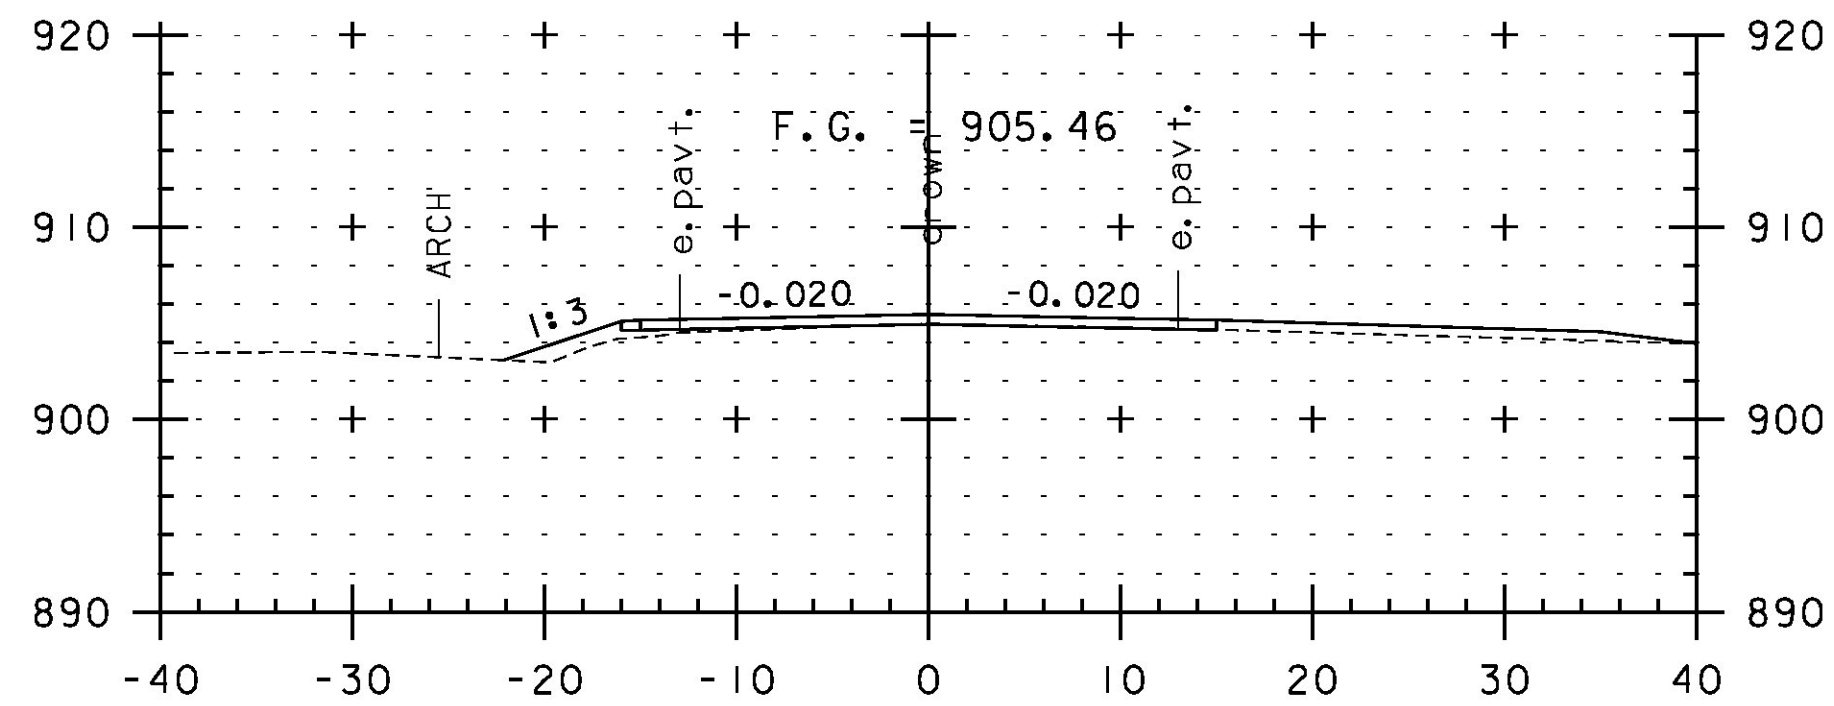


404+50

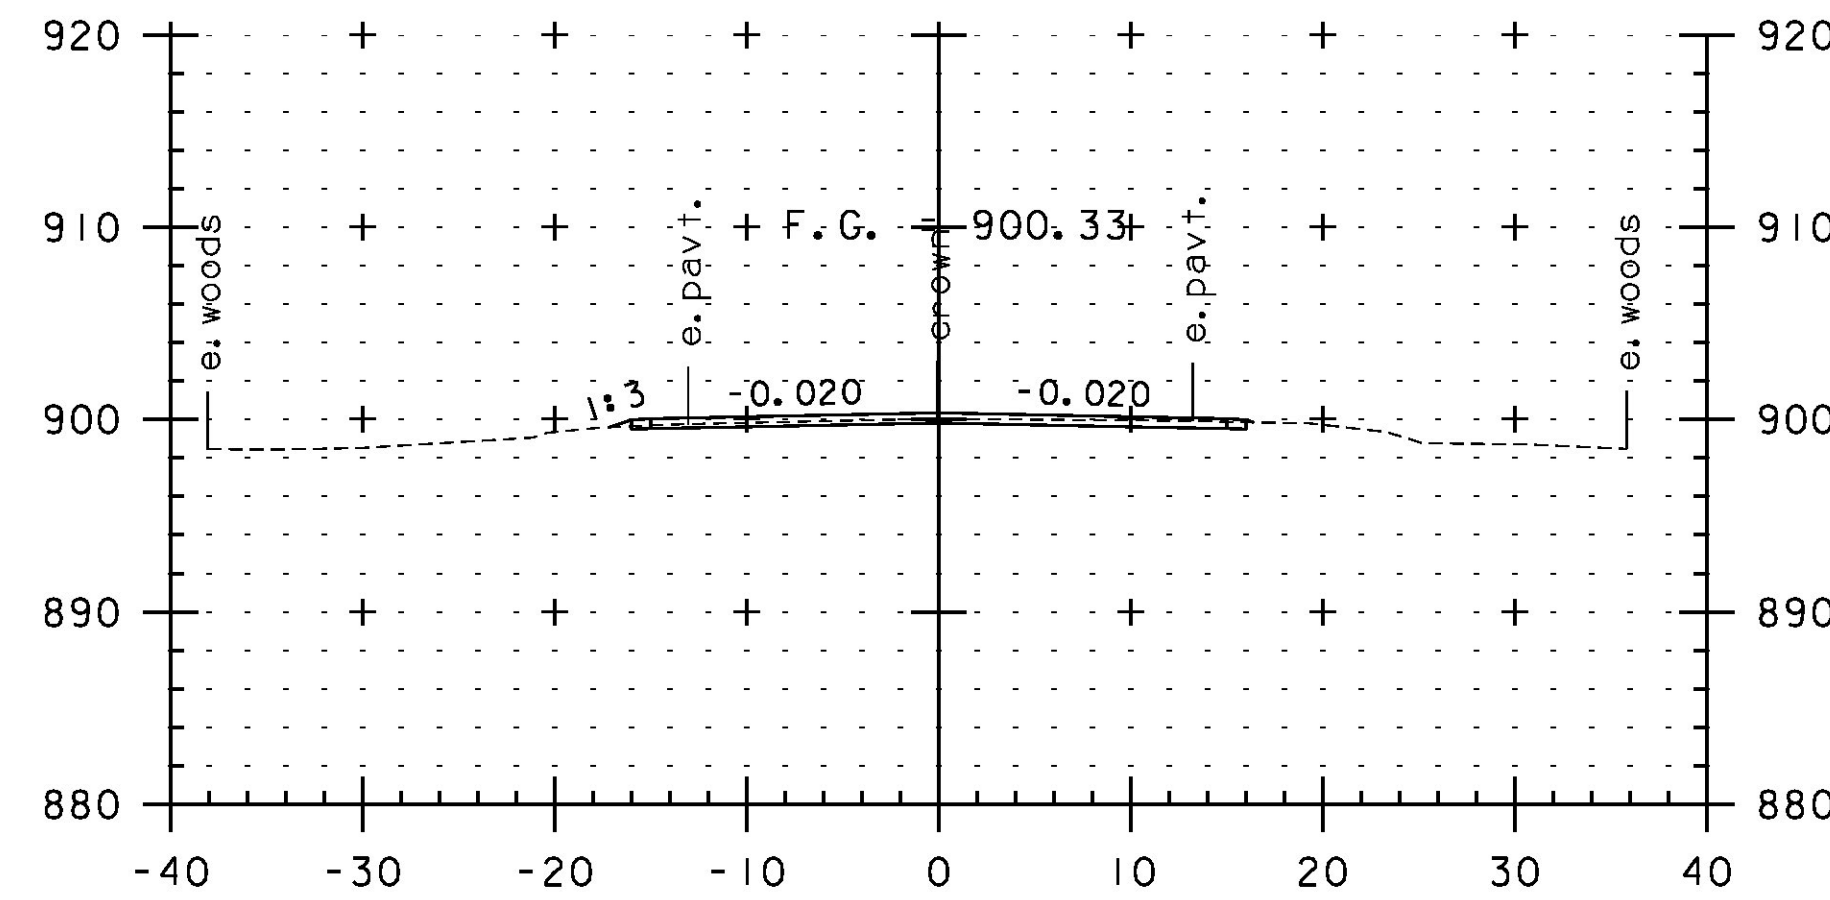


405+50

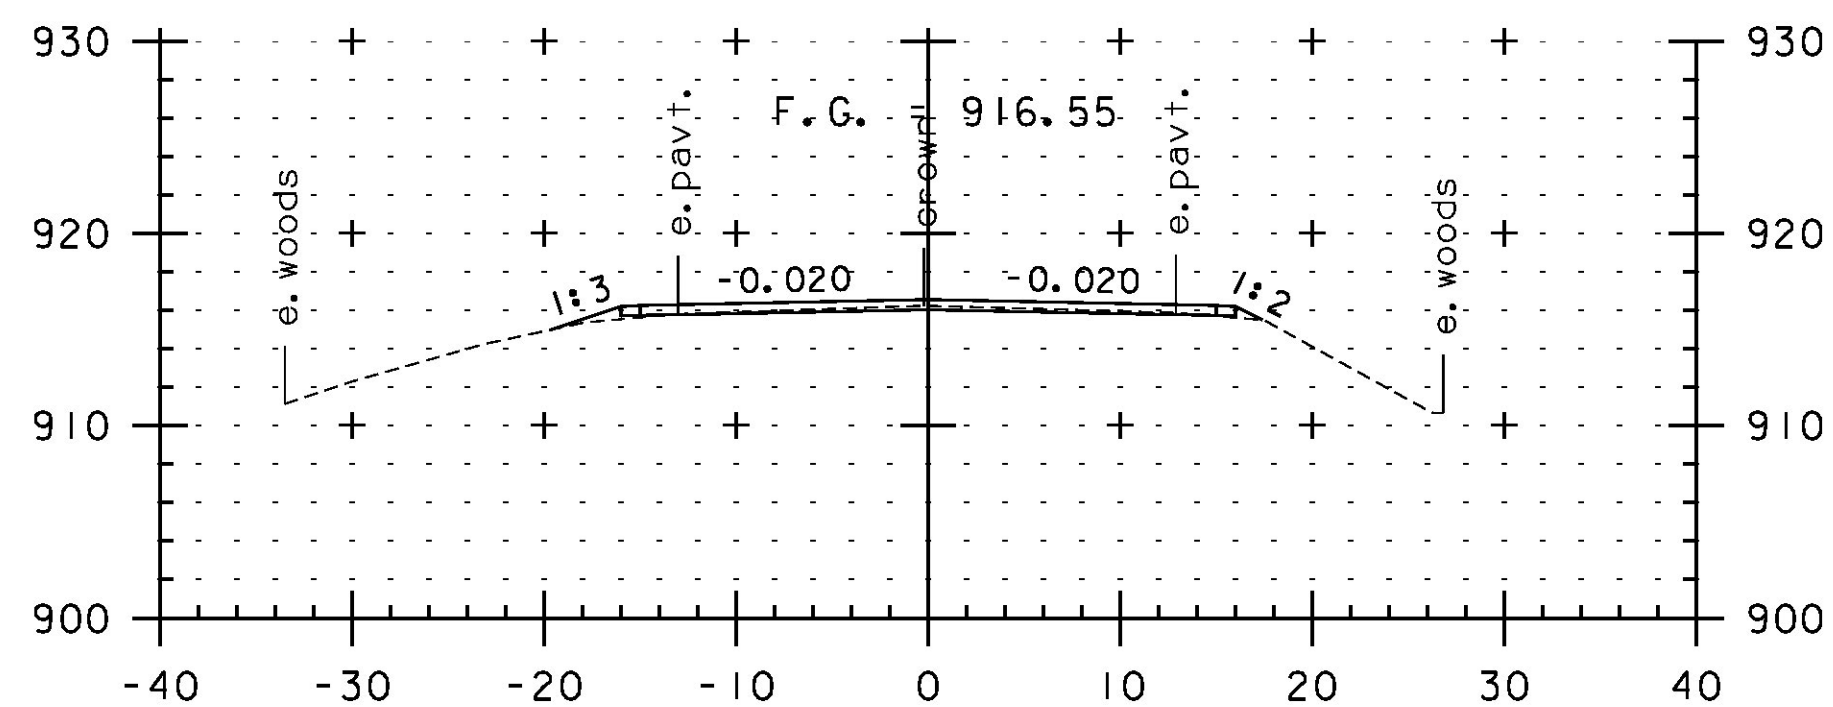


402+50

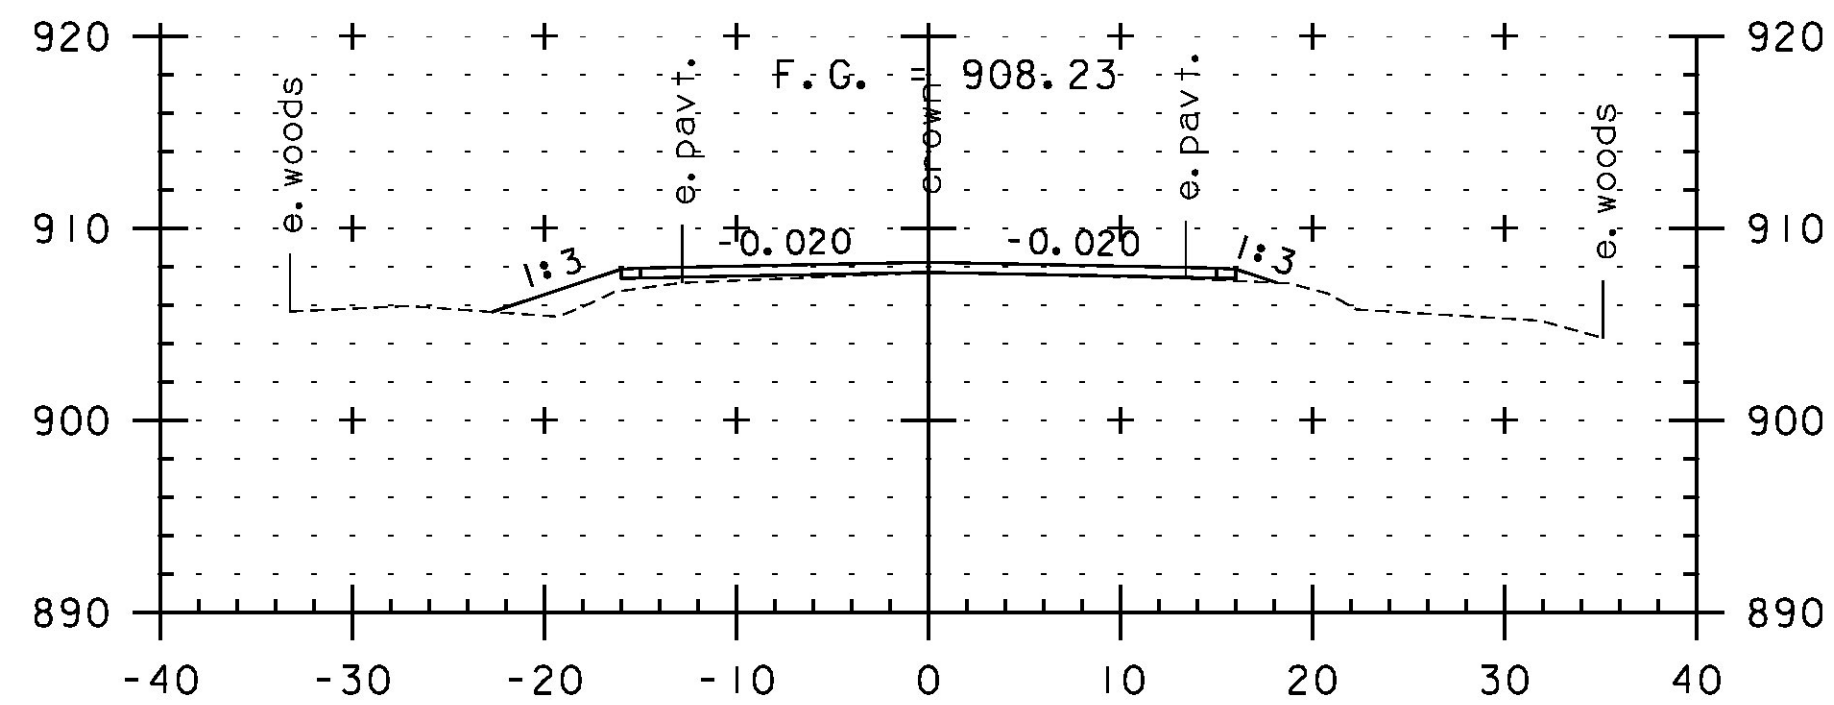


404+00

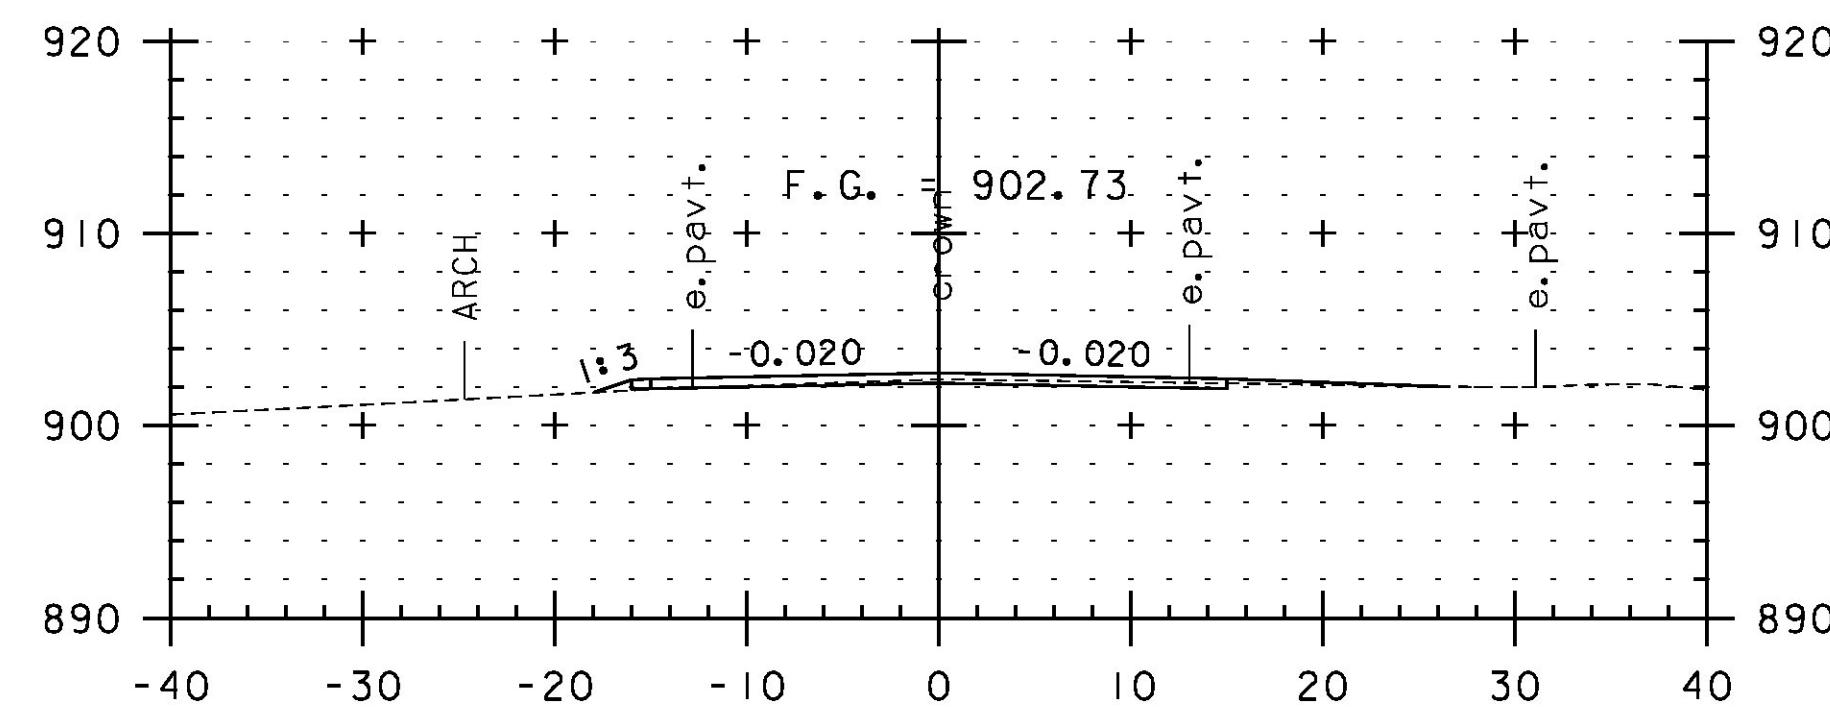


405+00

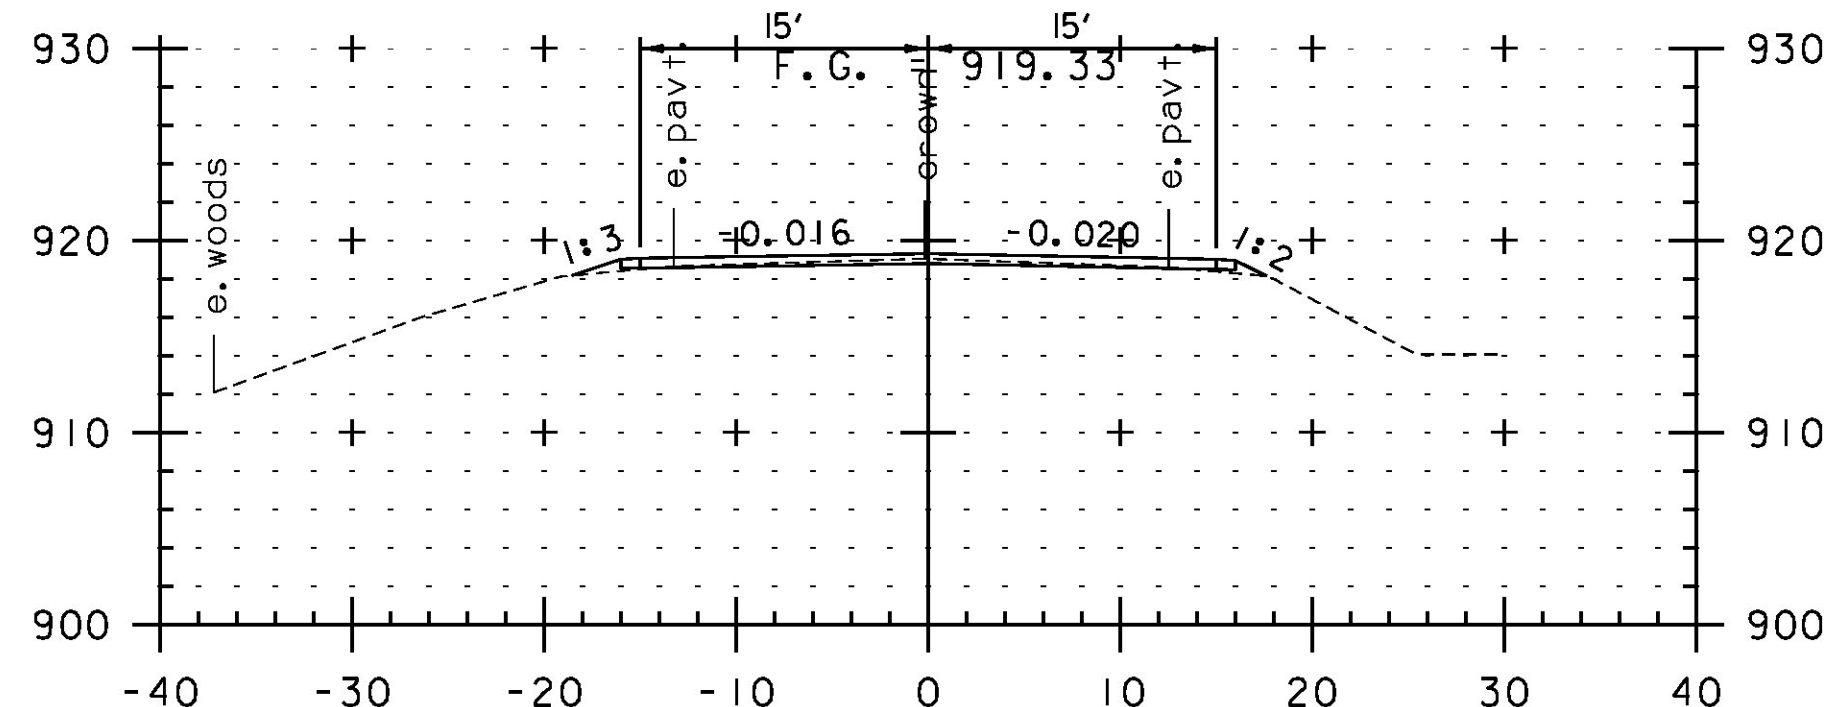

402+00

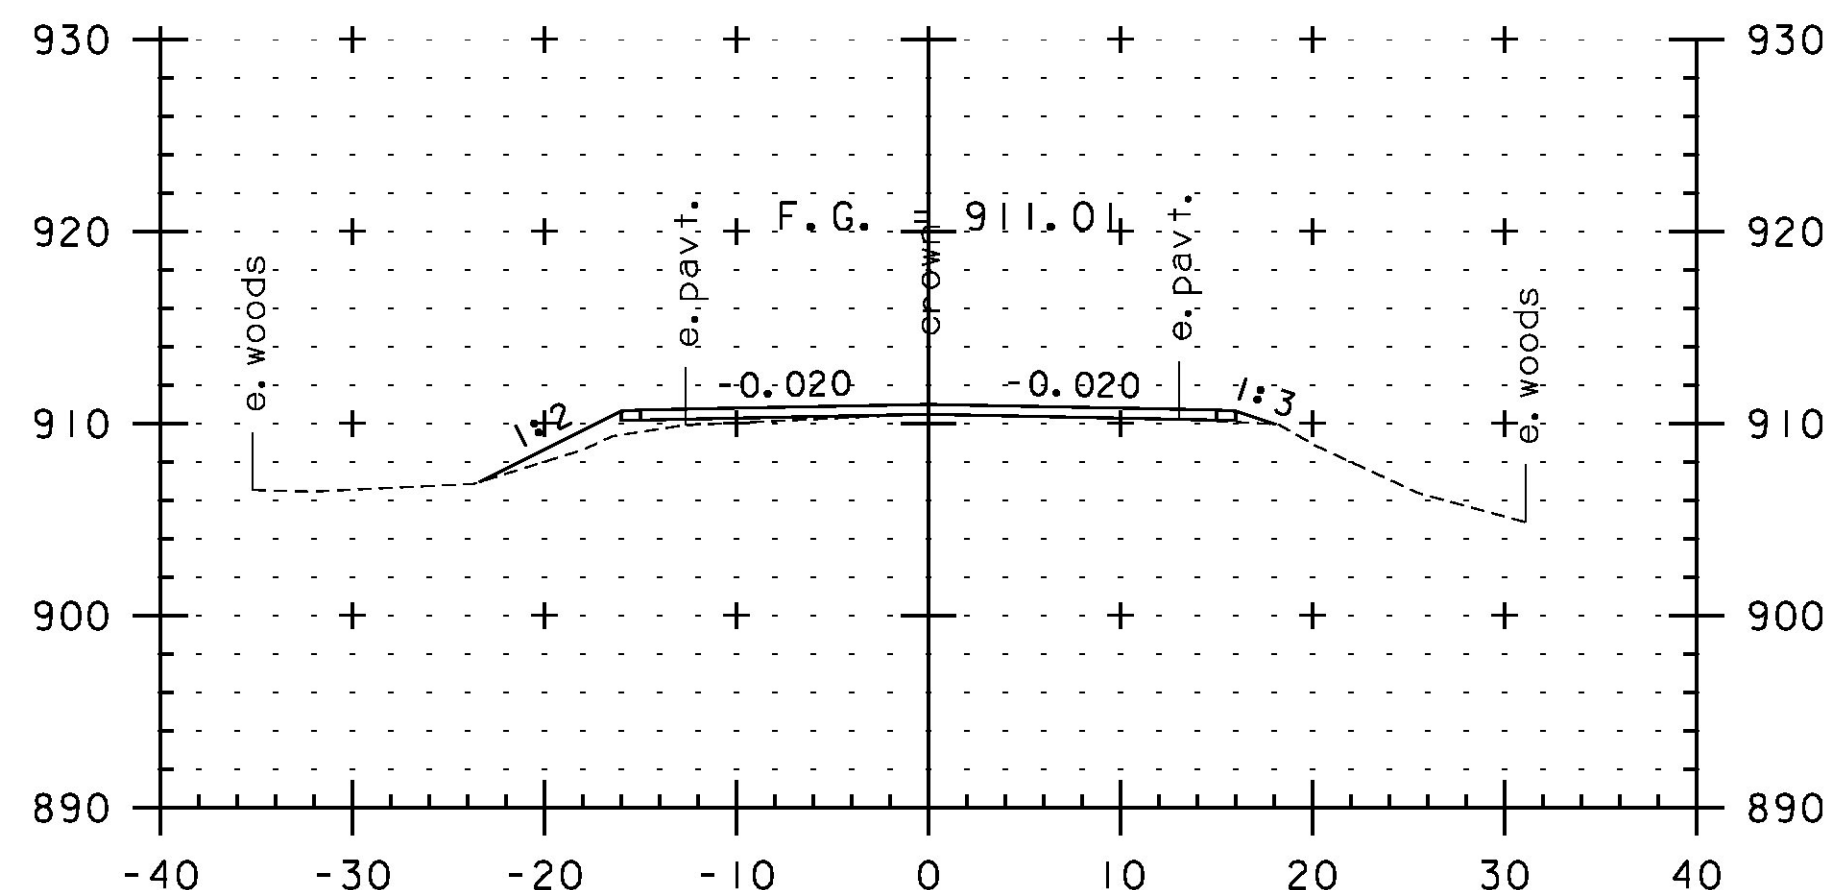

403+50

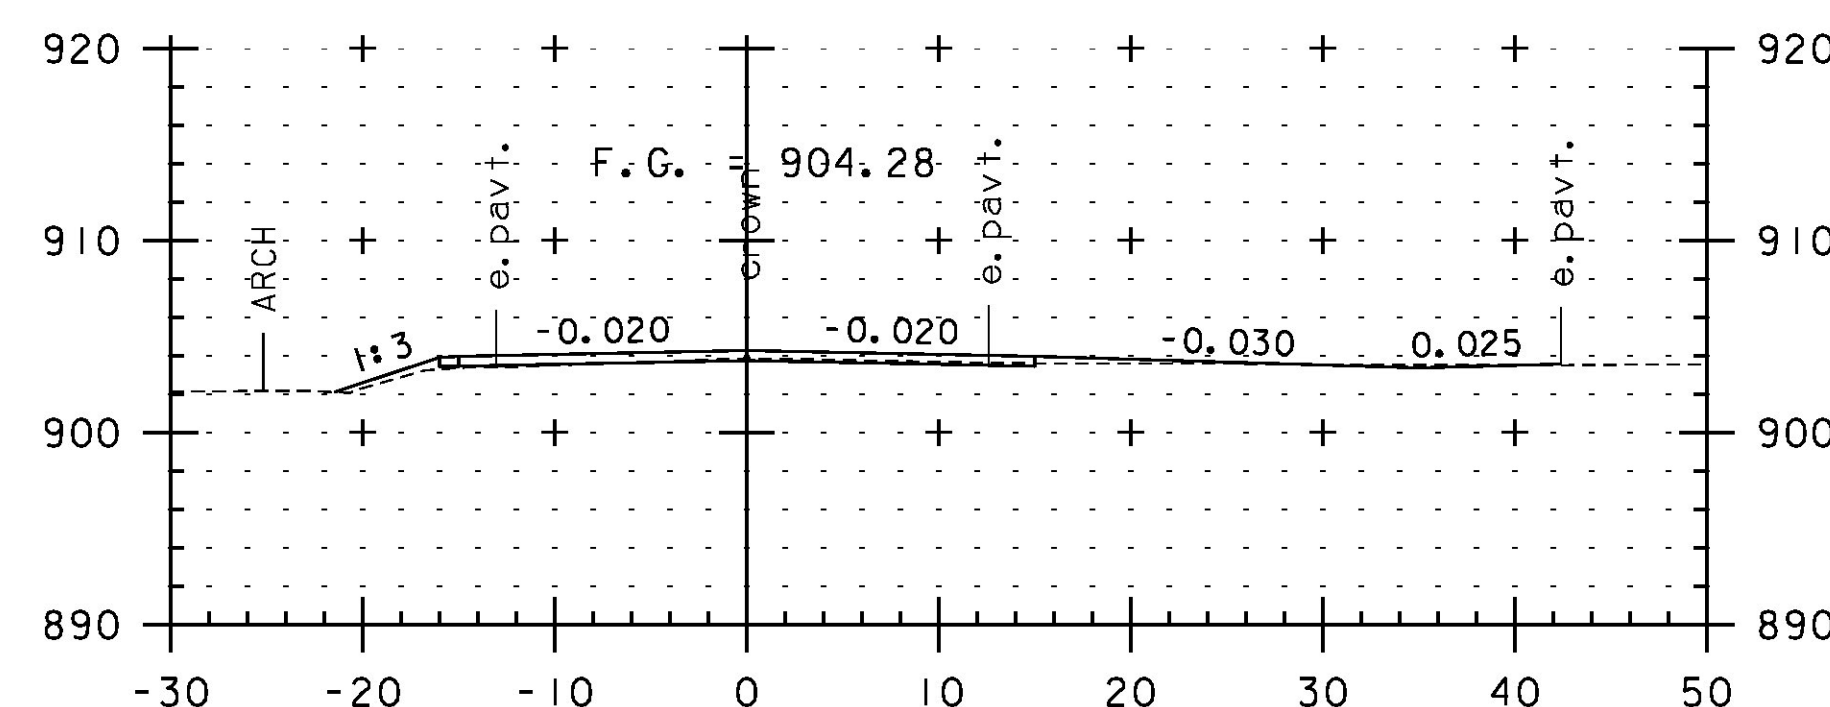

404+70
TH 29 RT



SCALE IN FEET

STA. 402+00 TO STA. 405+50

PROJECT NAME:	JAY-TROY	PLOT DATE:	5/16/2014
PROJECT NUMBER:	STP 2315(I)	DRAWN BY:	W. GORDON
FILE NAME:	z10b232xs.dgn	CHECKED BY:	P. SHEDD
PROJECT LEADER:	P. SHEDD	CROSS SECTION SHEET	92
DESIGNED BY:	N. LEMAY	SHEET	228 OF 244