




420+00

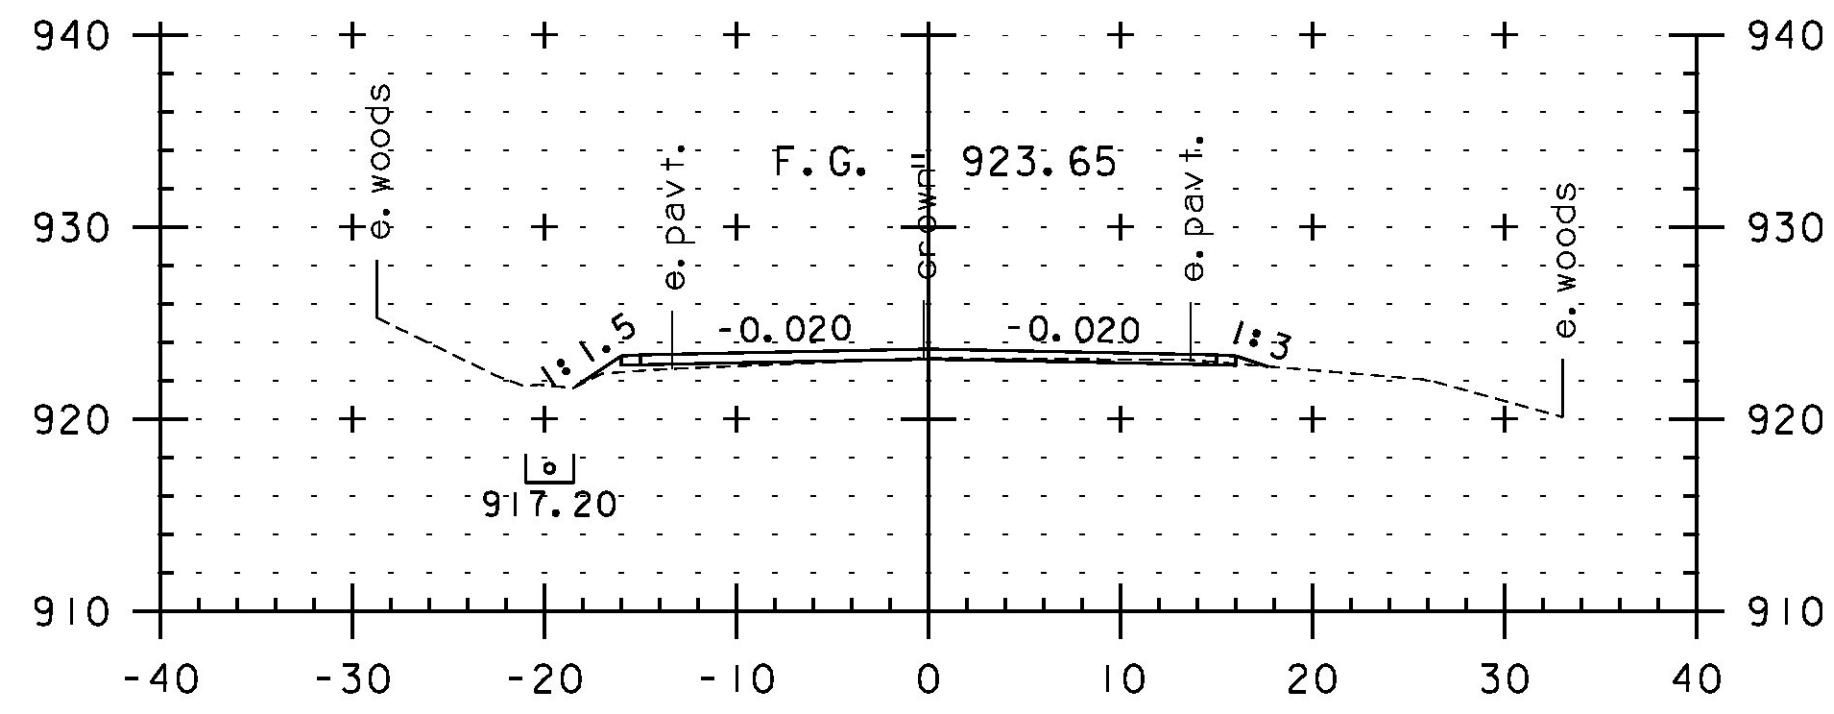


421+50

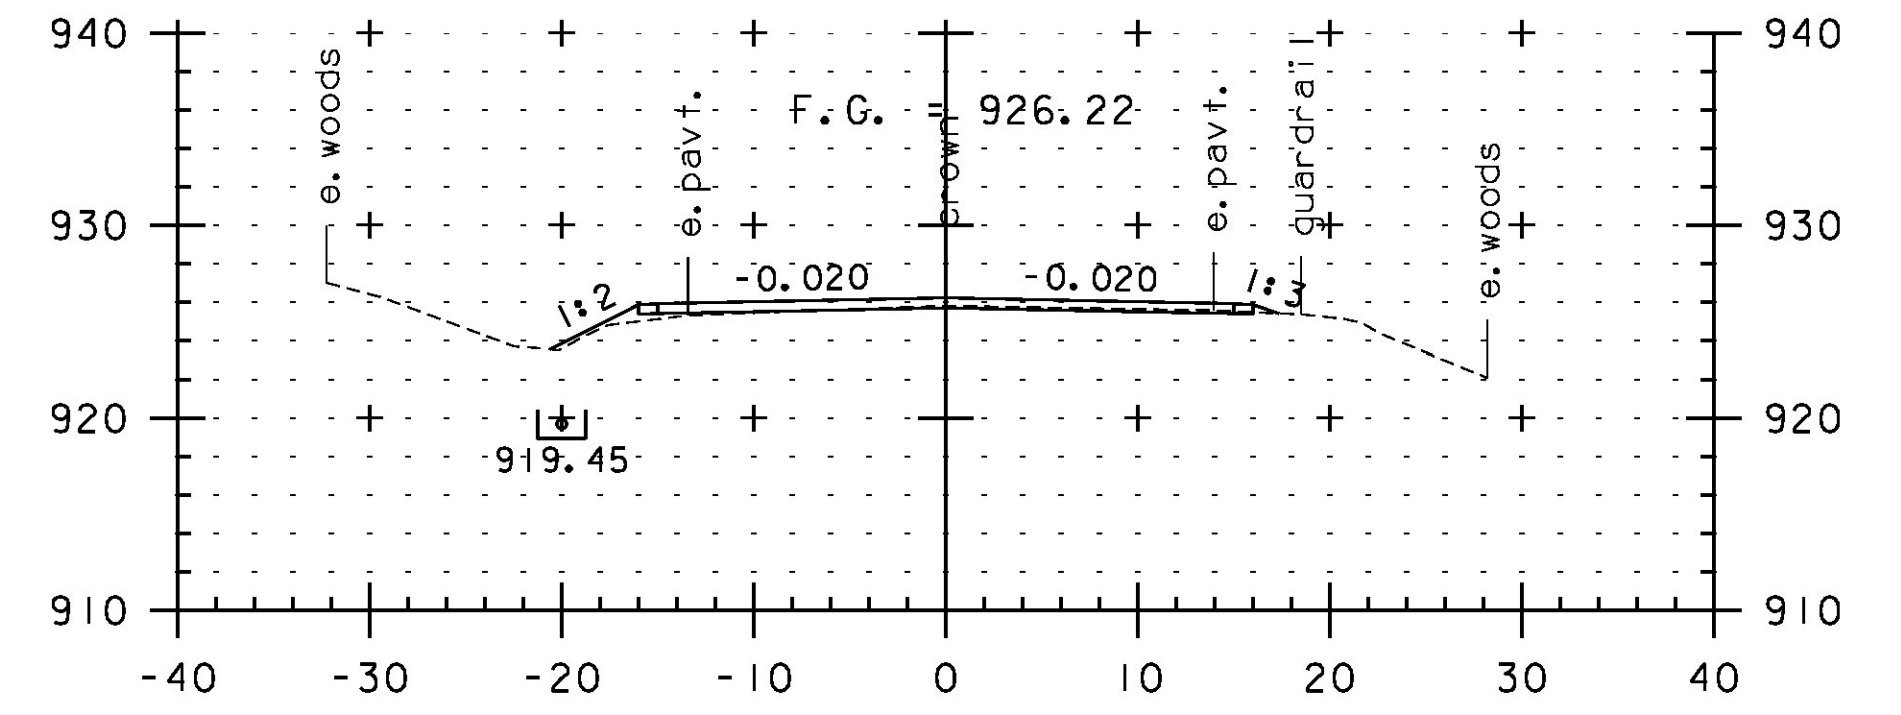


423+00

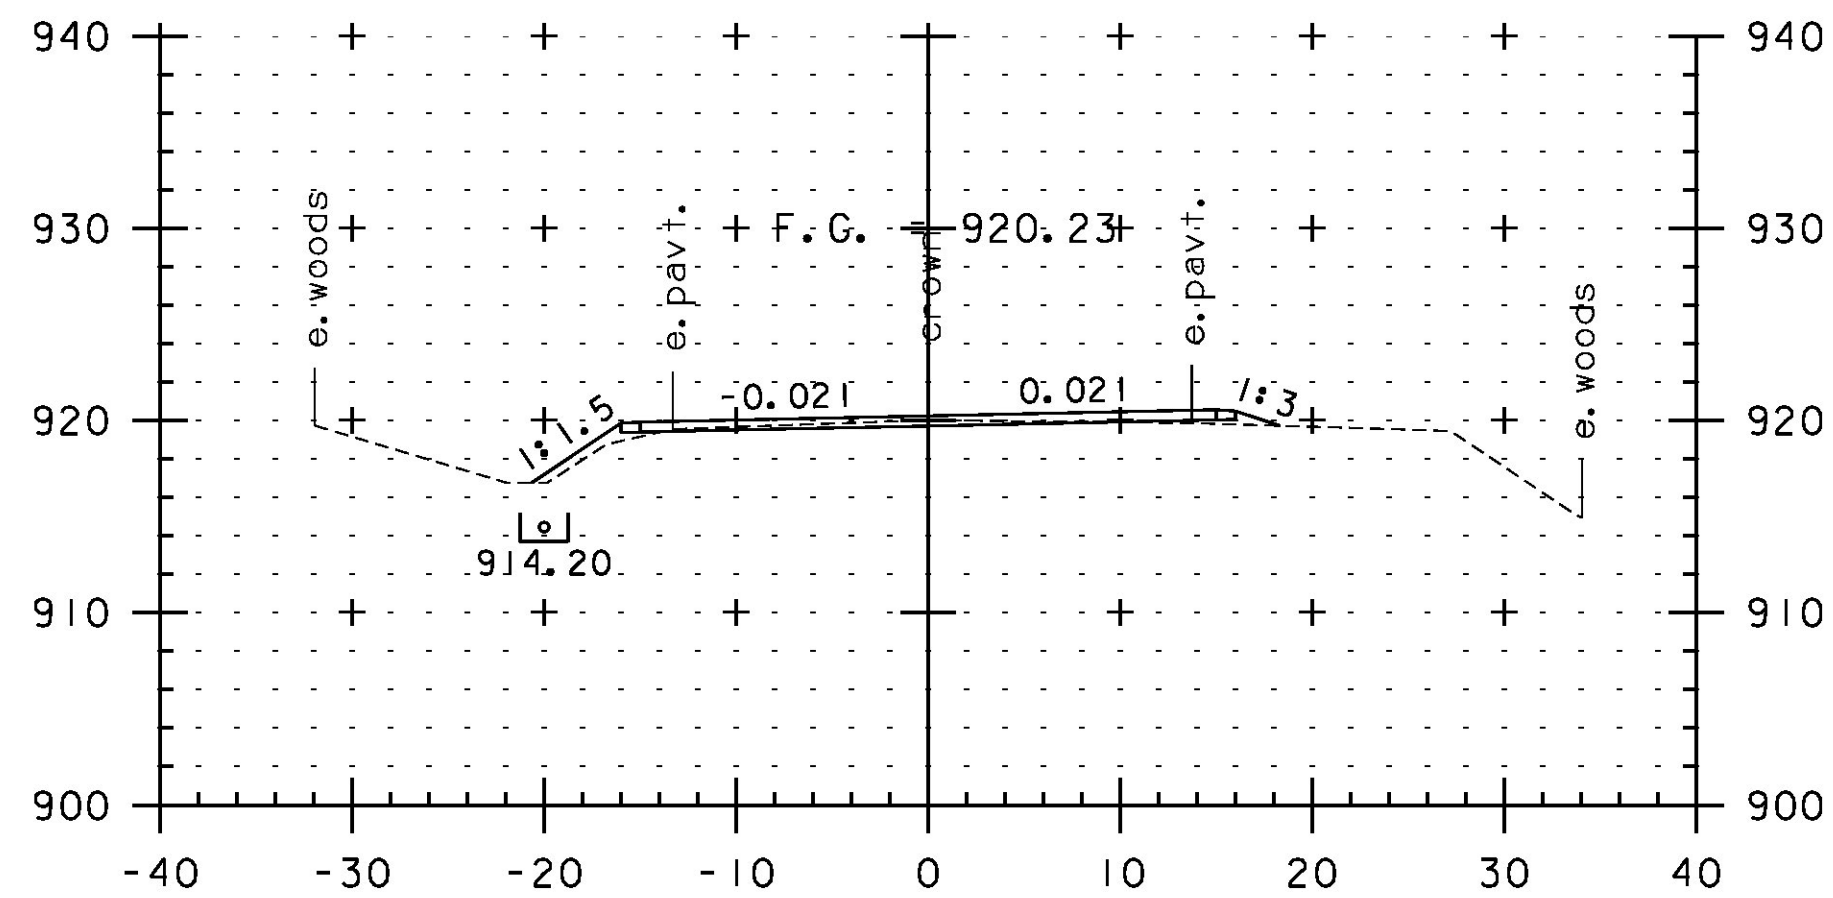


419+50

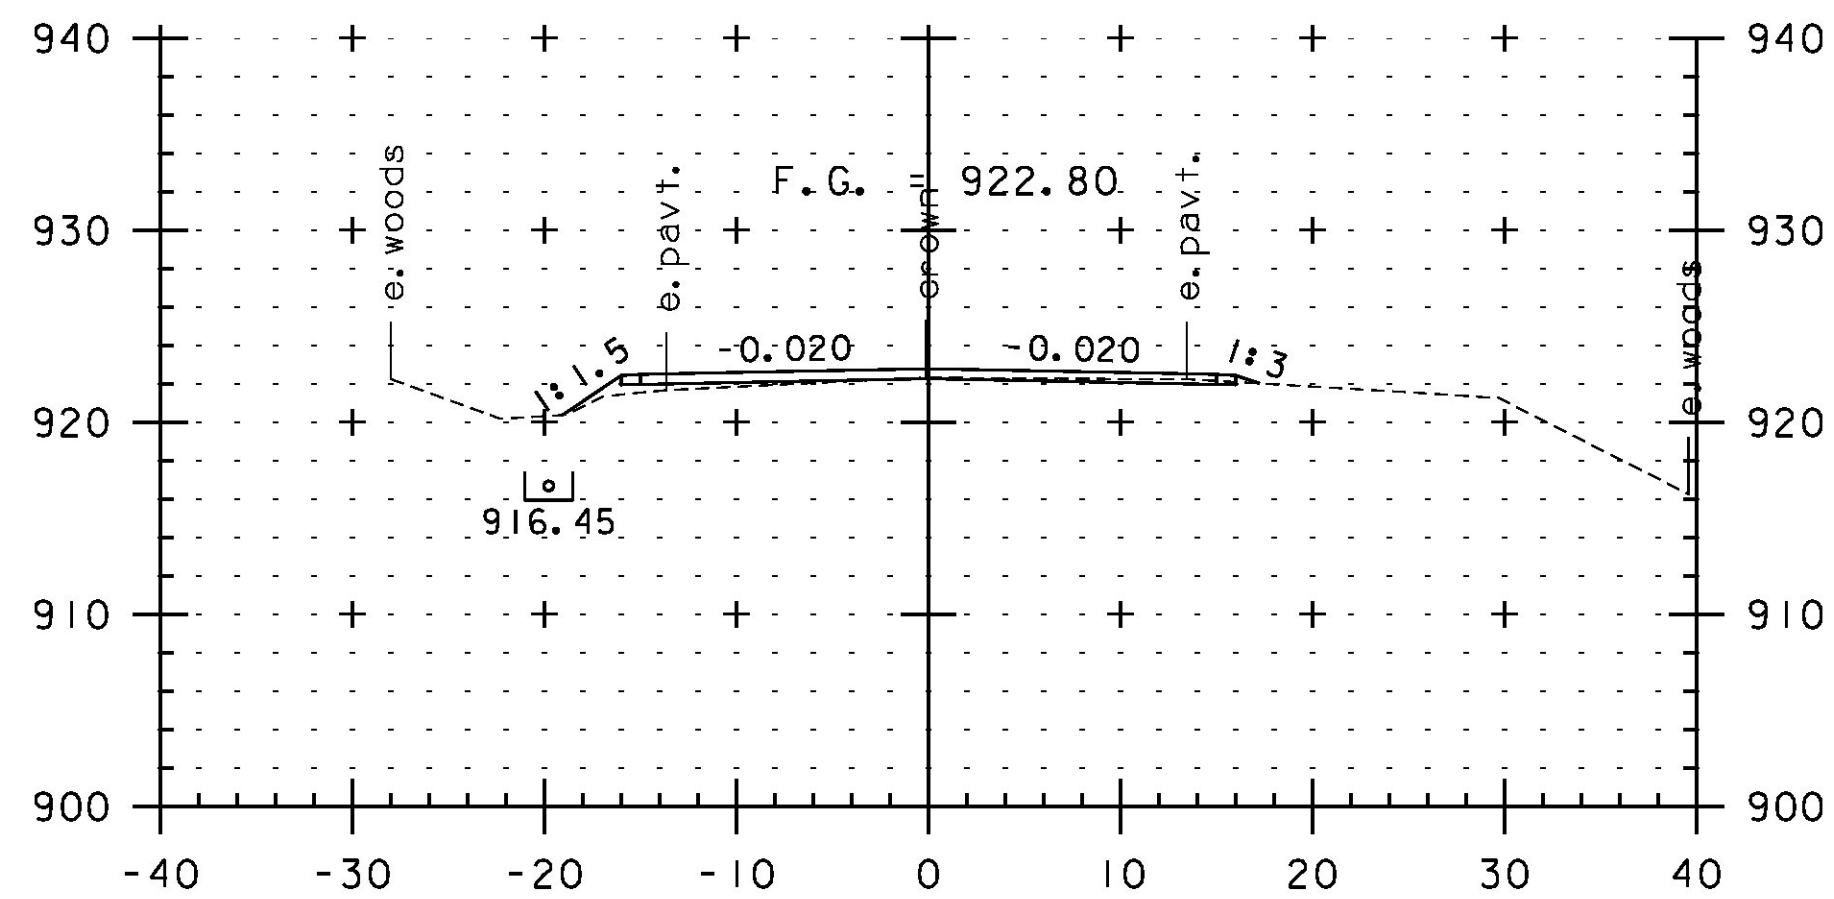


421+00

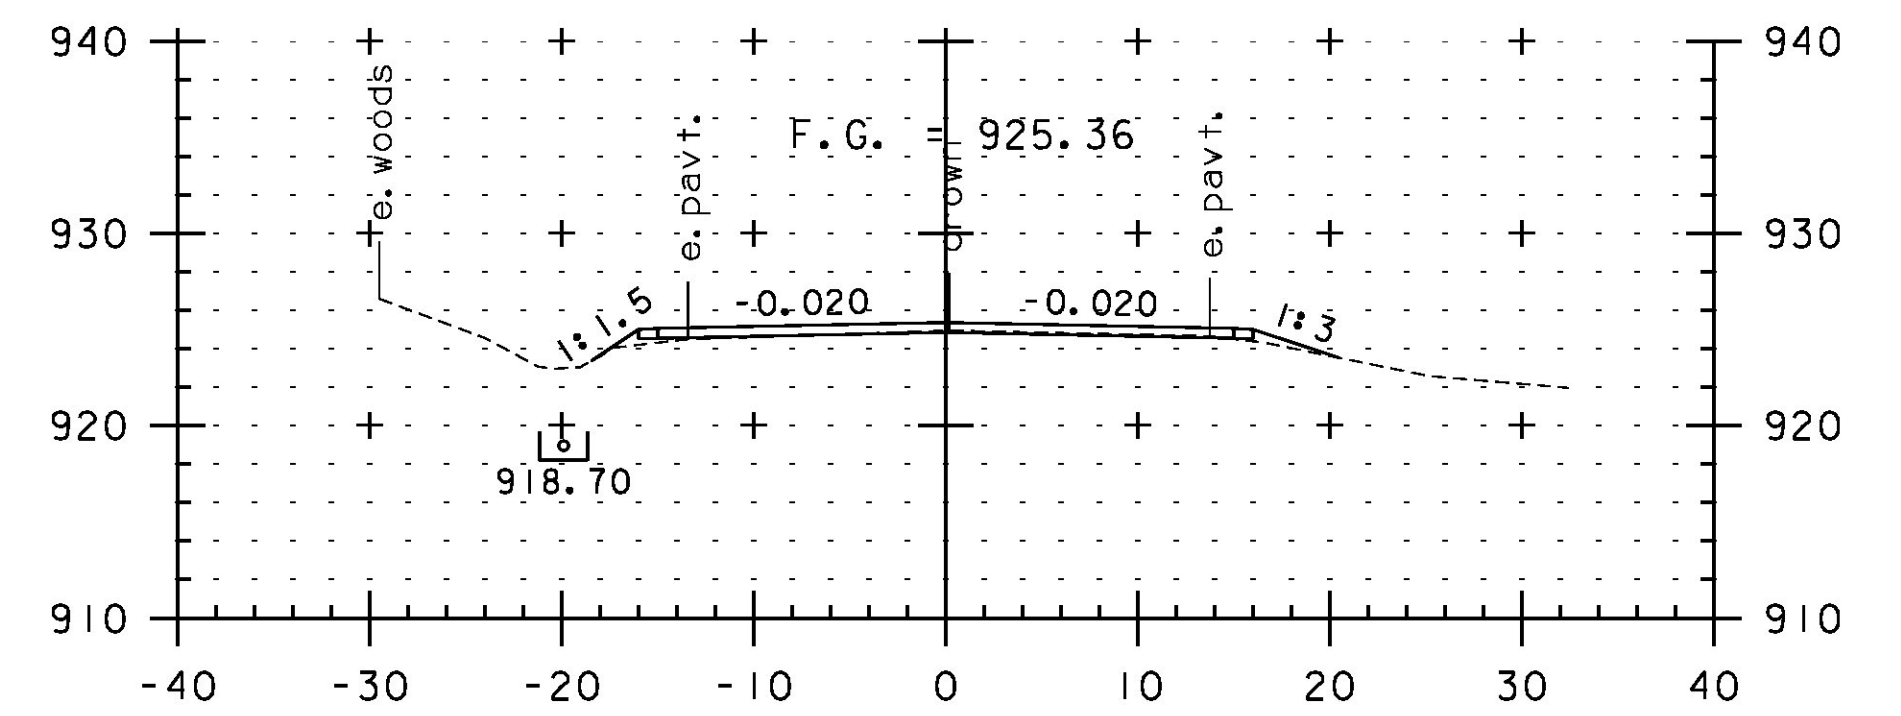


422+50

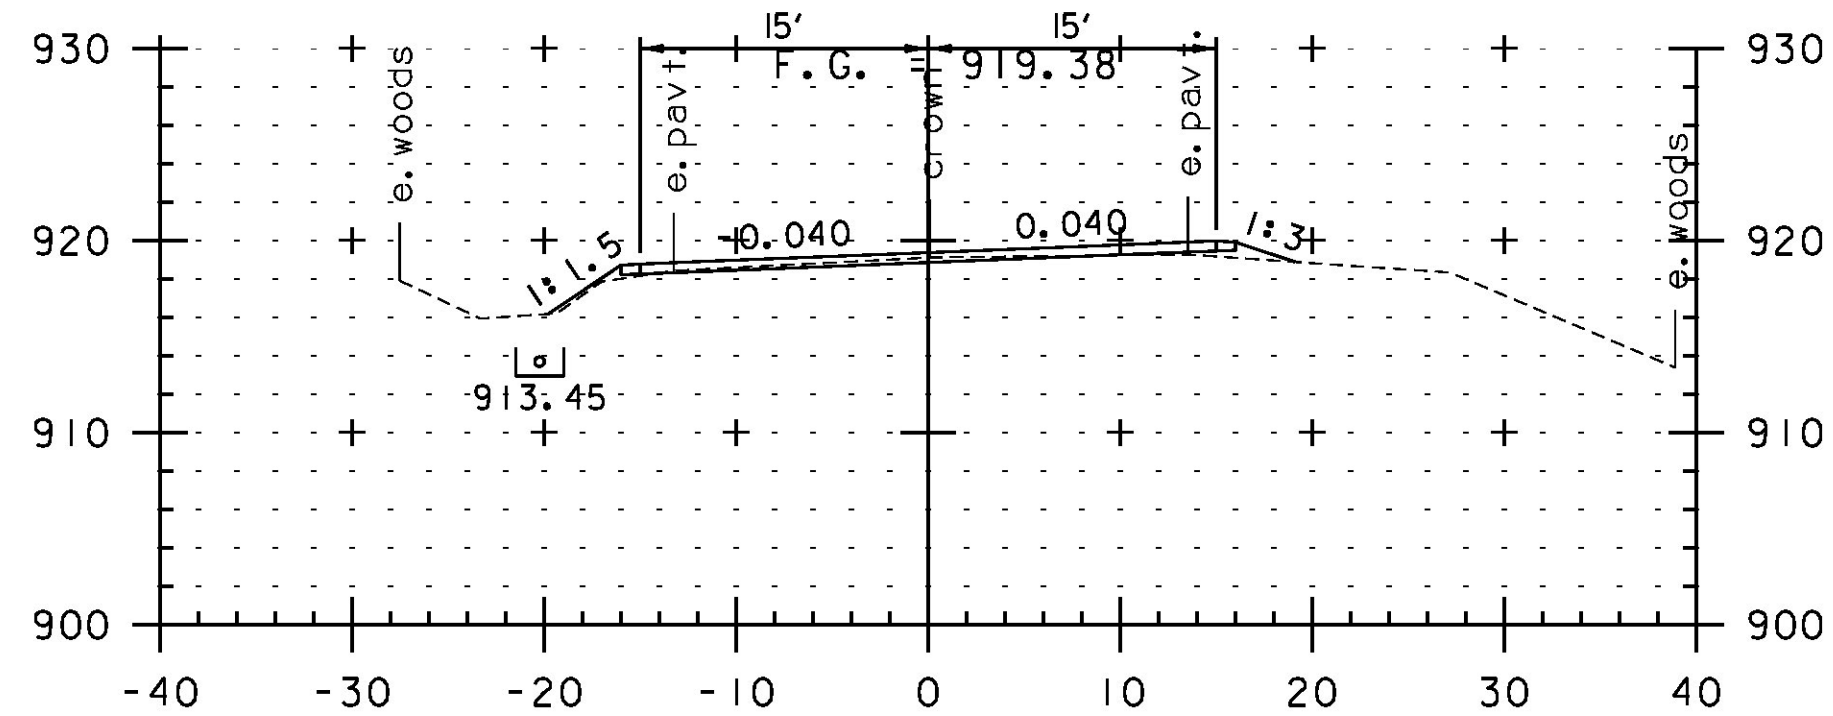

419+00

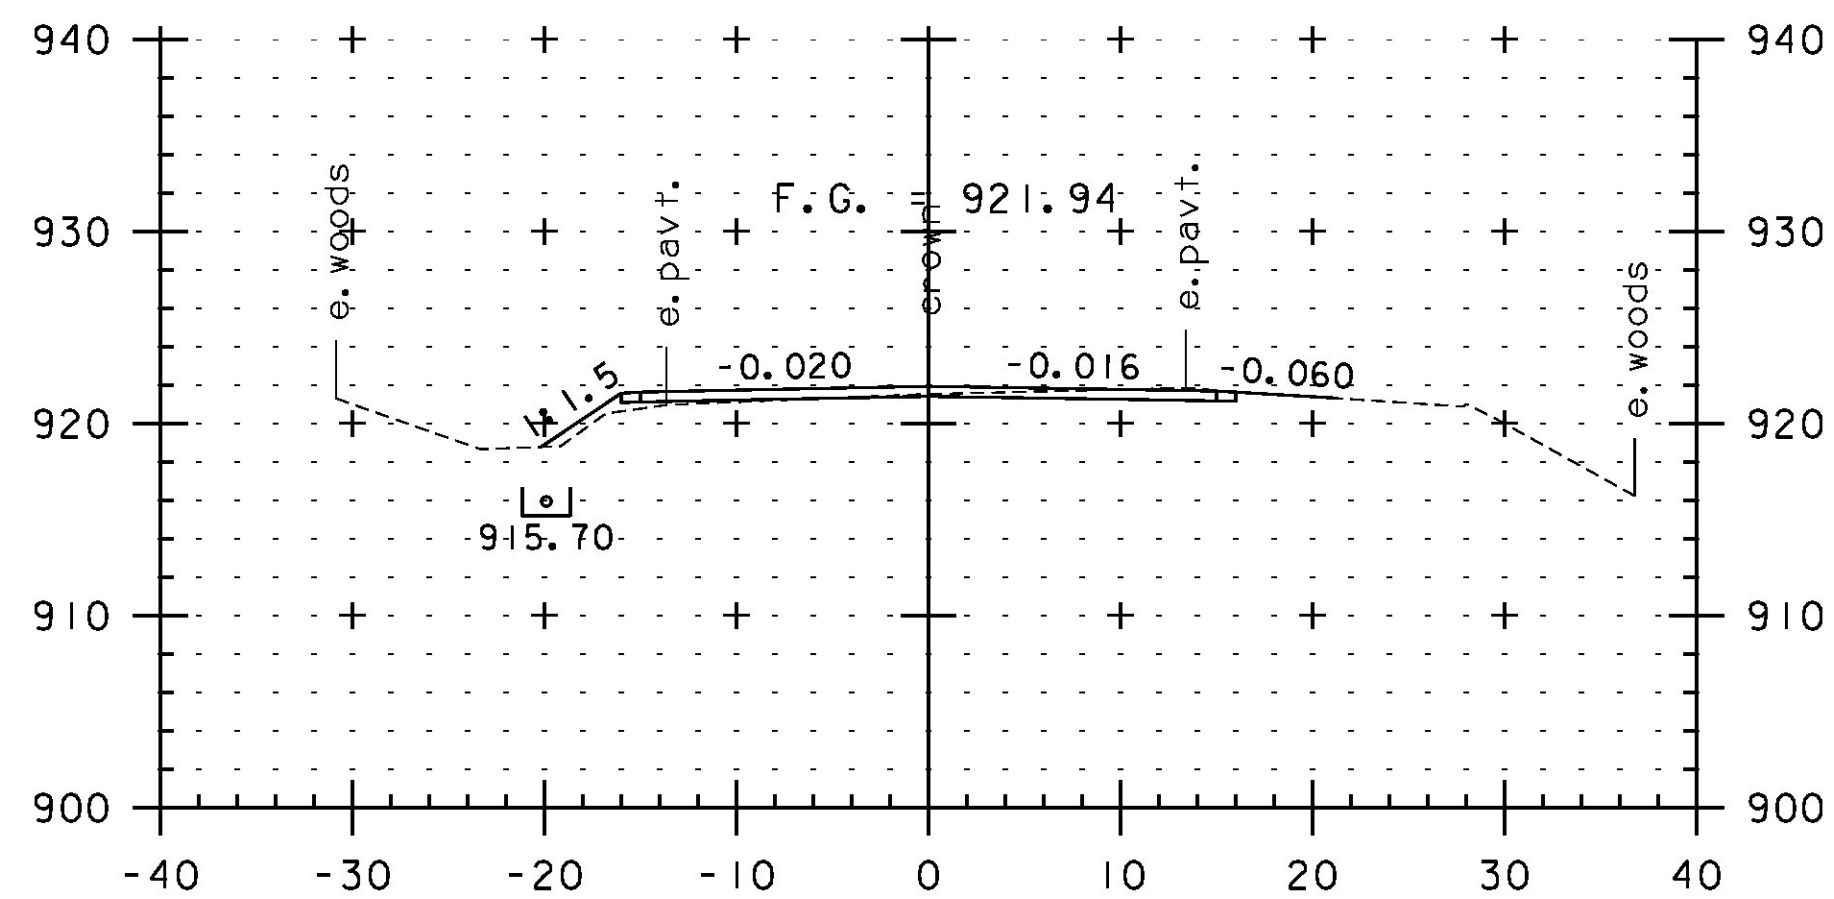

420+50

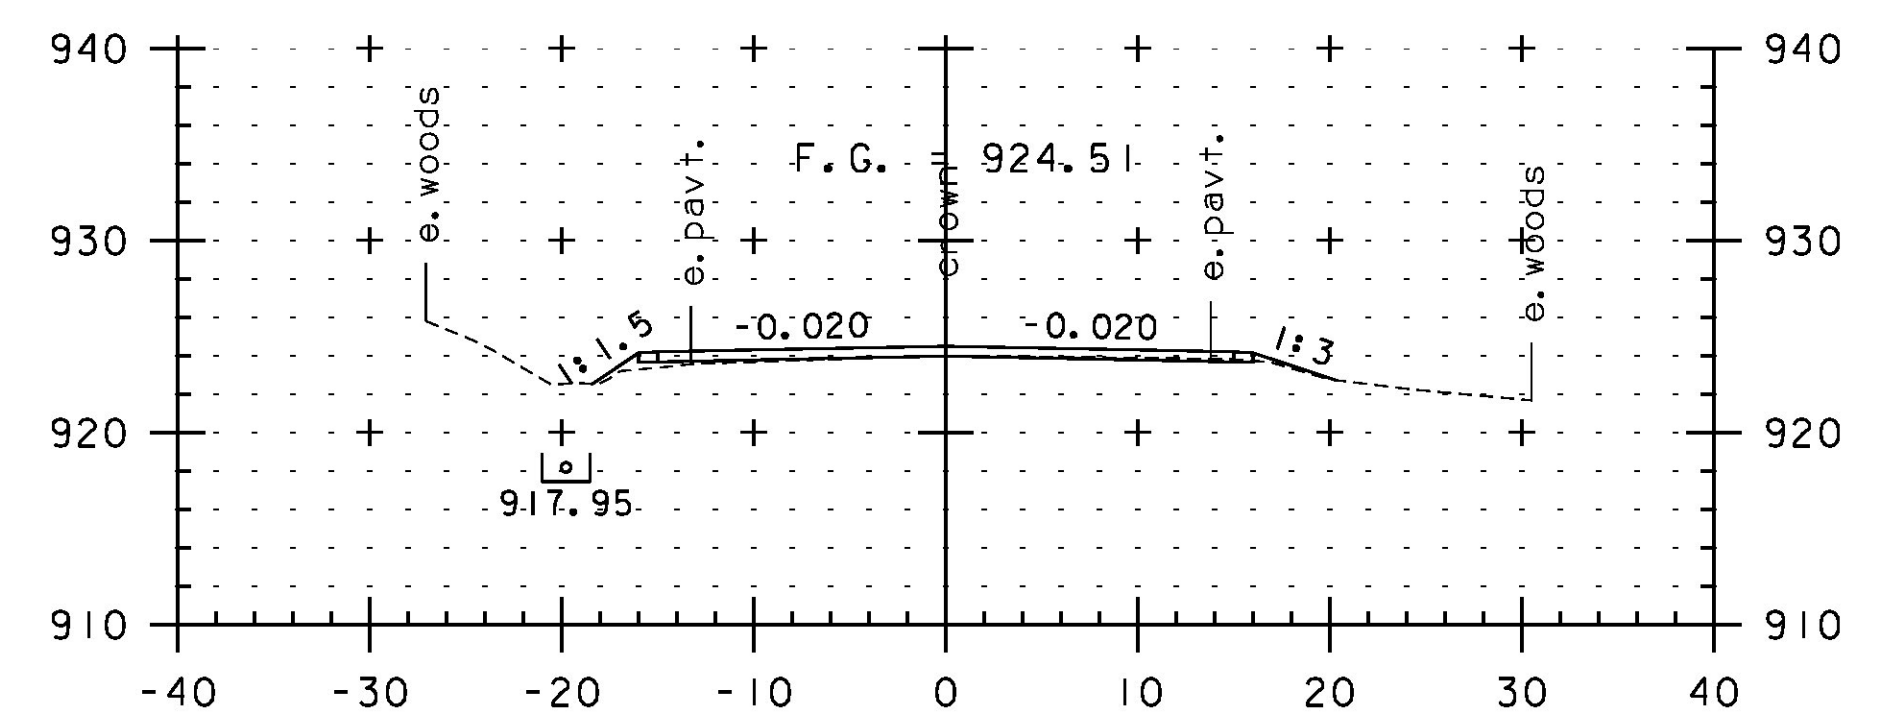

422+00



STA. 419+00 TO STA. 423+00

PROJECT NAME:	JAY-TROY	PLOT DATE:	5/16/2014
PROJECT NUMBER:	STP 2315(I)	DRAWN BY:	W. GORDON
FILE NAME:	z10b232xs.dgn	CHECKED BY:	P. SHEDD
PROJECT LEADER:	P. SHEDD	CROSS SECTION SHEET	97
DESIGNED BY:	N. LEMAY	SHEET	233 OF 244