




424+50

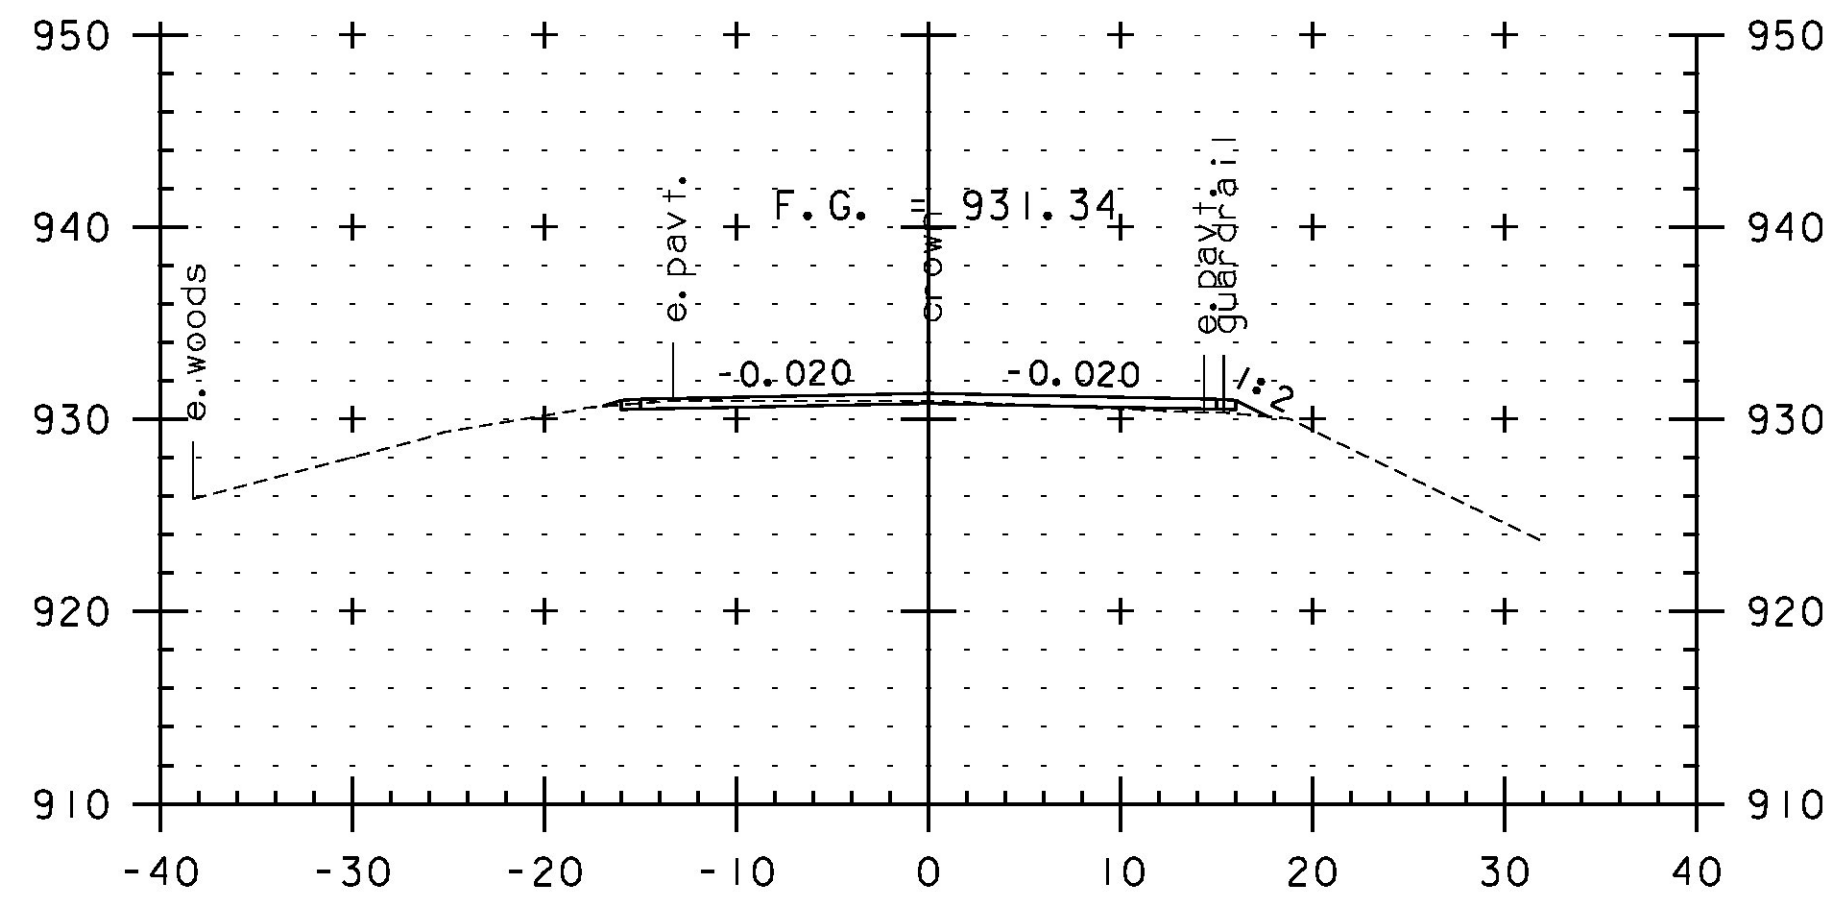


426+00

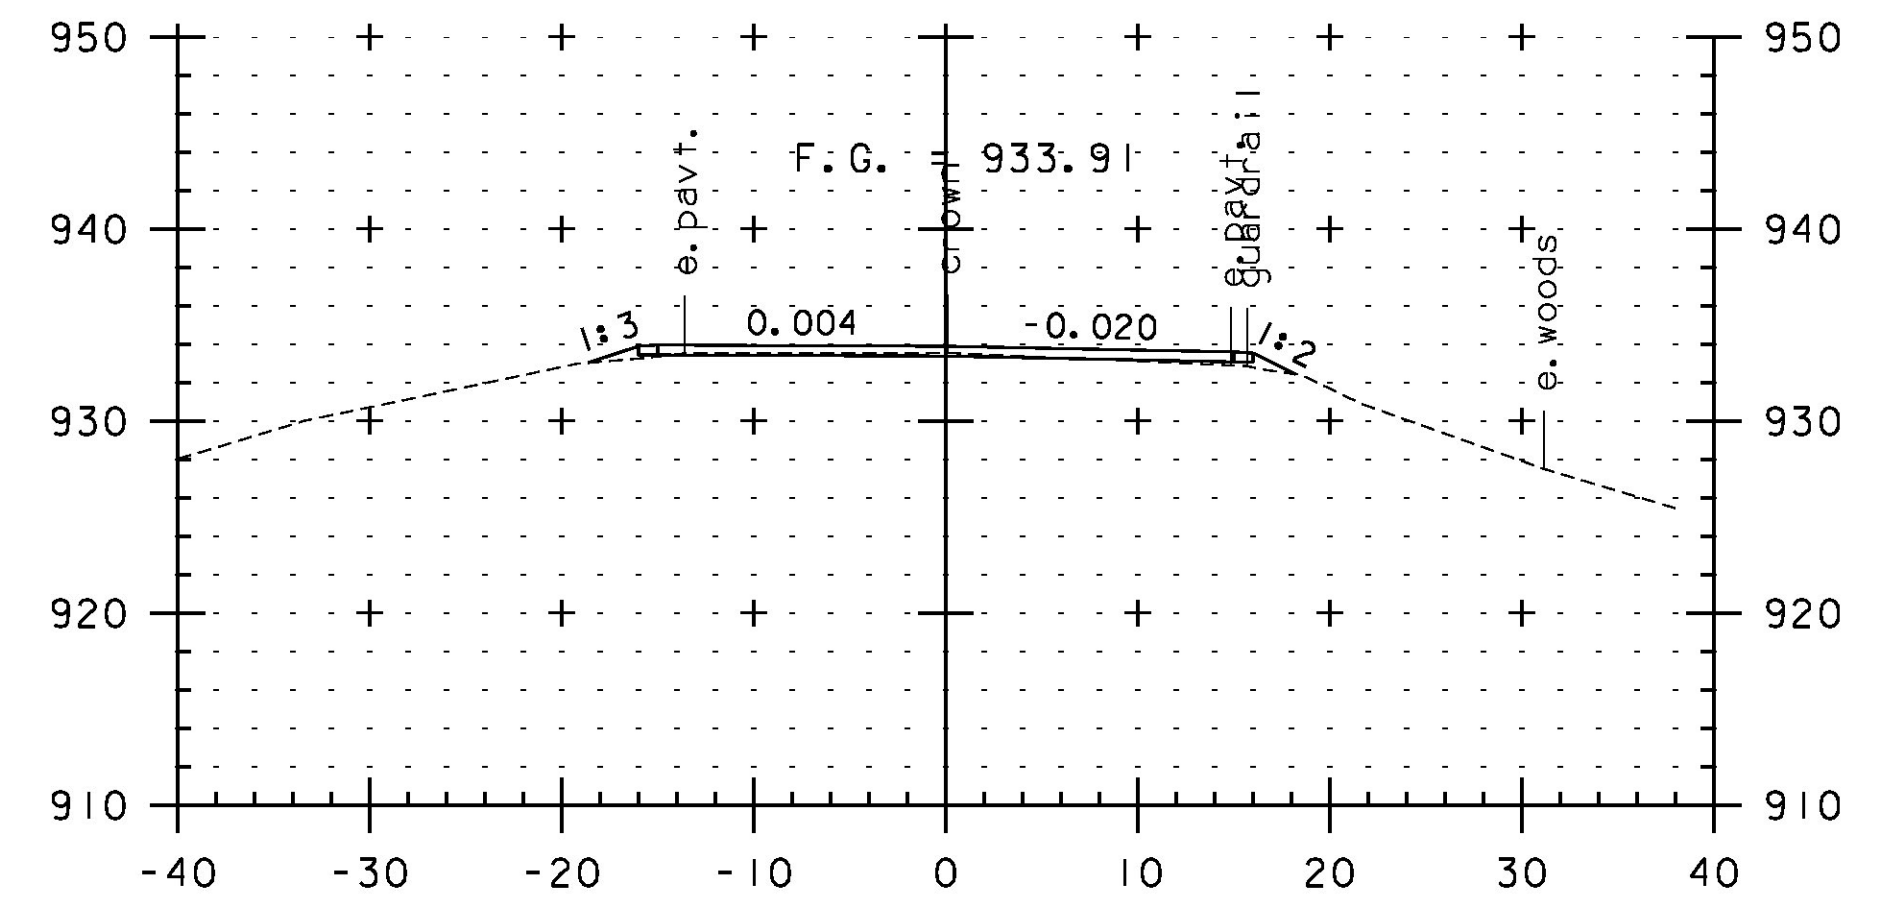


427+50

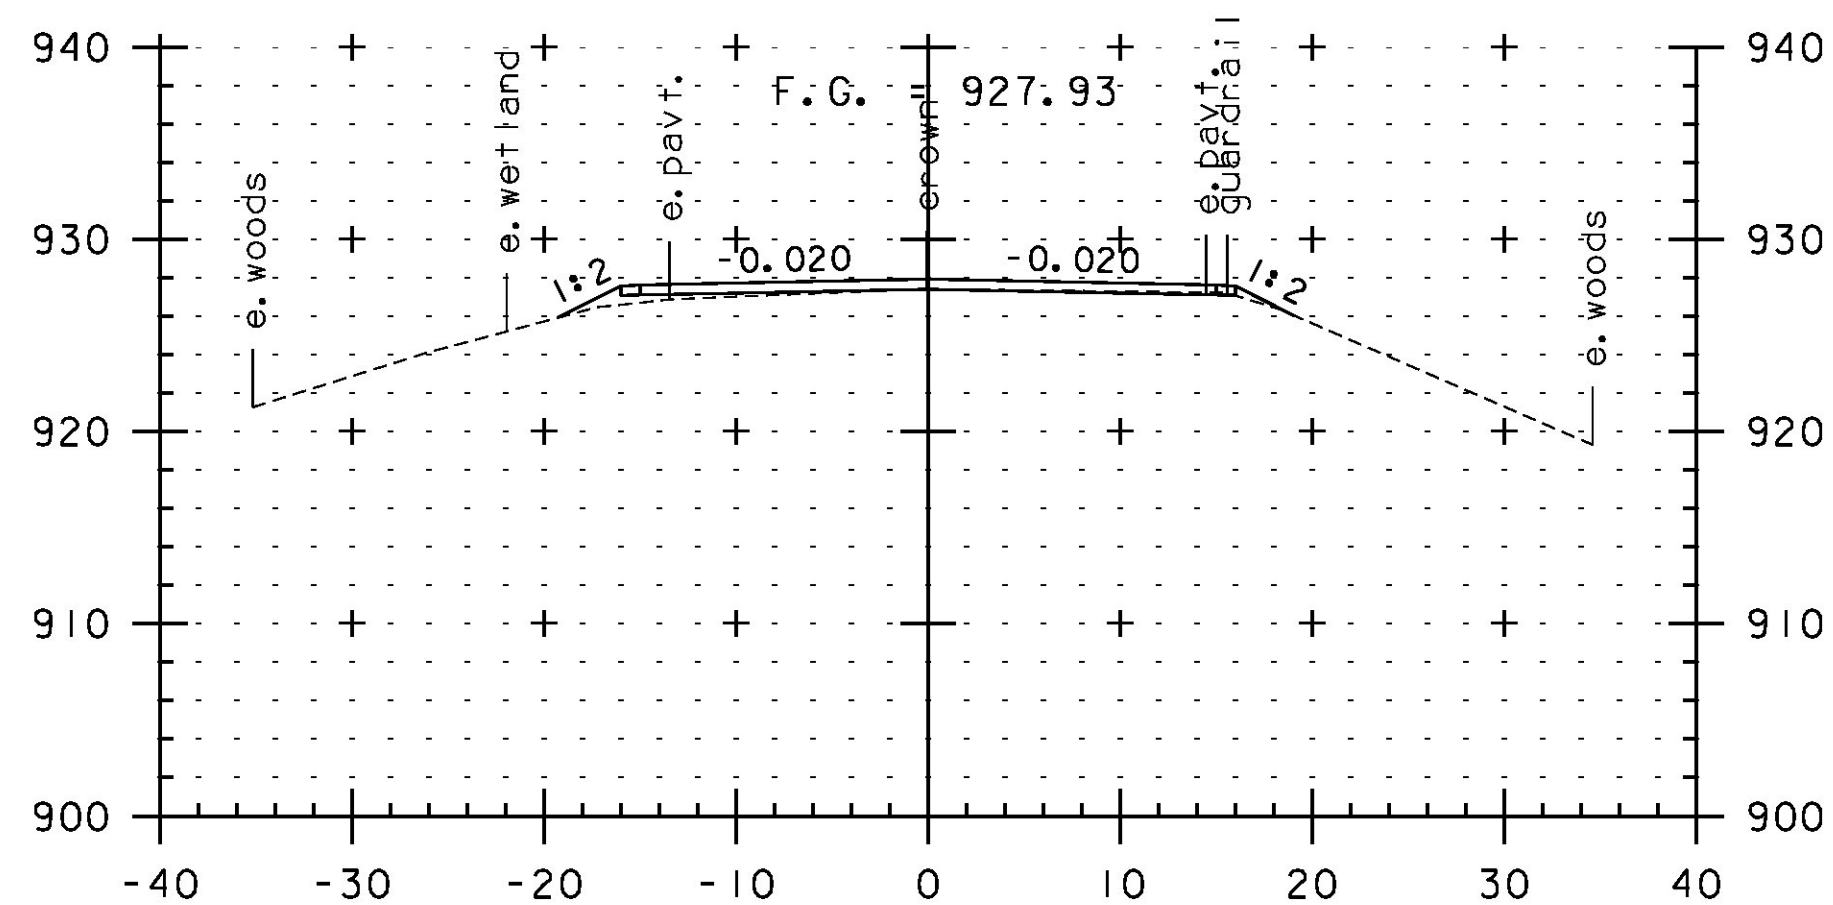


424+00

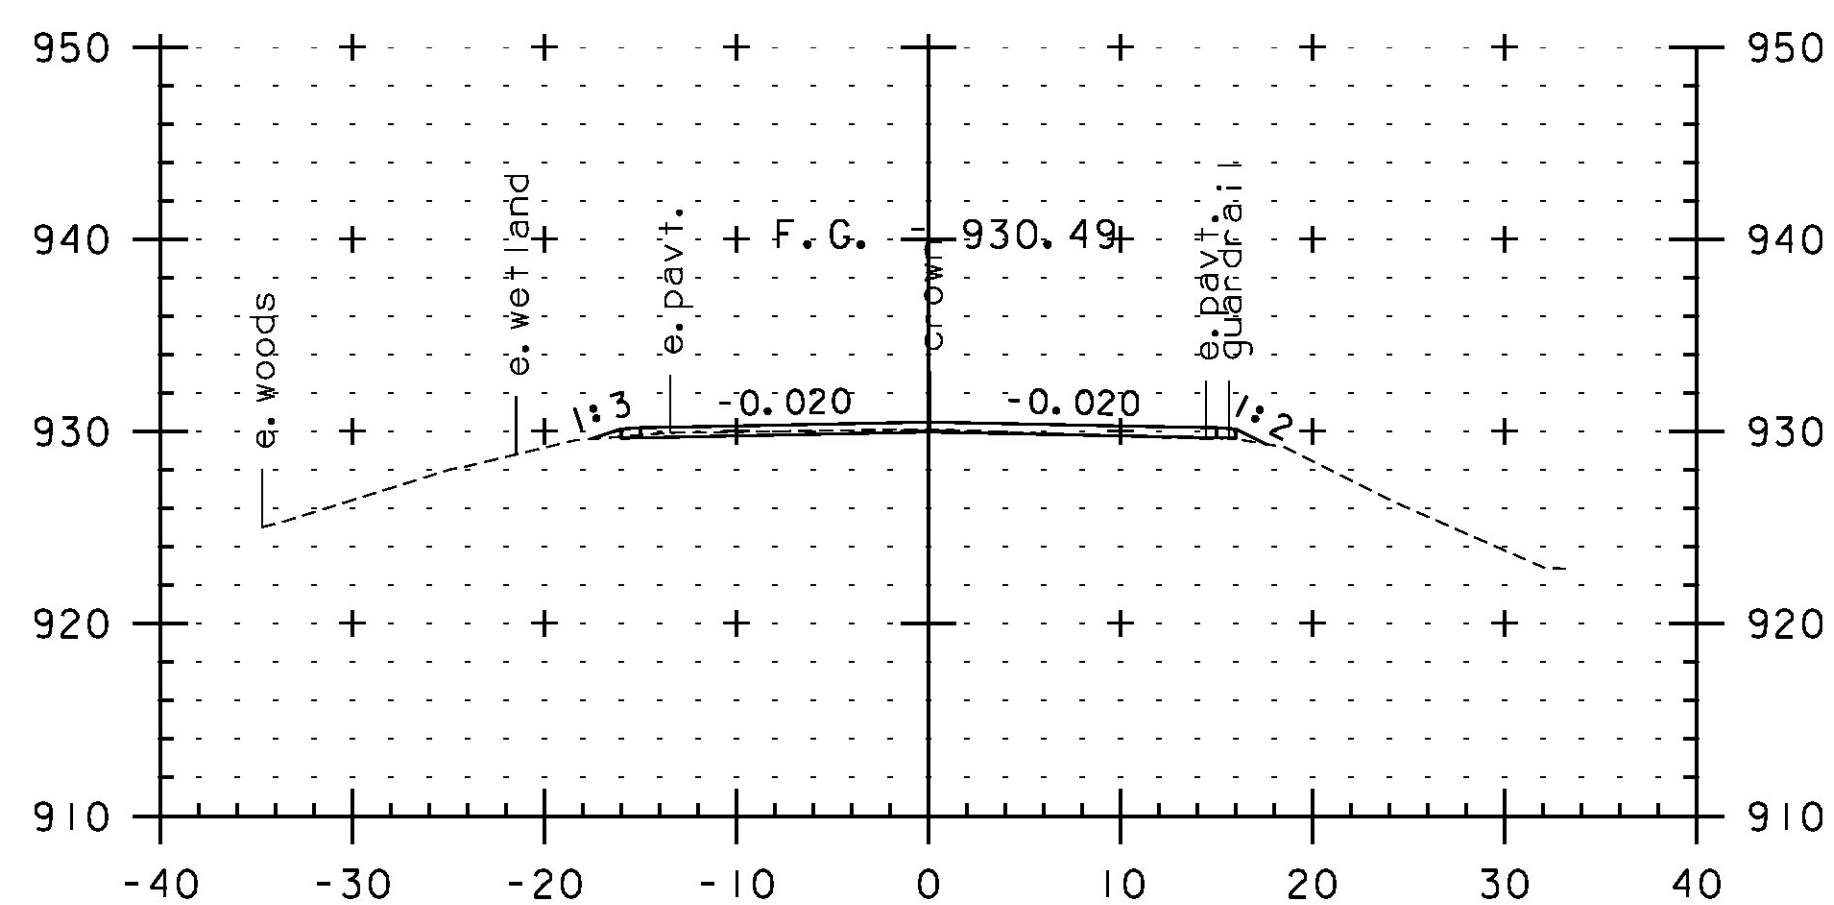


425+50

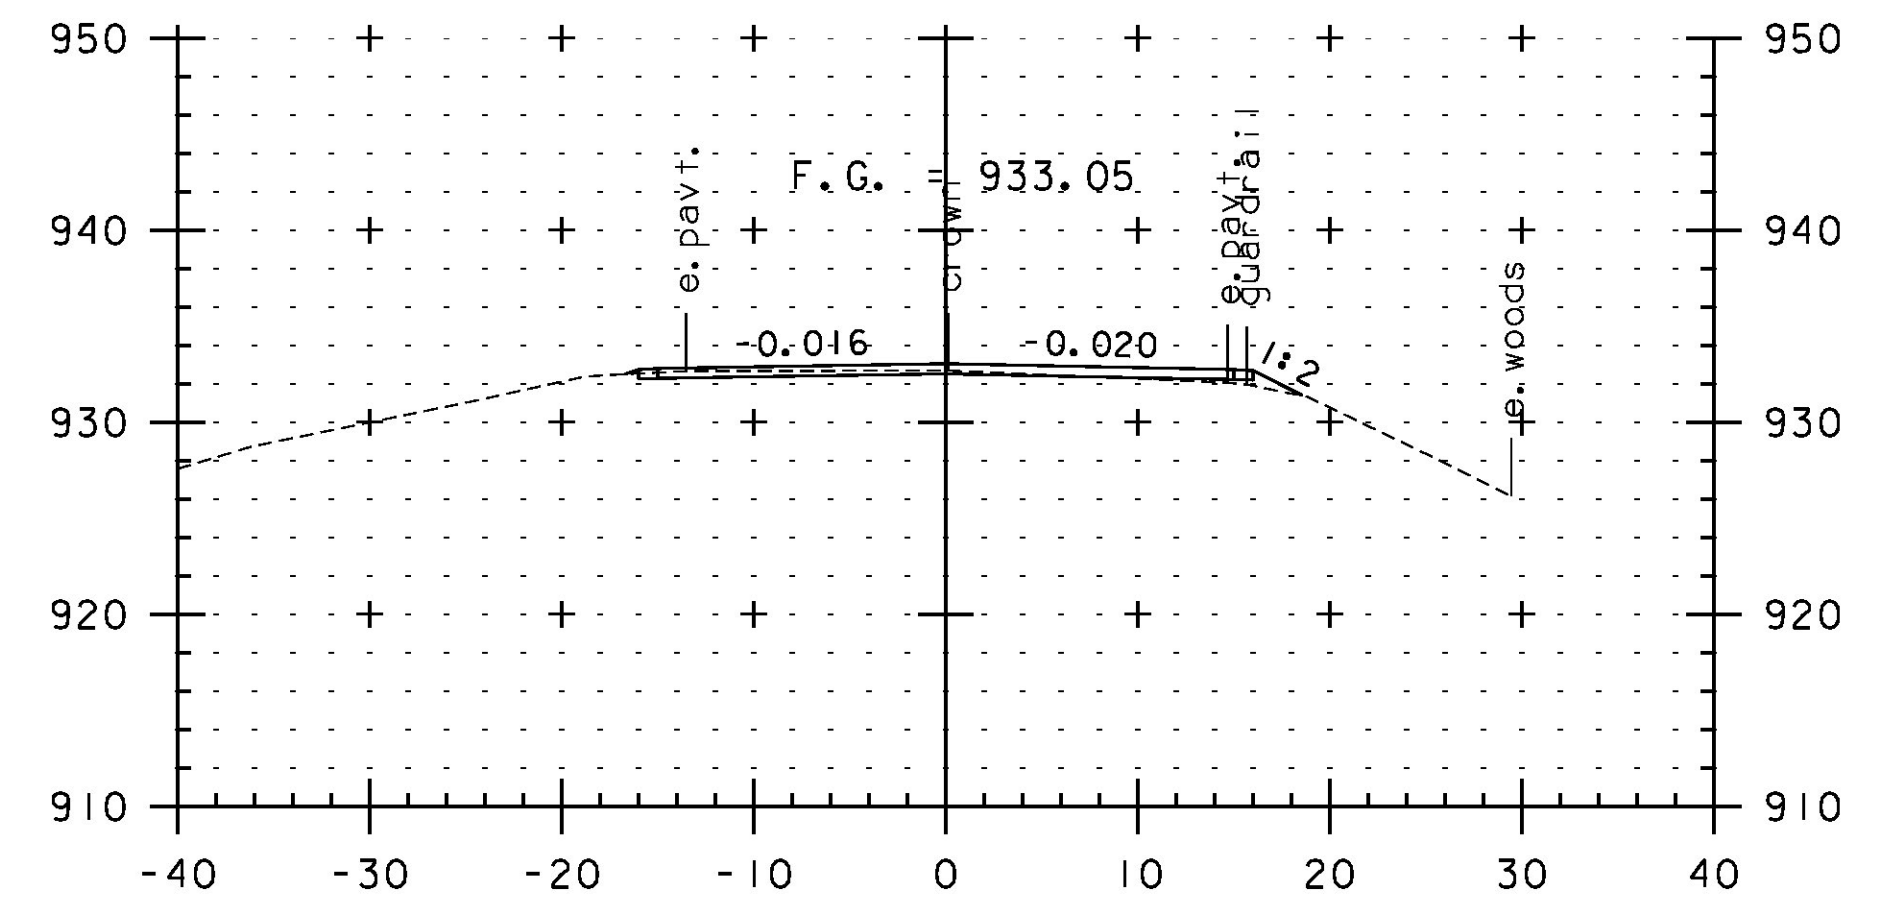


427+00

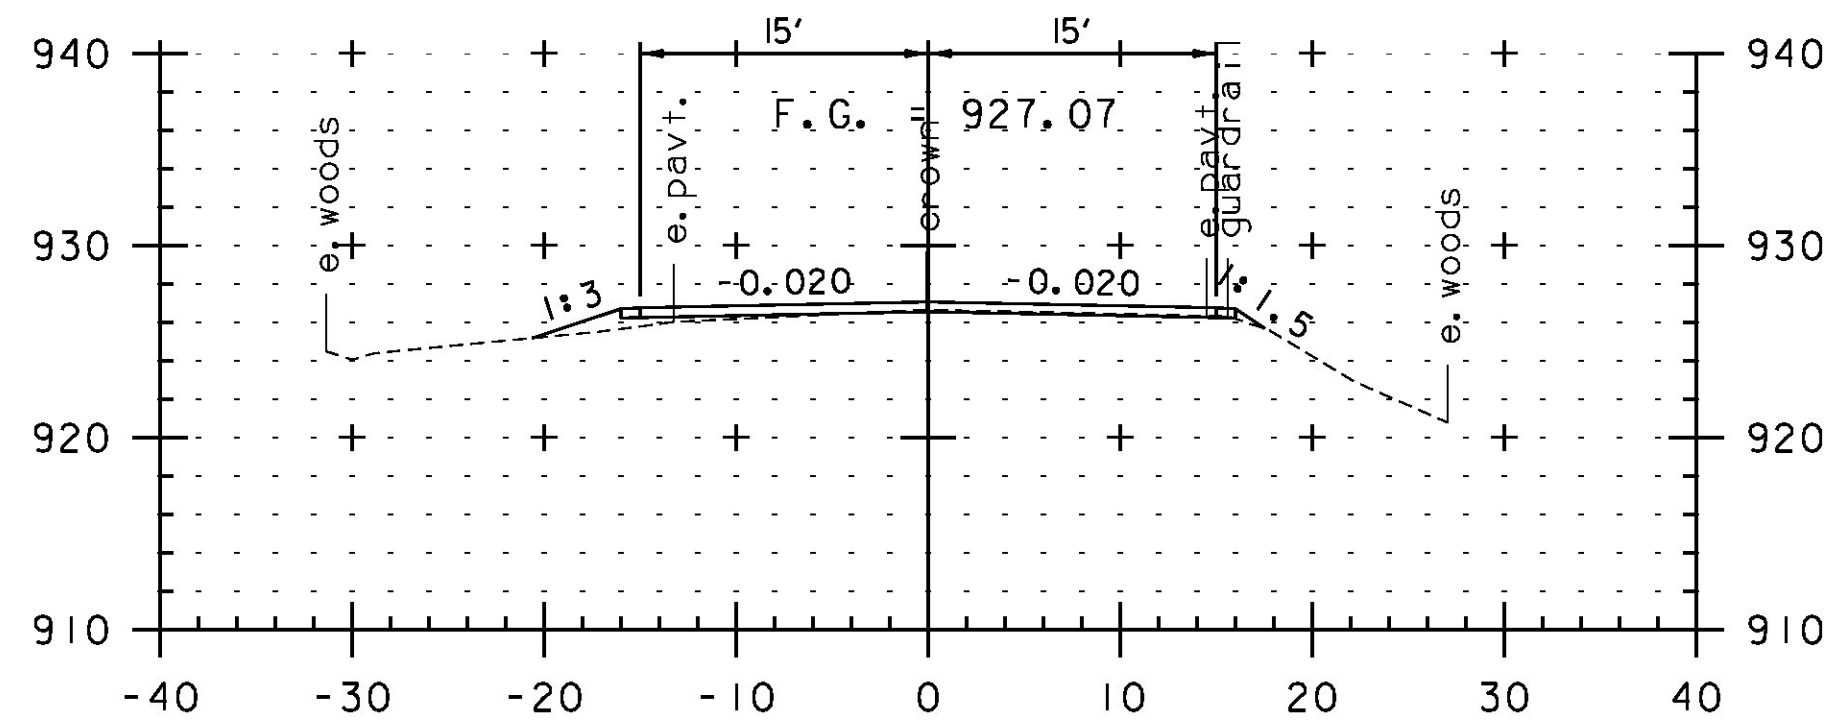

423+50

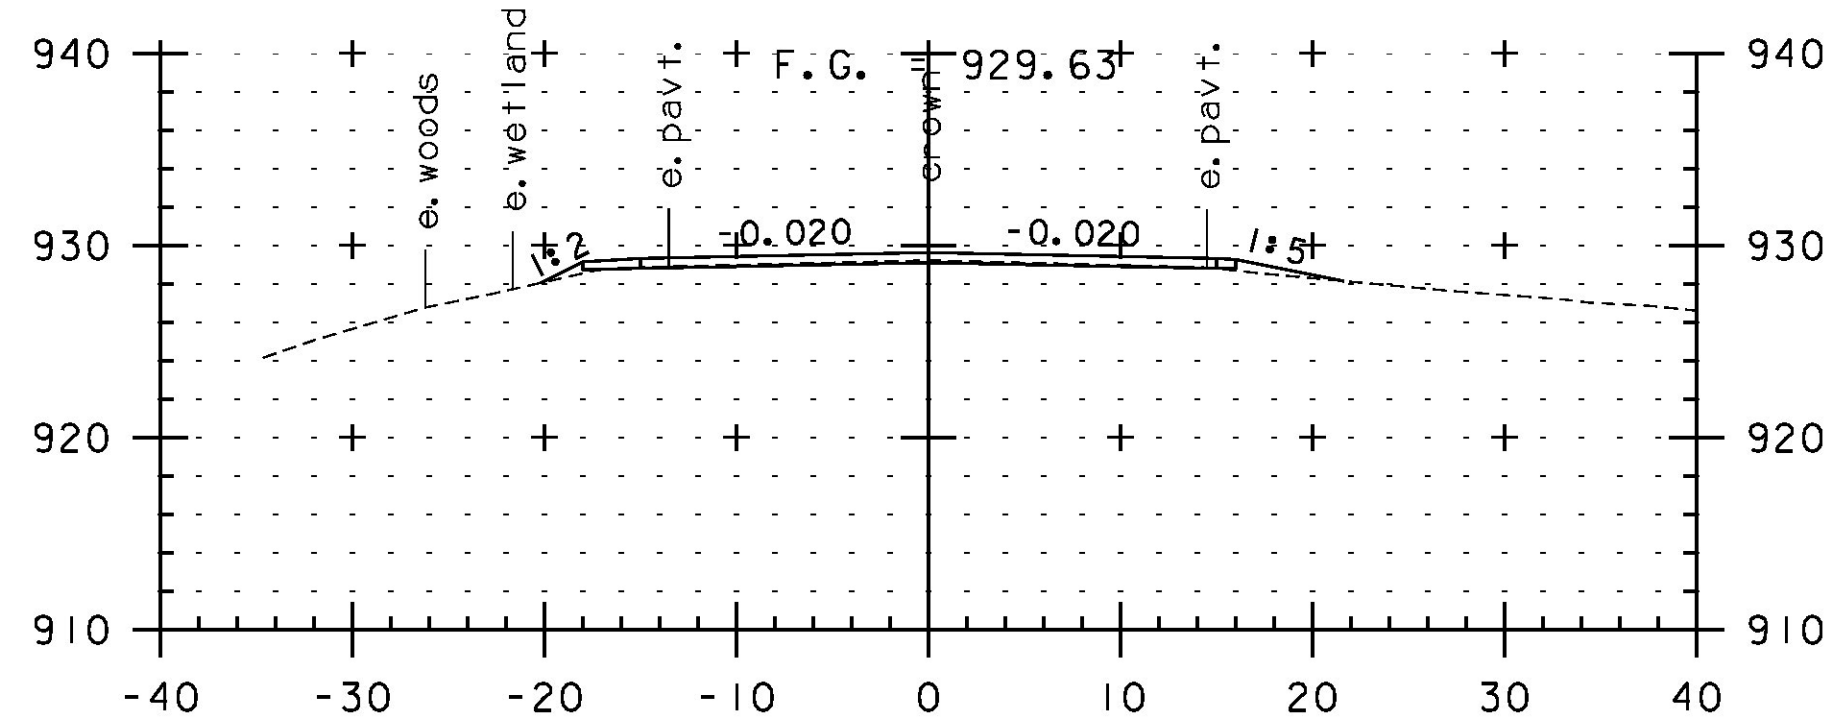

425+00

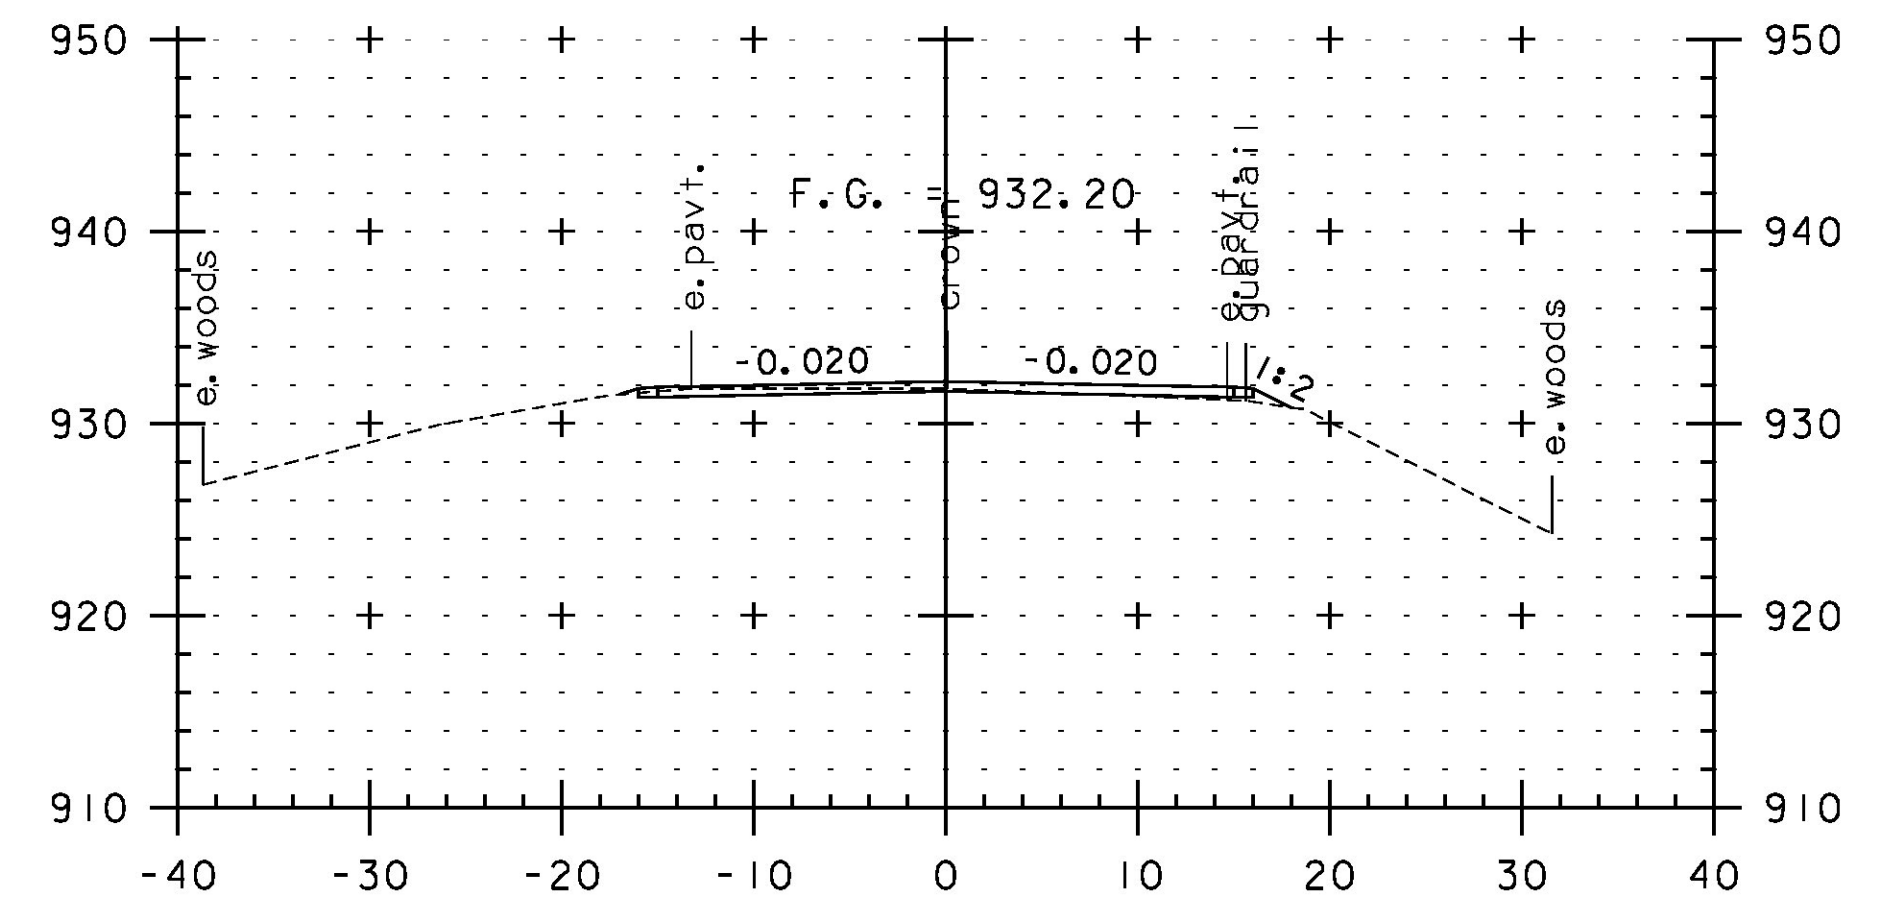

426+50



STA. 423+50 TO STA. 427+50

PROJECT NAME:	JAY-TROY	PLOT DATE:	5/16/2014
PROJECT NUMBER:	STP 2315(I)	DRAWN BY:	W. GORDON
FILE NAME:	z10b232xs.dgn	CHECKED BY:	P. SHEDD
PROJECT LEADER:	P. SHEDD	CROSS SECTION SHEET	98
DESIGNED BY:	N. LEMAY	SHEET	234 OF 244