




433+50

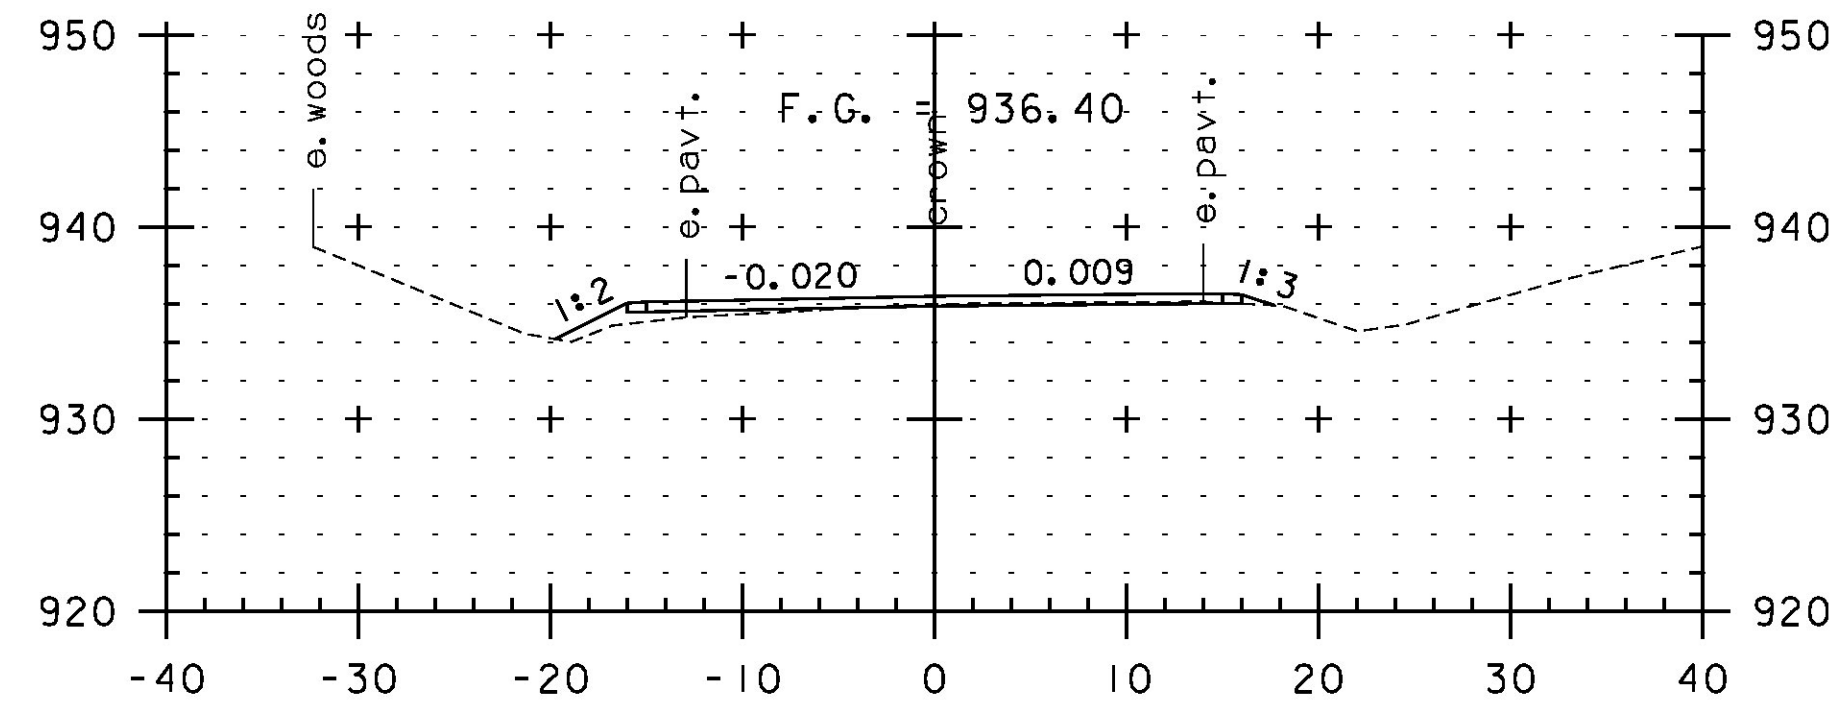


435+00

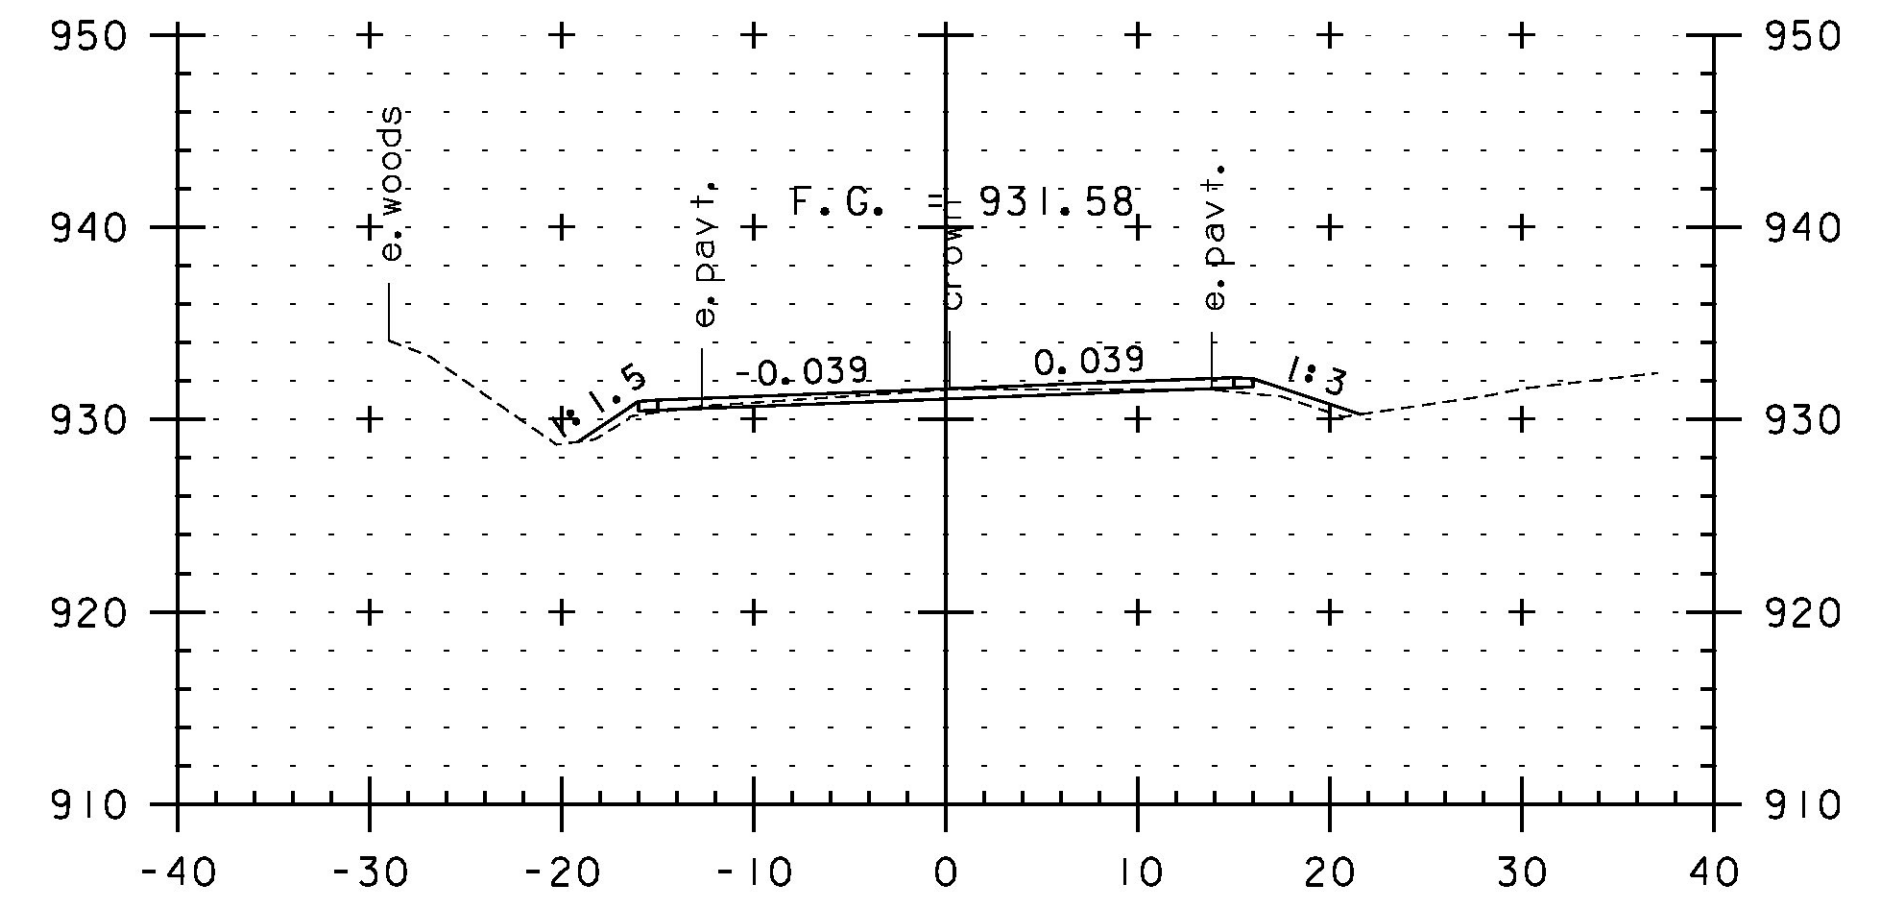


436+50

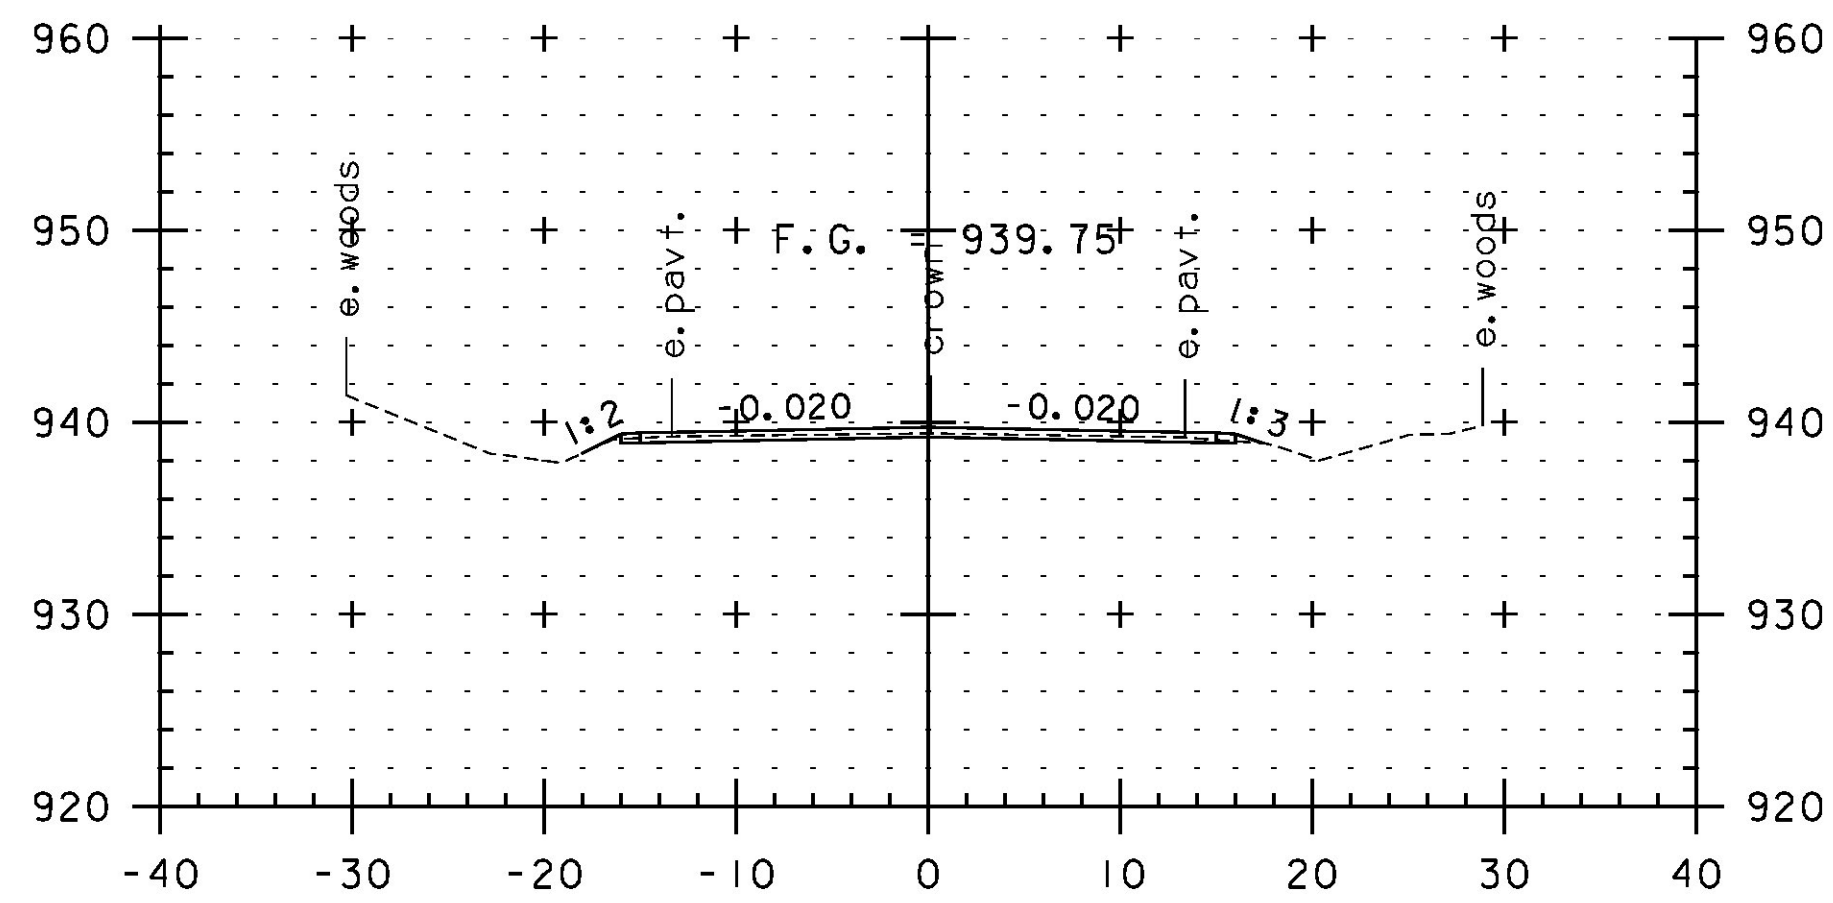


433+00

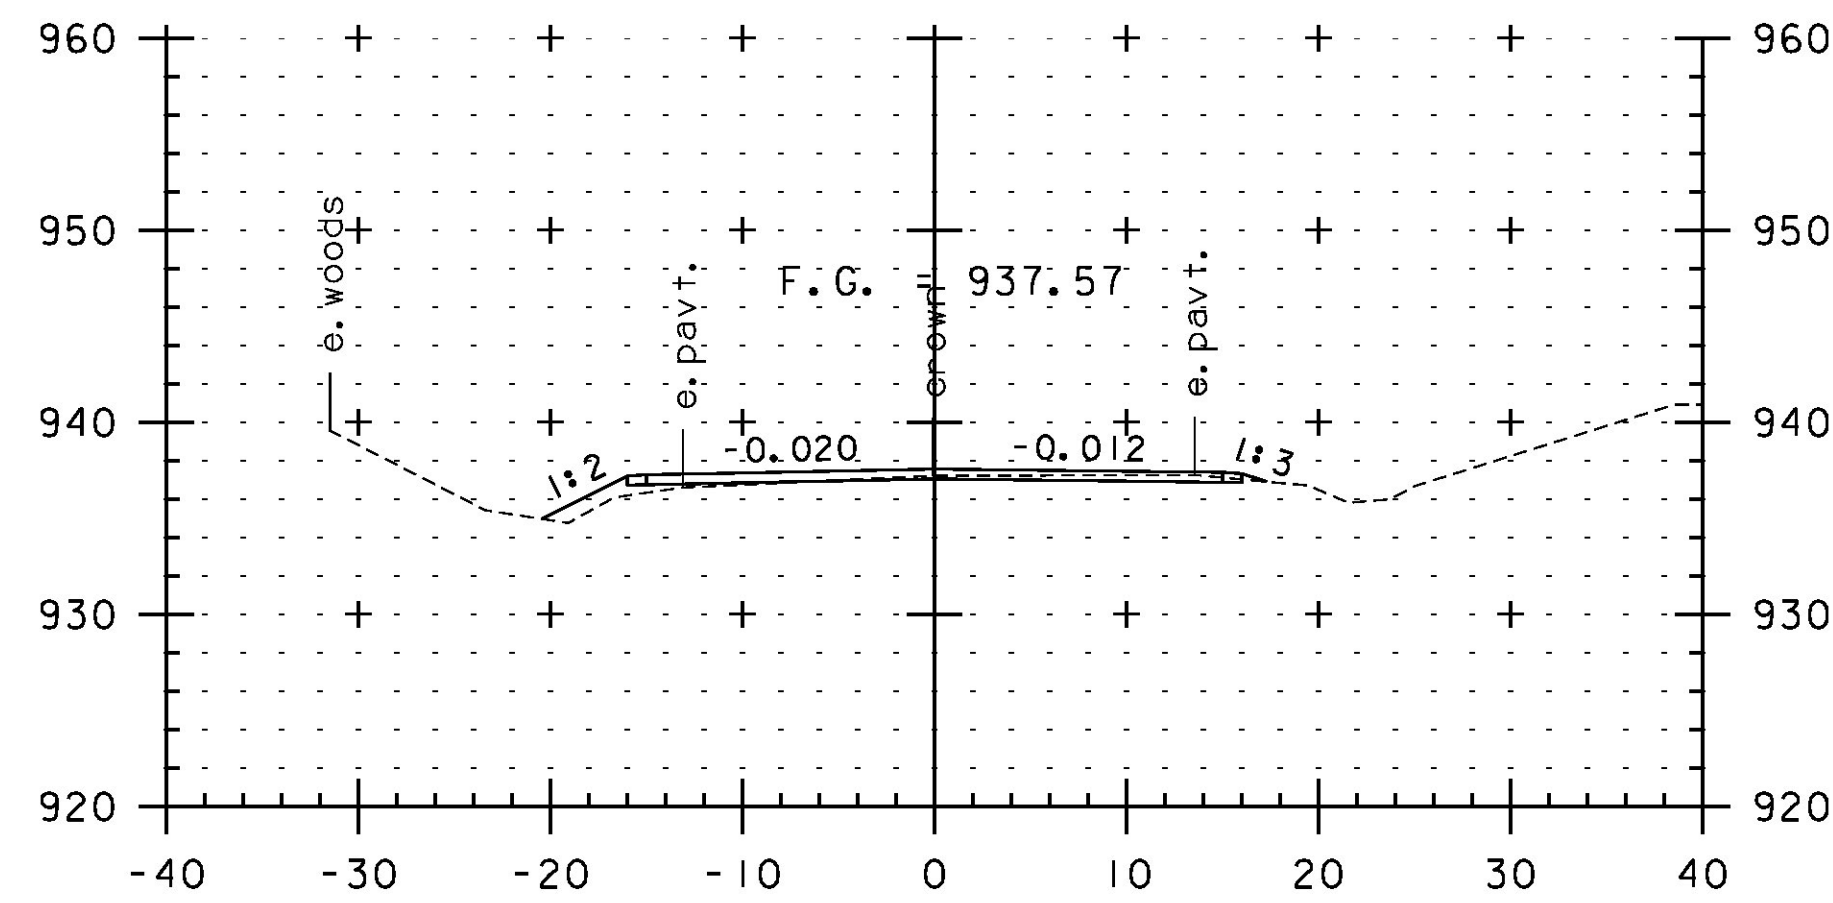


434+50

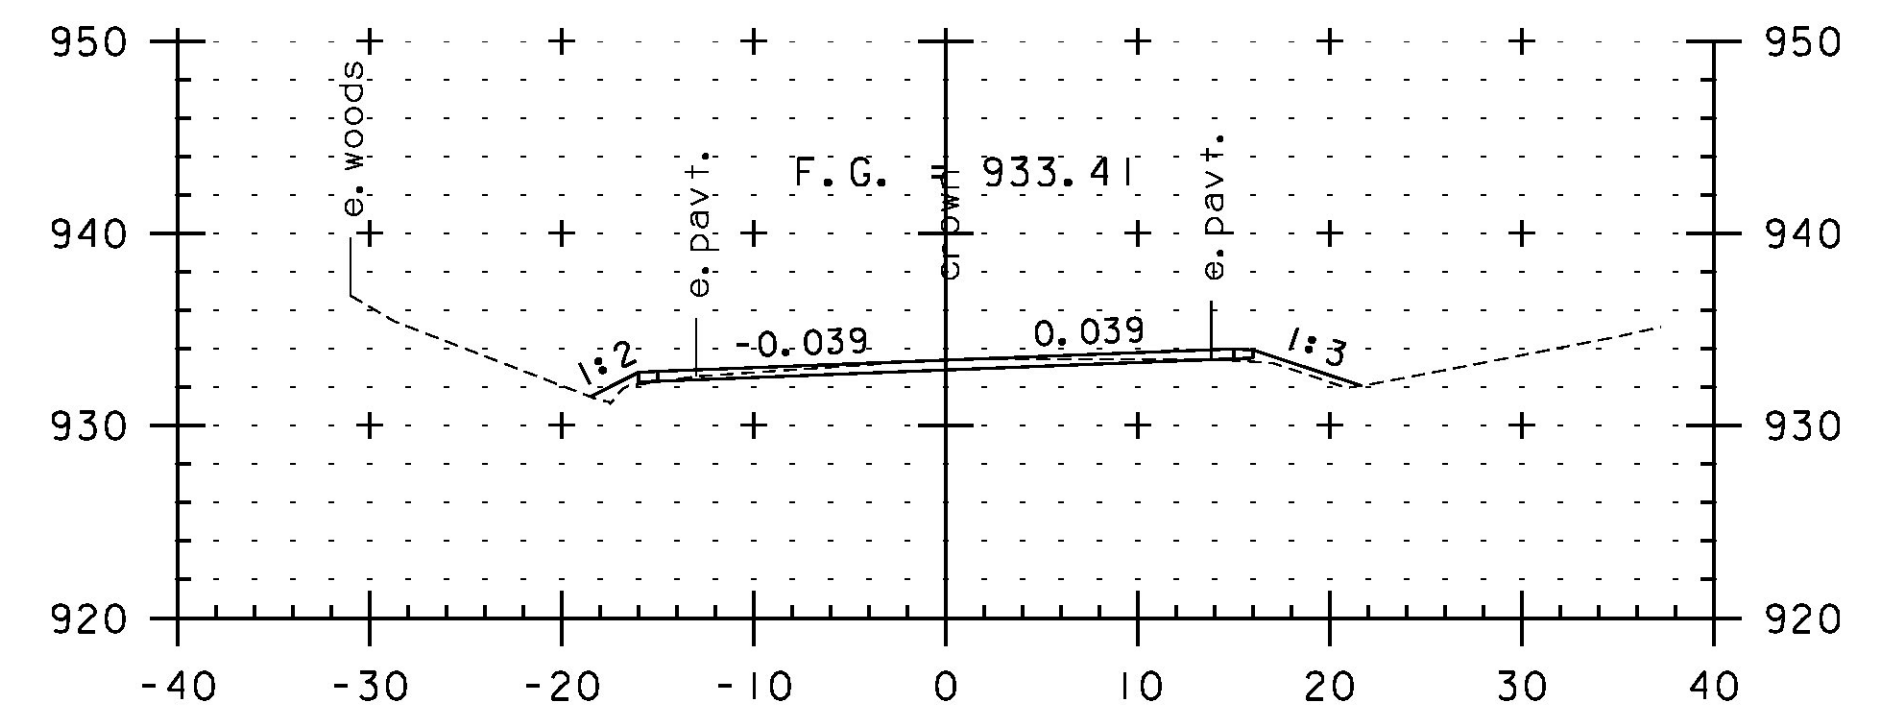


436+00

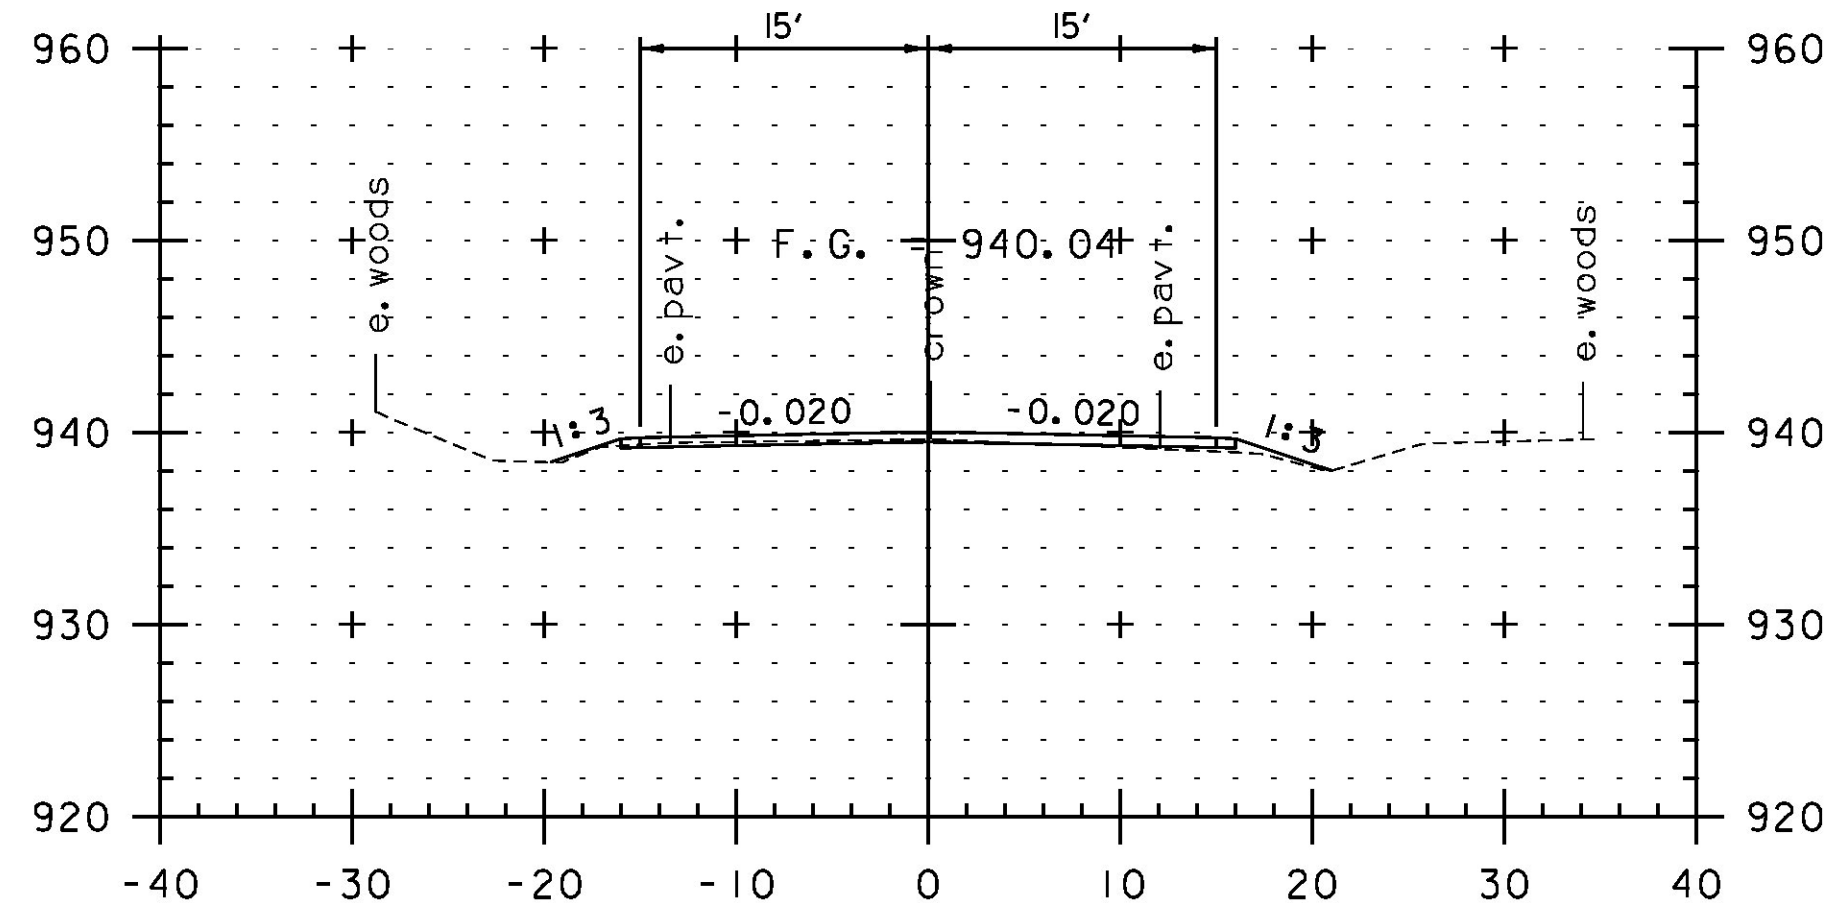

432+50

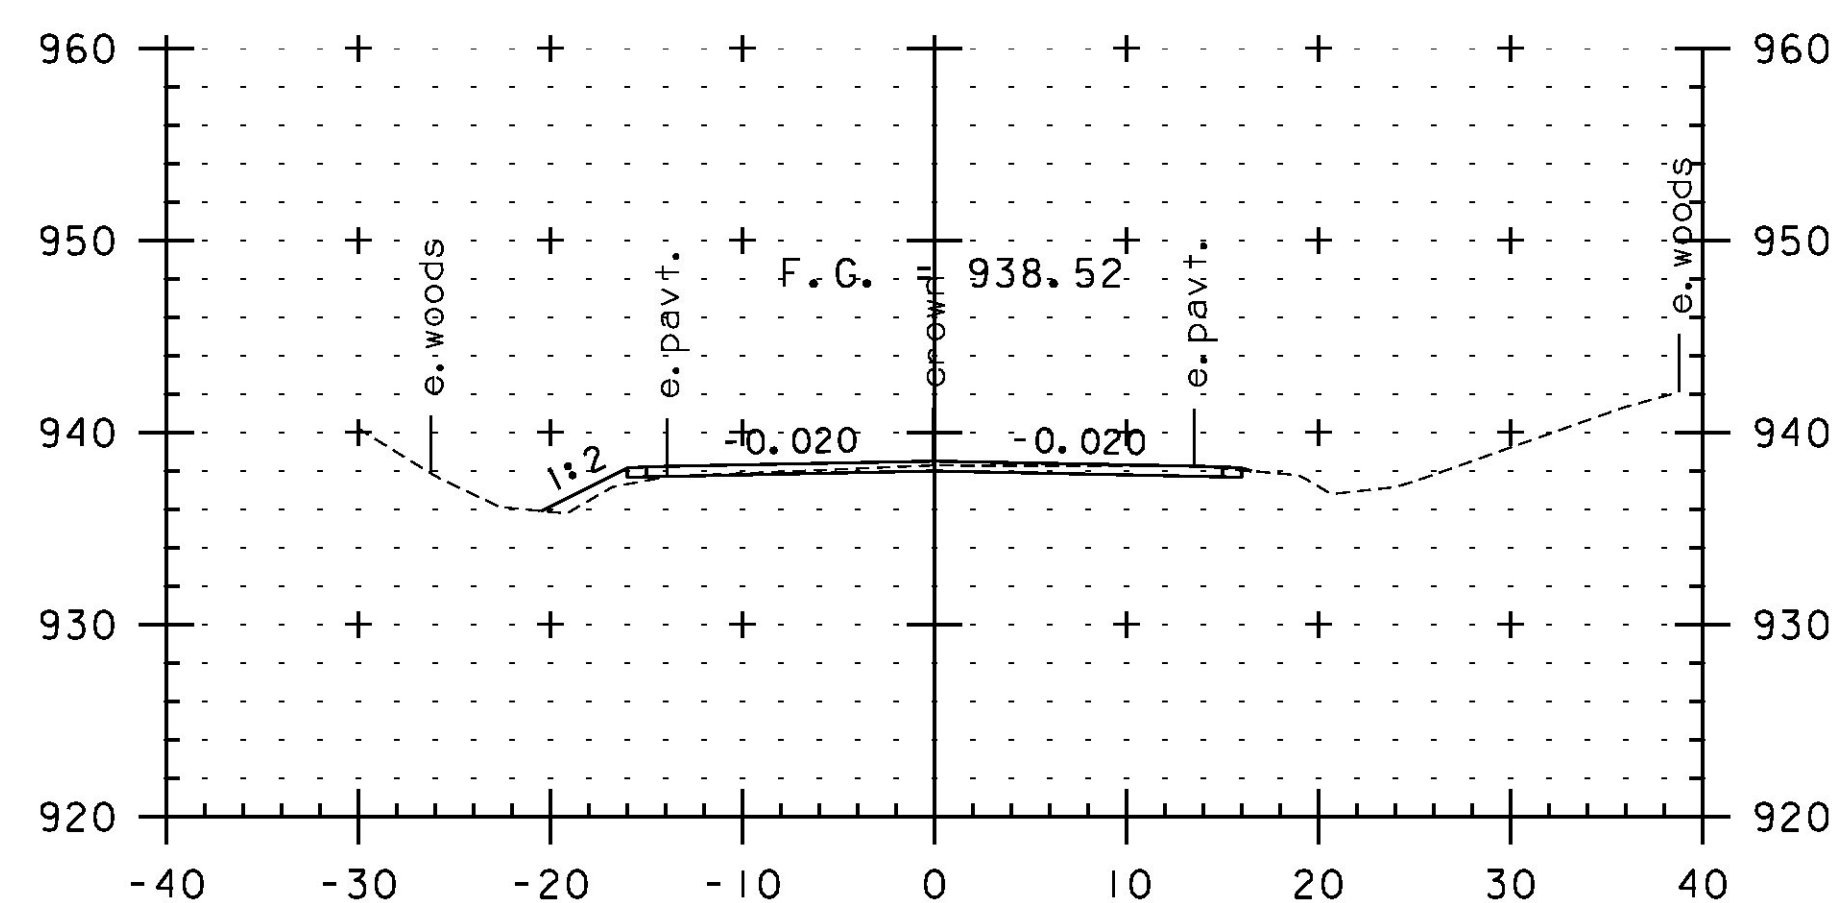

434+00

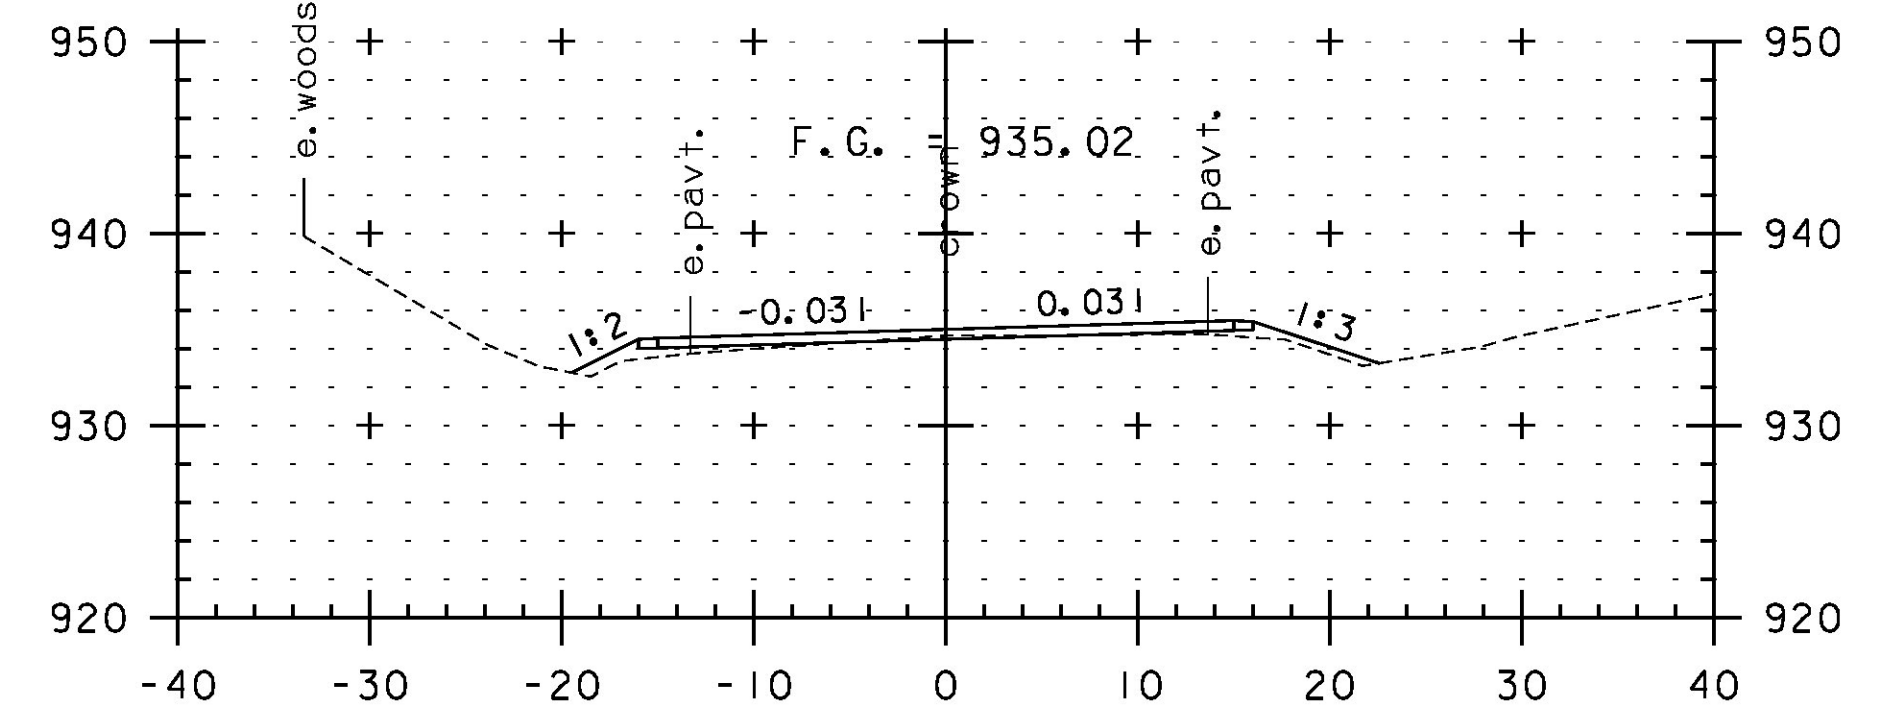

435+50



STA. 432+50 TO STA. 436+50

PROJECT NAME:	JAY-TROY	PLOT DATE:	5/16/2014
PROJECT NUMBER:	STP 2315(I)	DRAWN BY:	W. GORDON
FILE NAME:	z10b232xs.dgn	DESIGNED BY:	N. LEMAY
PROJECT LEADER:	P. SHEDD	CHECKED BY:	P. SHEDD
CROSS SECTION SHEET 100		SHEET	236 OF 244