




438+00

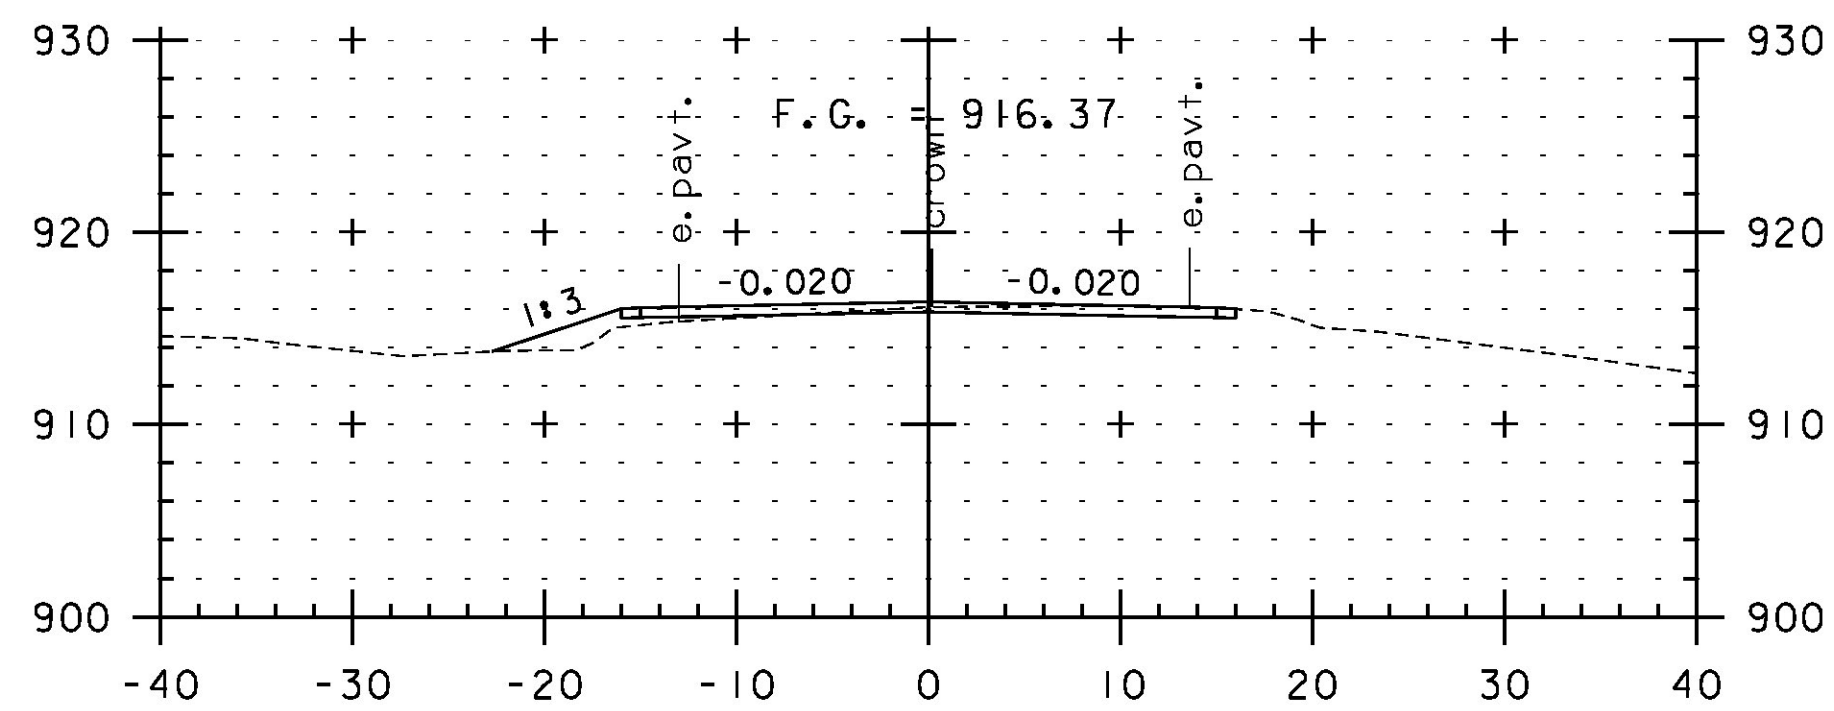


439+50

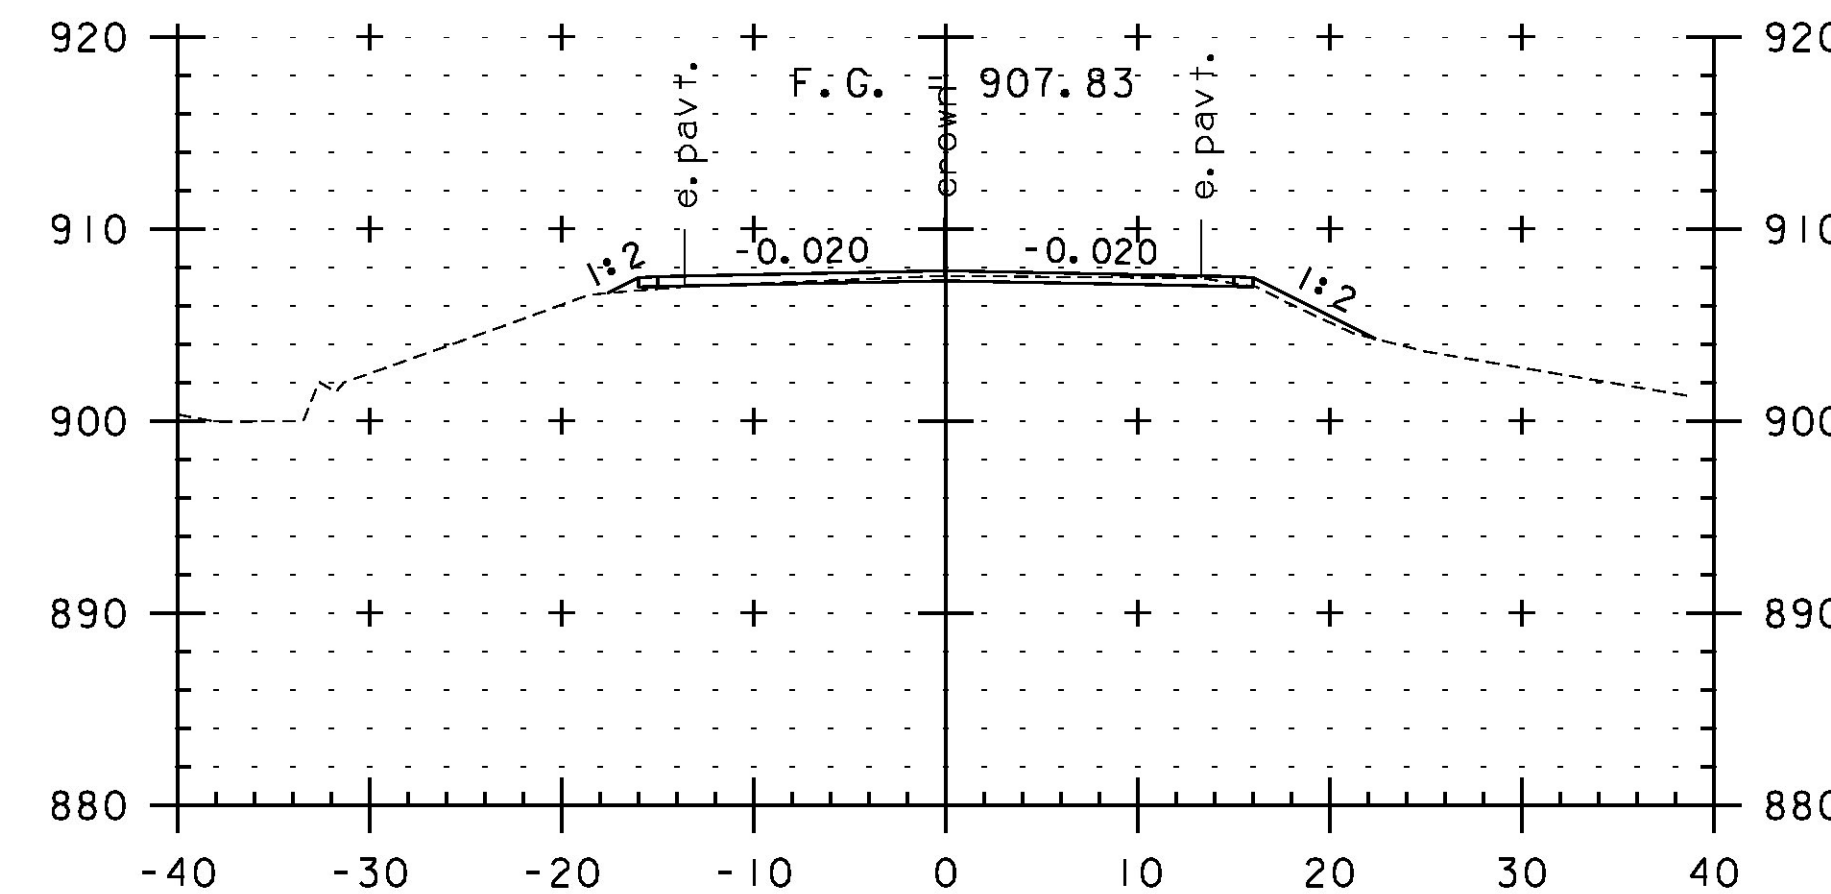


441+00

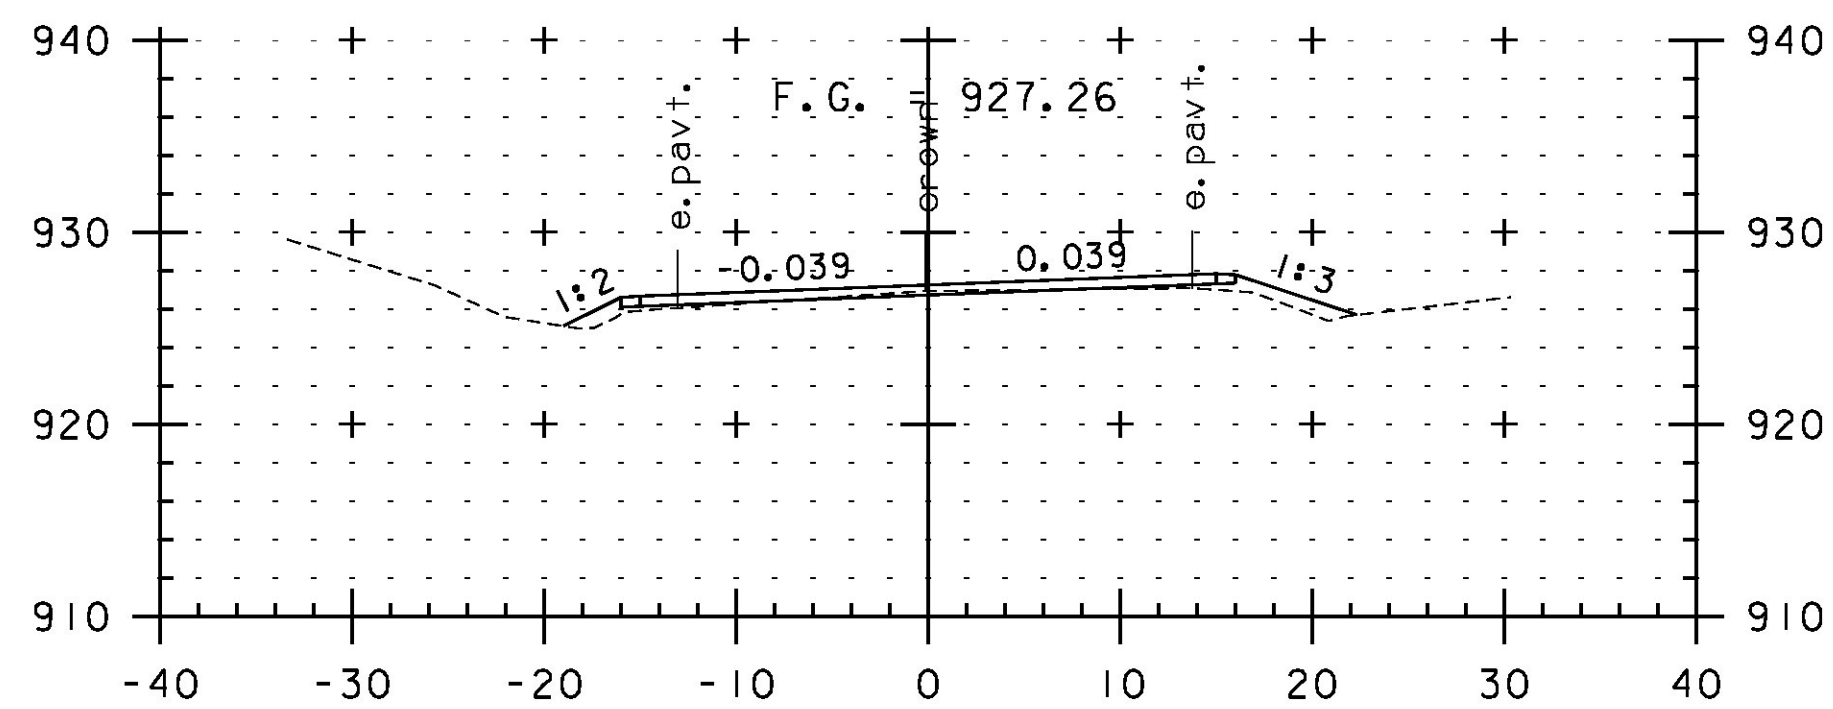


437+50

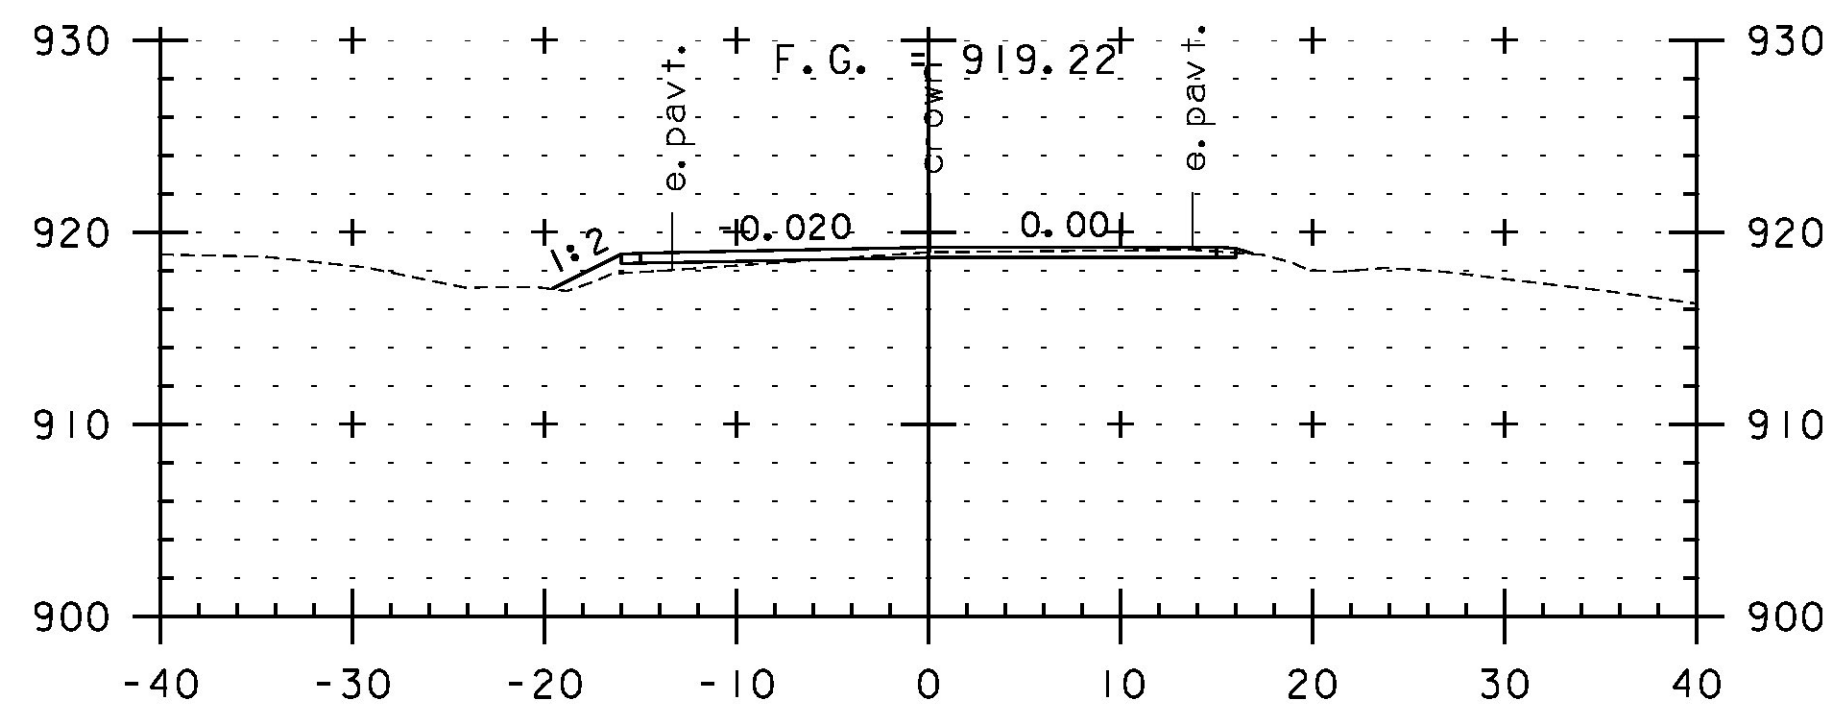


439+00

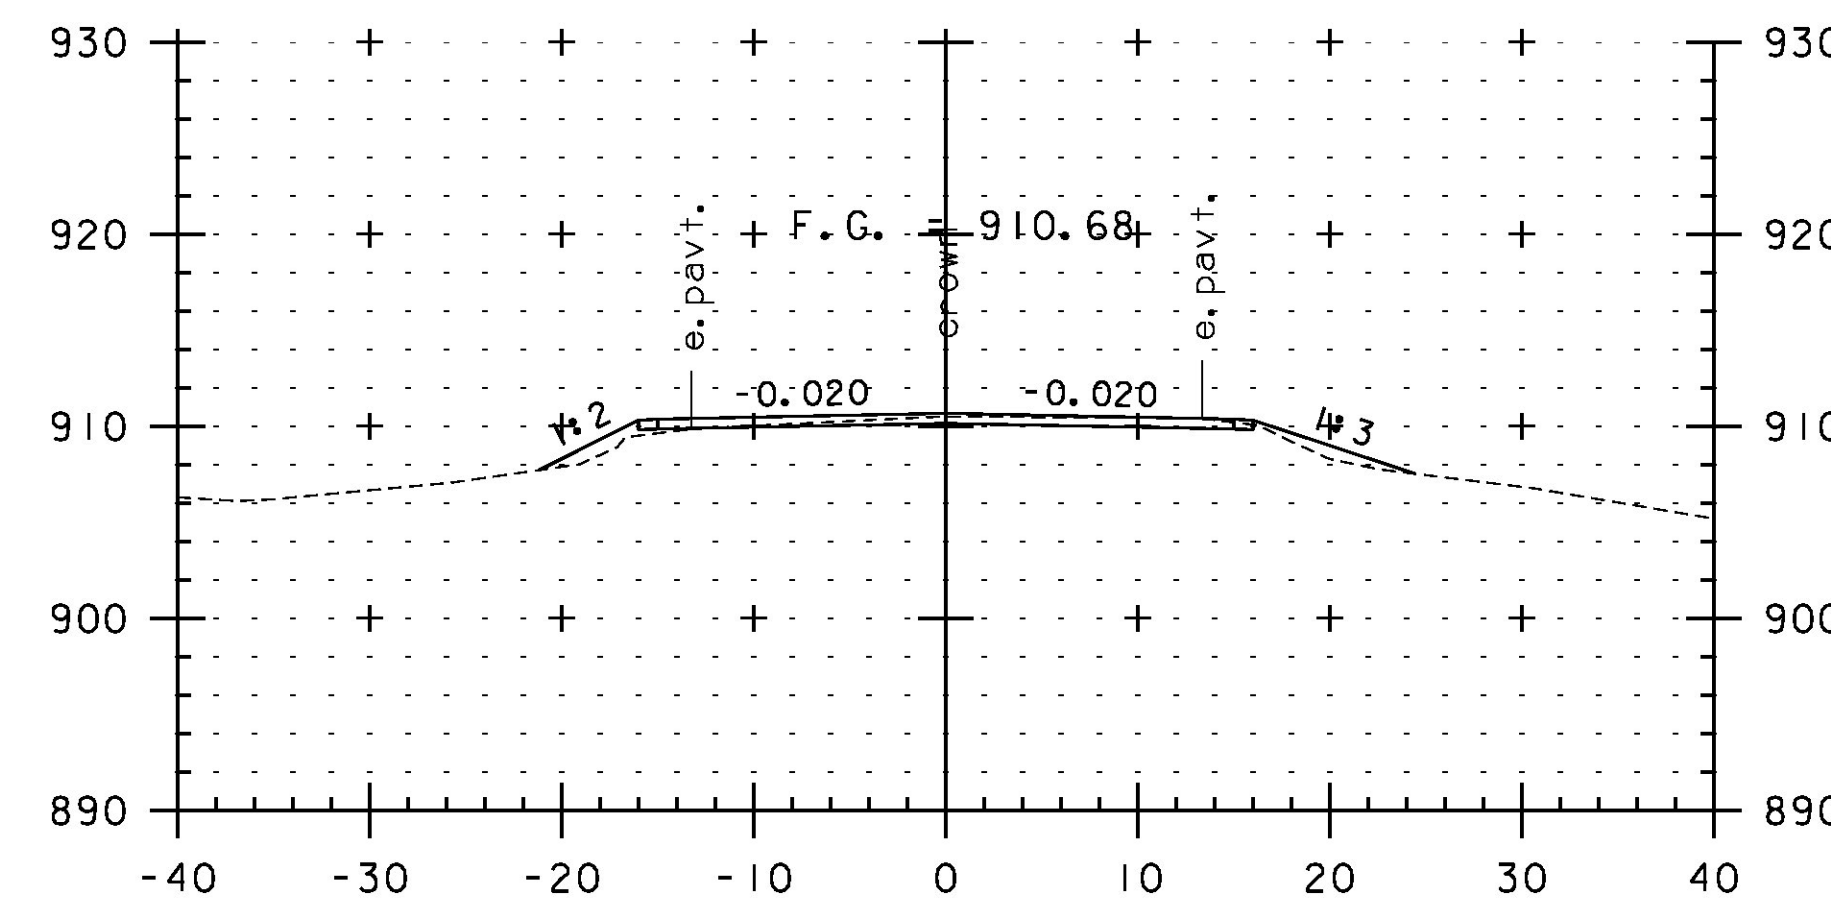


440+50

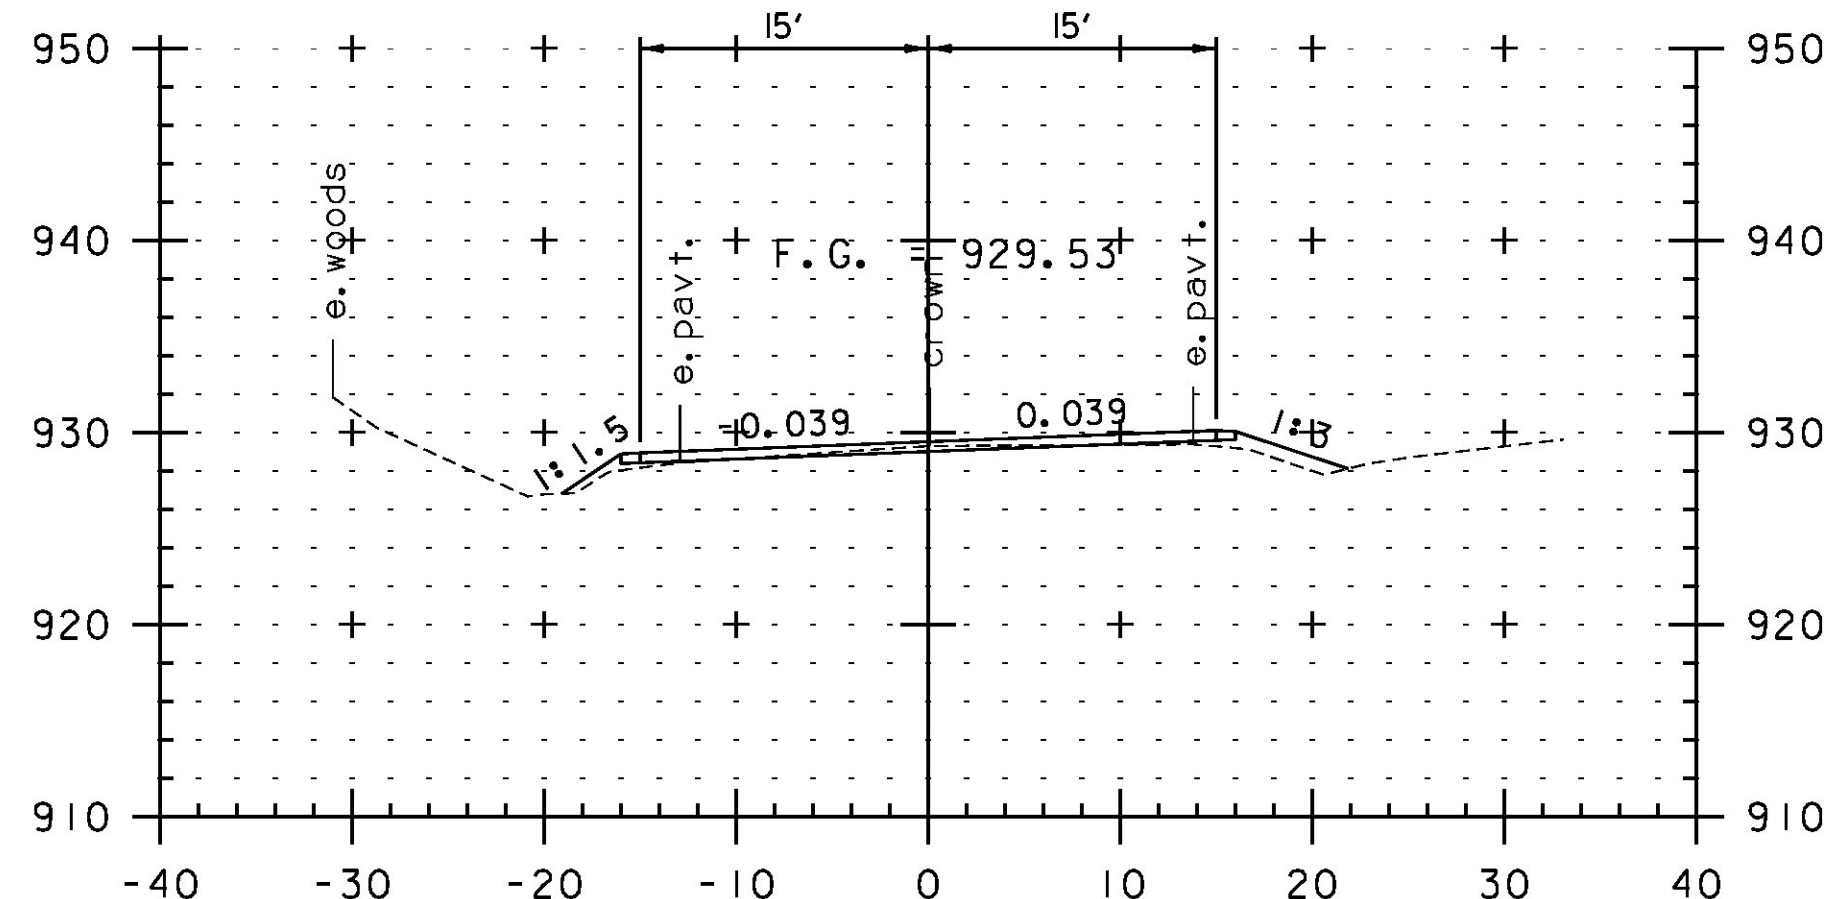

437+00

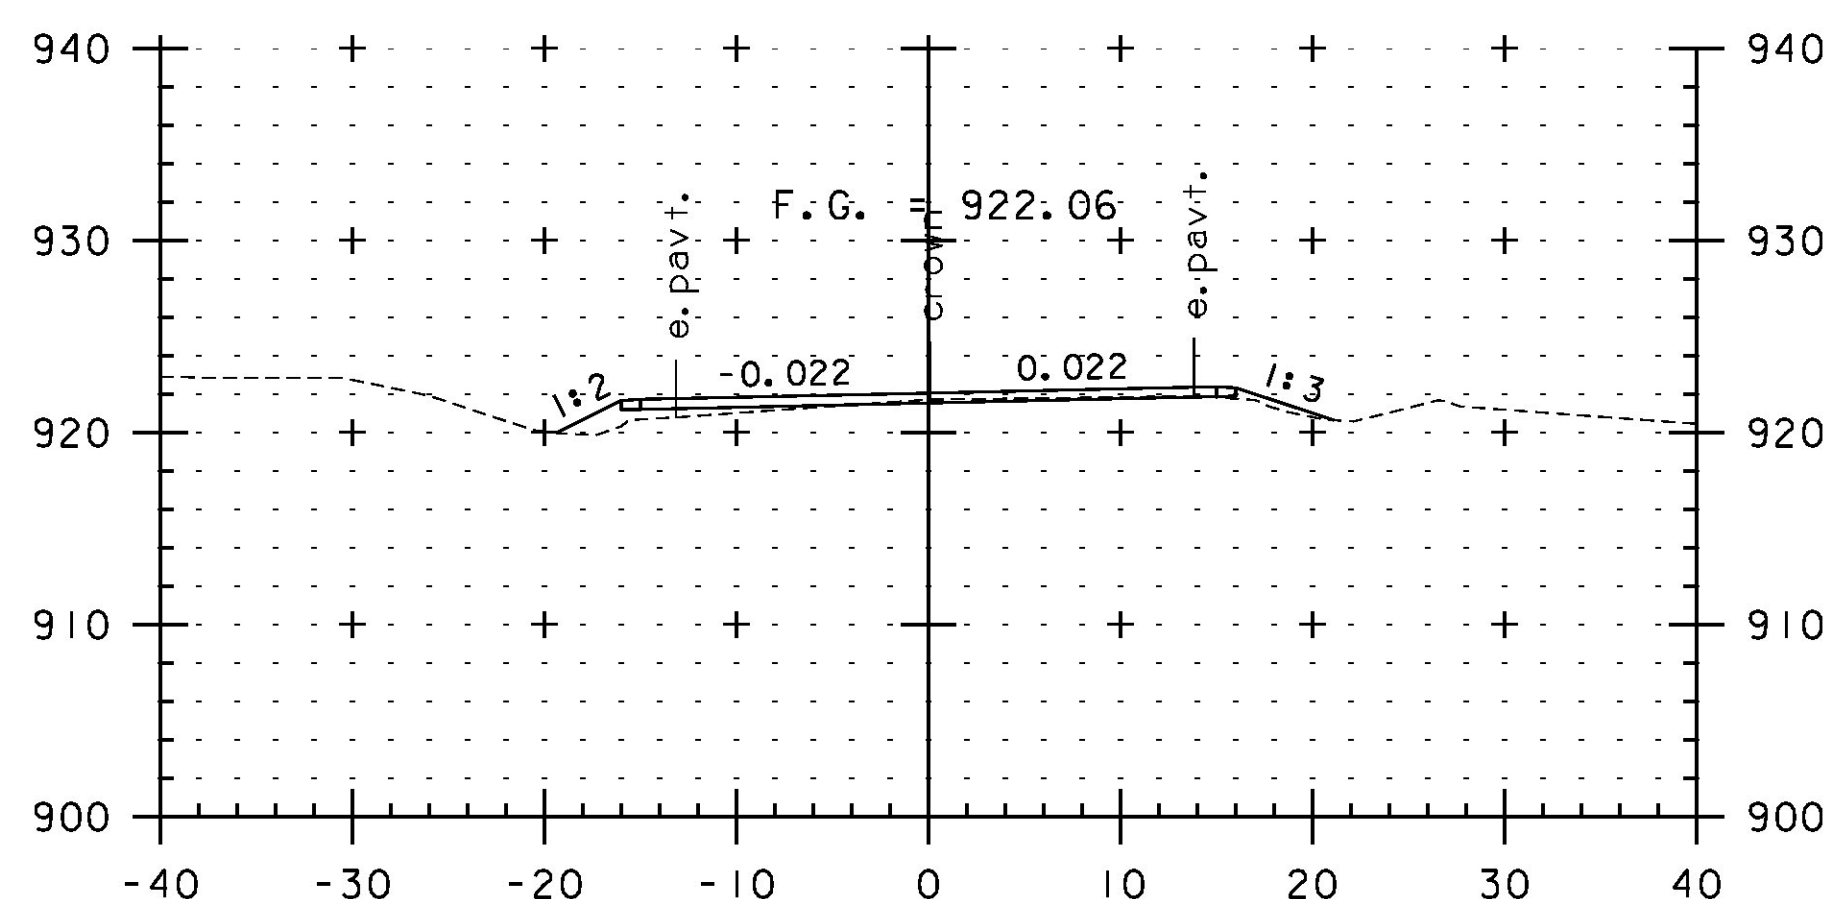

438+50

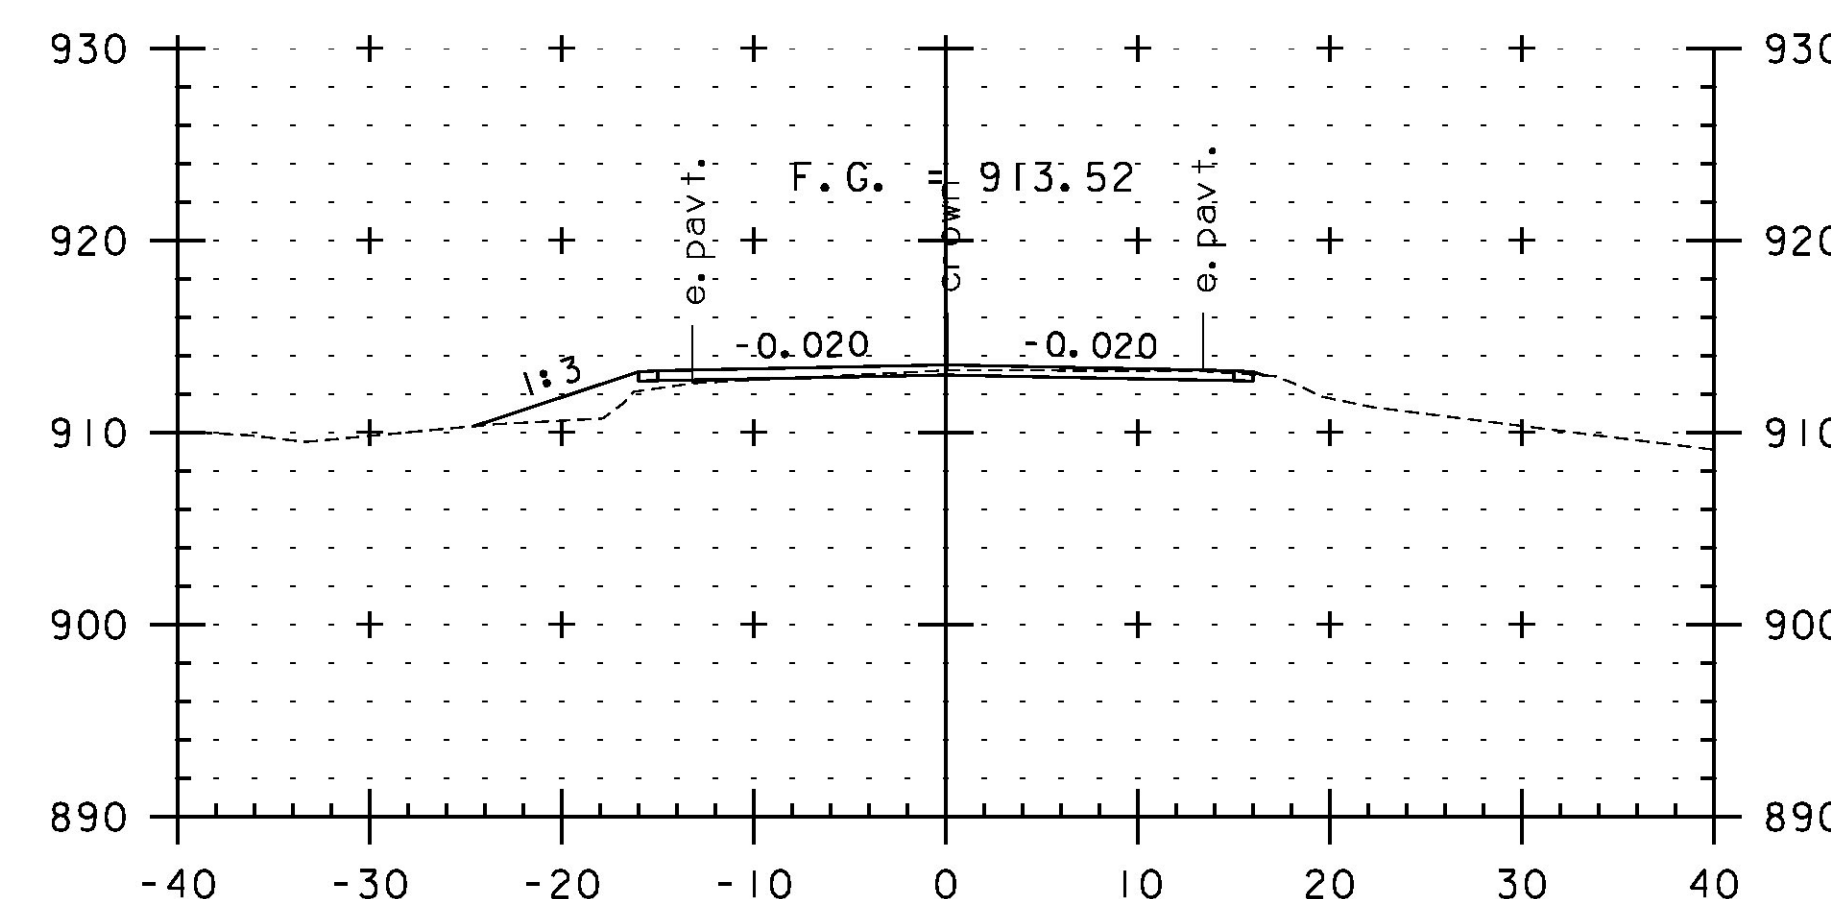

440+00



SCALE IN FEET

STA. 437+00 TO STA. 441+00

PROJECT NAME:	JAY-TROY	PLOT DATE:	5/16/2014
PROJECT NUMBER:	STP 2315(1)	DRAWN BY:	W. GORDON
FILE NAME:	z10b232xs.dgn	CHECKED BY:	P. SHEDD
PROJECT LEADER:	P. SHEDD	CROSS SECTION SHEET 101	SHEET 237 OF 244
DESIGNED BY:	N. LEMAY		