




442+00

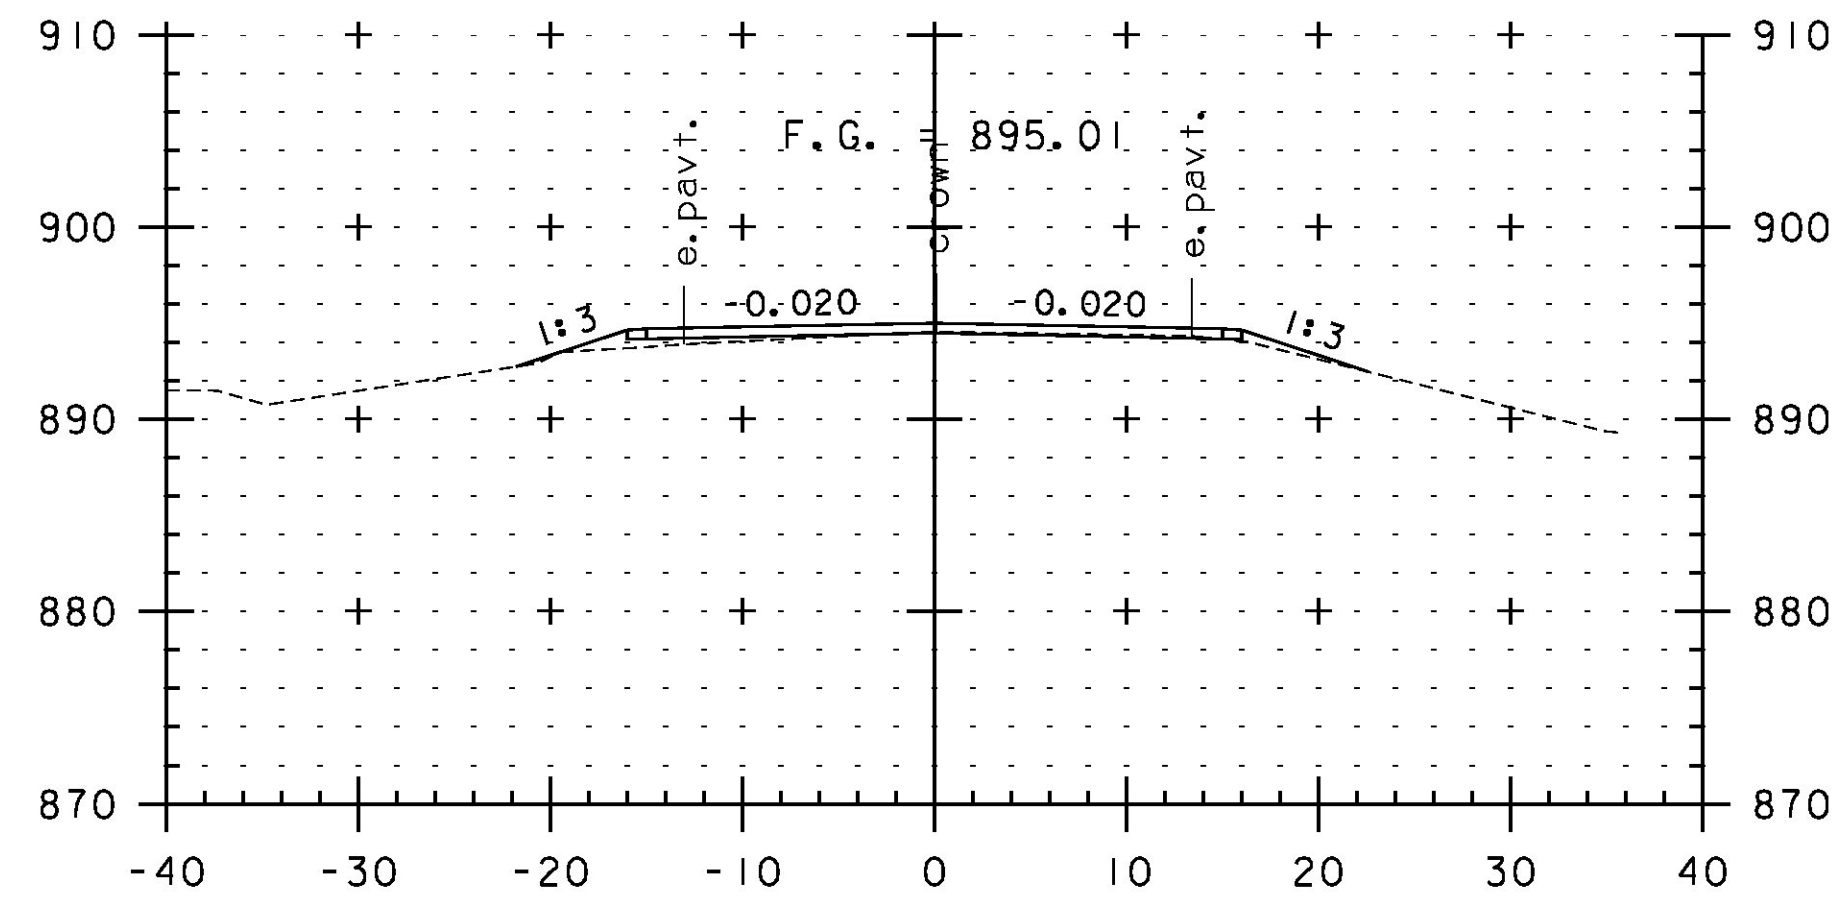


T1+00

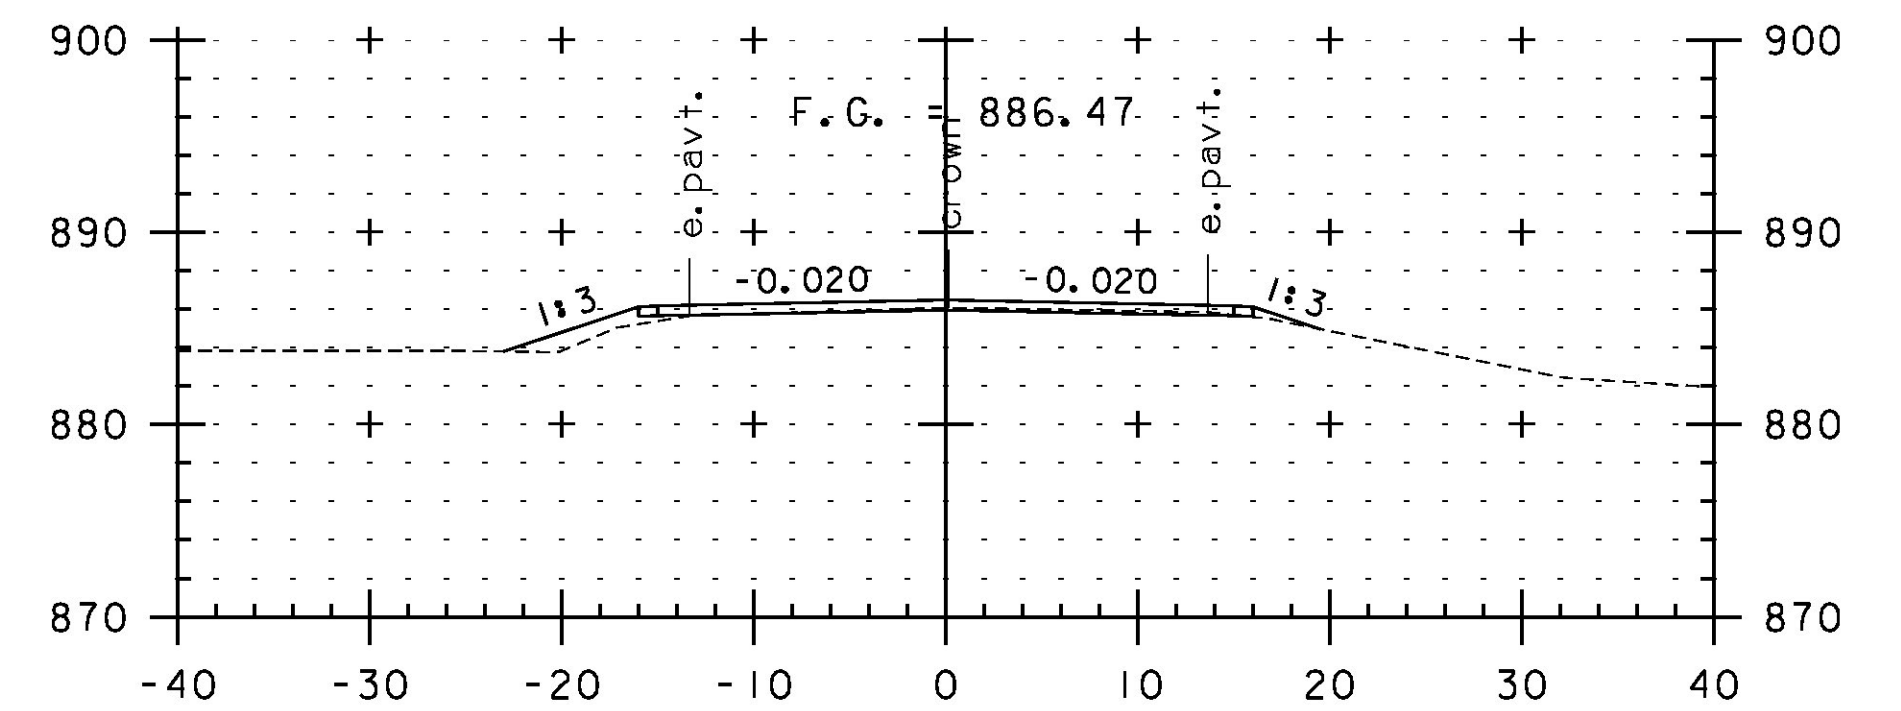


T2+50

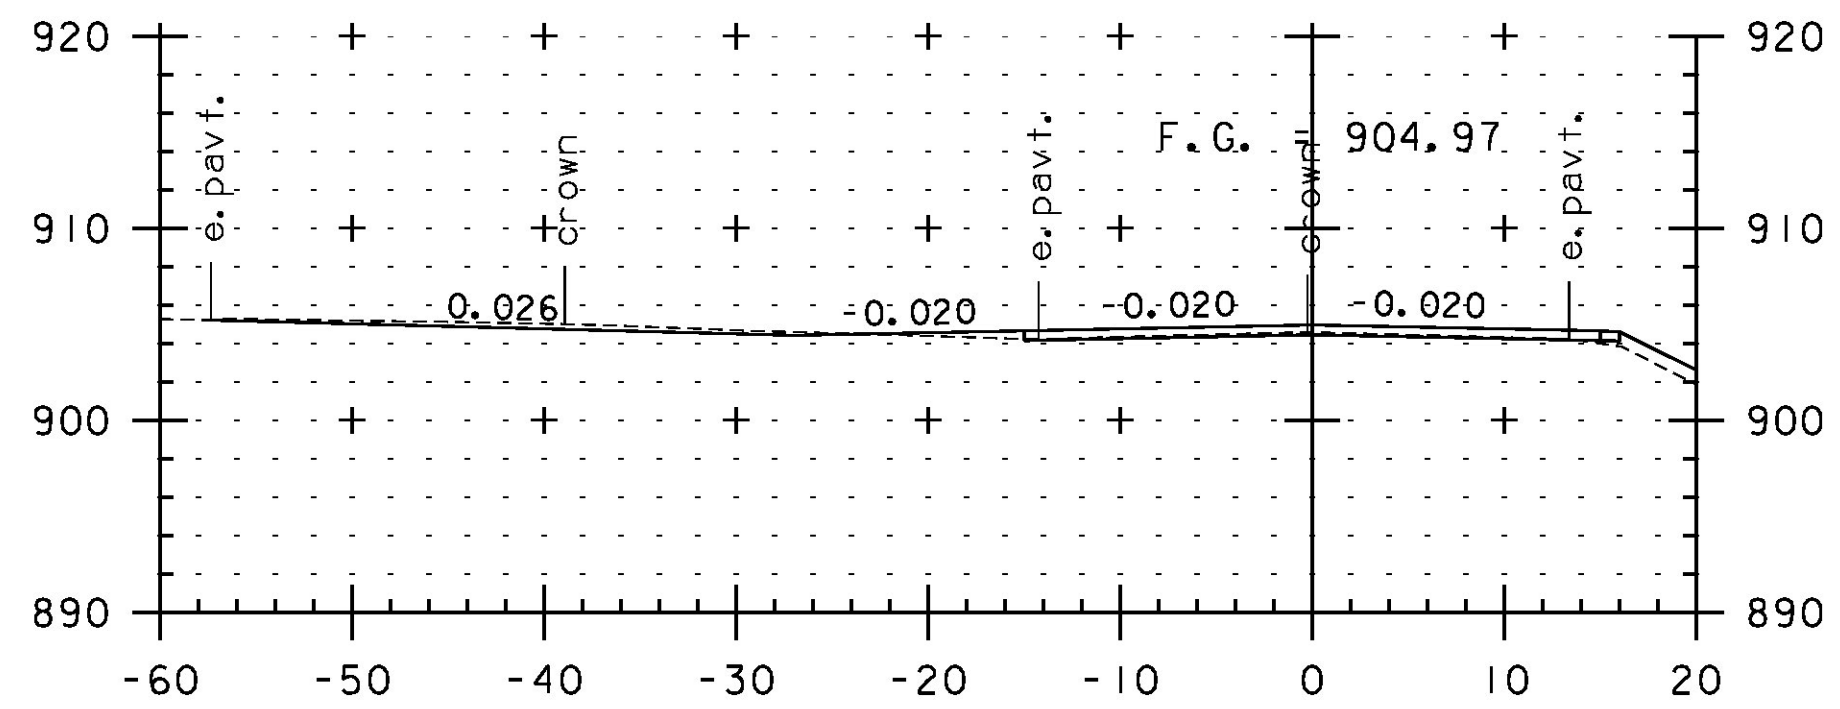


441+50
TH 30 LT

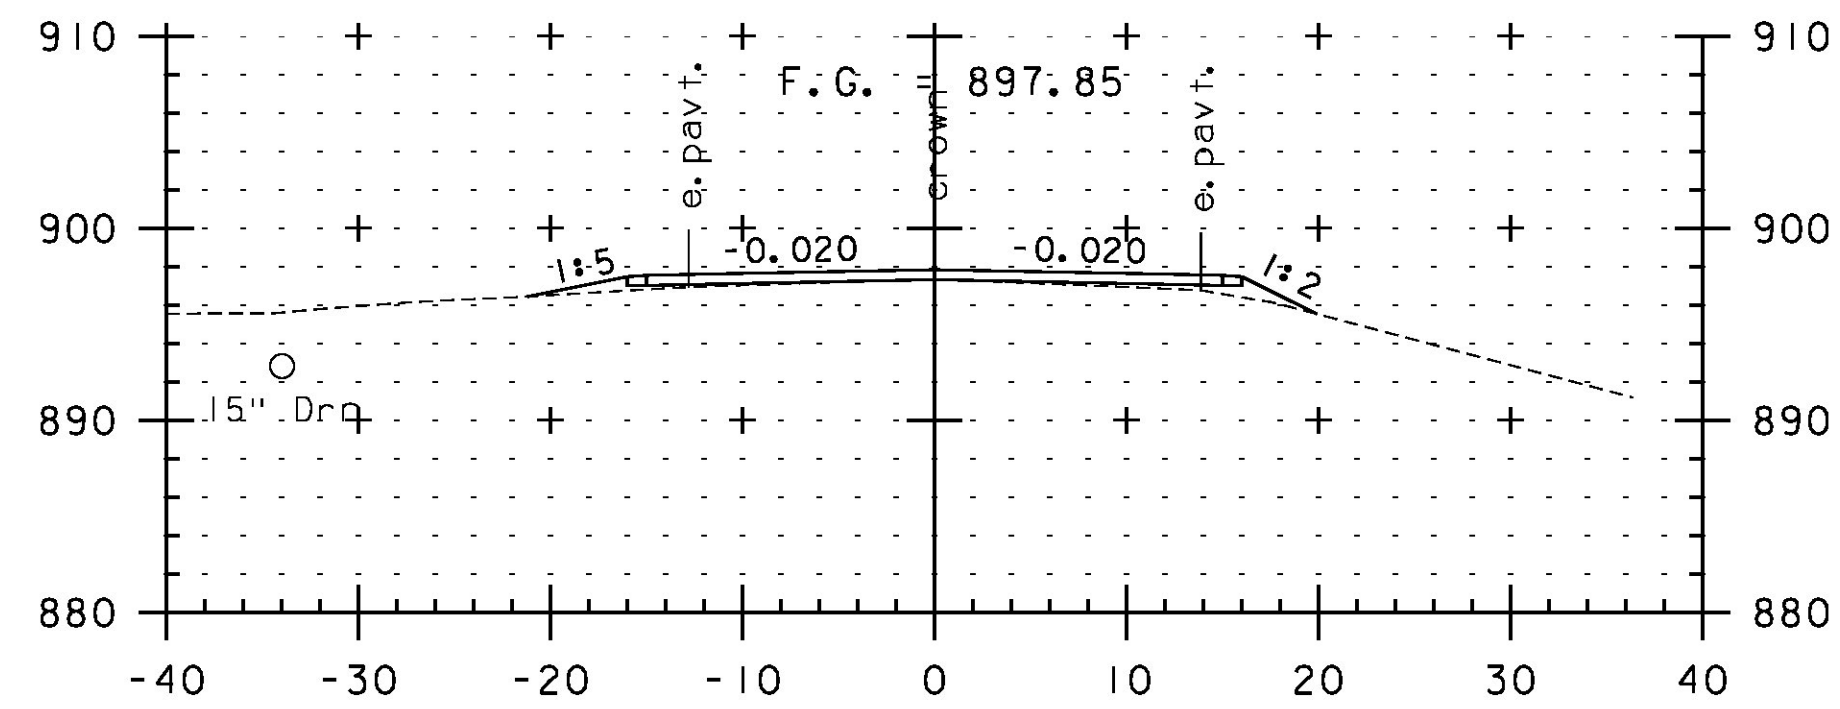


T0+50

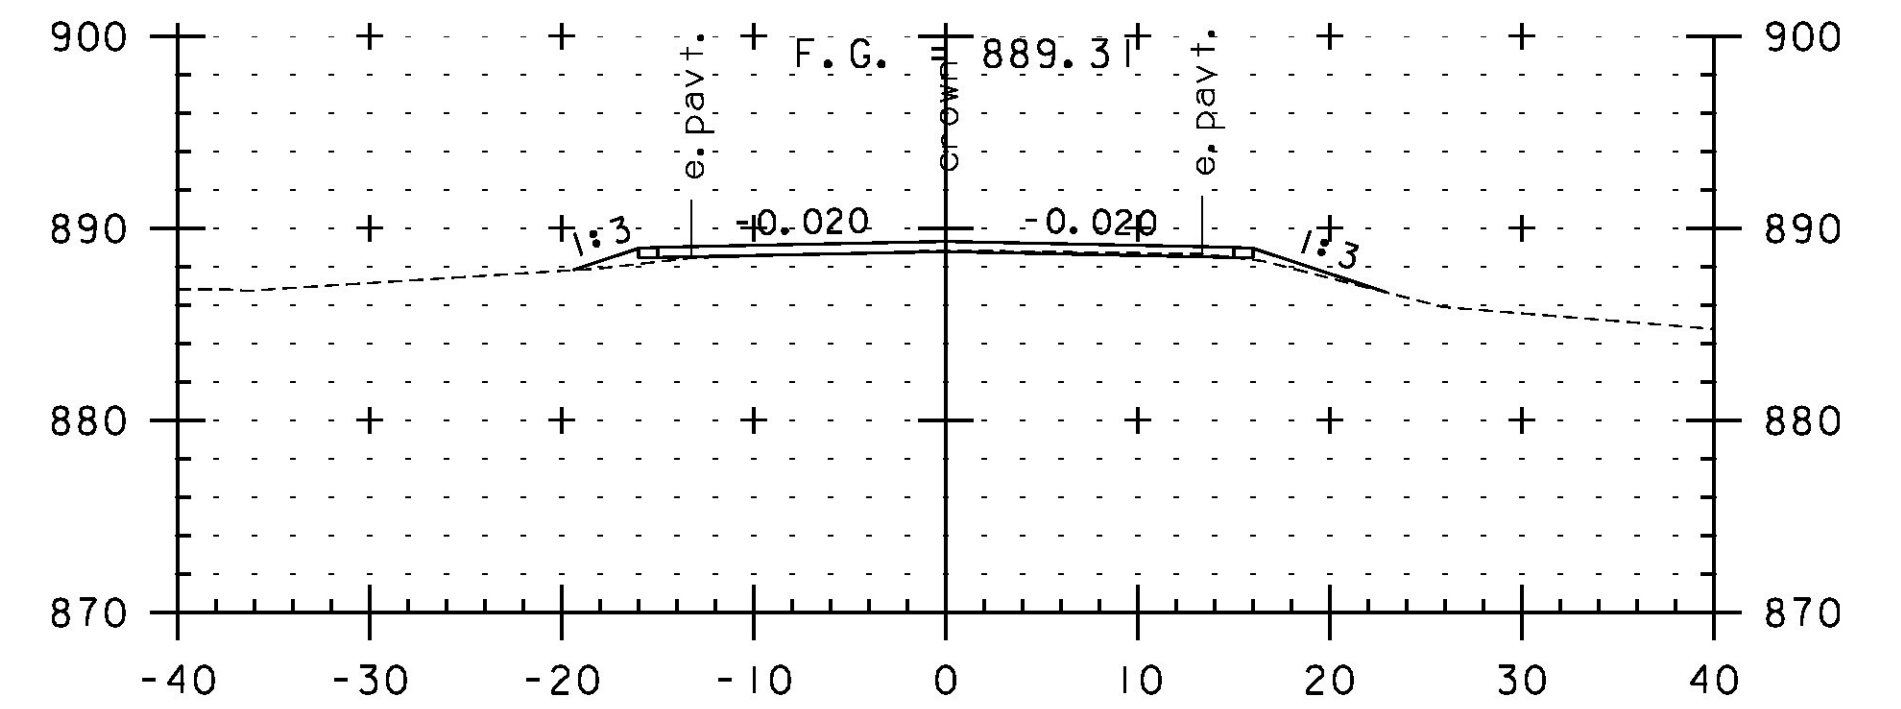


T2+00

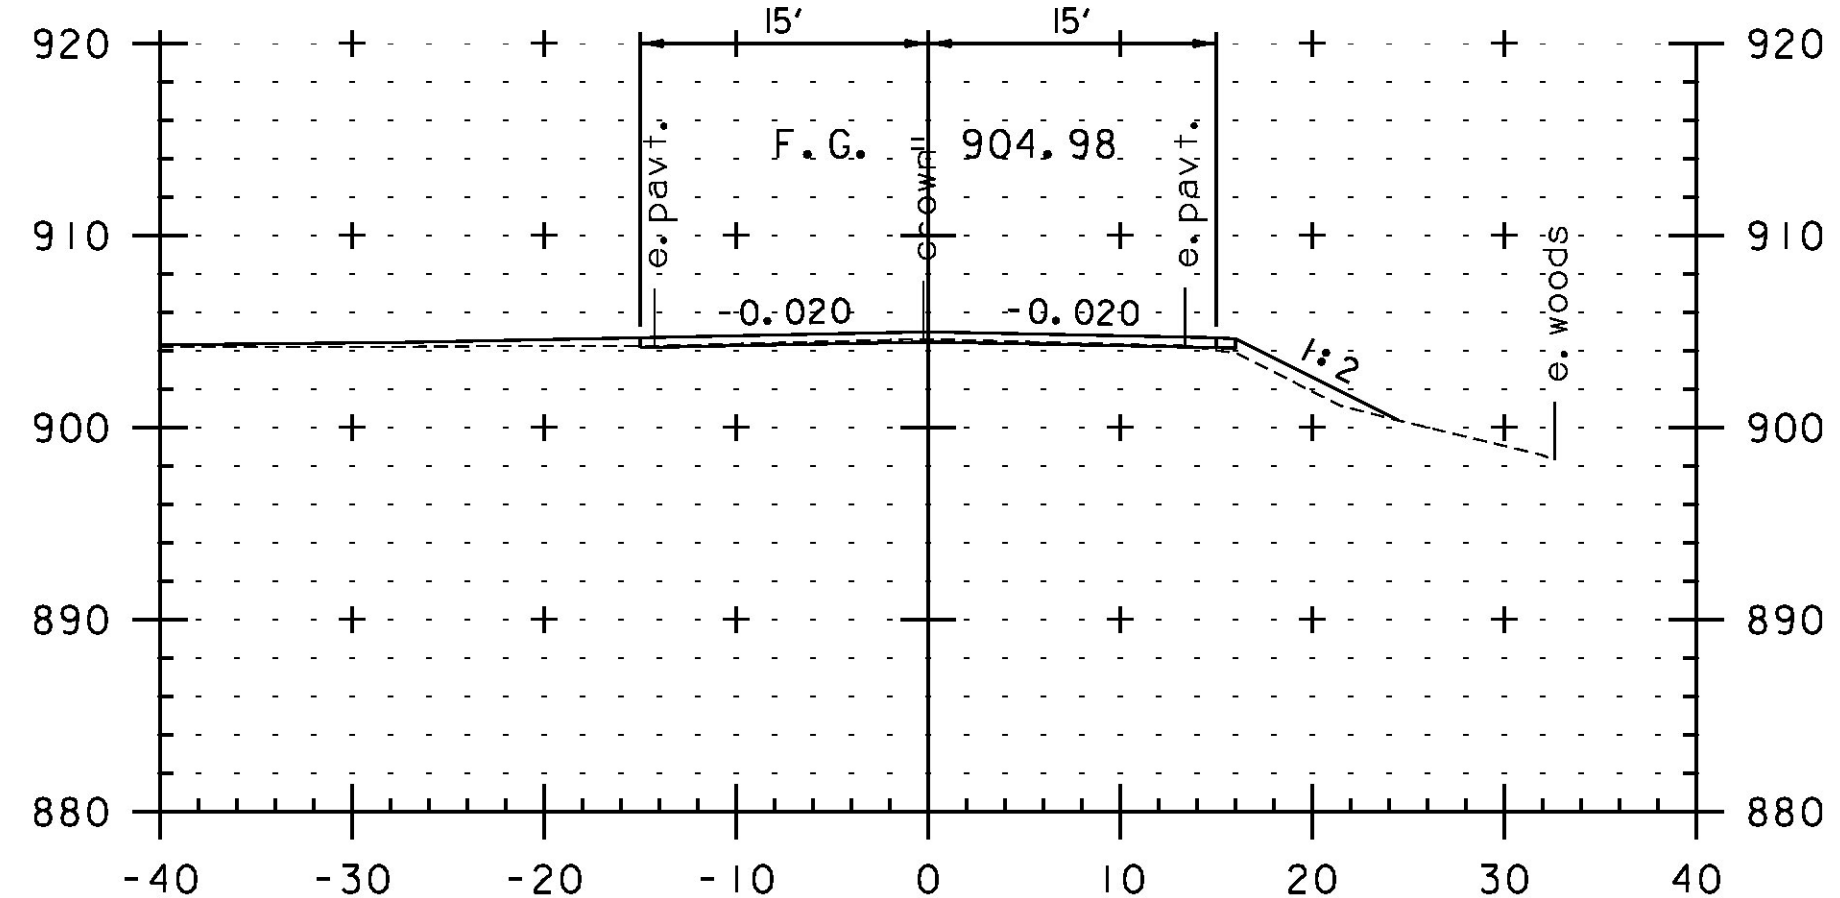

441+50

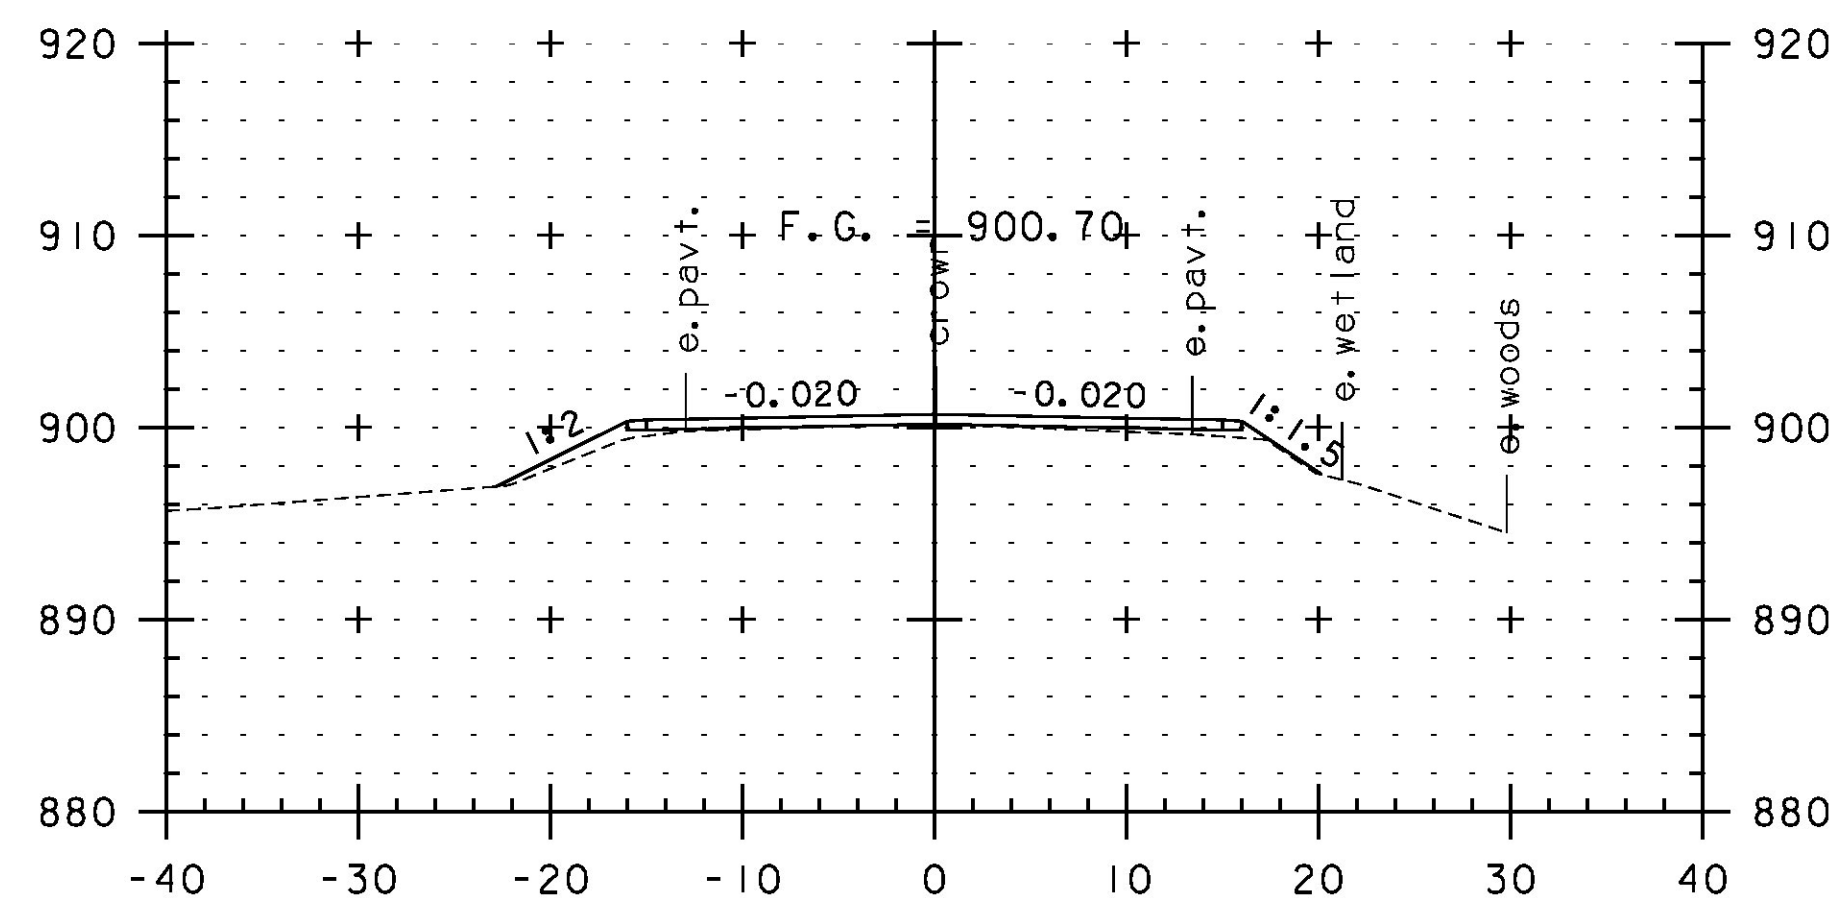

T0+00

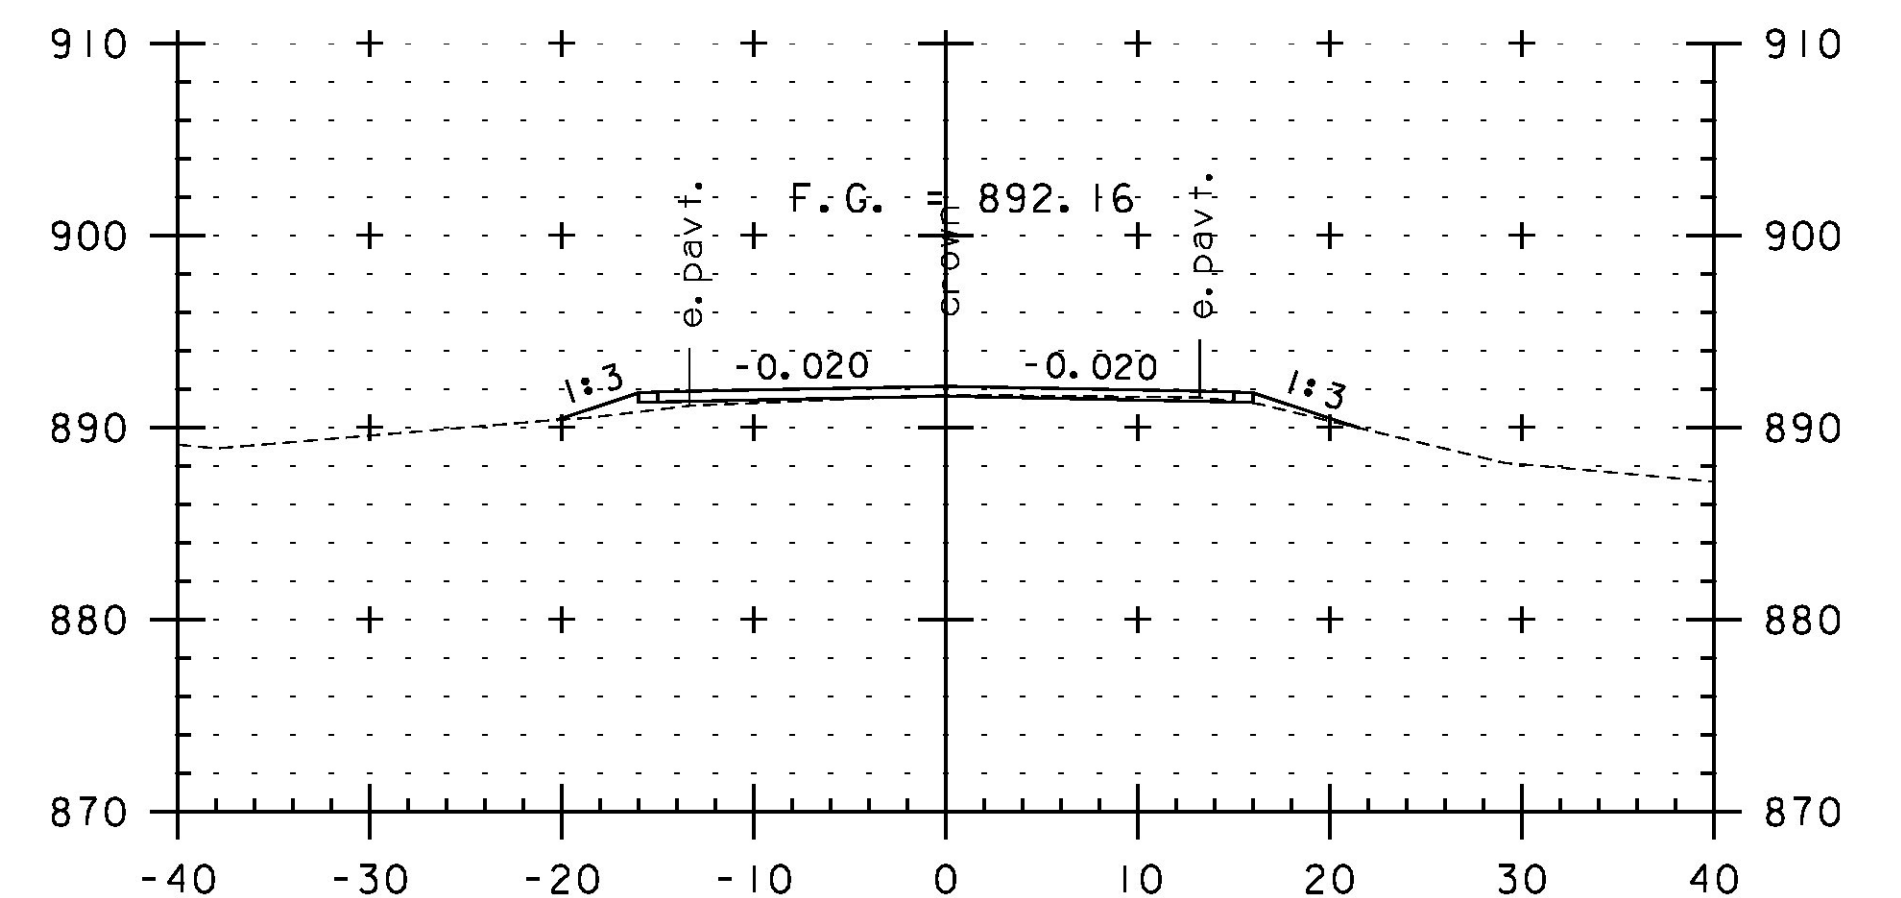

T1+50



STA. 441+50 TO STA. T2+50

PROJECT NAME: JAY-TROY
PROJECT NUMBER: STP 2315(I)

FILE NAME: z10b232xs.dgn
PROJECT LEADER: P. SHEDD
DESIGNED BY: N. LEMAY
CROSS SECTION SHEET 102

PLOT DATE: 5/16/2014
DRAWN BY: W. GORDON
CHECKED BY: P. SHEDD
SHEET 238 OF 244