




T8+50

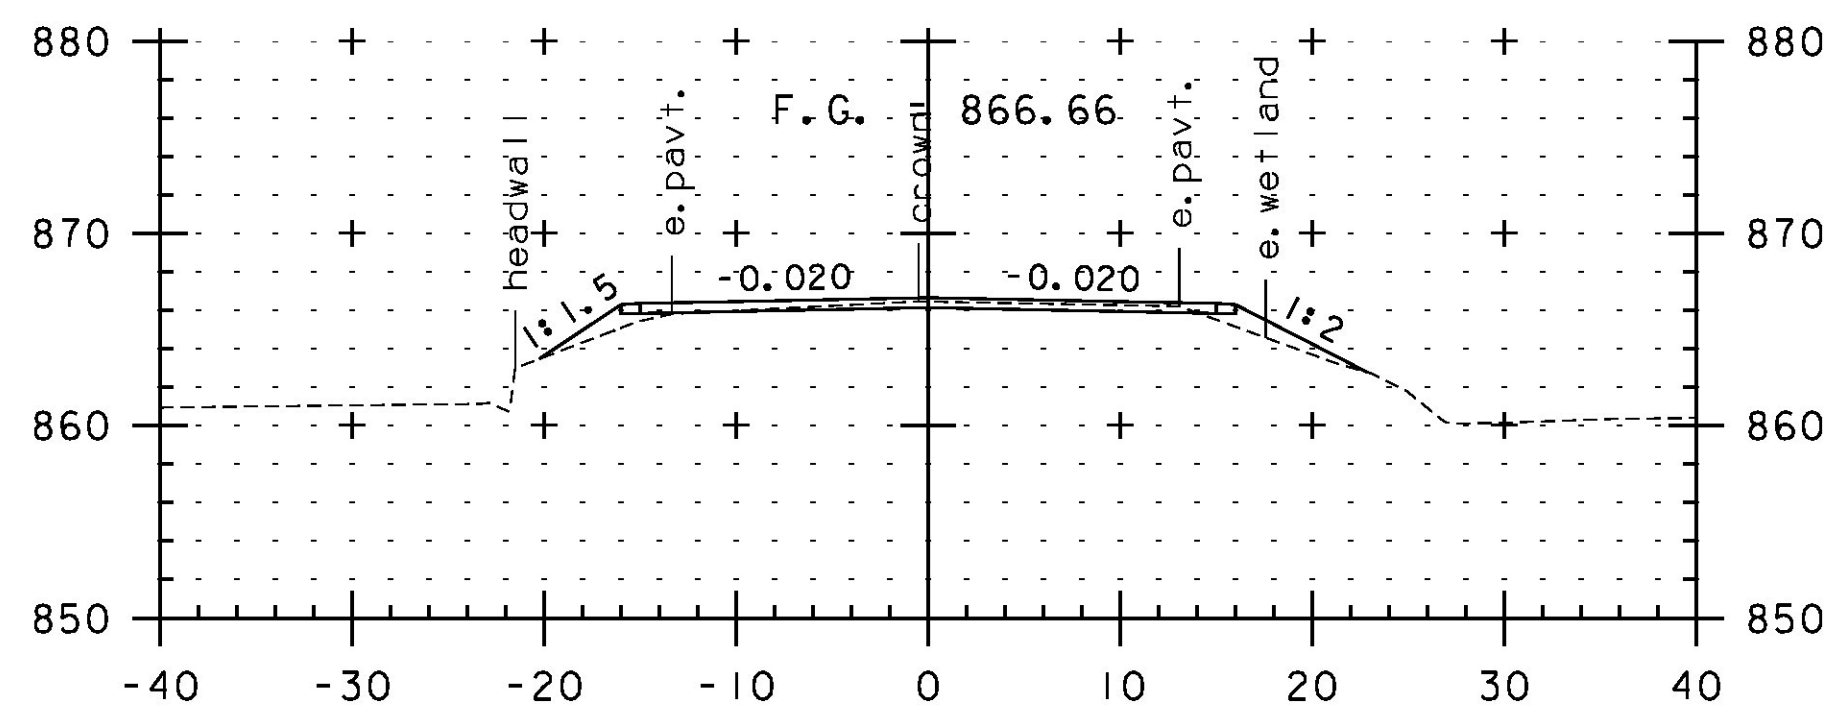


T8+00

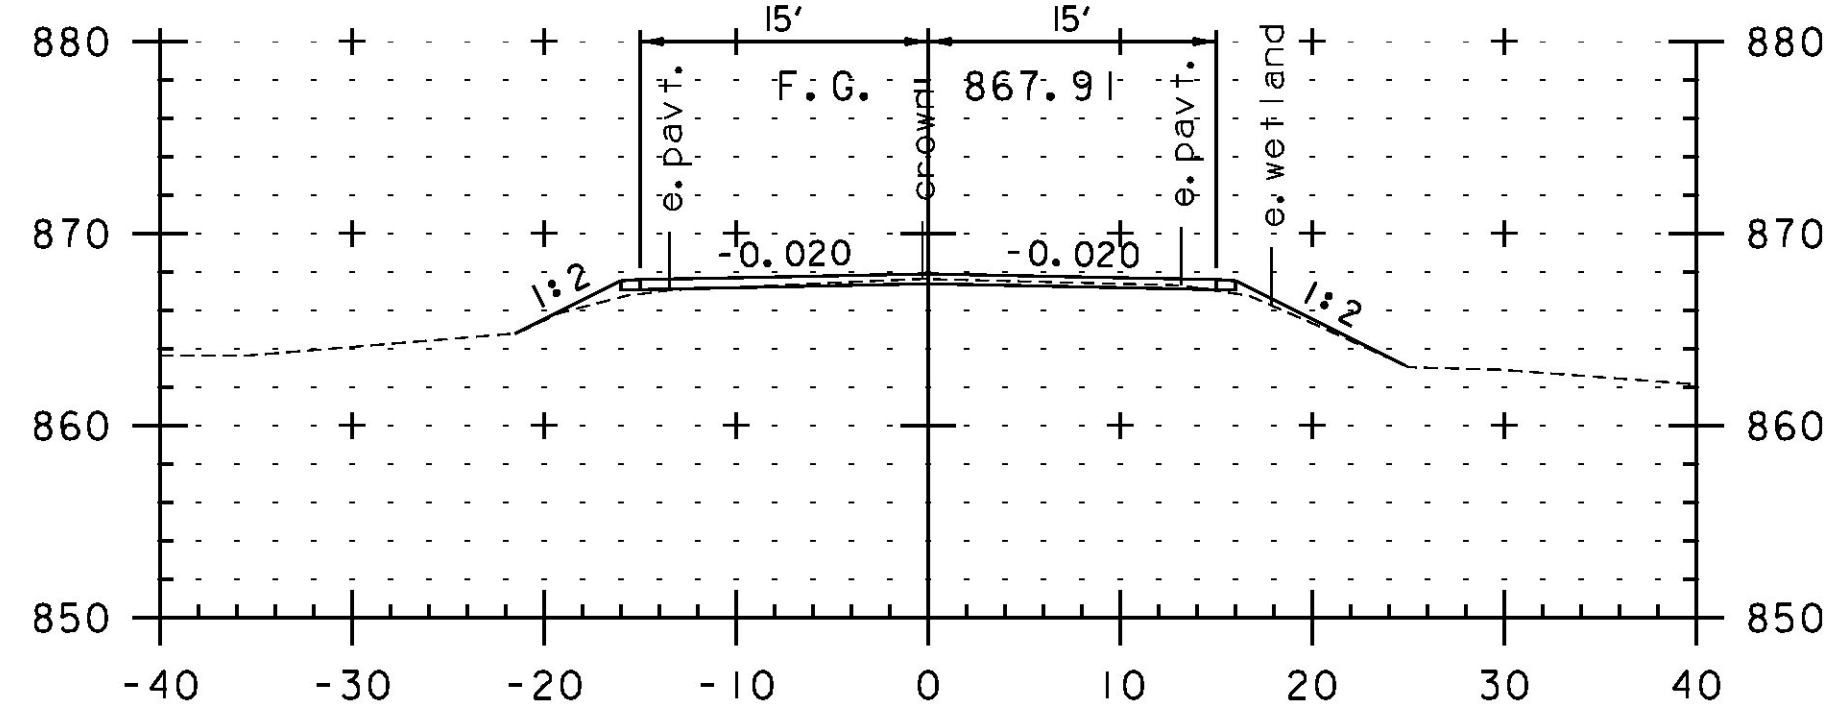


T7+50

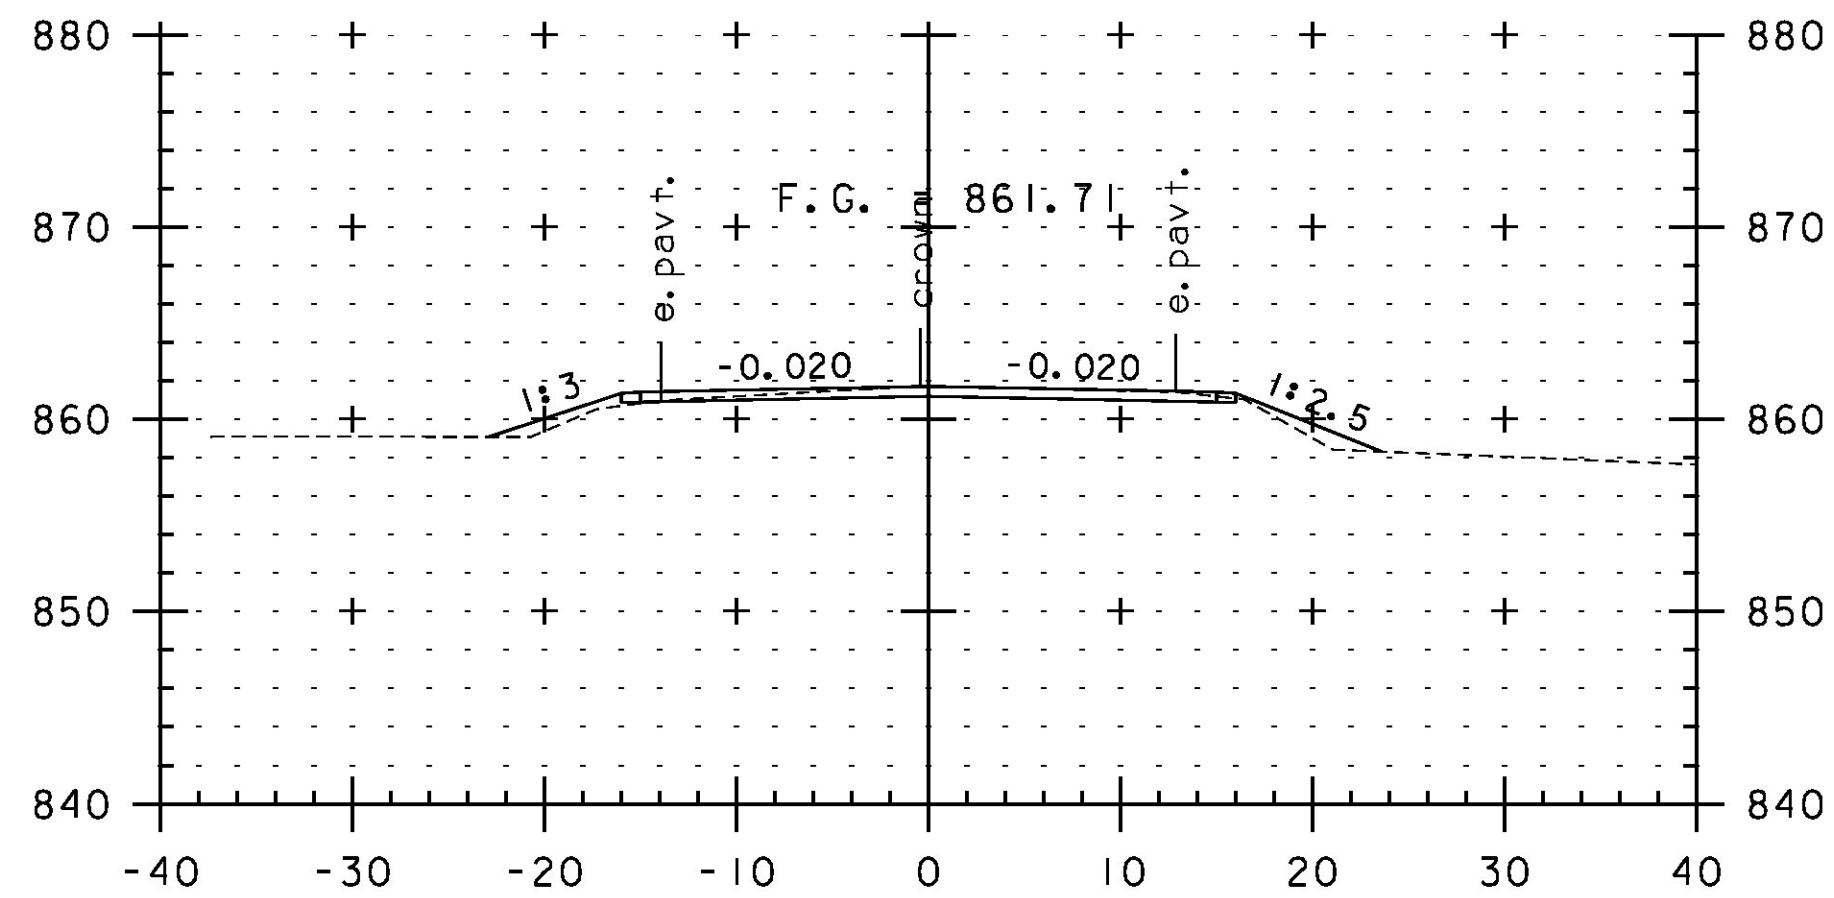


T10+00

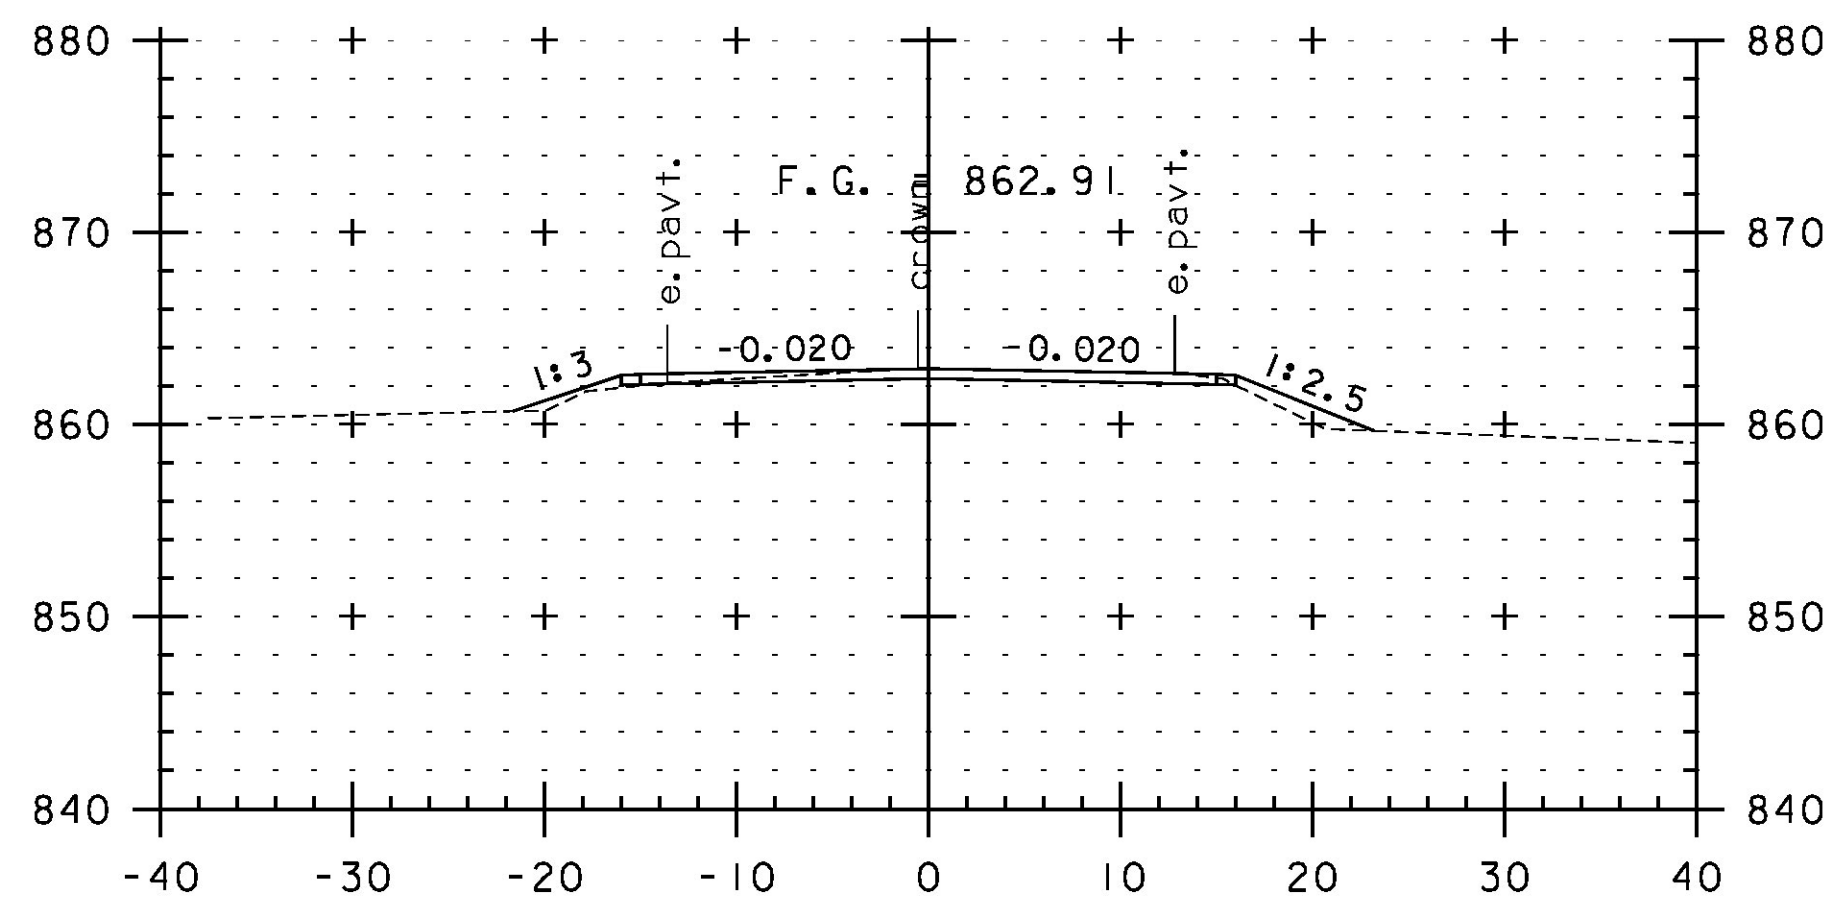


T9+50

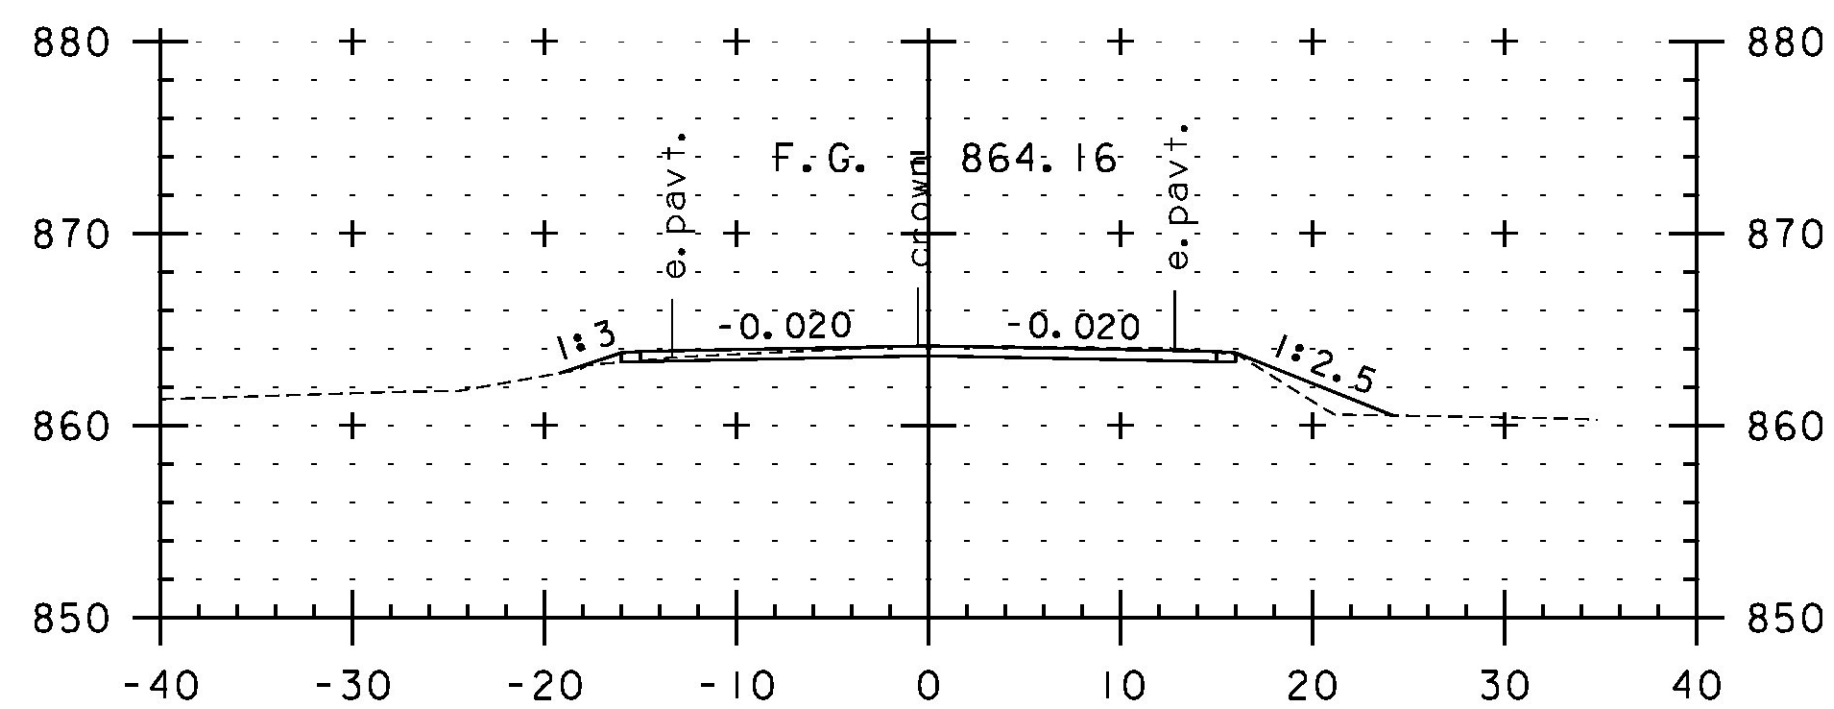


T9+00

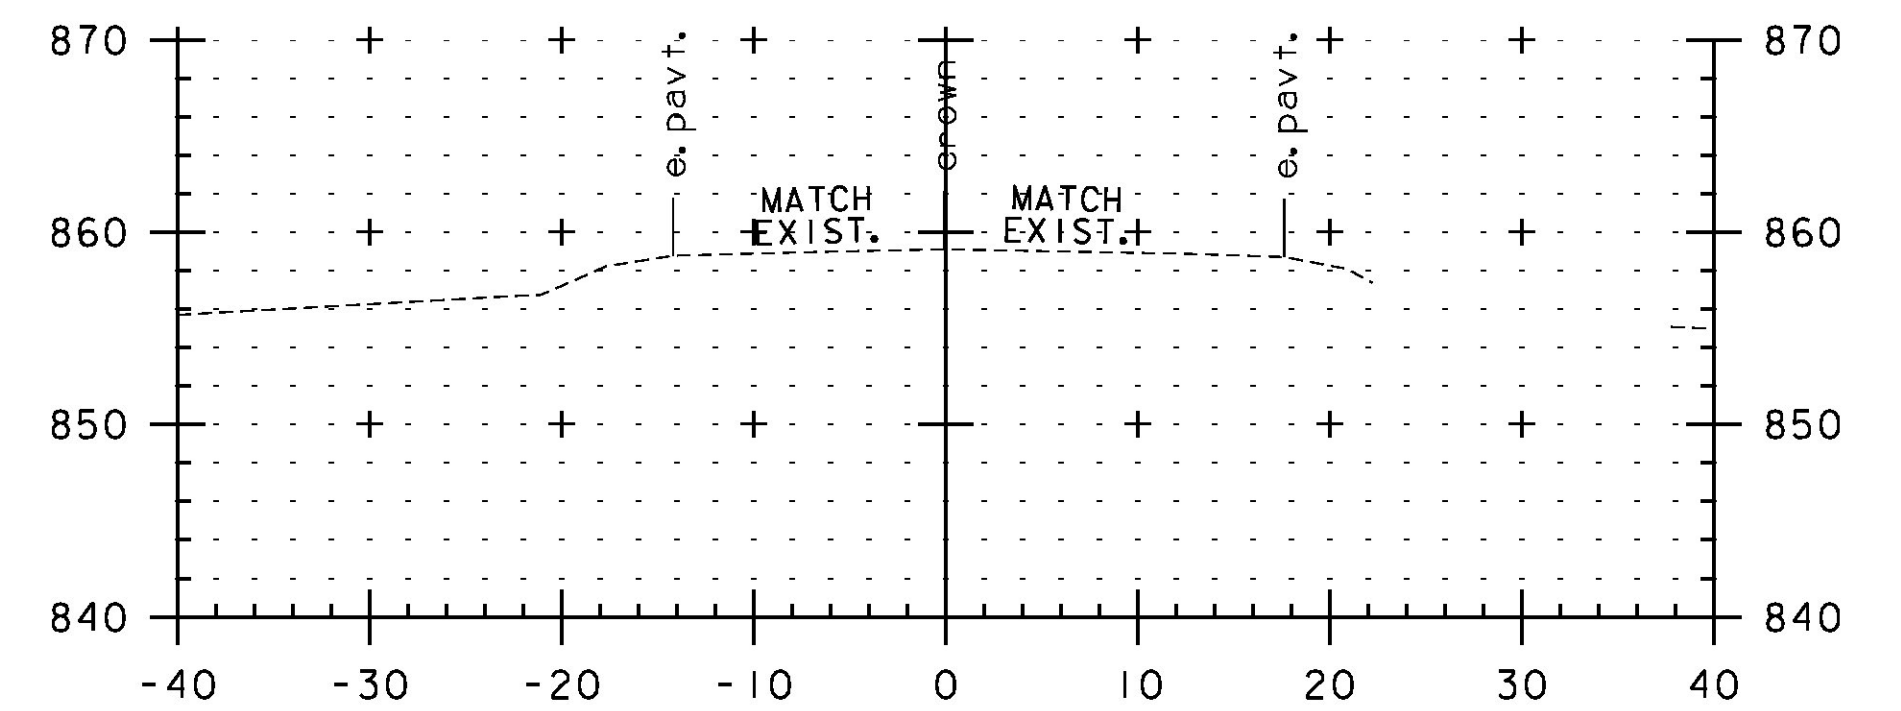

T11+10  
END PROJECT

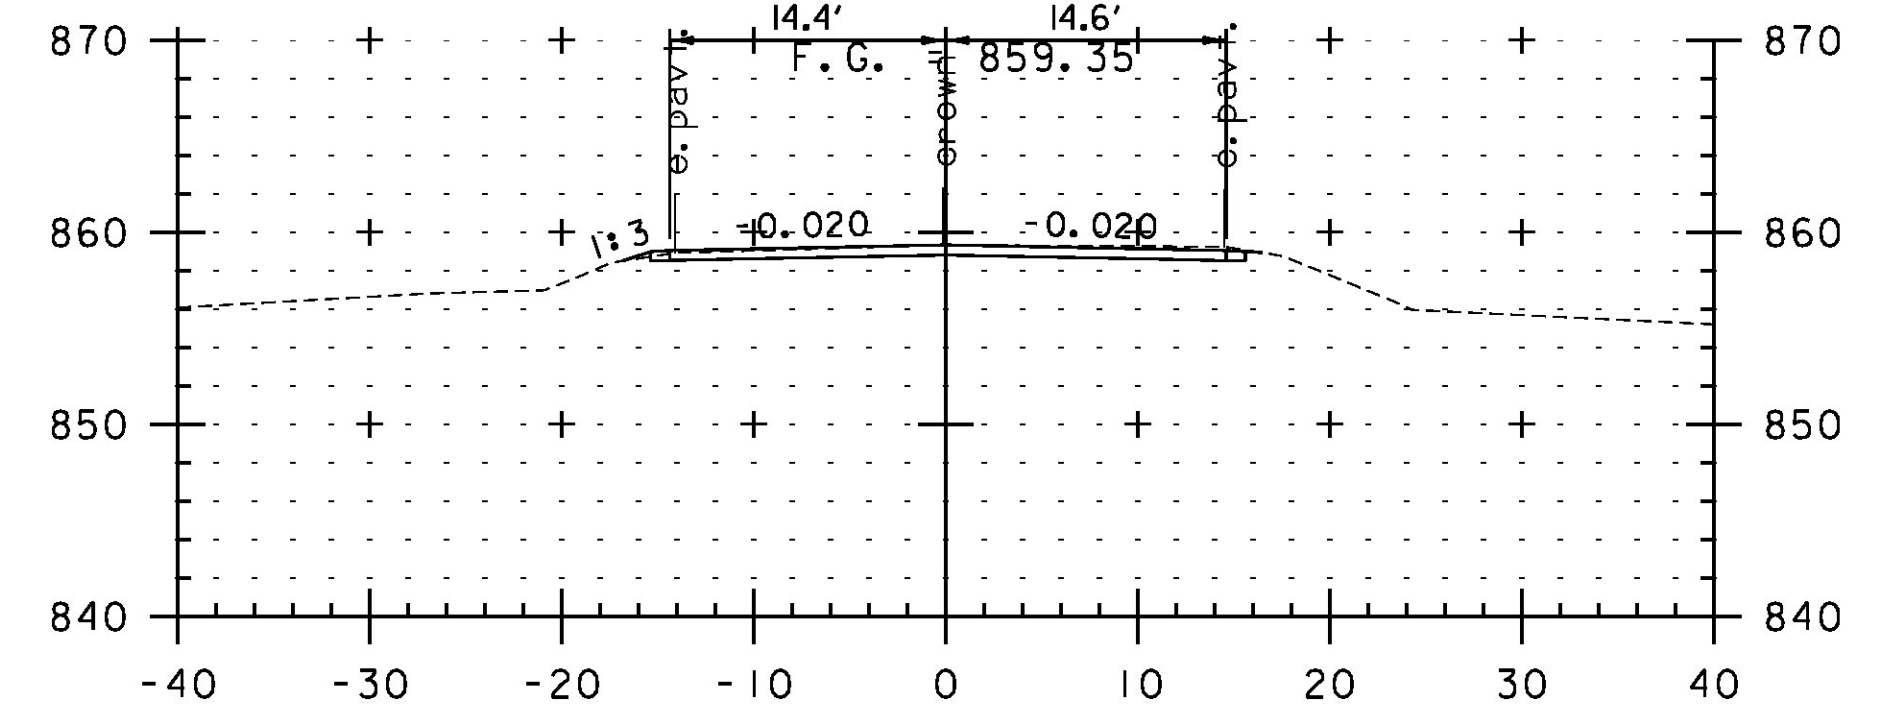

T11+00

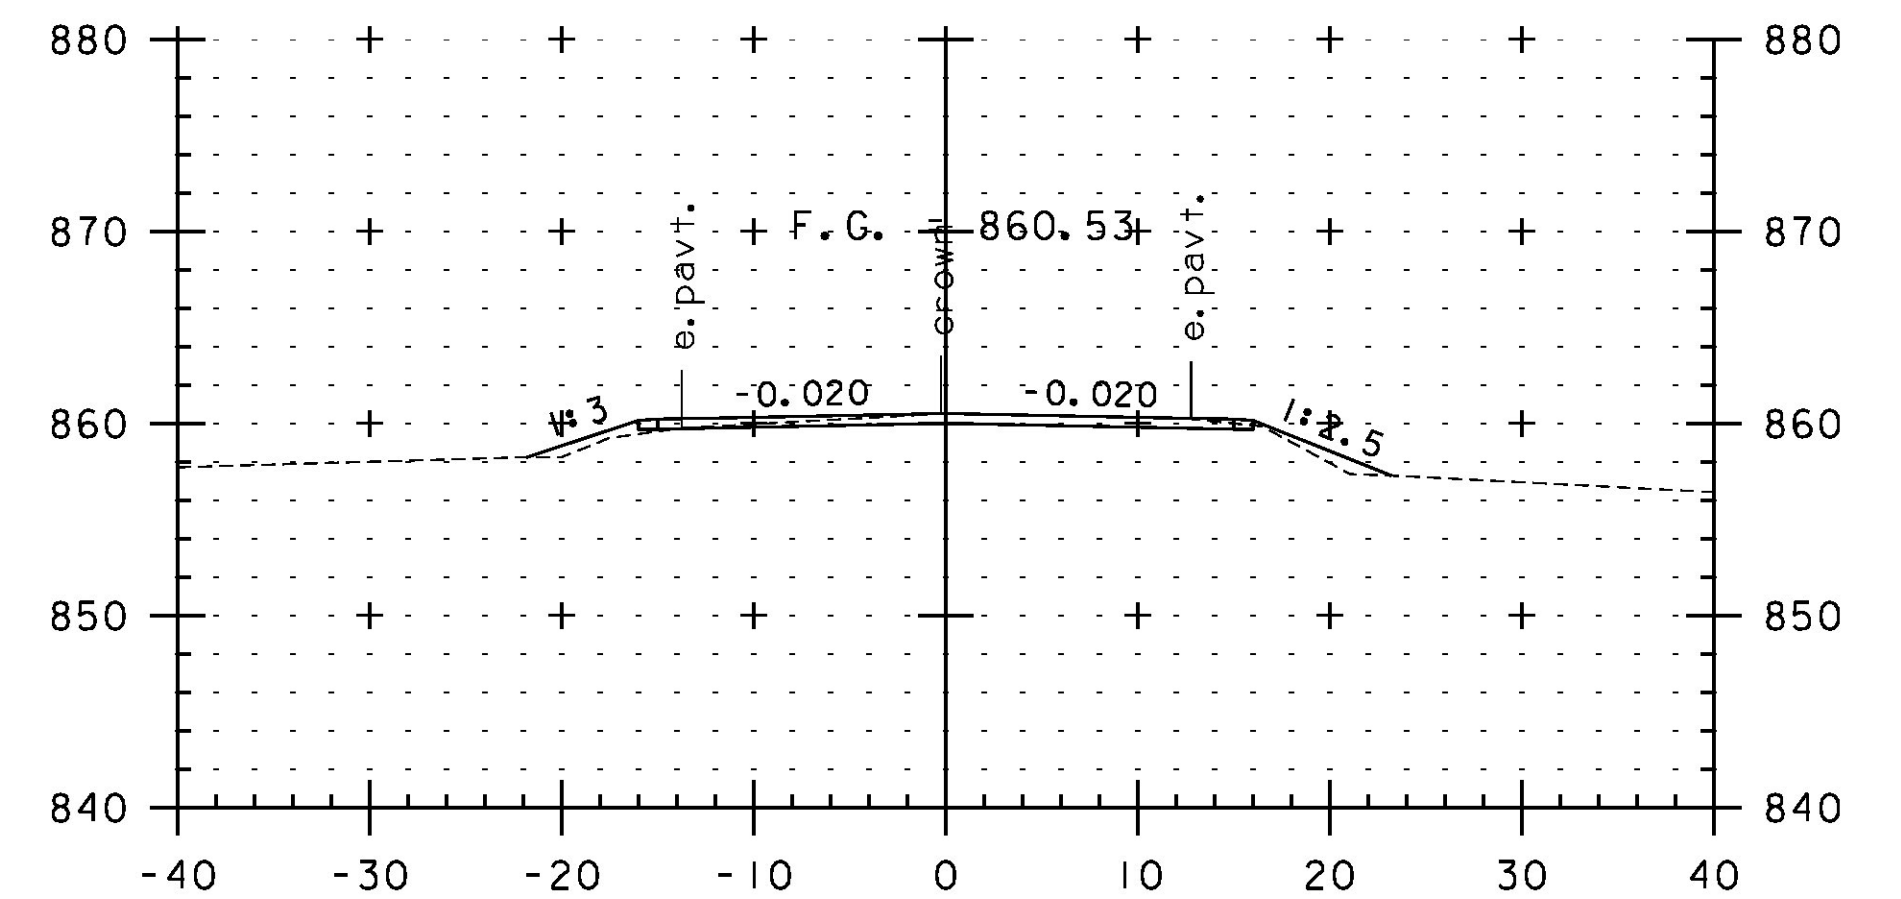

T10+50



SCALE IN FEET

STA. T7+50 TO STA. T11+10

PROJECT NAME: JAY-TROY  
PROJECT NUMBER: STP 2315(I)

FILE NAME: z10b232xs.dgn  
PROJECT LEADER: P. SHEDD  
DESIGNED BY: N. LEMAY  
CROSS SECTION SHEET 104

PLOT DATE: 5/16/2014  
DRAWN BY: W. GORDON  
CHECKED BY: P. SHEDD  
SHEET 240 OF 244