
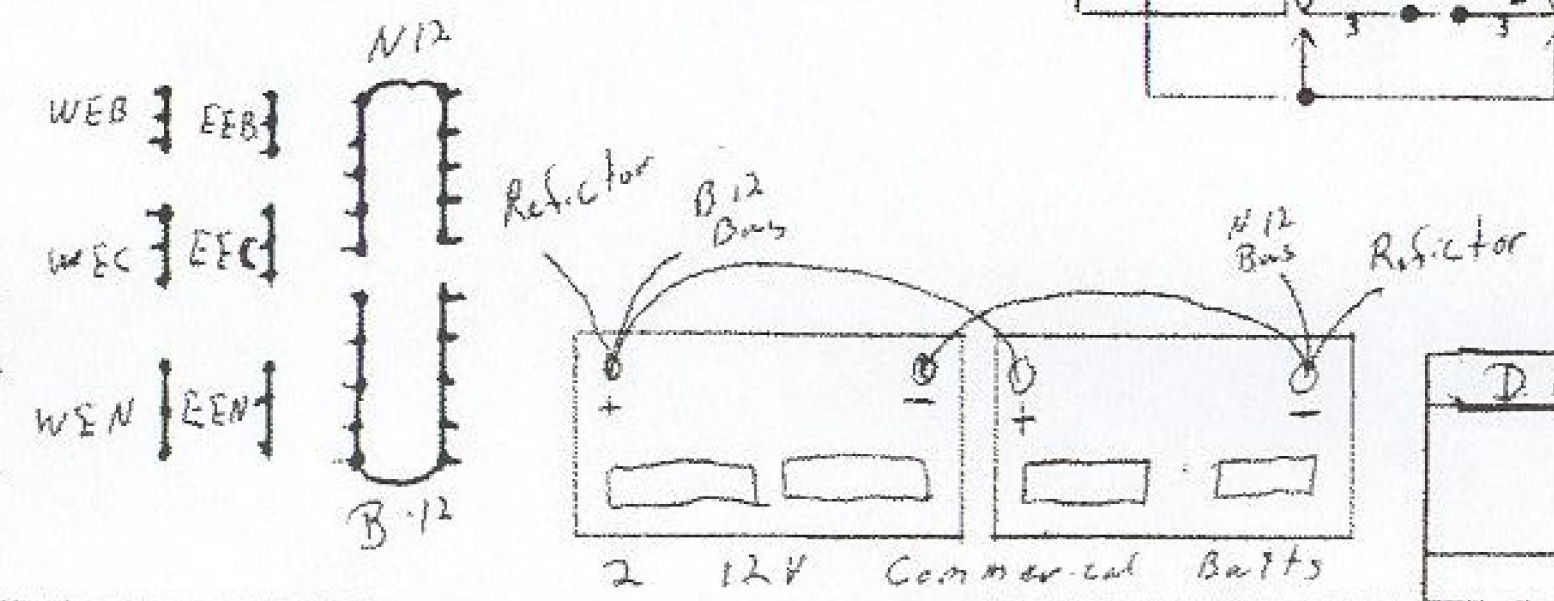
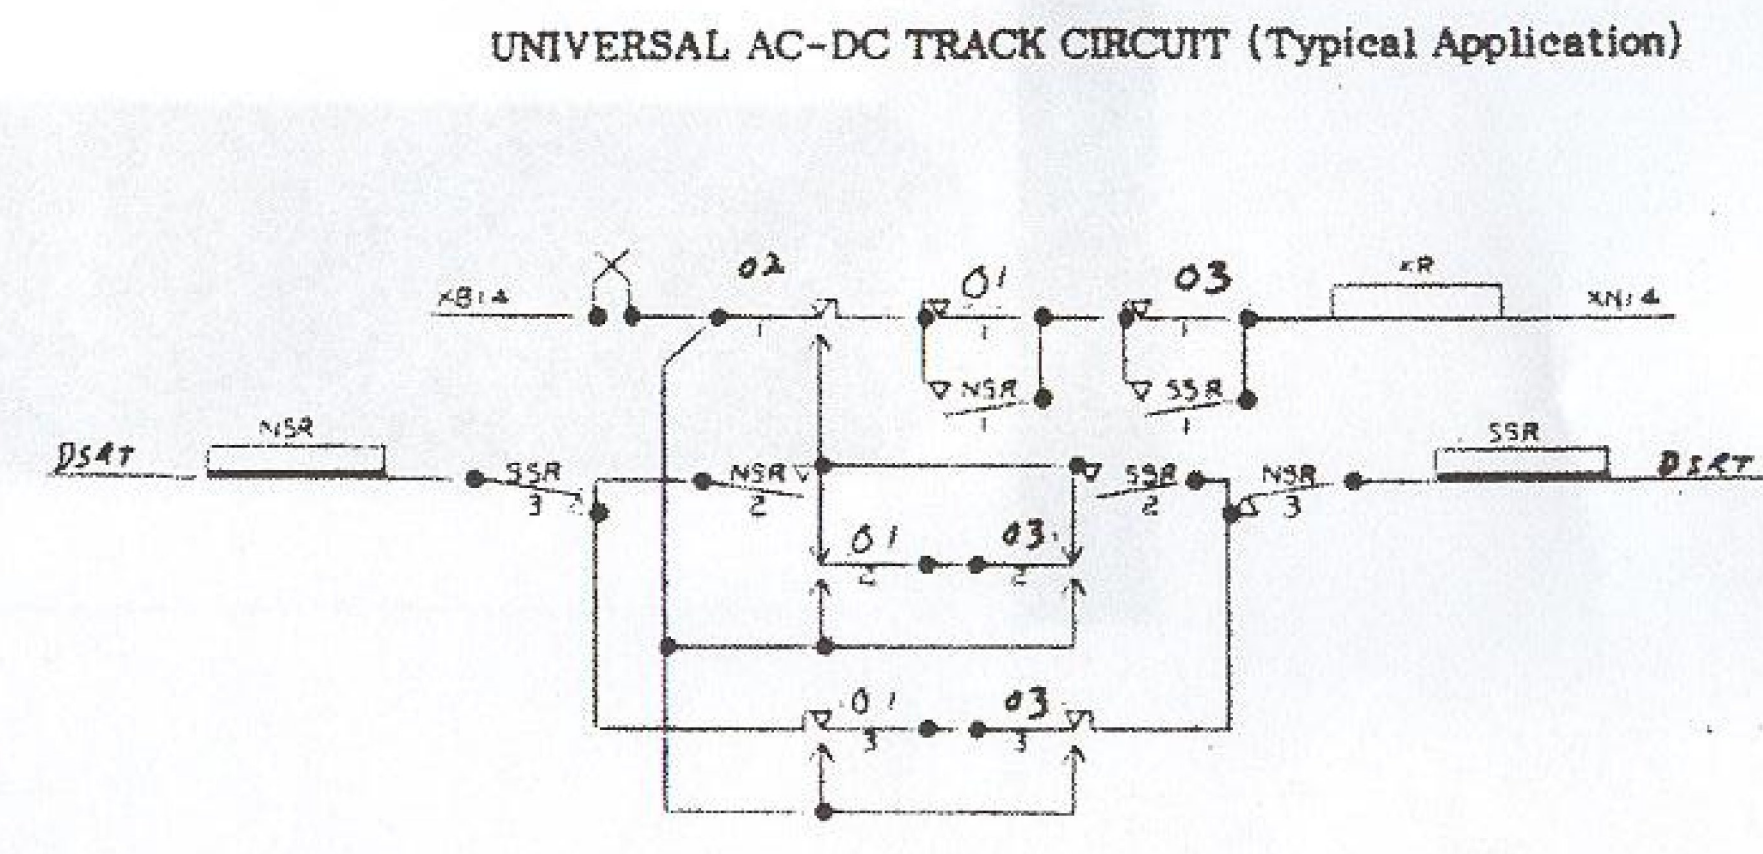
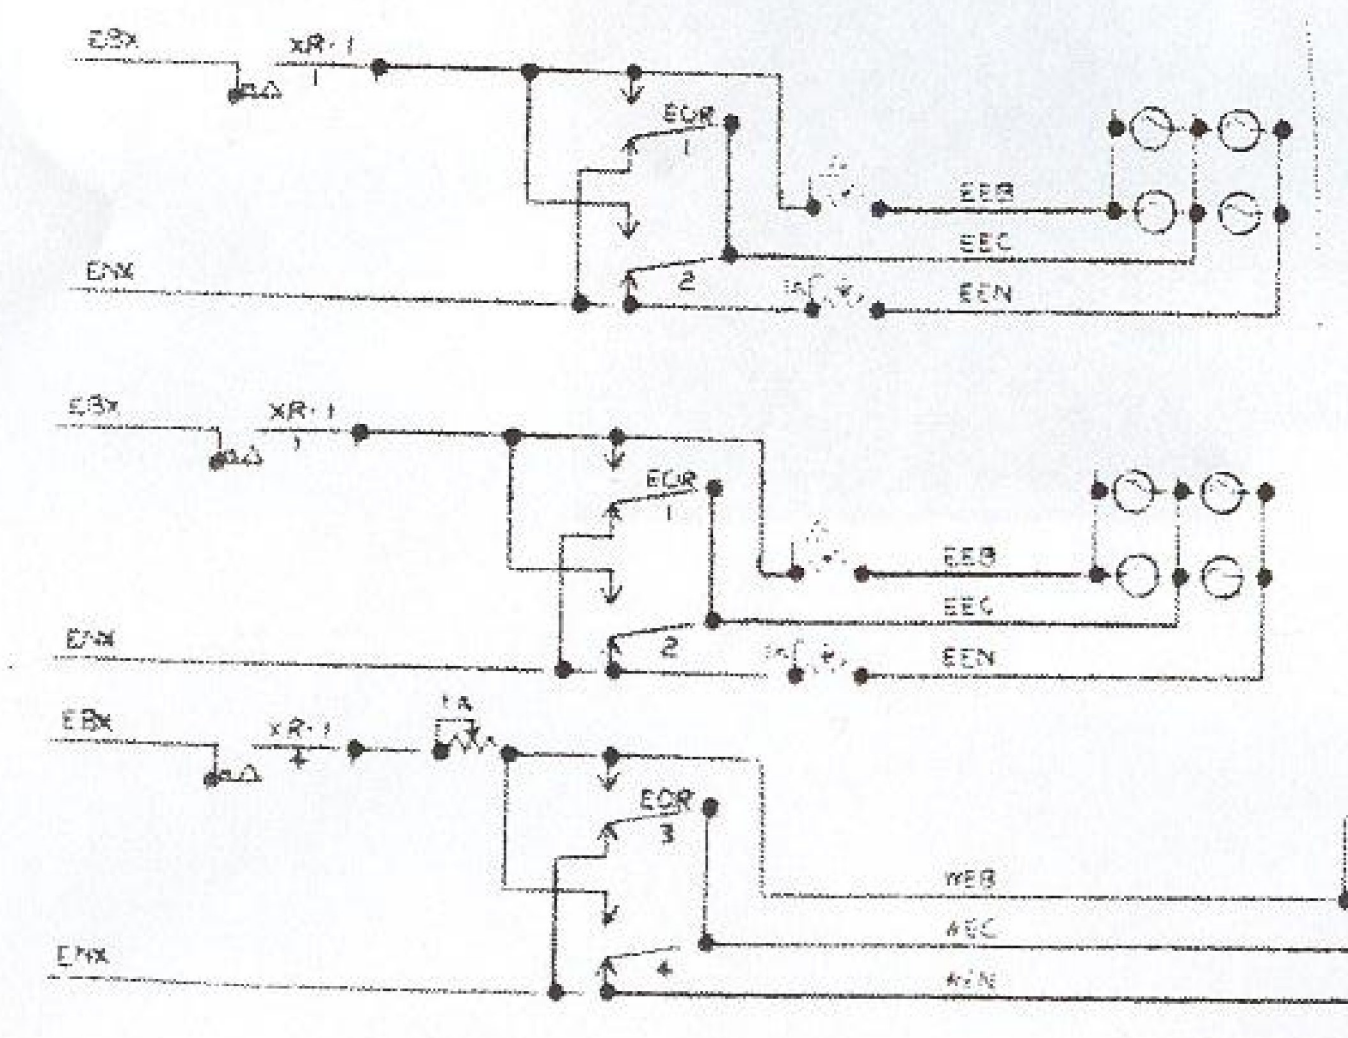
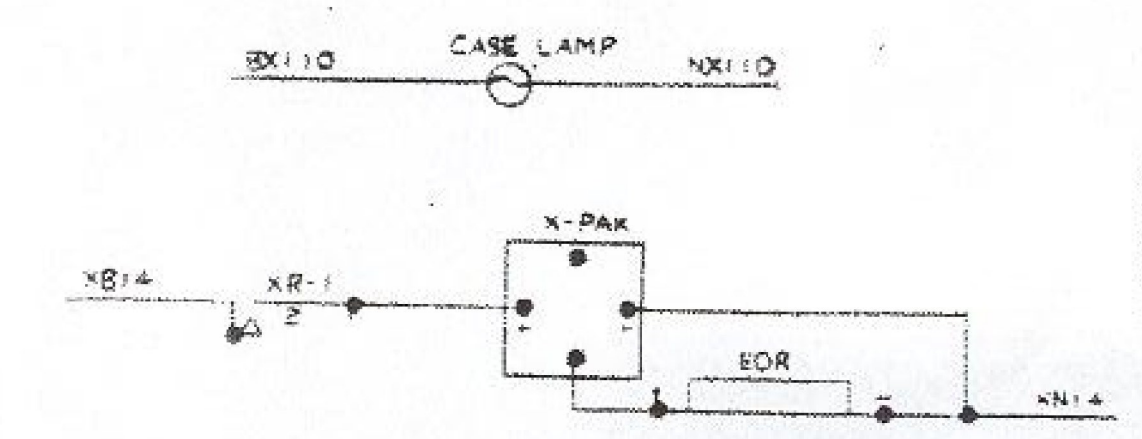
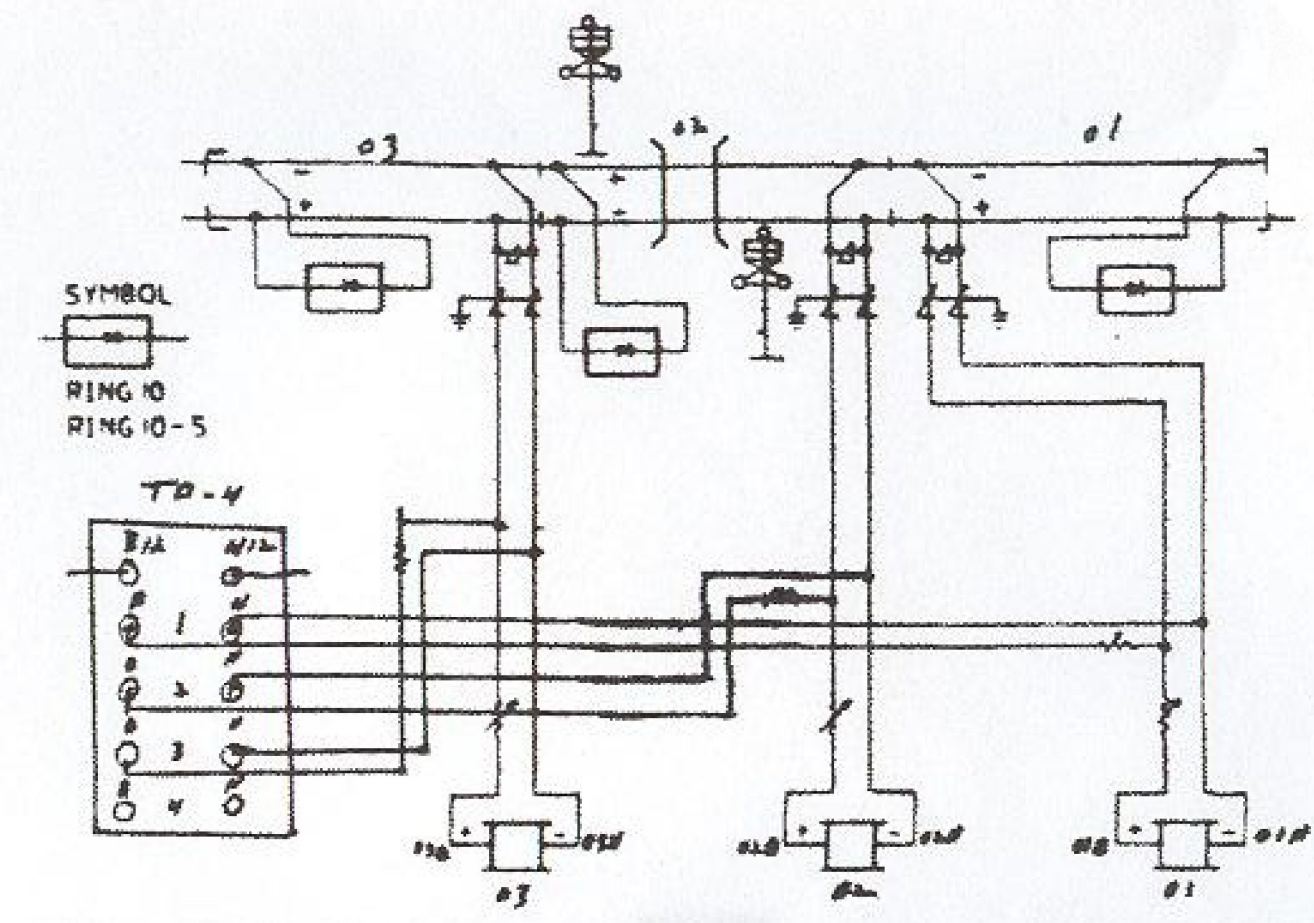
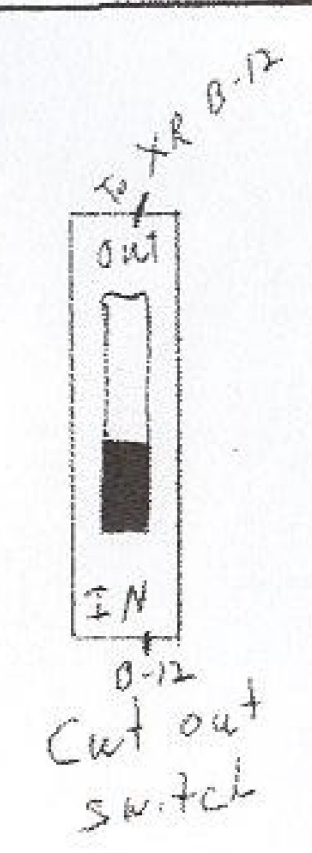


16:08:58 02-08-2012 3/3

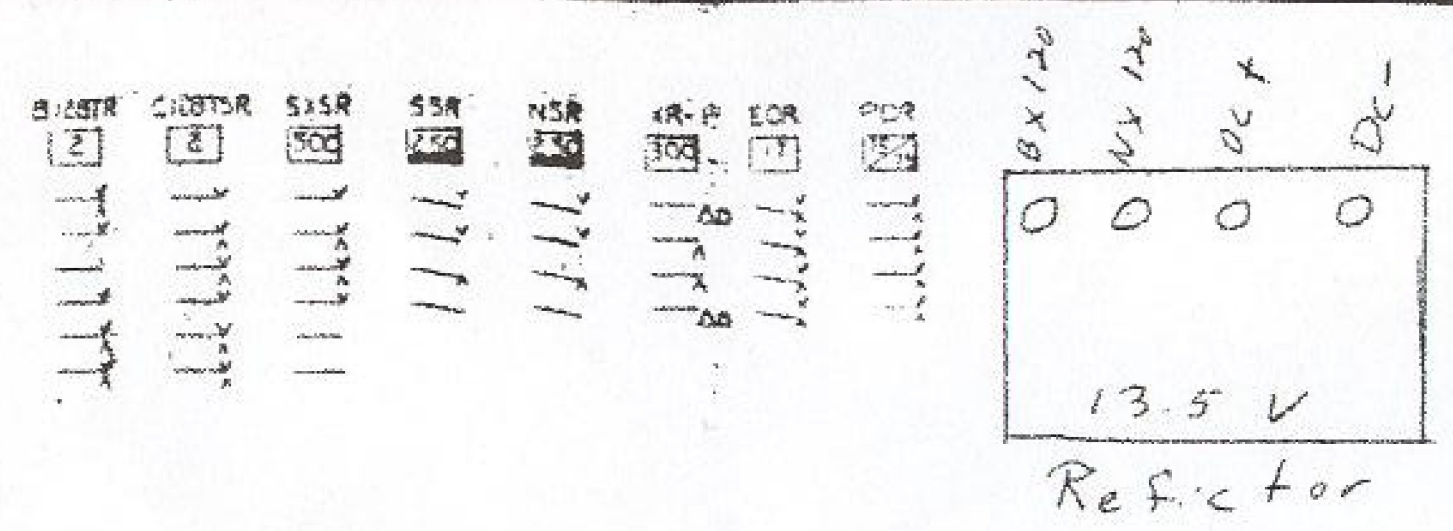

D 13.74 053 579 V	DR
Bradford	DR
LOCAL CIRCUITS & APPARATUS	SW
CASE	SH
	CHK
	APP
	72

16:08:27 02-08-2012

CROSSING RECORD SIGNAL PLAN	
PROJECT NAME:	BRADFORD
PROJECT NUMBER:	STP 2917(I)
FILE NAME:	pl0b236.dgn
PROJECT LEADER:	PTS
DESIGNED BY:	JHR
IPARM FILE NAME:	IOB236.37
PLOT DATE:	8/16/2012
DRAWN BY:	ABR
CHECKED BY:	JHR
SHEET	37 OF 105