

TEMPORARY 4 INCH WHITE LINE, PAINT
 DURABLE 4 INCH WHITE LINE
 0+38 TO 5+00 SOLID LT & RT

TEMPORARY 4 INCH YELLOW LINE, PAINT
 DURABLE 4 INCH YELLOW LINE
 0+38 TO 5+00 SOLID LT & RT

HD STEEL BEAM GUARDRAIL, GALVANIZED
 0+36 TO 0+67.3 LT
 0+36 TO 0+67.3 RT


STEEL BEAM GUARDRAIL, GALVANIZED
 0+67.3 TO 1+29.8 LT
 0+67.3 TO 1+04.8 RT

STEEL BEAM GUARDRAIL, GALVANIZED W/8 FEET POSTS
 1+01 TO 3+76 RT

ANCHOR FOR STEEL BEAM RAIL
 1+01 RT
 1+04.8 RT
 1+29.8 LT
 3+76 RT

REMOVAL AND DISPOSAL OF GUARDRAIL
 0+36 TO 1+33 LT
 0+36 TO 1+01 RT
 1+01 TO 3+80 RT

DELINEATOR WITH STEEL POST
 1+01 RT
 1+30 LT
 3+76 RT

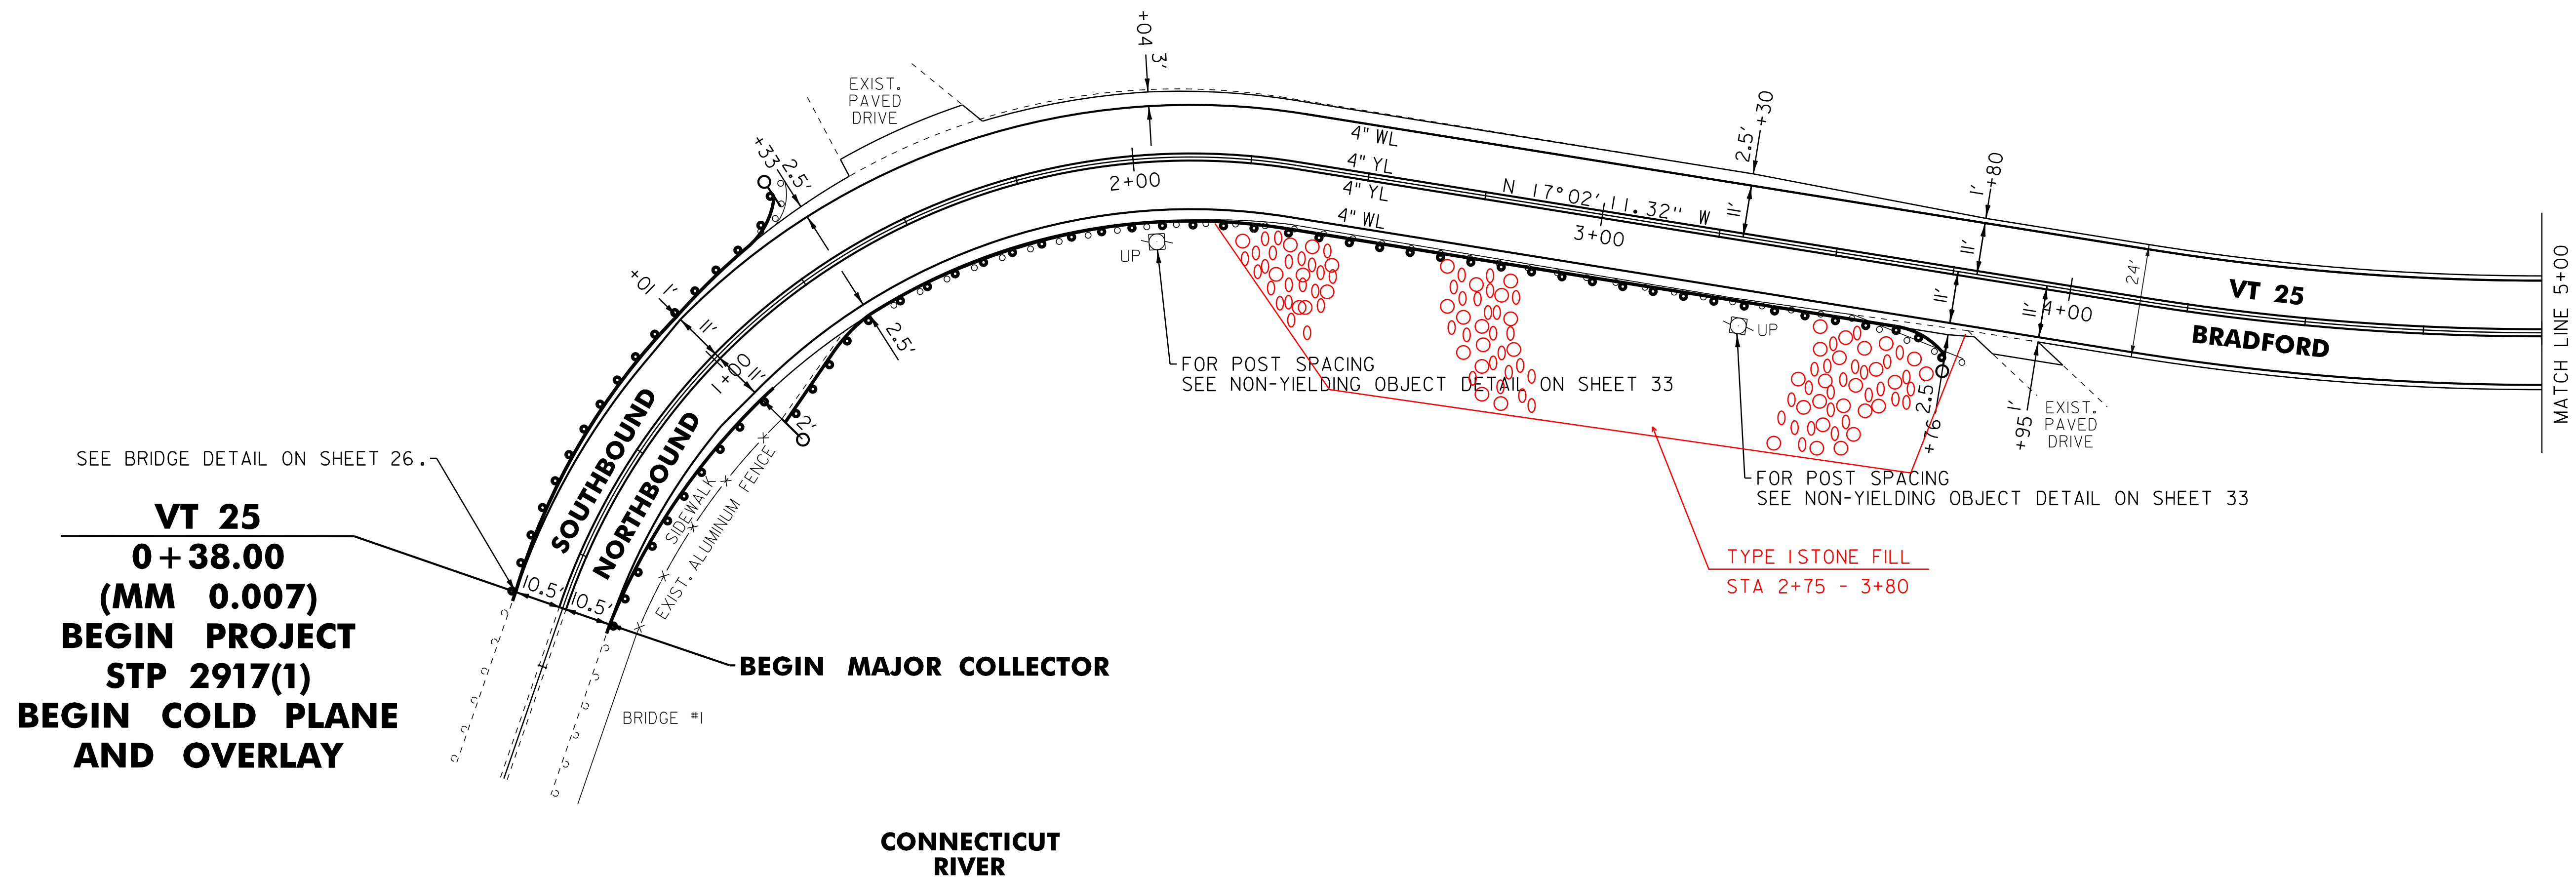

SEE BRIDGE DETAIL ON SHEET 26.
VT 25
0+38.00
(MM 0.007)
BEGIN PROJECT
STP 2917(1)
BEGIN COLD PLANE
AND OVERLAY

BEGIN MAJOR COLLECTOR

CONNECTICUT RIVER

NOT TO SCALE

LEGEND

- R = REMOVE EXISTING
- S = SALVAGED
- R&S = REMOVE AND SALVAGE
- N = NEW
- RET = RETAIN
- B-B = BACK TO BACK
- = EXISTING GUARDRAIL
- = PROPOSED GUARDRAIL
- YL = YELLOW LINE
- WL = WHITE LINE
- = DELINEATOR
- ||||| = RUMBLE STRIP

ROADWAY LAYOUT 1 VT 25

PROJECT NAME: BRADFORD

PROJECT NUMBER: STP 2917(1)

FILE NAME: p10b236.dgn

PROJECT LEADER: PTS

DESIGNED BY: NULL

IPARM FILE NAME: p10b236_40

PLOT DATE: 03-SEP-2014 12:50

DRAWN BY: SNG

CHECKED BY: PTS

SHEET 40 OF 105