


TEMPORARY 4 INCH WHITE LINE, PAINT  
 DURABLE 4 INCH WHITE LINE  
 U73+25 TO U77+55 SOLID LT  
 U73+25 TO U77+55 SOLID RT  
 U73+25 TO U75+25 SOLID LT (LANE LINE)  
 U75+25 TO U77+55 DOTTED LT (LANE LINE)  
 TEMPORARY 4 INCH YELLOW LINE, PAINT  
 DURABLE 4 INCH YELLOW LINE  
 U73+25 TO U77+55 SOLID LT & RT

DURABLE LETTER OR SYMBOL  
 U73+88 LT - THRU ARROW  
 U73+90 LT - LEFT TURN ARROW  
 U73+90 RT - RIGHT TURN ARROW  
 U74+55 LT - "ONLY"  
 U75+18 LT - THRU ARROW  
 U75+21 LT - RIGHT TURN ARROW  
 U75+21 RT - LEFT TURN ARROW

TEMPORARY LETTER OR SYMBOL, PAINT  
 U75+18 LT - THRU ARROW  
 U75+21 LT - RIGHT TURN ARROW  
 U75+21 RT - LEFT TURN ARROW  
 PAINTED CURB  
 U73+25 TO U73+28 LT & RT ( ISLAND)  
 U75+18 TO U77+55 LT & RT ( ISLAND)

SEE REVISED SHEET

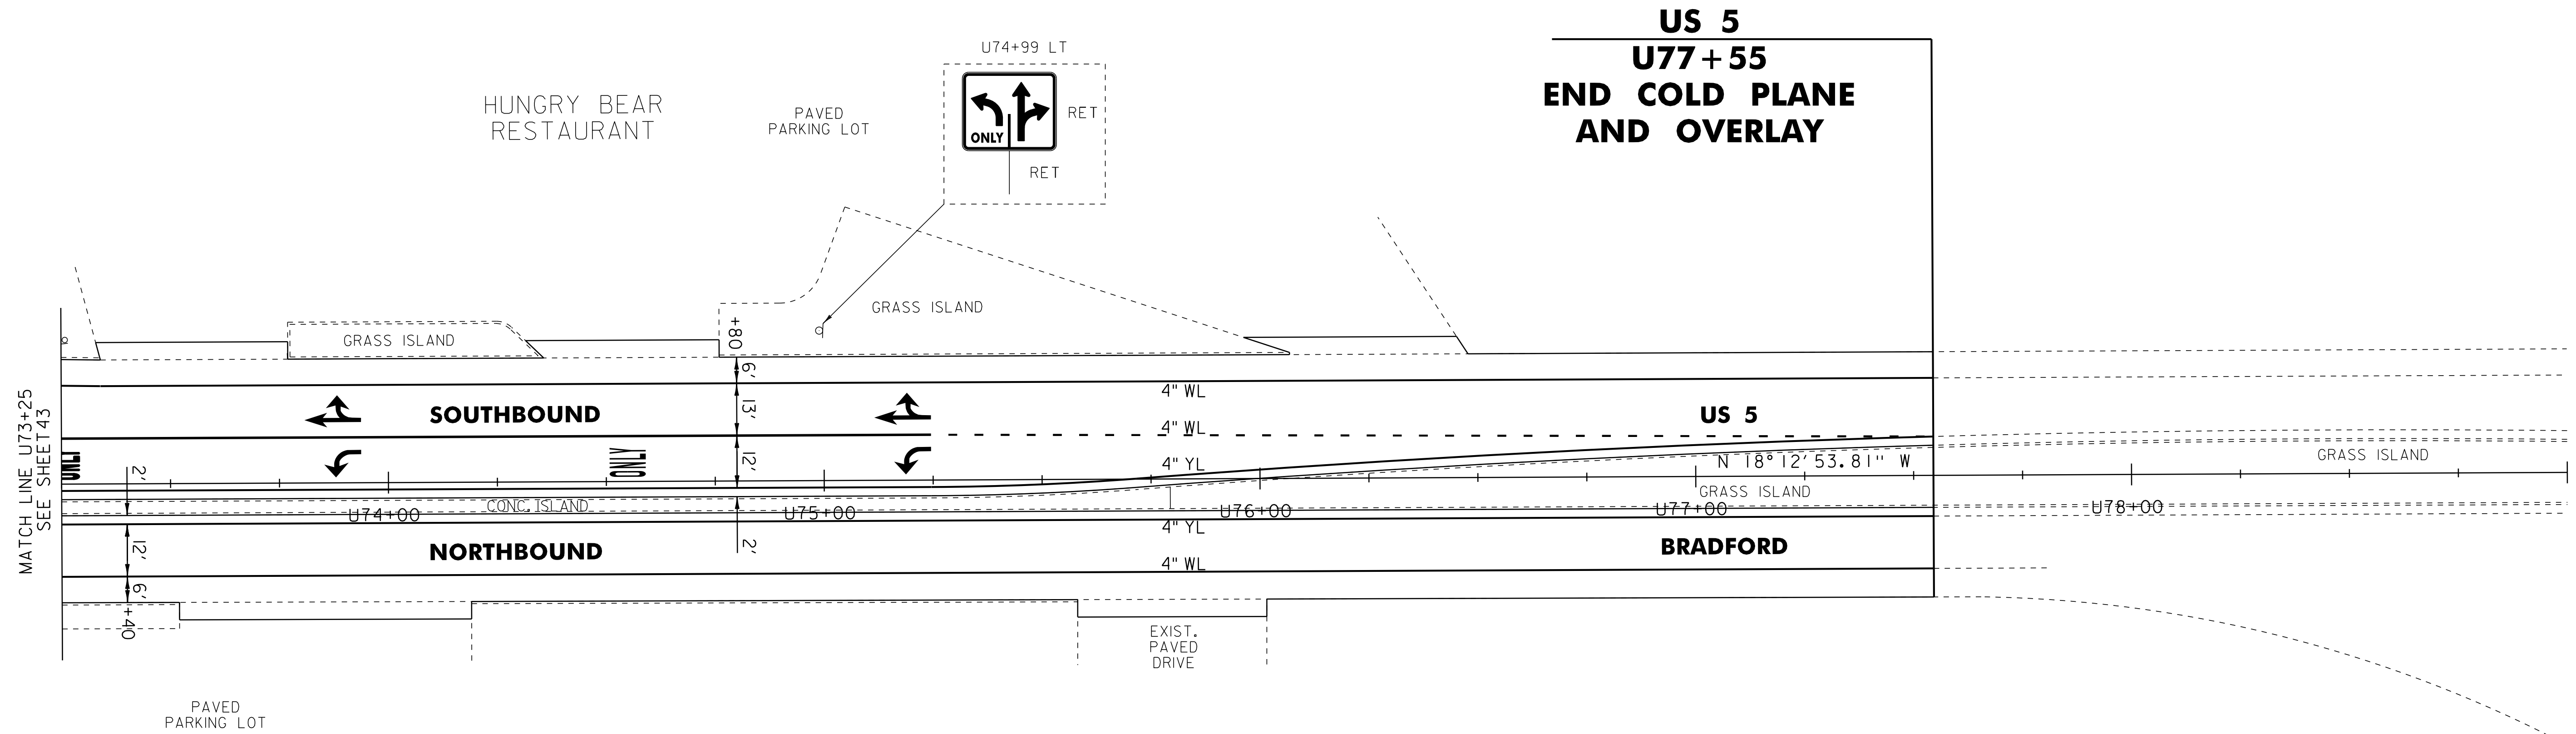

LEGEND

- R = REMOVE EXISTING
- S = SALVAGED
- R&S = REMOVE AND SALVAGE
- N = NEW
- RET = RETAIN
- B-B = BACK TO BACK
- = EXISTING GUARDRAIL
- = PROPOSED GUARDRAIL
- YL = YELLOW LINE
- WL = WHITE LINE
- = DELINEATOR
- ||||||| = RUMBLE STRIP

**ROADWAY LAYOUT 4B US 5**

PROJECT NAME: BRADFORD	PLOT DATE: 03-SEP-2014 12:50
PROJECT NUMBER: STP 2917(I)	DRAWN BY: WWG
FILE NAME: p10b236.dgn	CHECKED BY: PTS
PROJECT LEADER: PTS	SHEET 45 OF 105
DESIGNED BY: NULL	
IPARM FILE NAME: p10b236_45	

NOT TO SCALE