


TEMPORARY 4 INCH WHITE LINE, PAINT  
 DURABLE 4 INCH WHITE LINE  
 34+50 TO 36+02 SOLID LT  
 34+50 TO 45+00 SOLID RT  
 36+02 TO 36+30 SOLID LT (TH 50)  
 36+48 TO 36+76 SOLID LT (TH 50)  
 36+76 TO 45+00 SOLID LT

TEMPORARY 4 INCH YELLOW LINE, PAINT  
 DURABLE 4 INCH YELLOW LINE  
 34+50 TO 36+19 SOLID LT & RT  
 36+39 DOUBLE SOLID LT (TH 50)  
 36+59 TO 45+00 SOLID LT & RT

TEMPORARY 24 INCH STOP BAR, PAINT  
 DURABLE 24 INCH STOP BAR  
 36+24 TO 36+38 LT (TH 50)  
 TEMPORARY LETTER OR SYMBOL, PAINT  
 DURABLE LETTER OR SYMBOL  
 36+34 LT - "STOP" (TH 50)

REHAB. DROP INLETS  
 CATCH BASINS, OR MANHOLES,  
 CLASS I, CLASS II  
 39+11 LT (DI)  
~~41+64 LT (DI)~~  
 STEEL BEAM GUARDRAIL, GALVANIZED  
 36+65 TO 45+00 LT  
 38+90 TO 45+00 RT  
 REMOVAL AND DISPOSAL OF GUARDRAIL  
 36+85 TO 45+00 LT  
 39+31 TO 45+00 RT

ANCHOR FOR STEEL BEAM RAIL  
 36+65 LT  
 38+90 RT  
 REMOVAL AND DISPOSAL OF GUIDE POSTS  
 36+52 TO 36+79 LT (7)  
 DELINEATOR WITH STEEL POST  
 36+65 LT  
 38+90 RT

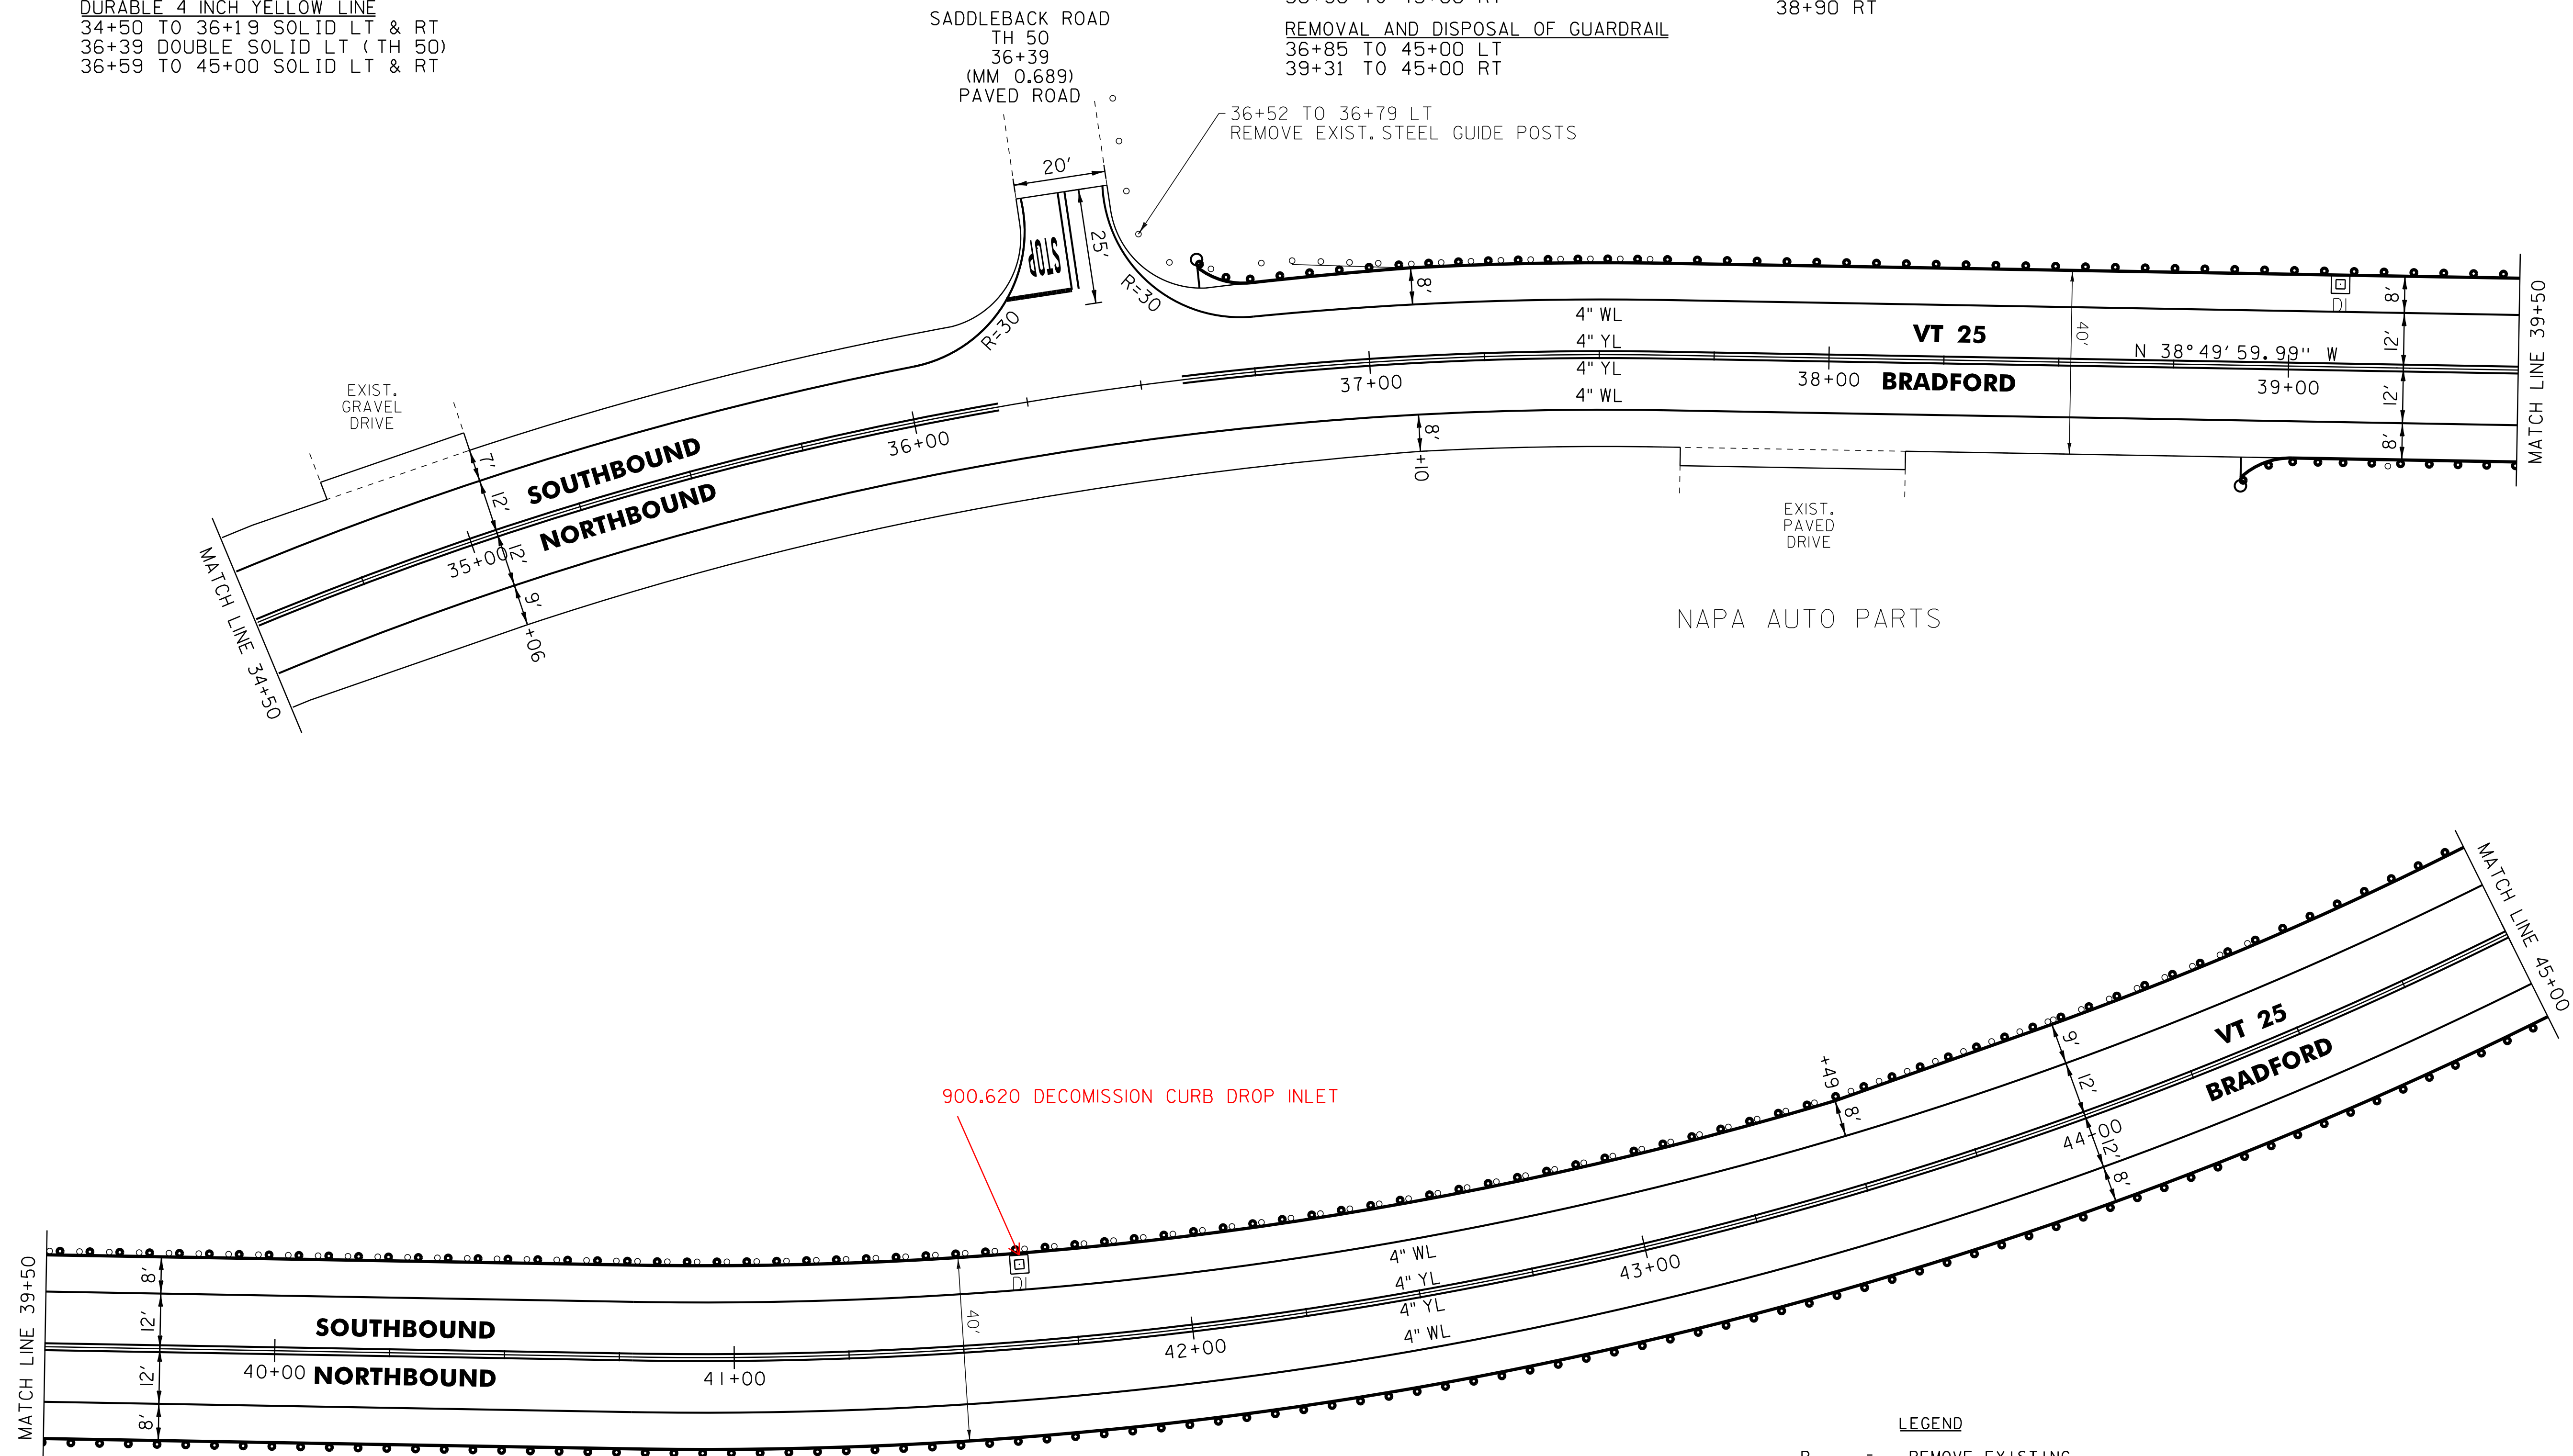

LEGEND

- R = REMOVE EXISTING
- S = SALVAGED
- R&S = REMOVE AND SALVAGE
- N = NEW
- RET = RETAIN
- B-B = BACK TO BACK
- = EXISTING GUARDRAIL
- = PROPOSED GUARDRAIL
- YL = YELLOW LINE
- WL = WHITE LINE
- = DELINEATOR
- ||||||| = RUMBLE STRIP

ROADWAY LAYOUT 6 VT 25

PROJECT NAME:	BRADFORD
PROJECT NUMBER:	STP 2917(I)
FILE NAME:	pl0b236.dgn
PROJECT LEADER:	PTS
DESIGNED BY:	NULL
IPARM FILE NAME:	pl0b236_47
PLOT DATE:	03-SEP-2014 12:50
DRAWN BY:	SNG
CHECKED BY:	PTS
SHEET	47 OF 105

NOT TO SCALE