

TEMPORARY 4 INCH WHITE LINE, PAINT  
 DURABLE 4 INCH WHITE LINE  
 104+00 TO 115+00 SOLID LT & RT



TEMPORARY 4 INCH YELLOW LINE, PAINT  
 DURABLE 4 INCH YELLOW LINE  
 104+00 TO 115+00 SOLID LT & RT

STEEL BEAM GUARDRAIL,  
 GALVANIZED W/8 FEET POSTS  
 106+15 TO 115+00 RT

ANCHOR FOR STEEL BEAM RAIL  
 106+15 RT

REMOVAL AND DISPOSAL OF GUARDRAIL  
 106+15 TO 115+00 RT

DELINEATOR WITH STEEL POST  
 106+15 RT

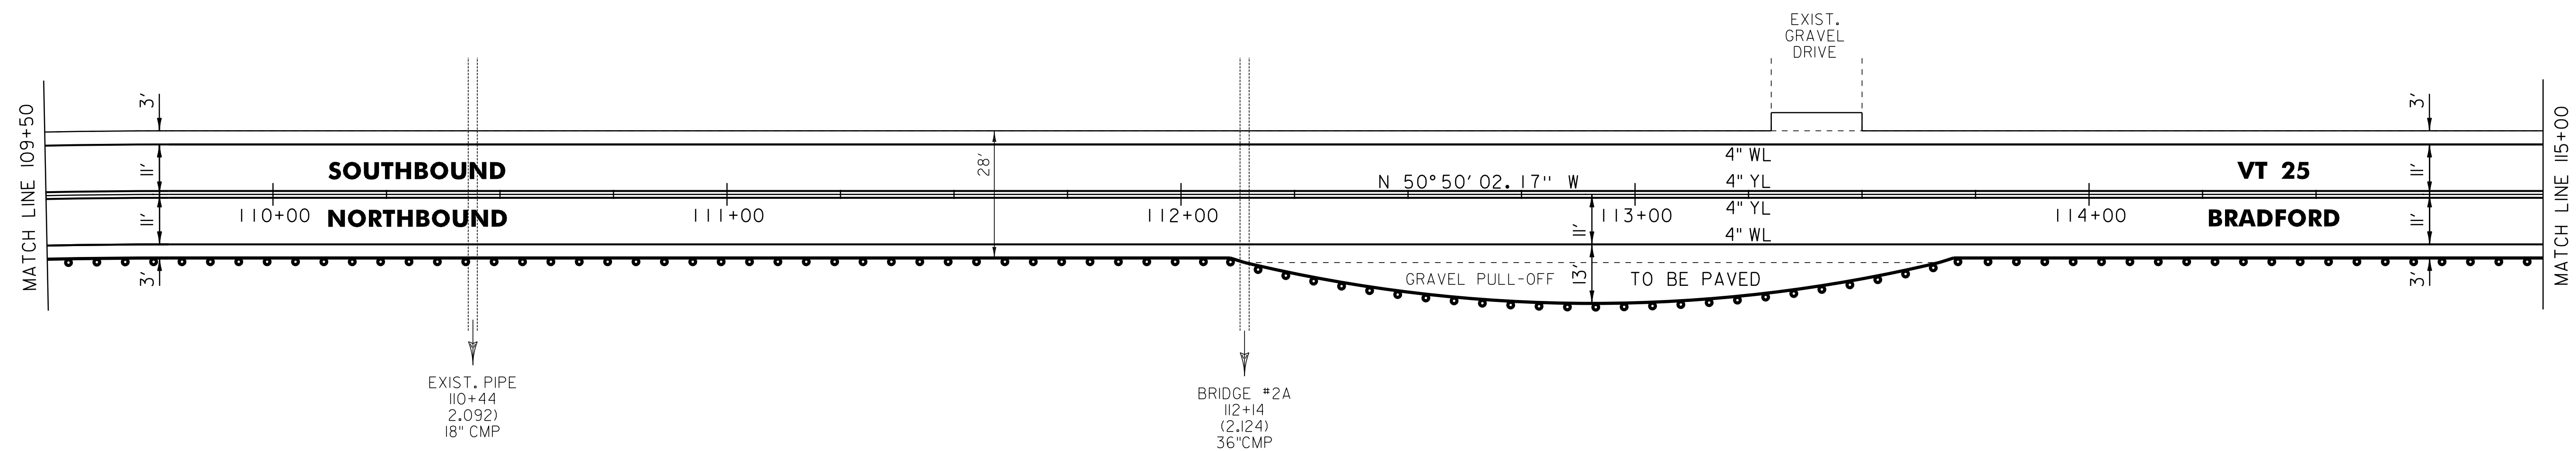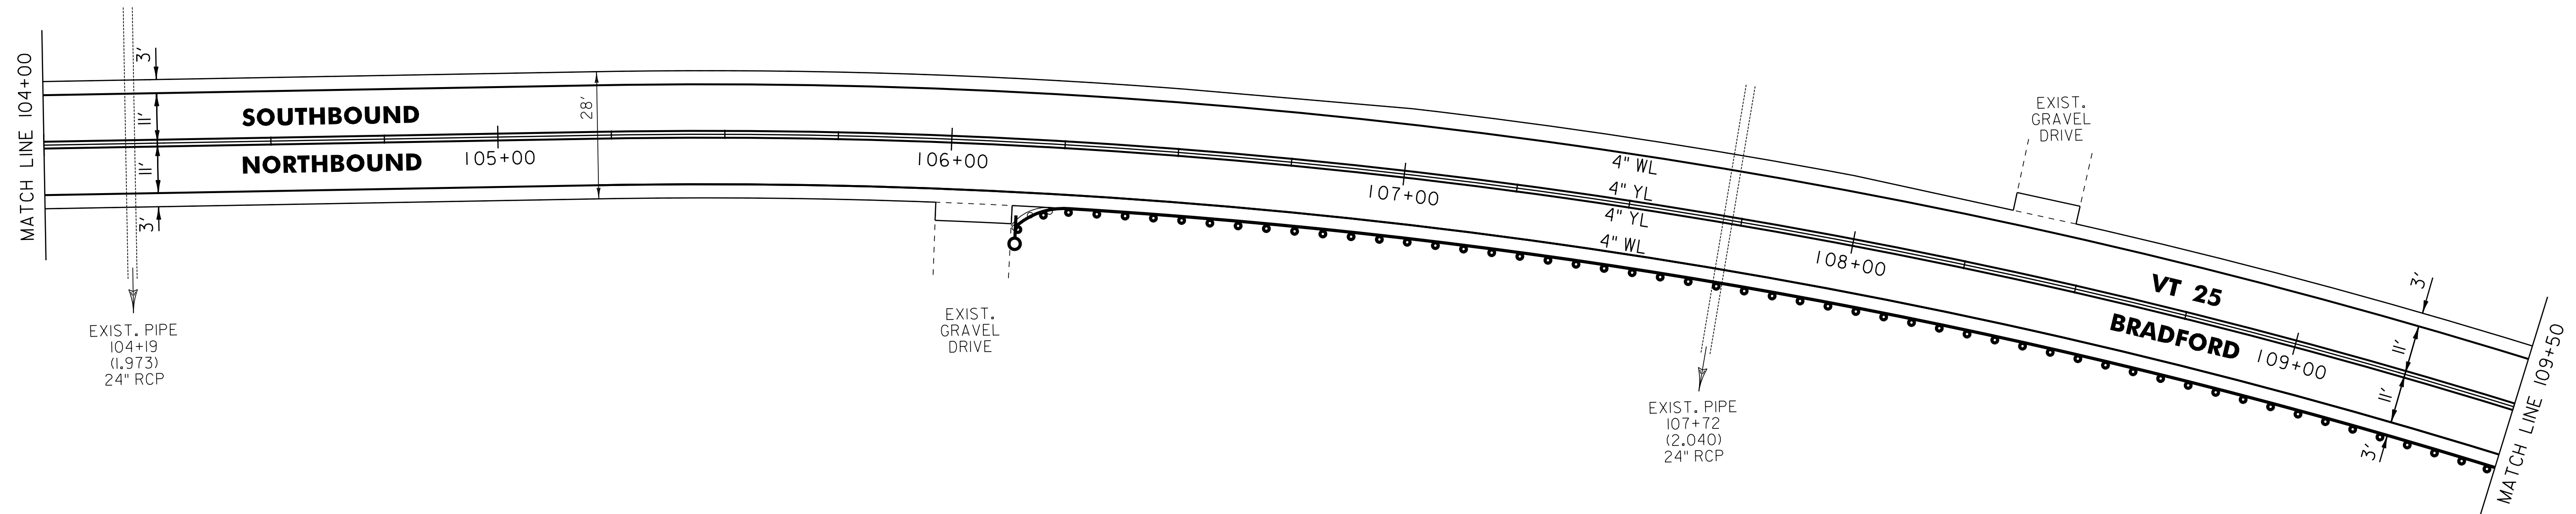

**LEGEND**

- R = REMOVE EXISTING
- S = SALVAGED
- R&S = REMOVE AND SALVAGE
- N = NEW
- RET = RETAIN
- B-B = BACK TO BACK
- = EXISTING GUARDRAIL
- = PROPOSED GUARDRAIL
- YL = YELLOW LINE
- WL = WHITE LINE
- = DELINEATOR
- ||||||| = RUMBLE STRIP

**ROADWAY LAYOUT 15 VT 25**

PROJECT NAME: BRADFORD

PROJECT NUMBER: STP 2917(I)

FILE NAME: p10b236.dgn

PROJECT LEADER: PTS

DESIGNED BY: NULL

IPARM FILE NAME: p10b236\_56

PLOT DATE: 03-SEP-2014 12:50

DRAWN BY: SNG

CHECKED BY: PTS

SHEET 56 OF 105

NOT TO SCALE