

TEMPORARY 4 INCH WHITE LINE, PAINT
 DURABLE 4 INCH WHITE LINE
 136+00 TO 147+00 SOLID LT & RT


TEMPORARY 4 INCH YELLOW LINE, PAINT
 DURABLE 4 INCH YELLOW LINE
 136+00 TO 147+00 SOLID LT & RT

STEEL BEAM GUARDRAIL, GALVANIZED
 137+13 TO 147+00 RT

ANCHOR FOR STEEL BEAM RAIL
 137+13 RT

REMOVAL AND DISPOSAL OF GUARDRAIL
 137+62 TO 147+00 RT

DELINEATOR WITH STEEL POST
 137+13 RT

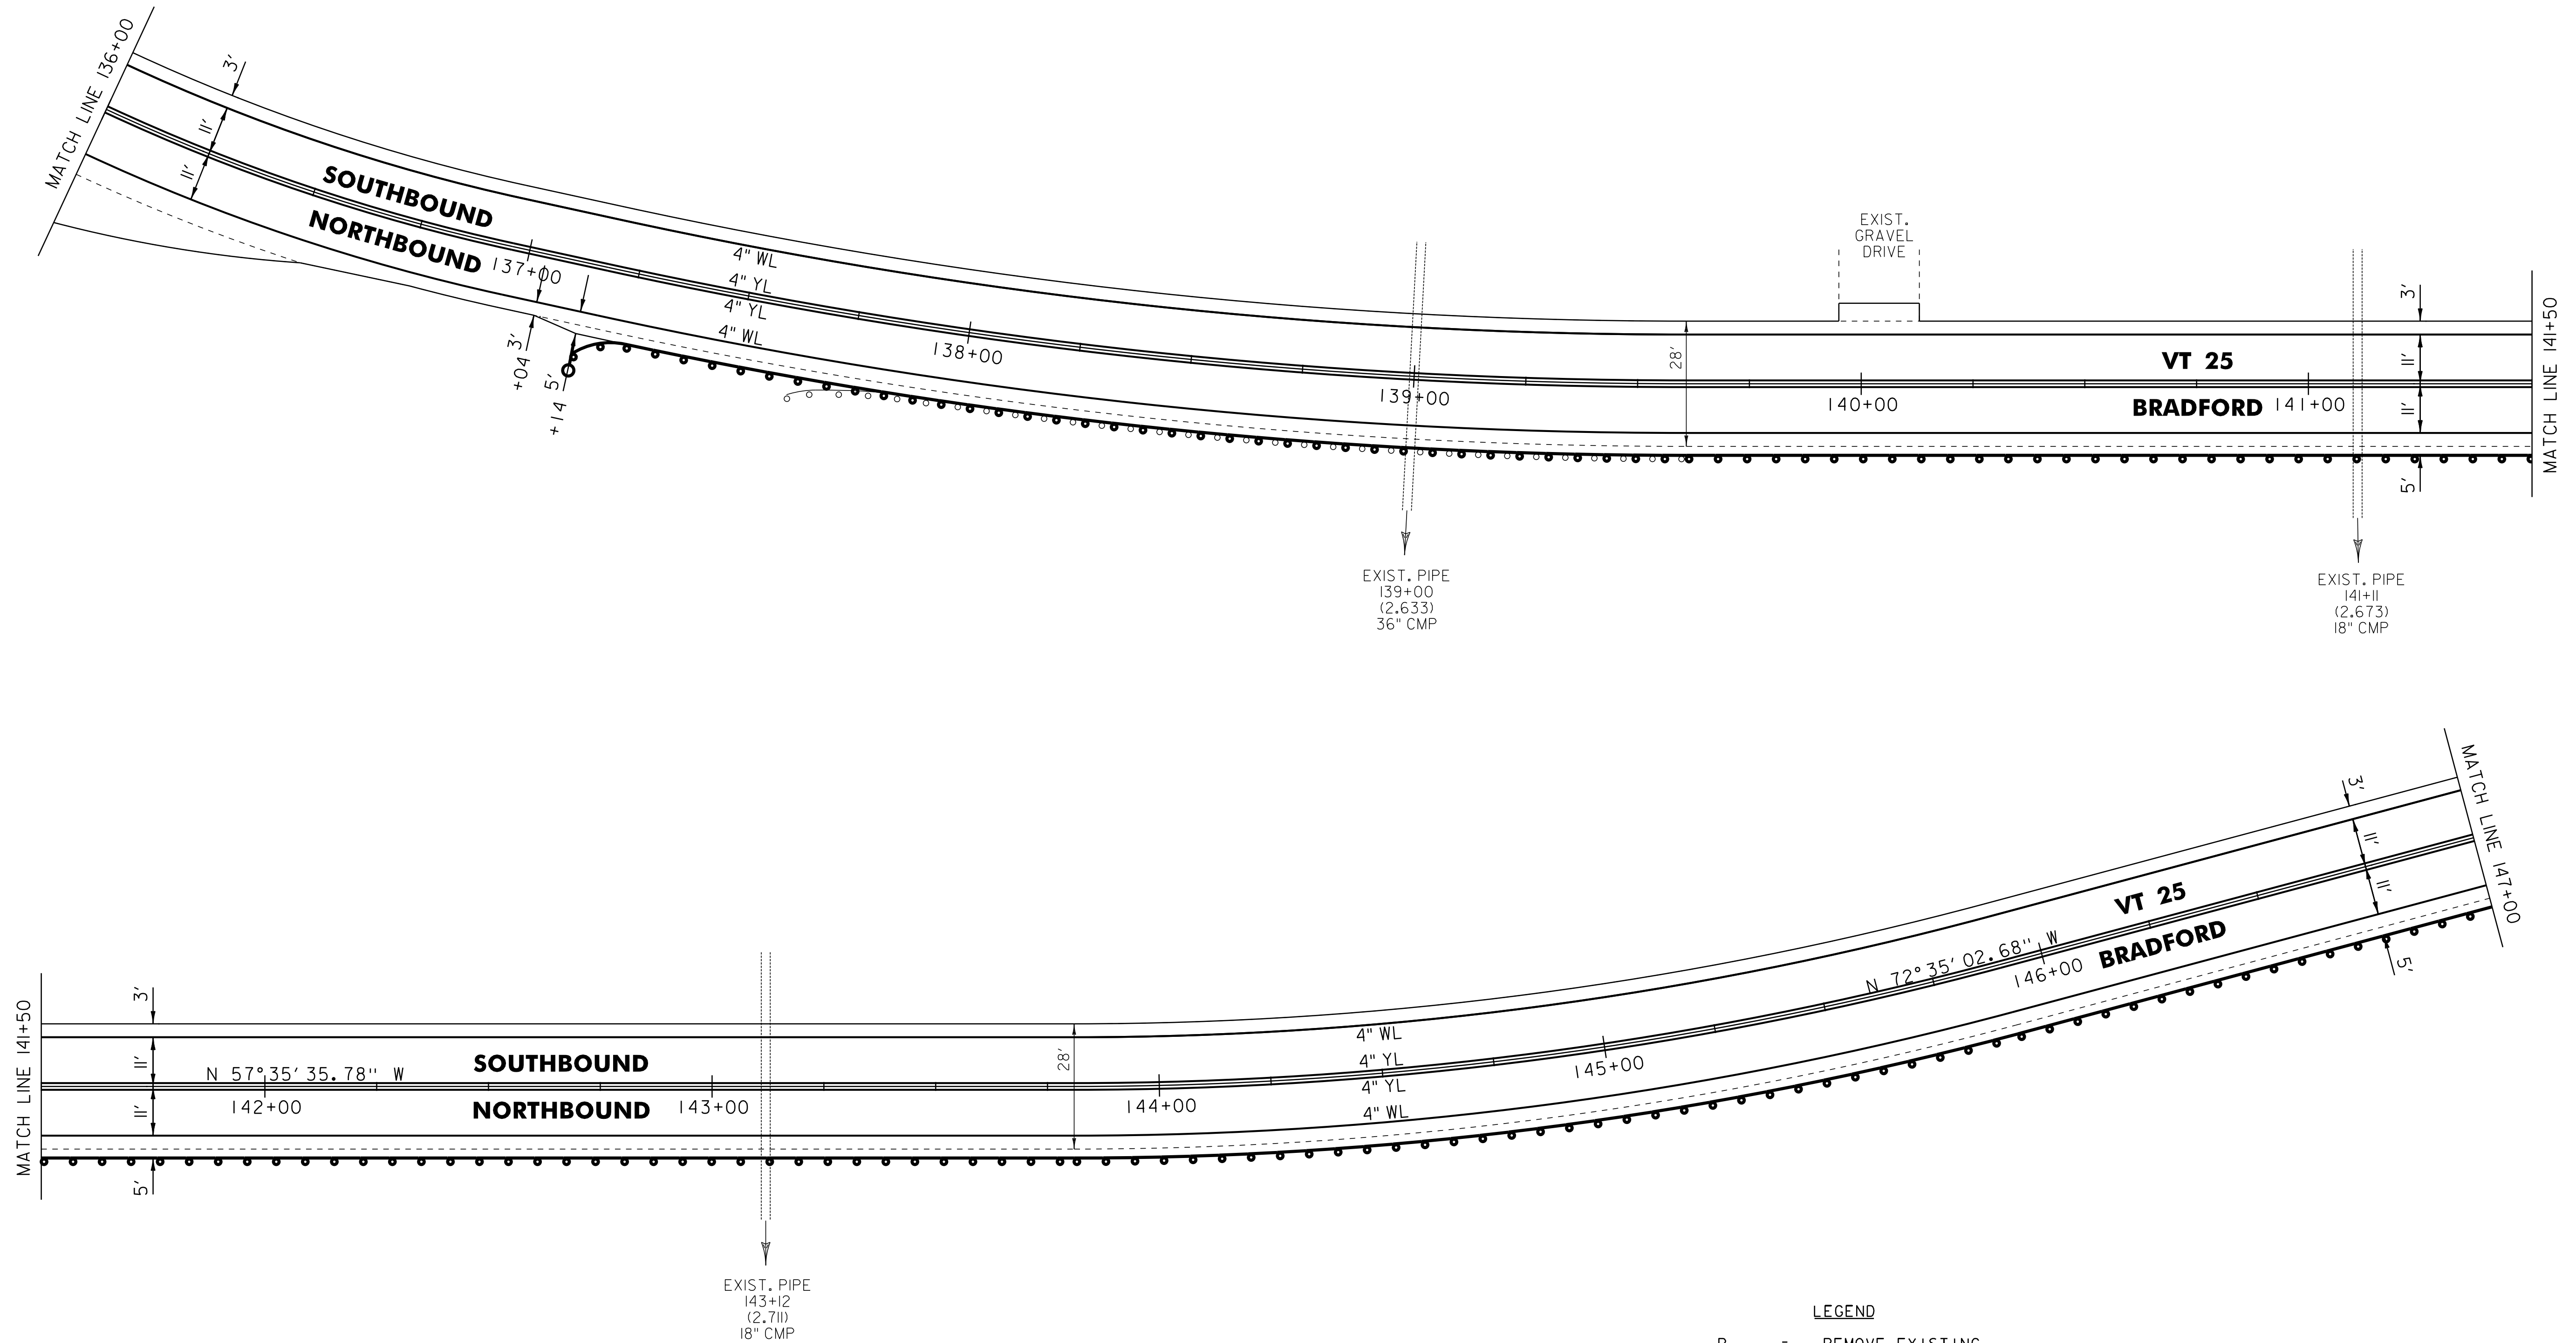

LEGEND

- R = REMOVE EXISTING
- S = SALVAGED
- R&S = REMOVE AND SALVAGE
- N = NEW
- RET = RETAIN
- B-B = BACK TO BACK
- = EXISTING GUARDRAIL
- = PROPOSED GUARDRAIL
- = YELLOW LINE
- = WHITE LINE
- = DELINEATOR
- = RUMBLE STRIP

ROADWAY LAYOUT 19 VT 25

PROJECT NAME: BRADFORD	PLOT DATE: 03-SEP-2014 12:50
PROJECT NUMBER: STP 2917(I)	DRAWN BY: SNG
FILE NAME: p10b236.dgn	CHECKED BY: PTS
PROJECT LEADER: PTS	SHEET 60 OF 105
DESIGNED BY: NLL	
IPARM FILE NAME: p10b236_60	

NOT TO SCALE