

TEMPORARY 4 INCH WHITE LINE, PAINT
 DURABLE 4 INCH WHITE LINE
 202+00 TO 203+42 SOLID LT
 202+00 TO 213+00 SOLID RT
 203+42 TO 203+78 SOLID LT (TH 23)
 204+05 TO 204+14 SOLID LT (TH 23)
 204+14 TO 213+00 SOLID LT

TEMPORARY 4 INCH YELLOW LINE, PAINT
 DURABLE 4 INCH YELLOW LINE
 202+00 TO 203+65 SOLID LT & RT
 203+85 TO 203+91 DOUBLE SOLID LT (TH 23)
 204+05 TO 213+00 SOLID LT & RT

TEMPORARY 24 INCH STOP BAR, PAINT
 DURABLE 24 INCH STOP BAR
 203+60 TO 203+84 LT (TH 23)

TEMPORARY LETTER OR SYMBOL, PAINT
 DURABLE LETTER OR SYMBOL
 203+77 LT - " STOP" (TH 23)

STEEL BEAM GUARDRAIL, GALVANIZED
 203+34.5 TO 204+72 RT
 204+13.5 TO 205+38.5 LT
 207+44.5 TO 208+07 RT
 208+10 TO 208+85 LT

KENYAN ROAD
 TH 23
 203+66
 (MM 3.857)
 PAVED APRON
 GRAVEL ROAD

GUARDRAIL APPROACH
 SECTION, GALV. TYPE I
 204+72 TO 205+22 RT
 207+60 TO 208+10 LT

GUARDRAIL APPROACH
 SECTION, GALV. TYPE II
 205+38.5 TO 205+51 LT
 207+32 TO 207+44.5 RT


REMOVAL AND DISPOSAL OF GUARDRAIL
 203+33 TO 205+22 RT
 204+08 TO 205+51 LT
 207+32 TO 208+06 RT
 207+60 TO 208+84 LT

ANCHOR FOR STEEL BEAM RAIL
 203+34.5 RT
 204+13.5 LT
 208+07 RT
 208+85 LT

DELINEATOR WITH STEEL POST
 203+34.5 RT
 204+13.5 LT
 208+07 RT
 208+85 LT

REMOVE AND REPLACE
 REFLECTOR UNIT
 205+37 TO 207+46 LT & RT (16)

BRIDGE #5
 OVER WAITS RIVER
 206+42
 (3.909)
 COLD PLANE
 AND OVERLAY

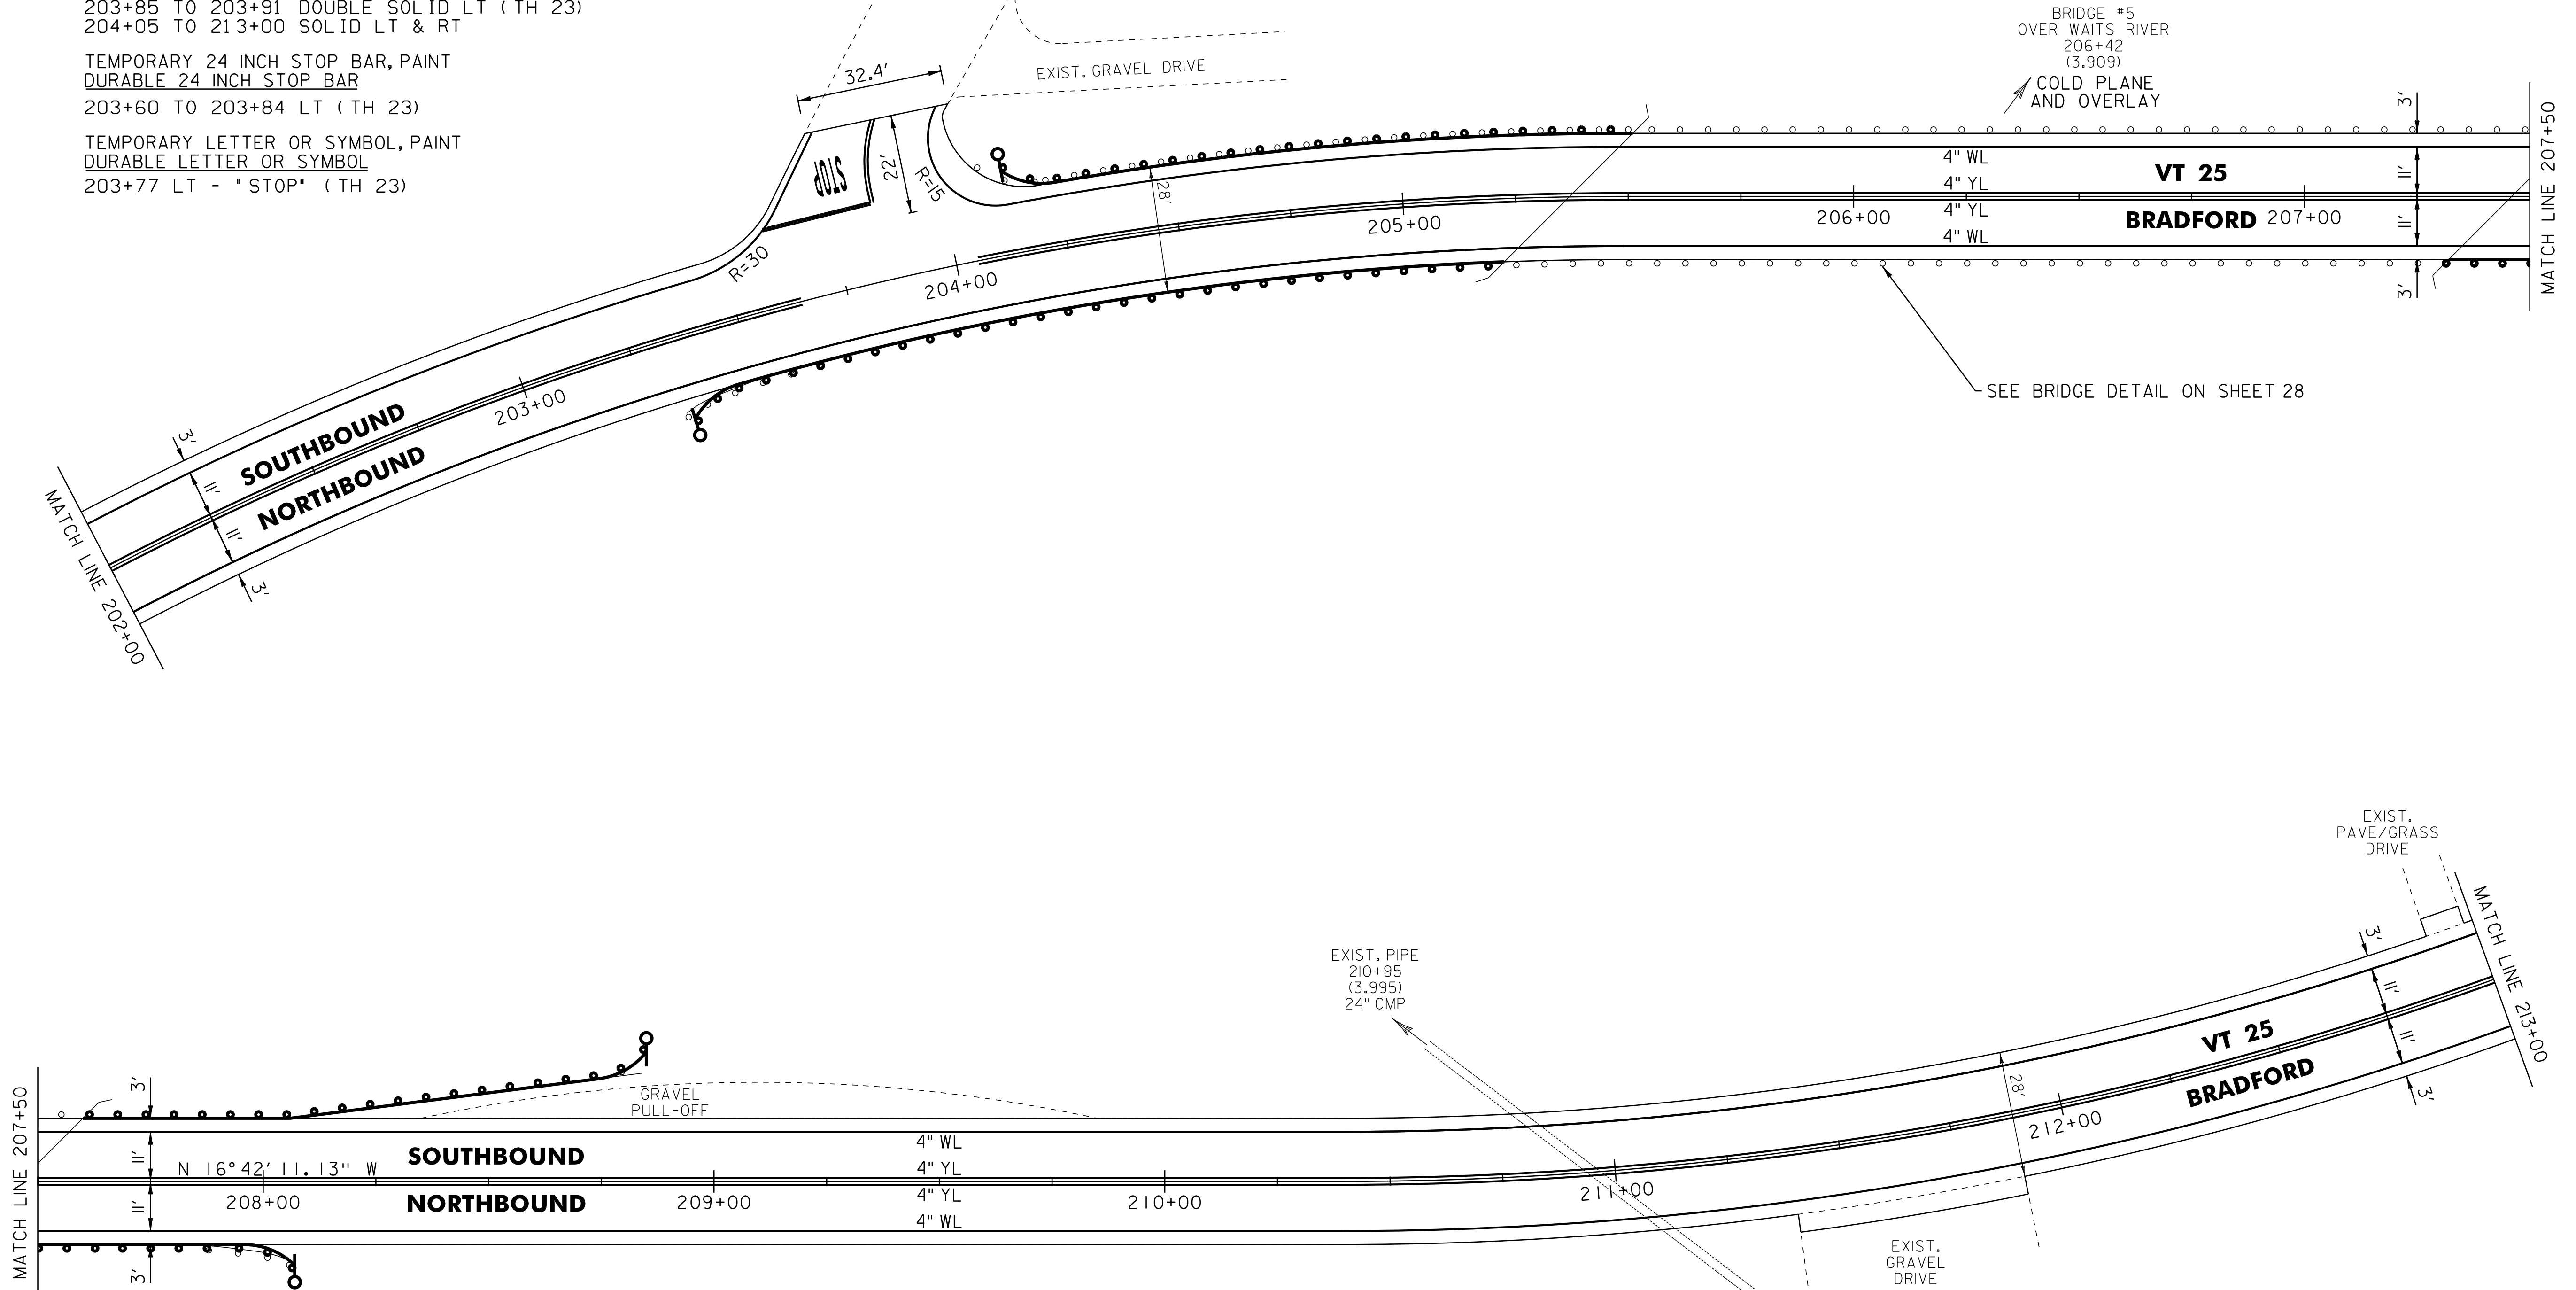

LEGEND

- R = REMOVE EXISTING
- S = SALVAGED
- R&S = REMOVE AND SALVAGE
- N = NEW
- RET = RETAIN
- B-B = BACK TO BACK
- = EXISTING GUARDRAIL
- = PROPOSED GUARDRAIL
- = YELLOW LINE
- = WHITE LINE
- = DELINEATOR
- = RUMBLE STRIP

ROADWAY LAYOUT 25 VT 25

PROJECT NAME: BRADFORD

PROJECT NUMBER: STP 2917(I)

FILE NAME: p10b236.dgn

PROJECT LEADER: PTS

DESIGNED BY: NULL

IPARM FILE NAME: p10b236_66

PLOT DATE: 03-SEP-2014 12:51

DRAWN BY: SNG

CHECKED BY: PTS

SHEET 66 OF 105

NOT TO SCALE