

TEMPORARY 4 INCH WHITE LINE, PAINT
 DURABLE 4 INCH WHITE LINE
 233+00 TO 243+00 SOLID LT
 233+00 TO 234+53 SOLID RT
 234+53 TO 235+07 SOLID RT (TH 19)
 235+32 TO 235+48 SOLID RT (TH 19)
 235+48 TO 243+00 SOLID RT

TEMPORARY 4 INCH YELLOW LINE, PAINT
 DURABLE 4 INCH YELLOW LINE
 233+00 TO 234+88 SOLID LT & RT
 235+08 TO 235+18 DOUBLE SOLID RT (TH 19)
 235+28 TO 243+00 SOLID LT & RT

TEMPORARY 24 INCH STOP BAR, PAINT
 DURABLE 24 INCH STOP BAR
 235+09 TO 235+33 RT (TH 19)
 TEMPORARY LETTER OR SYMBOL, PAINT
 DURABLE LETTER OR SYMBOL
 235+20 RT - "STOP" (TH 19)

REMOVAL OF EXISTING BRIDGE RAILING
 234+35 TO 234+60 RT
 234+48 TO 234+73 LT

BRIDGE RAILING REPAIR, TYPE I
 234+35 TO 234+60 RT
 234+48 TO 234+73 LT

STEEL BEAM GUARDRAIL, GALVANIZED
 233+35 TO 234+10 RT
 233+60.5 TO 234+23 LT
 234+81 TO 234+96 RT (25')
 234+98 TO 235+48 LT
 241+37.5 TO 243+00 LT

STEEL BEAM GUARDRAIL, GALVANIZED W/8 FEET POSTS
 236+87.5 TO 241+37.5 LT


HD STEEL BEAM GUARDRAIL, GALVANIZED
 234+10 TO 234+35 RT
 234+23 TO 234+48 LT
 234+60 TO 234+81 RT (25')
 234+73 TO 234+98 LT

ANCHOR FOR STEEL BEAM RAIL
 233+35 RT
 233+60.5 LT
 234+96 RT
 235+48 LT
 236+87.5 LT

REMOVAL AND DISPOSAL OF GUARDRAIL
 233+43 TO 234+35 RT
 233+61 TO 234+48 LT
 234+60 TO 234+96 RT
 234+73 TO 235+51 LT
 238+76 TO 243+00 LT

DELINEATOR WITH STEEL POST
 233+35 RT
 233+60.5 LT
 235+48 LT
 236+87.5 LT

FOR POST SPACING
 SEE NON-YIELDING OBJECT
 DETAIL ON SHEET 33

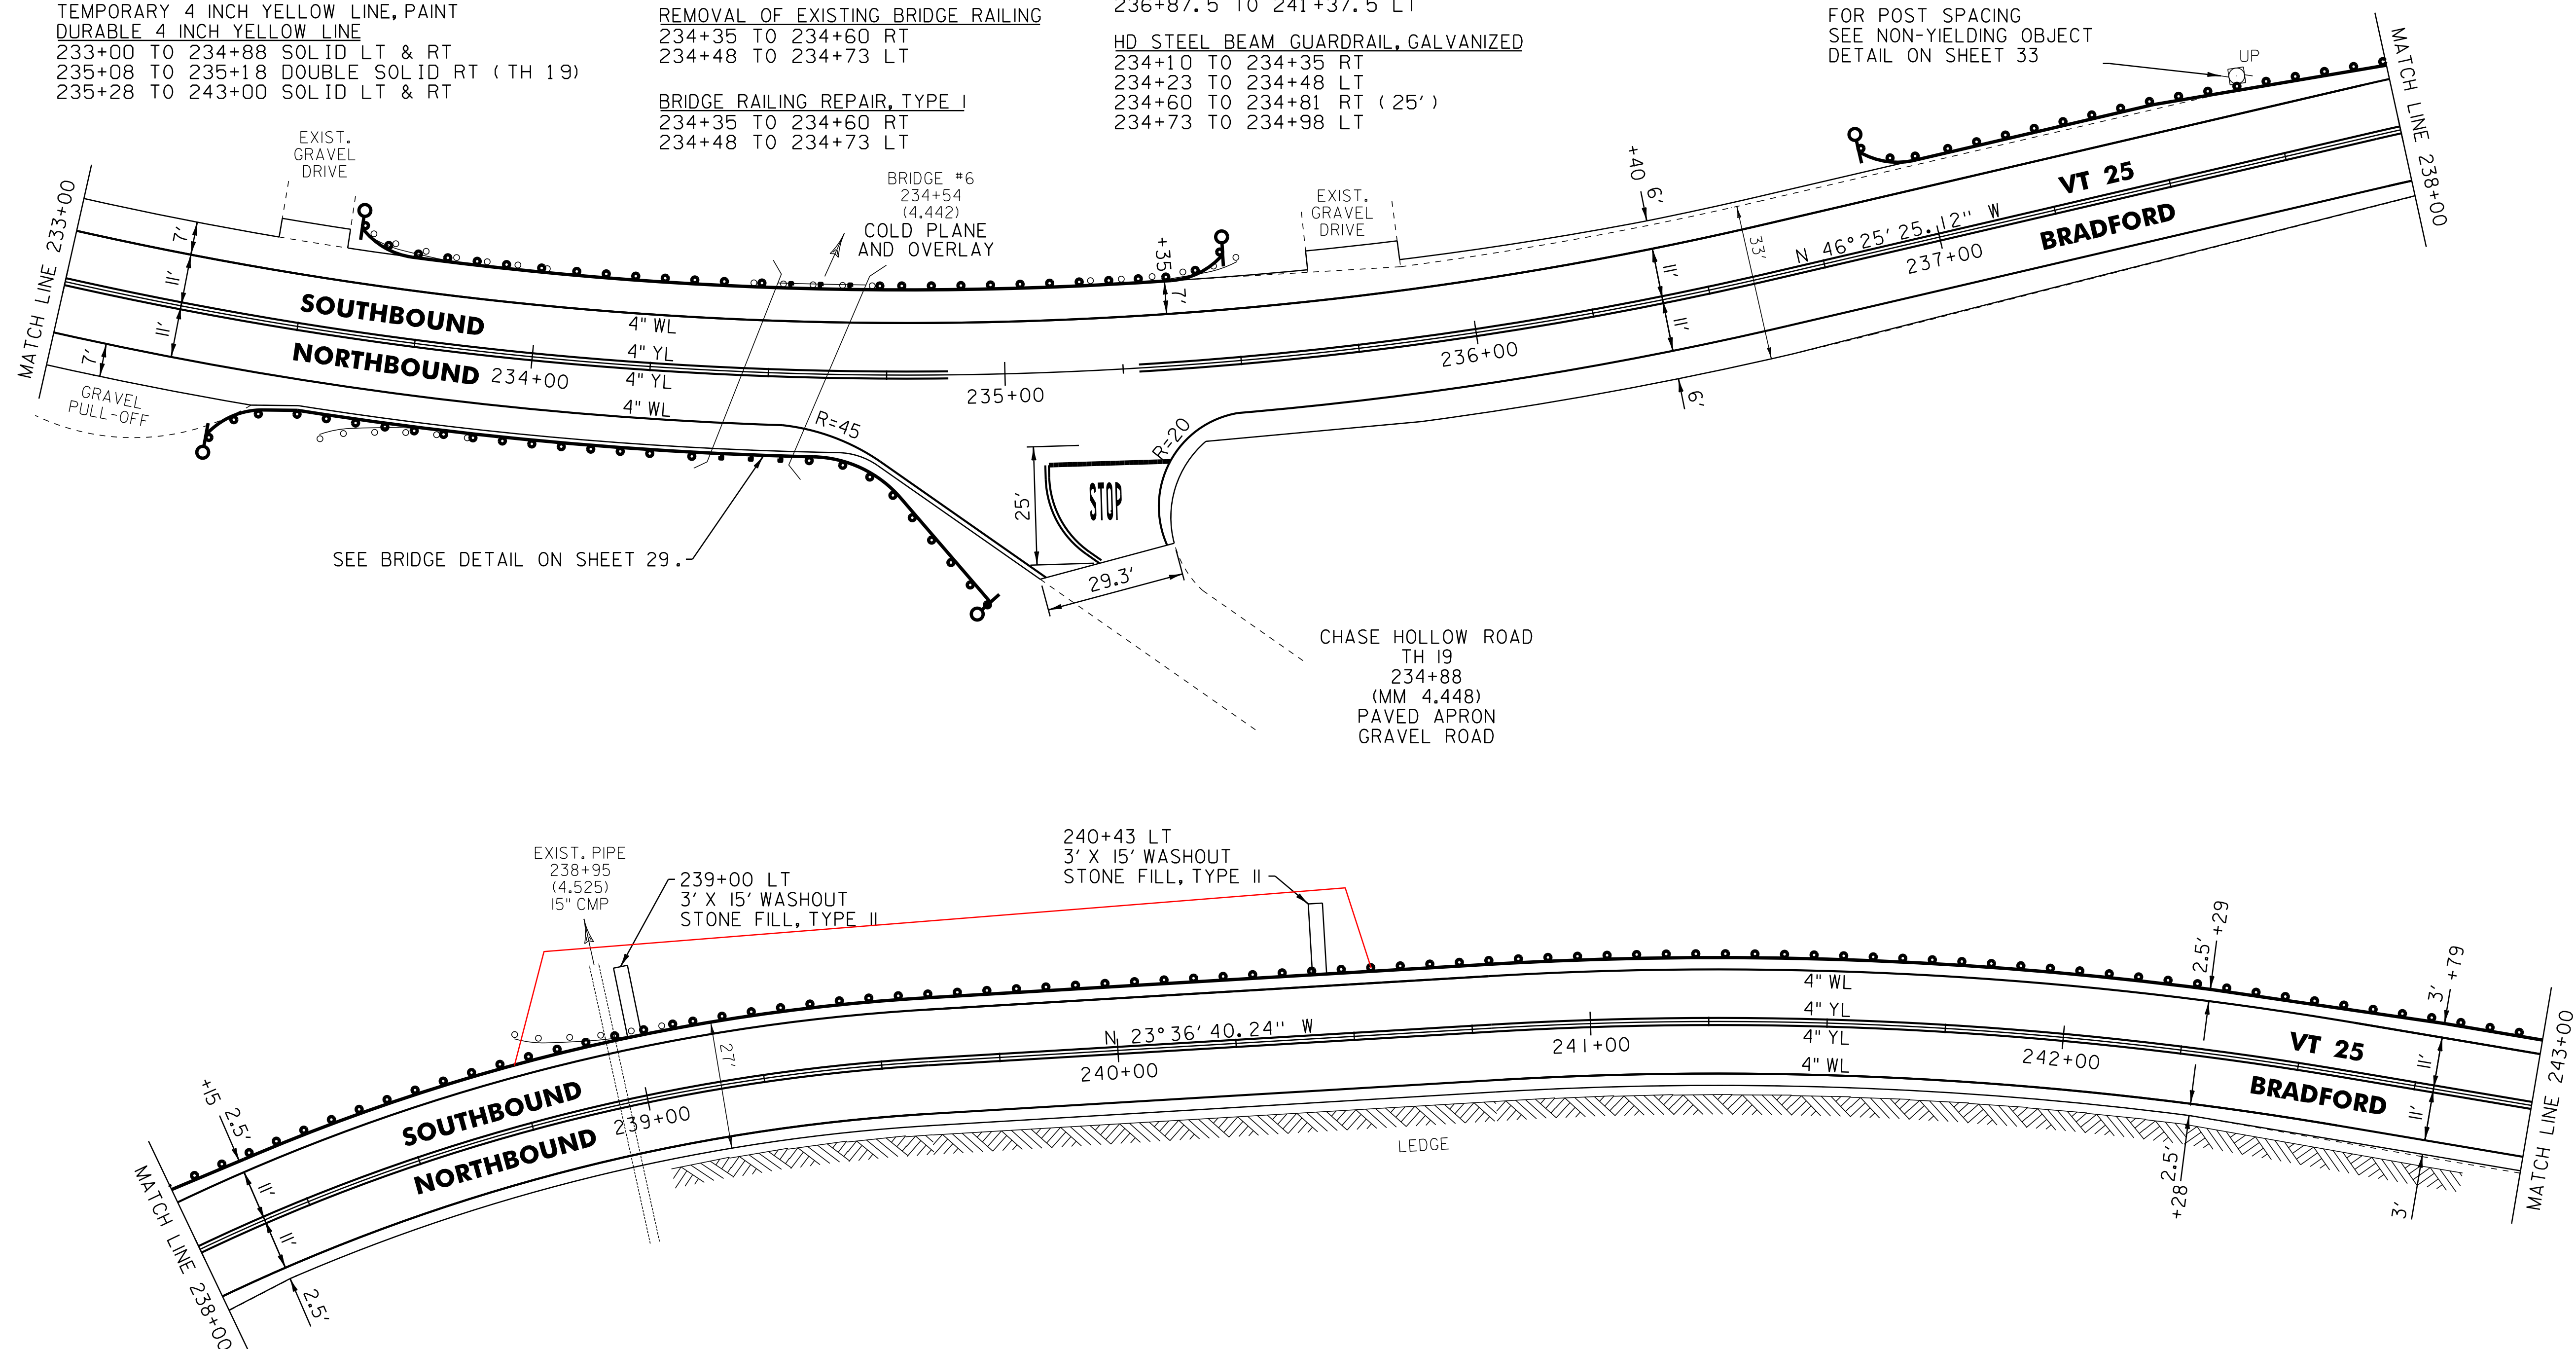

SEE BRIDGE DETAIL ON SHEET 29.

NOT TO SCALE

- LEGEND**
- R = REMOVE EXISTING
 - S = SALVAGED
 - R&S = REMOVE AND SALVAGE
 - N = NEW
 - RET = RETAIN
 - B-B = BACK TO BACK
 - = EXISTING GUARDRAIL
 - = PROPOSED GUARDRAIL
 - YL = YELLOW LINE
 - WL = WHITE LINE
 - = DELINEATOR
 - ||||| = RUMBLE STRIP

ROADWAY LAYOUT 28 VT 25

PROJECT NAME: BRADFORD	
PROJECT NUMBER: STP 2917(I)	
FILE NAME: p10b236.dgn	PLOT DATE: 03-SEP-2014 12:51
PROJECT LEADER: PTS	DRAWN BY: SNG
DESIGNED BY: NLL	CHECKED BY: PTS
IPARM FILE NAME: p10b236_69	SHEET 69 OF 105