
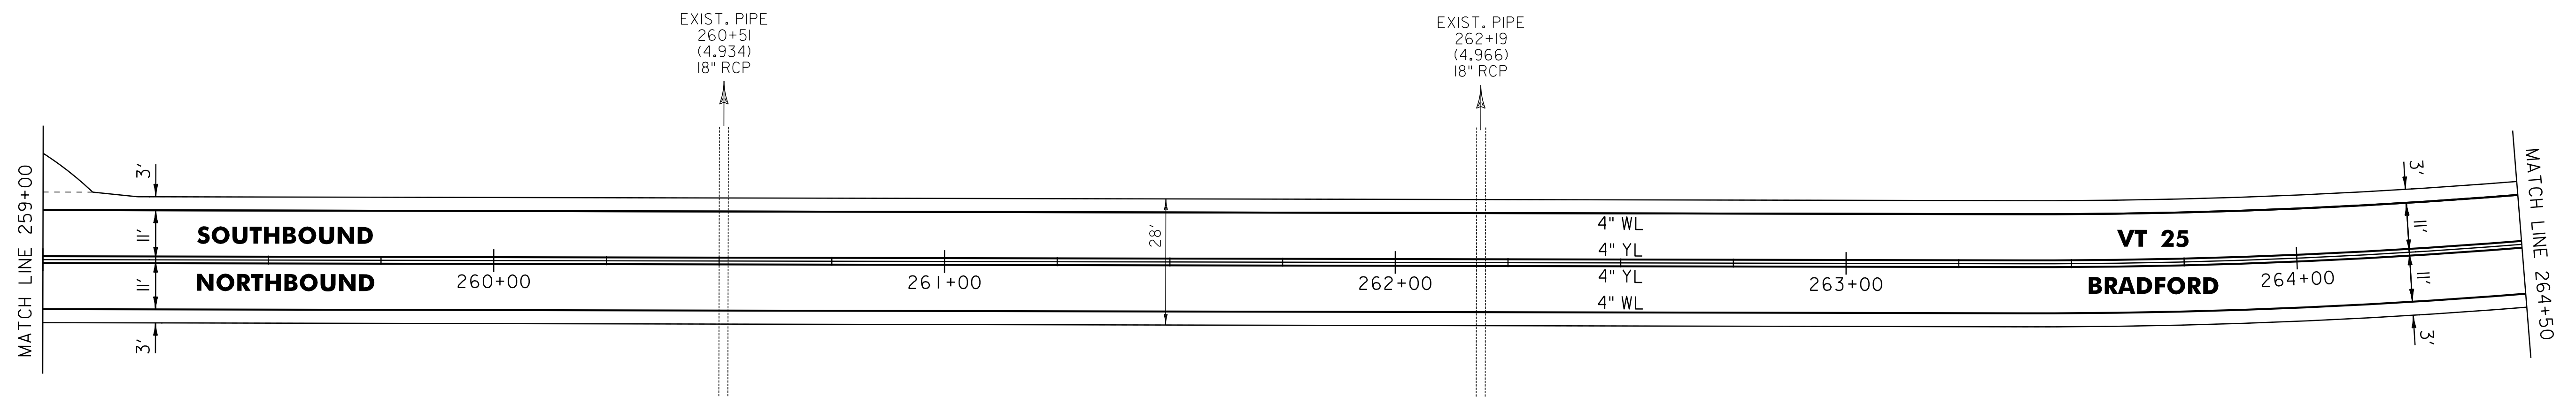


TEMPORARY 4 INCH WHITE LINE, PAINT  
 DURABLE 4 INCH WHITE LINE  
 253+50 TO 264+50 SOLID LT & RT

TEMPORARY 4 INCH YELLOW LINE, PAINT  
 DURABLE 4 INCH YELLOW LINE  
 253+50 TO 264+50 SOLID LT & RT

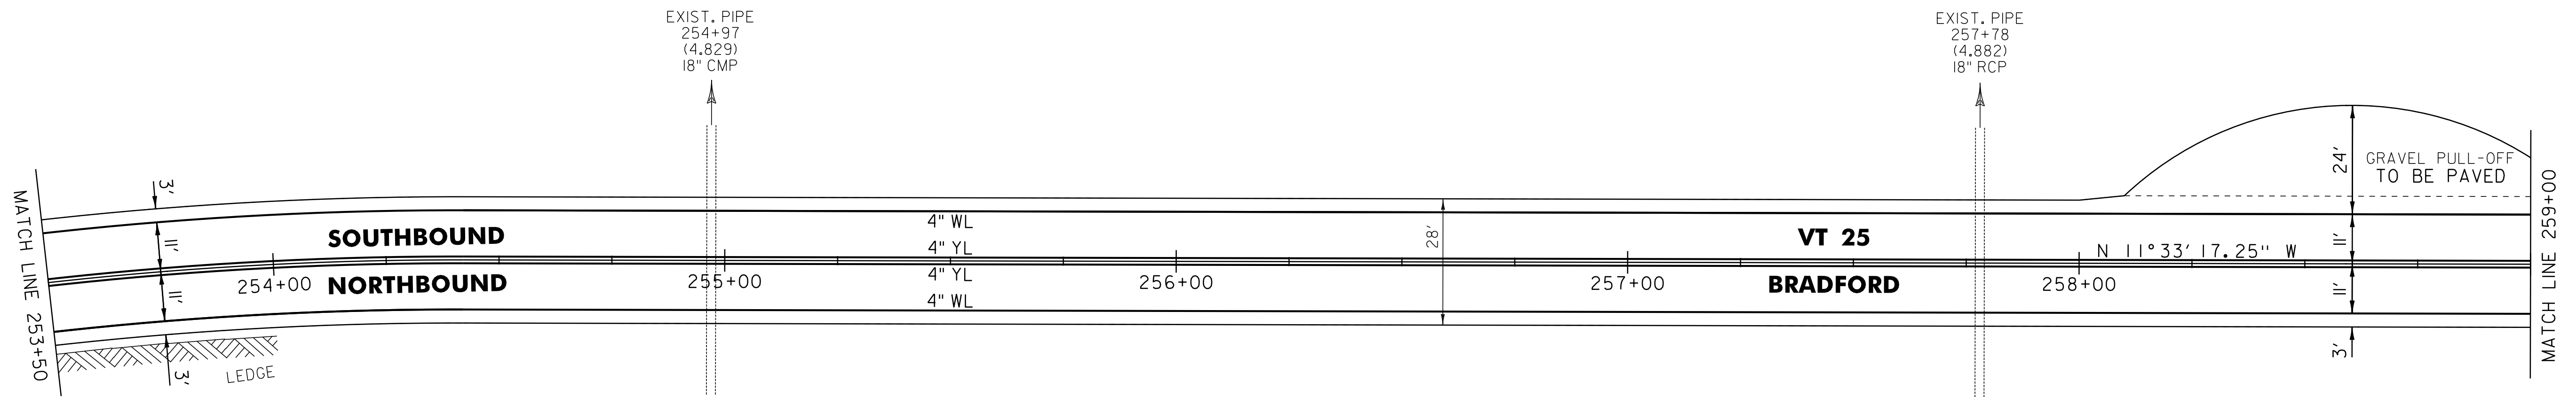

**LEGEND**

- R = REMOVE EXISTING
- S = SALVAGED
- R&S = REMOVE AND SALVAGE
- N = NEW
- RET = RETAIN
- B-B = BACK TO BACK
- = EXISTING GUARDRAIL
- = PROPOSED GUARDRAIL
- YL = YELLOW LINE
- WL = WHITE LINE
- = DELINEATOR
- ||||||| = RUMBLE STRIP

**ROADWAY LAYOUT 30 VT 25**

PROJECT NAME: BRADFORD	
PROJECT NUMBER: STP 2917(I)	
FILE NAME: p10b236.dgn	PLOT DATE: 03-SEP-2014 12:51
PROJECT LEADER: PTS	DRAWN BY: SNG
DESIGNED BY: NULL	CHECKED BY: PTS
IPARM FILE NAME: p10b236_71	SHEET 71 OF 105

NOT TO SCALE