

TEMPORARY 4 INCH WHITE LINE, PAINT  
 DURABLE 4 INCH WHITE LINE  
 B31+00 TO B36+00 SOLID LT & RT


TEMPORARY 4 INCH YELLOW LINE, PAINT  
 DURABLE 4 INCH YELLOW LINE  
 B31+00 TO B36+00 SOLID LT & RT

REHAB. DROP  
 INLETS, CATCH BASINS, OR MANHOLES,  
 CLASS I OR CLASS II  
 B33+59 LT (DI)

CHANGING ELEVATION  
 OF SEWER MANHOLES (NON-PART.)  
 B33+52 RT

ADJUST ELEVATION OF  
 VALVE BOX (NON-PART.)  
 B34+07 LT

REMOVING SIGNS  
 AS SHOWN - 2

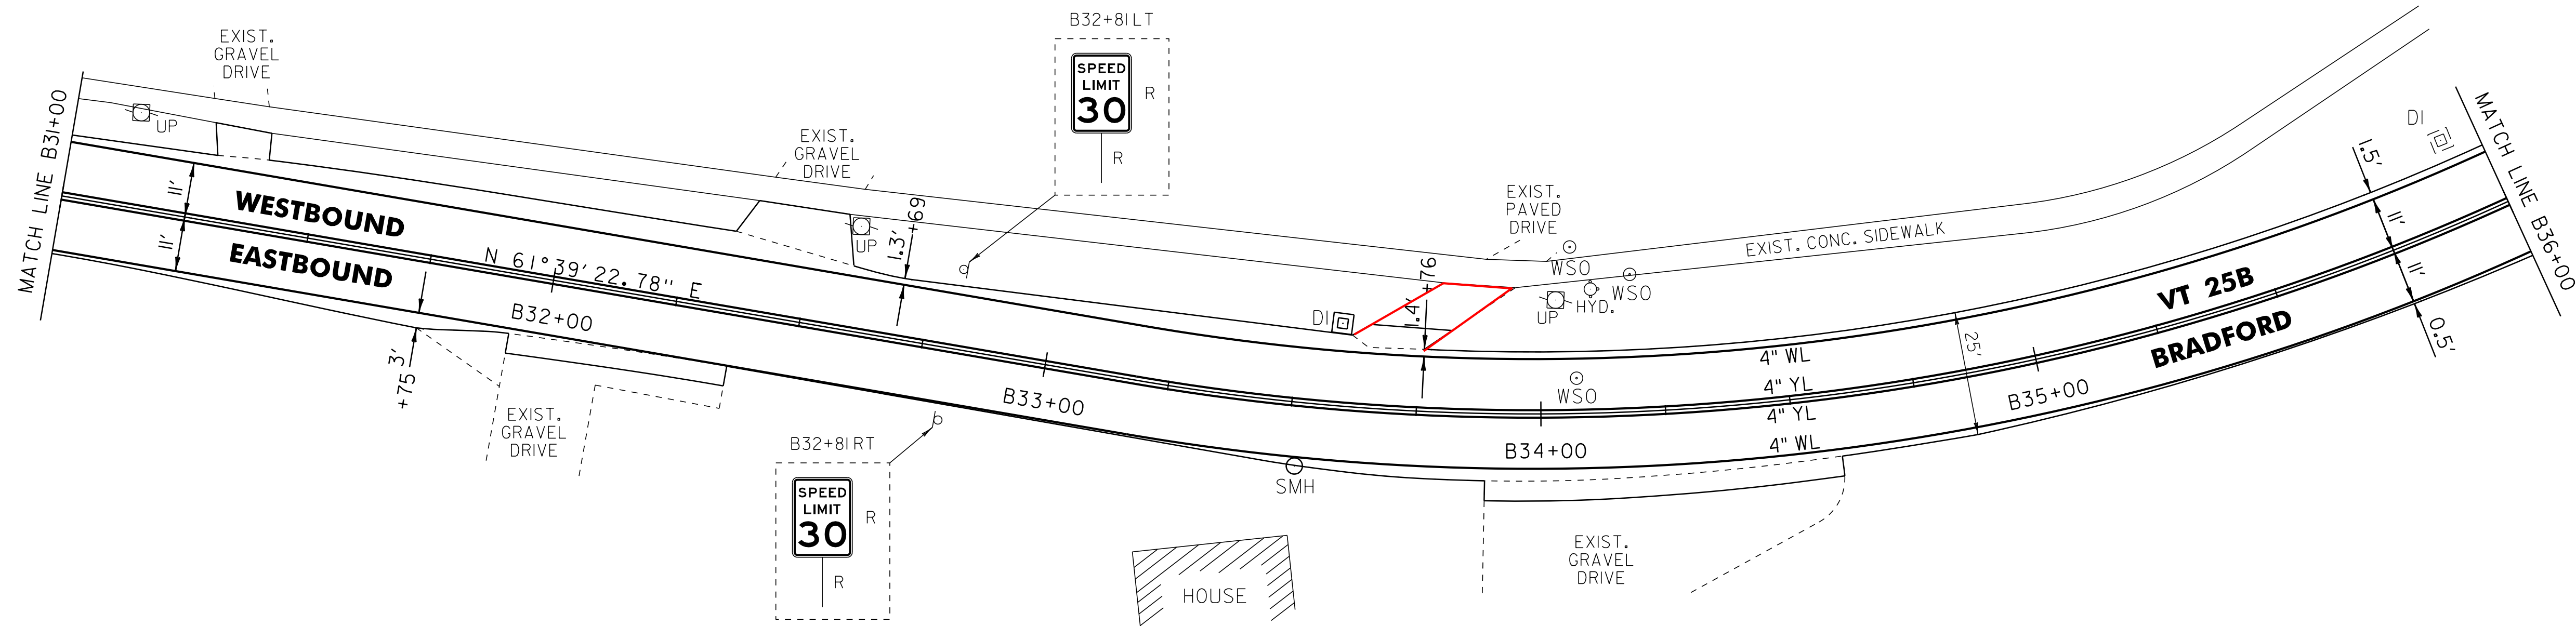

NOT TO SCALE

LEGEND

- R = REMOVE EXISTING
- S = SALVAGED
- R&S = REMOVE AND SALVAGE
- N = NEW
- RET = RETAIN
- B-B = BACK TO BACK
- = EXISTING GUARDRAIL
- = PROPOSED GUARDRAIL
- YL = YELLOW LINE
- WL = WHITE LINE
- = DELINEATOR
- ⊙ = PAVEMENT CORE

ROADWAY LAYOUT 7 VT 25B

PROJECT NAME: BRADFORD	PLOT DATE: 03-SEP-2014 12:51
PROJECT NUMBER: STP 2918(1)	DRAWN BY: SNG
FILE NAME: p10b236.dgn	CHECKED BY: PTS
PROJECT LEADER: PTS	SHEET 94 OF 105
DESIGNED BY: NULL	
IPARM FILE NAME: p10c238_94	