


**INDEX OF SHEETS**

SEE SHEET 2 OF 387

STATE OF VERMONT  
AGENCY OF TRANSPORTATION

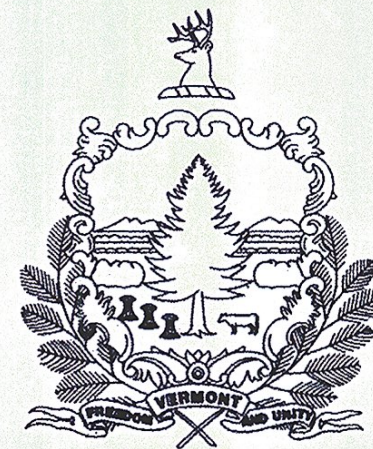

PROPOSED IMPROVEMENT  
TOWNS OF CAMBRIDGE, FLETCHER AND BAKERSFIELD  
COUNTIES OF LAMOILLE AND FRANKLIN  
VT ROUTE 108


**CAMBRIDGE-BAKERSFIELD**  
**STP 2926(1)**  
**VT ROUTE 108**

SEE SHEET 7 OF 387

**FLETCHER**  
**STP 027-1(22)**  
**VT ROUTE 108**

SEE SHEET 349 OF 387

**CAMBRIDGE-BAKERSFIELD**  
**AND FLETCHER**  
**STP 2926(1) AND**  
**STP 027-1(22)**

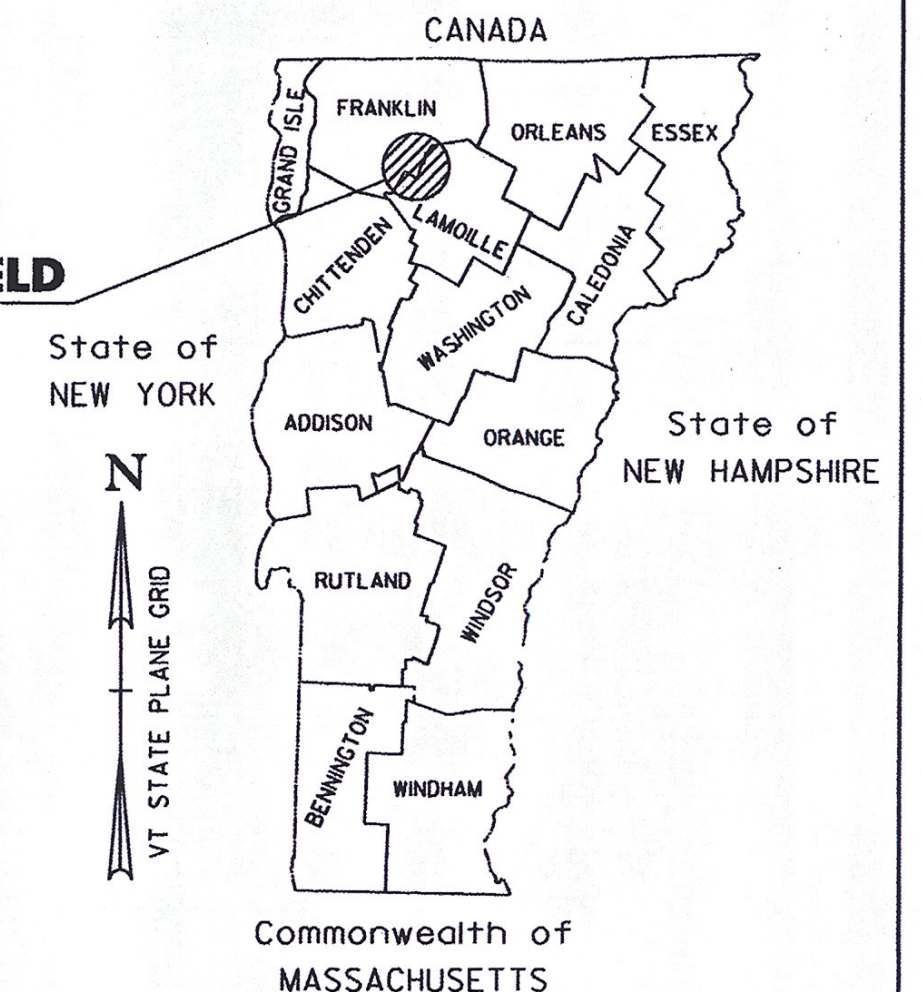

RECORD PLANS

CONTRACTOR: FRANK W. WHITCOMB CONSTRUCTION, CO. - WALPOLE, NH

RESIDENT ENGINEER: DELVIN WARNER

CONSTRUCTION BEGAN: APRIL 15<sup>TH</sup>, 2013



CONSTRUCTION COMPLETE: JULY 2<sup>ND</sup>, 2014

RECORD PLANS BY: DELVIN WARNER & P. BANNERMAN

I HEREBY CERTIFY THAT ALL THE CONSTRUCTION REQUIRED BY THIS SET OF DRAWINGS HAS BEEN ACCOMPLISHED AS INDICATED HEREIN.

BY *Delvin Warner* RESIDENT ENGINEER  
DATE 04/05/2015

NOTE: Any further information concerning final quantities, amounts or other details relative to this project may be found at Central Files in the electronic archives.

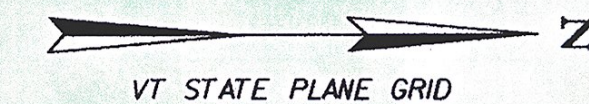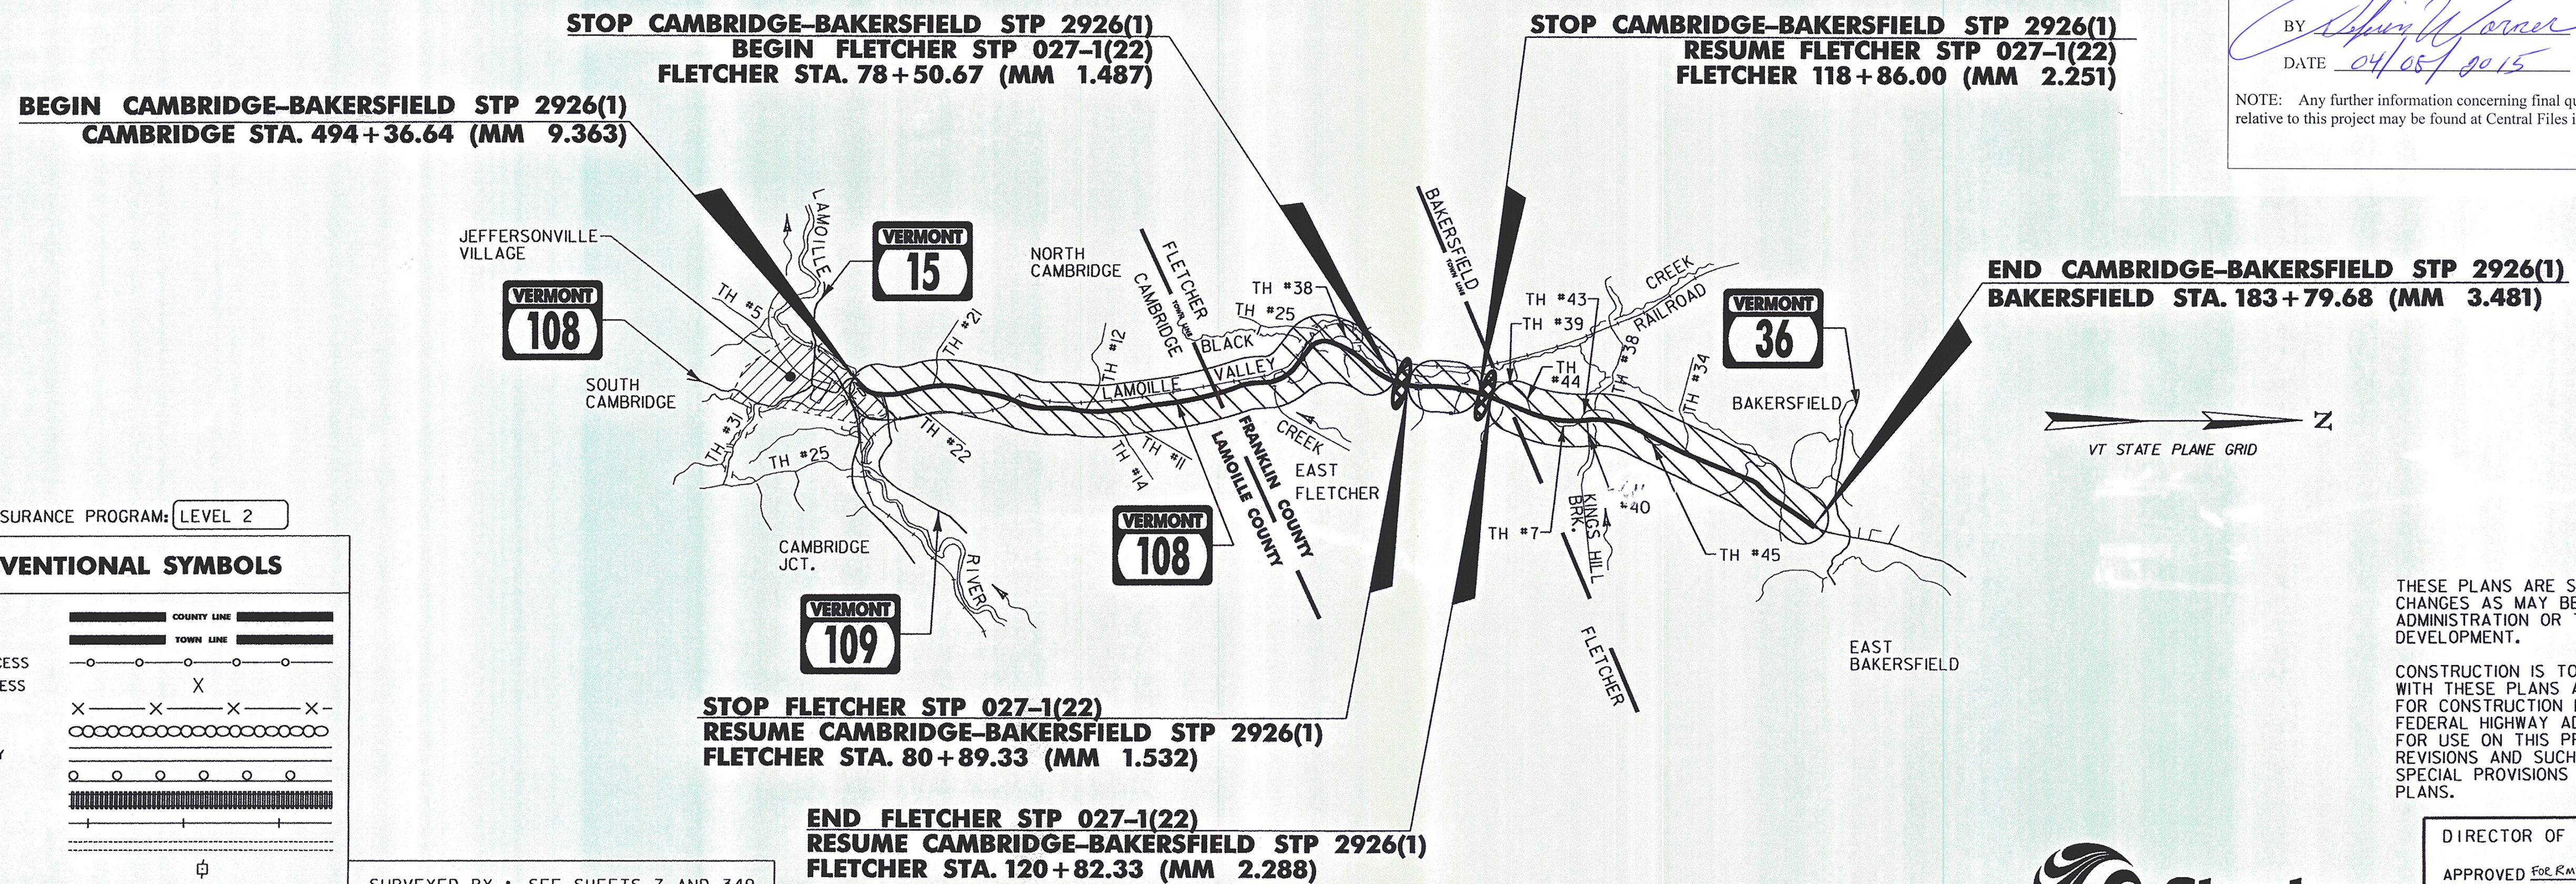

QUALITY ASSURANCE PROGRAM: LEVEL 2

**CONVENTIONAL SYMBOLS**

COUNTY LINE	
TOWN LINE	
LIMITS OF ACCESS	
POINT OF ACCESS	
FENCE LINE	
STONE WALL	
TRAVELED WAY	
GUARDRAIL	
RAILROAD	
SURVEY LINE	
CULVERT	
UTILITY POLE	
TREES	
CONTROL OF ACCESS	
PROPERTY LINE	
R.O.W. TAKING LINE	
SLOPE RIGHTS	
TOP OF CUT	
TOE OF SLOPE	

SURVEYED BY : SEE SHEETS 7 AND 349  
SURVEYED DATE : SEE SHEETS 7 AND 349

DATUM  
VERTICAL SEE SHEETS 7 AND 349  
HORIZONTAL SEE SHEETS 7 AND 349

THESE PLANS ARE SUBJECT TO SUCH ENGINEERING CHANGES AS MAY BE REQUIRED BY THE FEDERAL HIGHWAY ADMINISTRATION OR THE DIRECTOR OF PROGRAM DEVELOPMENT.

CONSTRUCTION IS TO BE CARRIED ON IN ACCORDANCE WITH THESE PLANS AND THE STANDARD SPECIFICATIONS FOR CONSTRUCTION DATED 2011, AS APPROVED BY THE FEDERAL HIGHWAY ADMINISTRATION ON JULY 20, 2011 FOR USE ON THIS PROJECT, INCLUDING ALL SUBSEQUENT REVISIONS AND SUCH REVISED SPECIFICATIONS AND SPECIAL PROVISIONS AS ARE INCORPORATED IN THESE PLANS.



DIRECTOR OF PROGRAM DEVELOPMENT	
APPROVED FOR RMT <i>Michael Hedges</i> DATE 11/19/12	
PROJECT MANAGER : MICHAEL FOWLER	
PROJECT NAME : CAMBRIDGE-BAKERSFIELD AND FLETCHER	
PROJECT NUMBER : STP 2926 (1) AND STP 027-1 (22)	
SHEET 1 OF 387 SHEETS	