

**STONE FILL, TYPE 1**  
 STA. 513+50 TO 514+35, LT  
 STA. 514+35 TO 516+11, RT  
 STA. 514+79 TO 515+00, LT  
 STA. 518+25 TO 518+50, RT

**DURABLE 4 INCH WHITE LINE**  
 (ALL LINES WILL INCLUDE EDGE LINE BREAKS AND RADII FOR SIDE ROADS)  
 STA. 513+50 TO 518+50, SOLID LT & RT

**DURABLE 4 INCH YELLOW LINE**  
 (ALL LINES WILL INCLUDE  $\phi$  BREAKS FOR SIDE ROADS)  
 STA. 513+50 TO 518+50, SOLID LT & RT

**TEMPORARY 4 INCH WHITE LINE, PAINT**  
 (ALL LINES WILL INCLUDE EDGE LINE BREAKS AND RADII FOR SIDE ROADS)  
 STA. 513+50 TO 518+50, SOLID LT & RT

**TEMPORARY 4 INCH YELLOW LINE, PAINT**  
 (ALL LINES WILL INCLUDE  $\phi$  BREAKS FOR SIDE ROADS)  
 STA. 513+50 TO 518+50, SOLID LT & RT



**GEOTEXTILE UNDER STONE FILL**  
 STA. 513+50 TO 514+25, LT  
 STA. 514+25 TO 516+25, RT  
 STA. 514+75 TO 515+25, LT  
 STA. 518+25 TO 518+50, RT

**GRUBBING MATERIAL**  
 STA. 513+50 TO 514+25, LT  
 STA. 514+25 TO 516+25, RT  
 STA. 514+75 TO 515+25, LT  
 STA. 518+25 TO 518+50, RT

**BARRIER FENCE**  
 STA. 513+50 TO 518+50, RT  
 (WITH BREAKS FOR DRIVES AND SIDEROADS)

**REMOVING SIGNS**  
 AS SHOWN - 1

UD-3 STA 515+00 TO 518+50, LT  
 CONSTRUCT 6 INCH UNDERDRAIN PIPE,  
 SEE SHEET 18 FOR DETAIL AND  
 ASSOCIATED QUANTITIES.

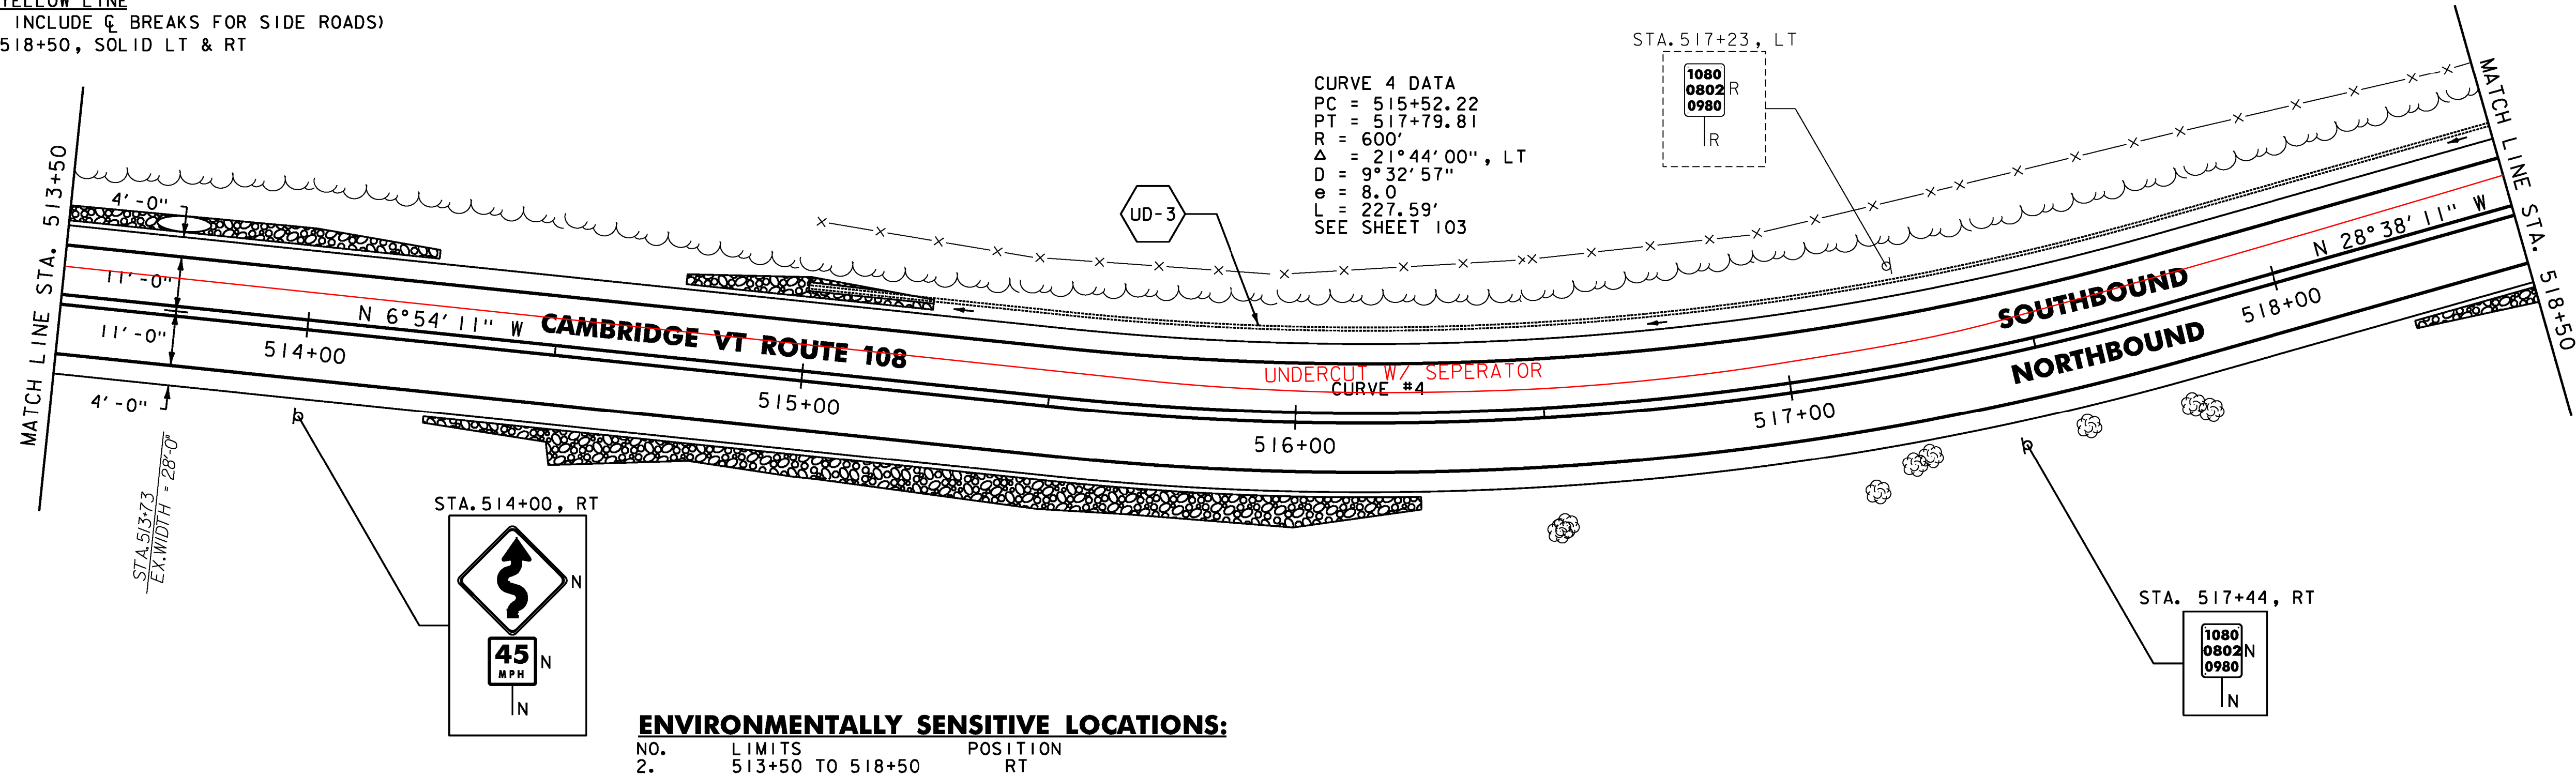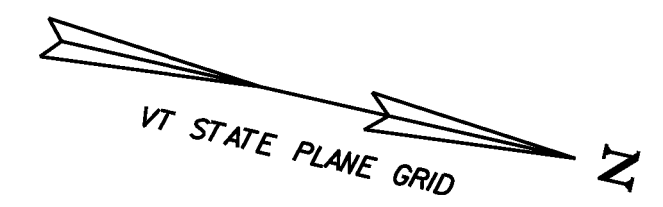

**ENVIRONMENTALLY SENSITIVE LOCATIONS:**

NO.	LIMITS	POSITION
2.	513+50 TO 518+50	RT

**REHAB. DIS. CBS OR MHS. CLASS 1**  
 STA. 520+15, RT "DI"

**STONE FILL, TYPE 1**  
 STA. 518+50 TO 519+08, RT  
 STA. 519+08 TO 522+00, LT  
 STA. 522+25 TO 523+00, RT

**DURABLE 4 INCH WHITE LINE**  
 (ALL LINES WILL INCLUDE EDGE LINE BREAKS AND RADII FOR SIDE ROADS)  
 STA. 518+50 TO 523+00, SOLID LT & RT

**DURABLE 4 INCH YELLOW LINE**  
 (ALL LINES WILL INCLUDE  $\phi$  BREAKS FOR SIDE ROADS)  
 STA. 518+50 TO 523+00, SOLID LT & RT

**TEMPORARY 4 INCH WHITE LINE, PAINT**  
 (ALL LINES WILL INCLUDE EDGE LINE BREAKS AND RADII FOR SIDE ROADS)  
 STA. 518+50 TO 523+00, SOLID LT & RT



**TEMPORARY 4 INCH YELLOW LINE, PAINT**  
 (ALL LINES WILL INCLUDE  $\phi$  BREAKS FOR SIDE ROADS)  
 STA. 518+50 TO 523+00, SOLID LT & RT

**GEOTEXTILE UNDER STONE FILL**  
 STA. 518+50 TO 518+75, RT  
 STA. 519+25 TO 522+25, LT  
 STA. 522+75 TO 523+00, RT

**GRUBBING MATERIAL**  
 STA. 518+50 TO 518+75, RT  
 STA. 519+25 TO 522+25, LT  
 STA. 522+75 TO 523+00, RT

**BARRIER FENCE**  
 STA. 518+50 TO 520+00, RT  
 (WITH BREAKS FOR DRIVES AND SIDEROADS)

UD-4 STA 522+00 TO 526+53, LT  
 CONSTRUCT 6 INCH UNDERDRAIN PIPE,  
 SEE SHEET 18 FOR DETAIL AND  
 ASSOCIATED QUANTITIES.

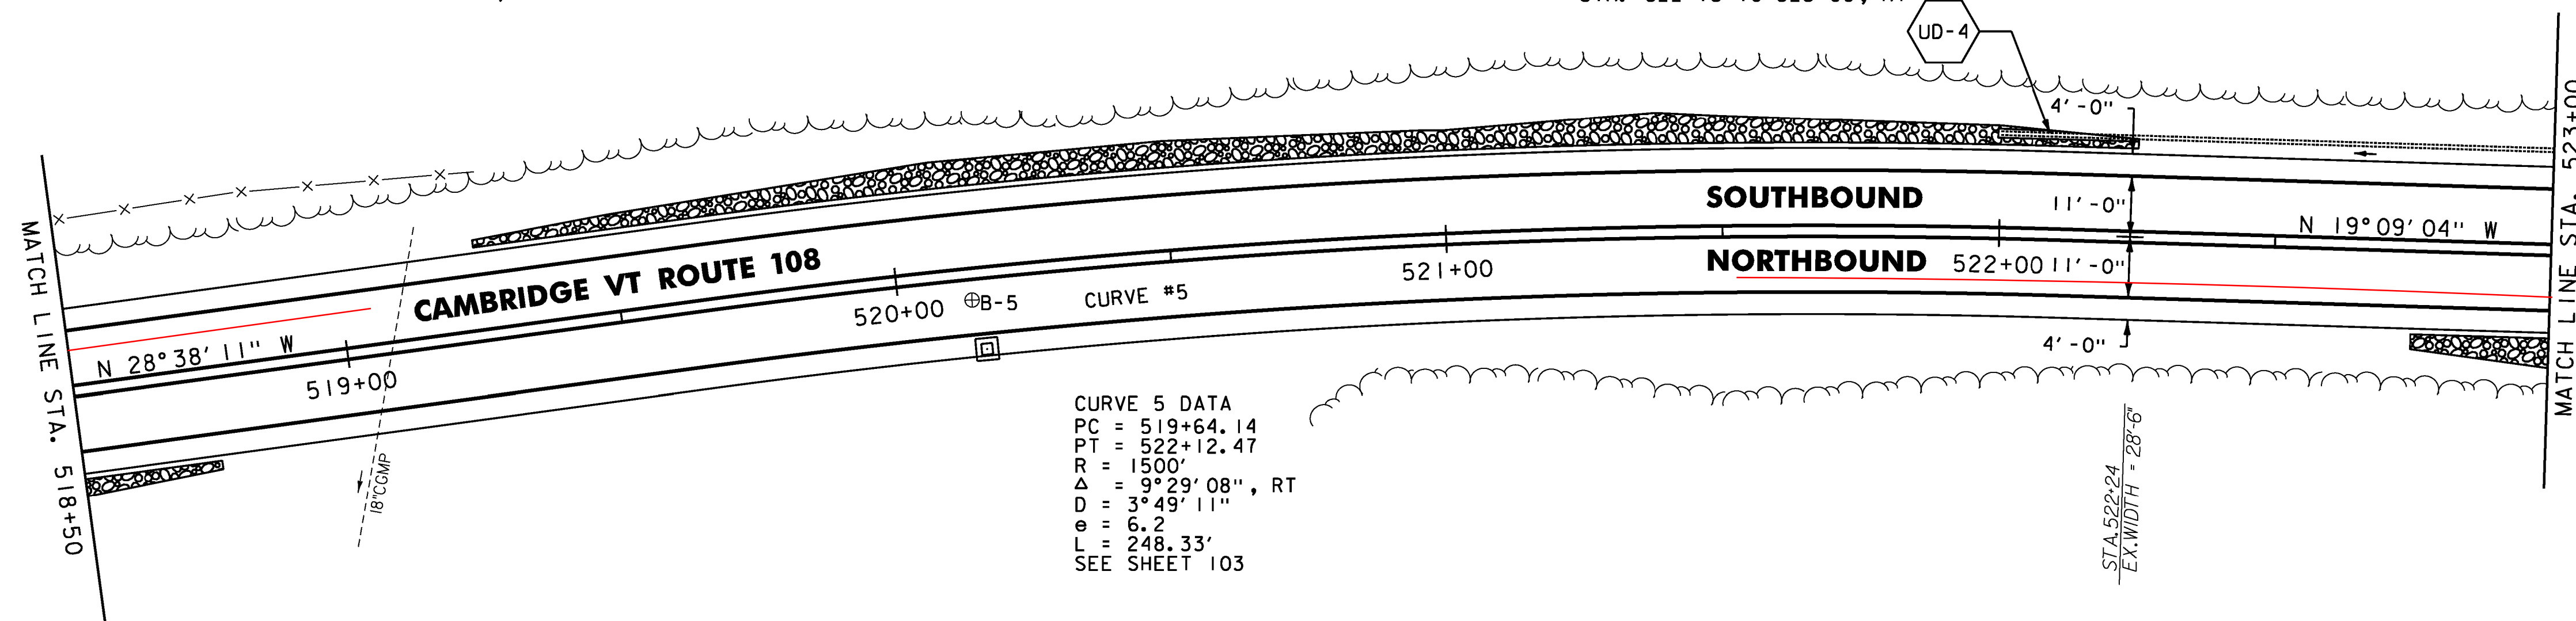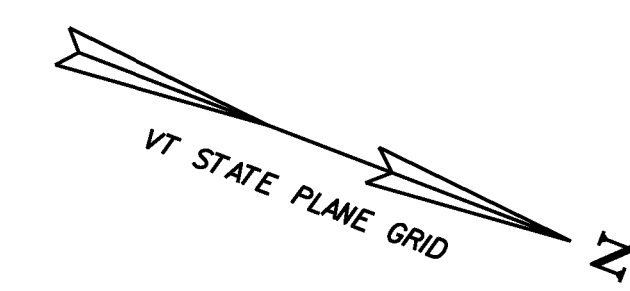

**CURVE 5 DATA**  
 PC = 519+64.14  
 PT = 522+12.47  
 R = 1500'  
 Δ = 9°29'08", RT  
 D = 3°49'11"  
 e = 6.2  
 L = 248.33'  
 SEE SHEET 103

**NOTES:**

- FOR LEGENDS, SEE SHEET 27.
- ALL EXISTING SIGNS NOT SHOWN SHALL BE RETAINED.
- DURABLE MARKINGS DETAILED ON THIS SHEET ARE OPTION BID ITEMS. SEE SHEET 14.

**ENVIRONMENTALLY SENSITIVE LOCATIONS:**

NO.	LIMITS	POSITION
2.	518+50 TO 520+00	RT

SOIL BORING DATA			
BORING#	DEPTH (FT.)	PCC	COMMENTS
B-5	3.0'	NO	LEDGE @ 3.0'



NOT TO SCALE

**PROJECT LAYOUT SHEET #4**

PROJECT NAME: CAMBRIDGE-BAKERSFIELD  
 PROJECT NUMBER: STP 2926(I)

FILE NAME: pl0b258.dgn  
 PROJECT LEADER: JLL  
 DESIGNED BY: STANTEC  
 IPARM FILE: p10b258104.i

PLOT DATE: 11/15/2012  
 DRAWN BY: STANTEC  
 CHECKED BY: STANTEC  
 SHEET 30 OF 387