

STONE FILL, TYPE I
STA. 584+25 TO 586+50, RT

DURABLE 4 INCH WHITE LINE
(ALL LINES WILL INCLUDE EDGE LINE BREAKS AND RADII FOR SIDE ROADS)
STA. 581+50 TO 586+50, SOLID LT & RT

TEMPORARY 4 INCH WHITE LINE, PAINT
(ALL LINES WILL INCLUDE EDGE LINE BREAKS AND RADII FOR SIDE ROADS)
STA. 581+50 TO 586+50, SOLID LT & RT



GEOTEXTILE UNDER STONE FILL
STA. 584+25 TO 586+50, RT

BARRIER FENCE
STA. 581+50 TO 586+50, LT
(WITH BREAKS FOR DRIVES AND SIDEROADS)

GRUBBING MATERIAL
STA. 584+25 TO 586+50, RT

DURABLE 4 INCH YELLOW LINE
(ALL LINES WILL INCLUDE Q BREAKS FOR SIDE ROADS)
STA. 581+50 TO 586+50, SOLID LT & RT

TEMPORARY 4 INCH YELLOW LINE, PAINT
(ALL LINES WILL INCLUDE Q BREAKS FOR SIDE ROADS)
STA. 581+50 TO 586+50, SOLID LT & RT

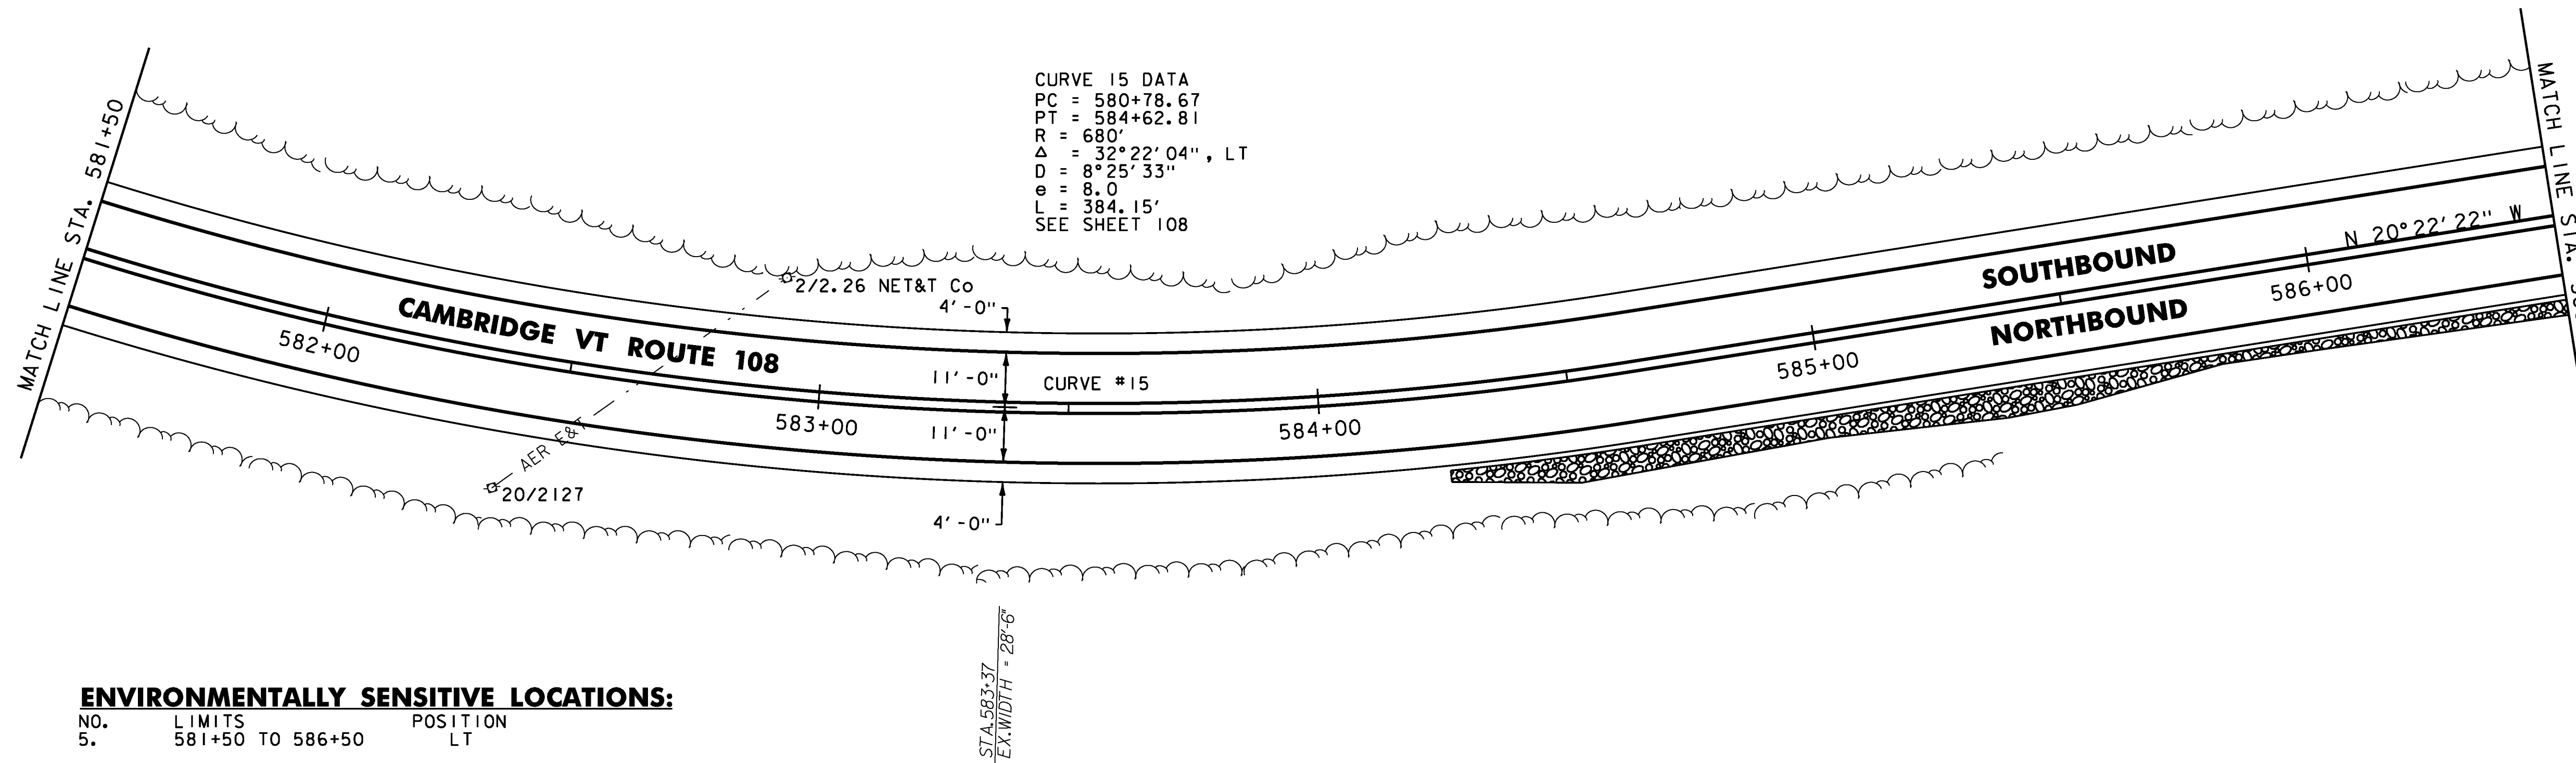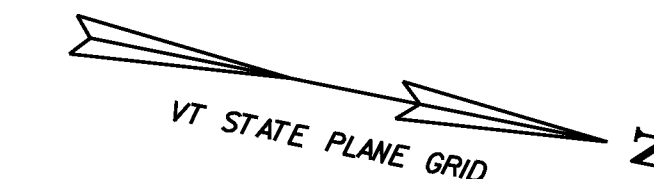

CURVE 15 DATA
PC = 580+78.67
PT = 584+62.81
R = 680'
 $\Delta = 32^{\circ}22'04''$, LT
D = 8°25'33"
e = 8.0
L = 384.15'
SEE SHEET 108

ENVIRONMENTALLY SENSITIVE LOCATIONS:

NO.	LIMITS	POSITION
5.	581+50 TO 586+50	LT

STONE FILL, TYPE I
STA. 586+50 TO 587+25, RT
STA. 587+75 TO 589+70, LT

TEMPORARY 4 INCH WHITE LINE, PAINT
(ALL LINES WILL INCLUDE EDGE LINE BREAKS AND RADII FOR SIDE ROADS)
STA. 586+50 TO 591+50, SOLID LT & RT

GEOTEXTILE UNDER STONE FILL
STA. 586+50 TO 587+25, RT
STA. 587+75 TO 589+70, LT

BARRIER FENCE
STA. 586+50 TO 591+50, LT
(WITH BREAKS FOR DRIVES AND SIDEROADS)



REMOVING SIGNS
AS SHOWN - 1

DURABLE 4 INCH WHITE LINE
(ALL LINES WILL INCLUDE EDGE LINE BREAKS AND RADII FOR SIDE ROADS)
STA. 586+50 TO 591+50, SOLID LT & RT

TEMPORARY 4 INCH YELLOW LINE, PAINT
(ALL LINES WILL INCLUDE Q BREAKS FOR SIDE ROADS)
STA. 586+50 TO 591+50, SOLID LT & RT

GRUBBING MATERIAL
STA. 586+50 TO 587+25, RT
STA. 587+75 TO 589+70, LT

DURABLE 4 INCH YELLOW LINE
(ALL LINES WILL INCLUDE Q BREAKS FOR SIDE ROADS)
STA. 586+50 TO 591+50, SOLID LT & RT

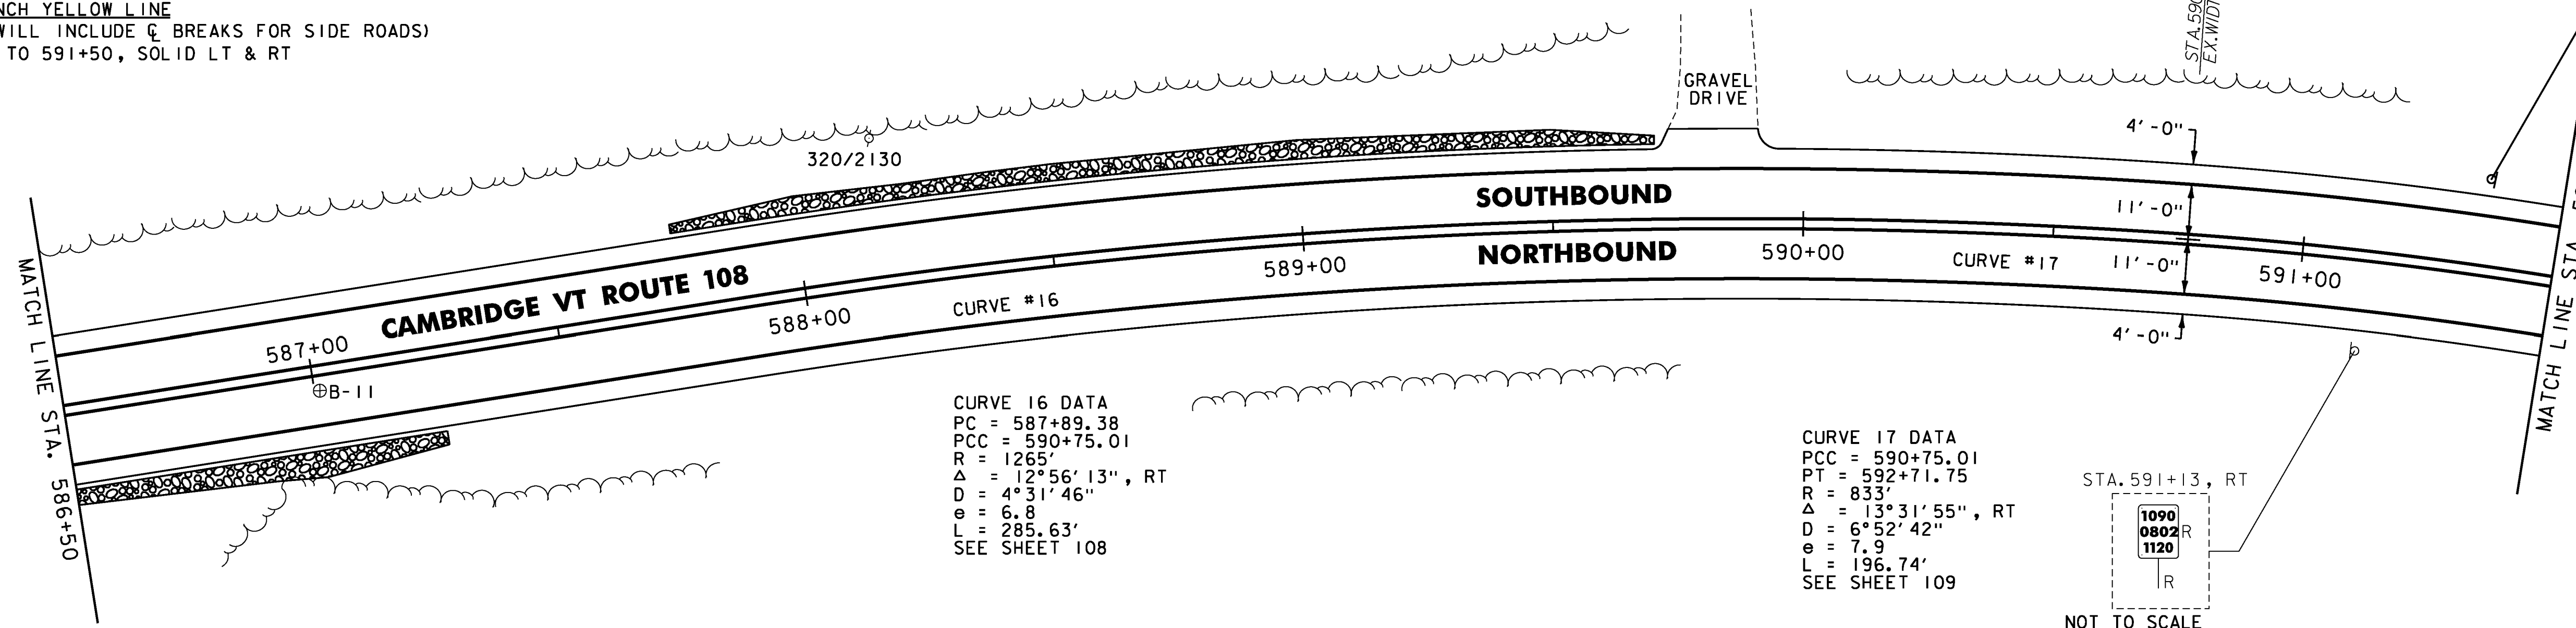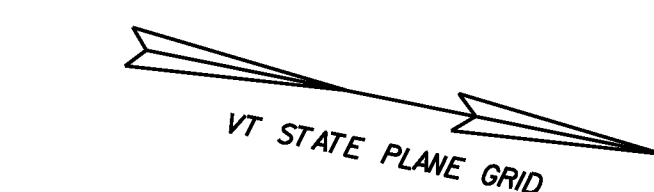

CURVE 16 DATA
PC = 587+89.38
PCC = 590+75.01
R = 1265'
 $\Delta = 12^{\circ}56'13''$, RT
D = 4°31'46"
e = 6.8
L = 285.63'
SEE SHEET 108

CURVE 17 DATA
PCC = 590+75.01
PT = 592+71.75
R = 833'
 $\Delta = 13^{\circ}31'55''$, RT
D = 6°52'42"
e = 7.9
L = 196.74'
SEE SHEET 109

ENVIRONMENTALLY SENSITIVE LOCATIONS:

NO.	LIMITS	POSITION
5.	586+50 TO 591+50	LT

SOIL BORING DATA			
BORING #	DEPTH (FT.)	PCC	COMMENTS
B-II	5.0'	NO	

NOTES:

- FOR LEGENDS, SEE SHEET 27.
- ALL EXISTING SIGNS NOT SHOWN SHALL BE RETAINED.
- DURABLE MARKINGS DETAILED ON THIS SHEET ARE OPTION BID ITEMS. SEE SHEET 14.



PROJECT LAYOUT SHEET #11

PROJECT NAME: CAMBRIDGE-BAKERSFIELD
PROJECT NUMBER: STP 2926(1)

FILE NAME: p10b258.dgn
PROJECT LEADER: JLL
DESIGNED BY: STANTEC
IPARM FILE: p10b258(1).i

PLOT DATE: 11/15/2012
DRAWN BY: STANTEC
CHECKED BY: STANTEC
SHEET 37 OF 387