

**STONE FILL, TYPE I**  
 STA. 612+25 TO 612+75, LT  
 STA. 613+87 TO 616+50, LT  
 STA. 614+75 TO 615+75, RT

**TEMPORARY 4 INCH WHITE LINE, PAINT**  
 (ALL LINES WILL INCLUDE EDGE LINE BREAKS AND RADII FOR SIDE ROADS)  
 STA. 611+50 TO 616+50, SOLID LT & RT

**TEMPORARY 4 INCH YELLOW LINE, PAINT**  
 (ALL LINES WILL INCLUDE  $\phi$  BREAKS FOR SIDE ROADS)  
 STA. 611+50 TO 616+50, SOLID LT & RT

**GEOTEXTILE UNDER STONE FILL**  
 STA. 612+25 TO 612+75, LT  
 STA. 613+75 TO 616+50, LT



**BARRIER FENCE**  
 STA. 611+50 TO 616+50, LT  
 (WITH BREAKS FOR DRIVES AND SIDEROADS)

**DURABLE 4 INCH WHITE LINE**  
 (ALL LINES WILL INCLUDE EDGE LINE BREAKS AND RADII FOR SIDE ROADS)  
 STA. 611+50 TO 616+50, SOLID LT & RT

**DURABLE 4 INCH YELLOW LINE**  
 (ALL LINES WILL INCLUDE  $\phi$  BREAKS FOR SIDE ROADS)  
 STA. 611+50 TO 616+50, SOLID LT & RT

**GRUBBING MATERIAL**  
 STA. 612+25 TO 612+75, LT  
 STA. 613+75 TO 616+50, LT

**REMOVING SIGNS**  
 AS SHOWN - 2

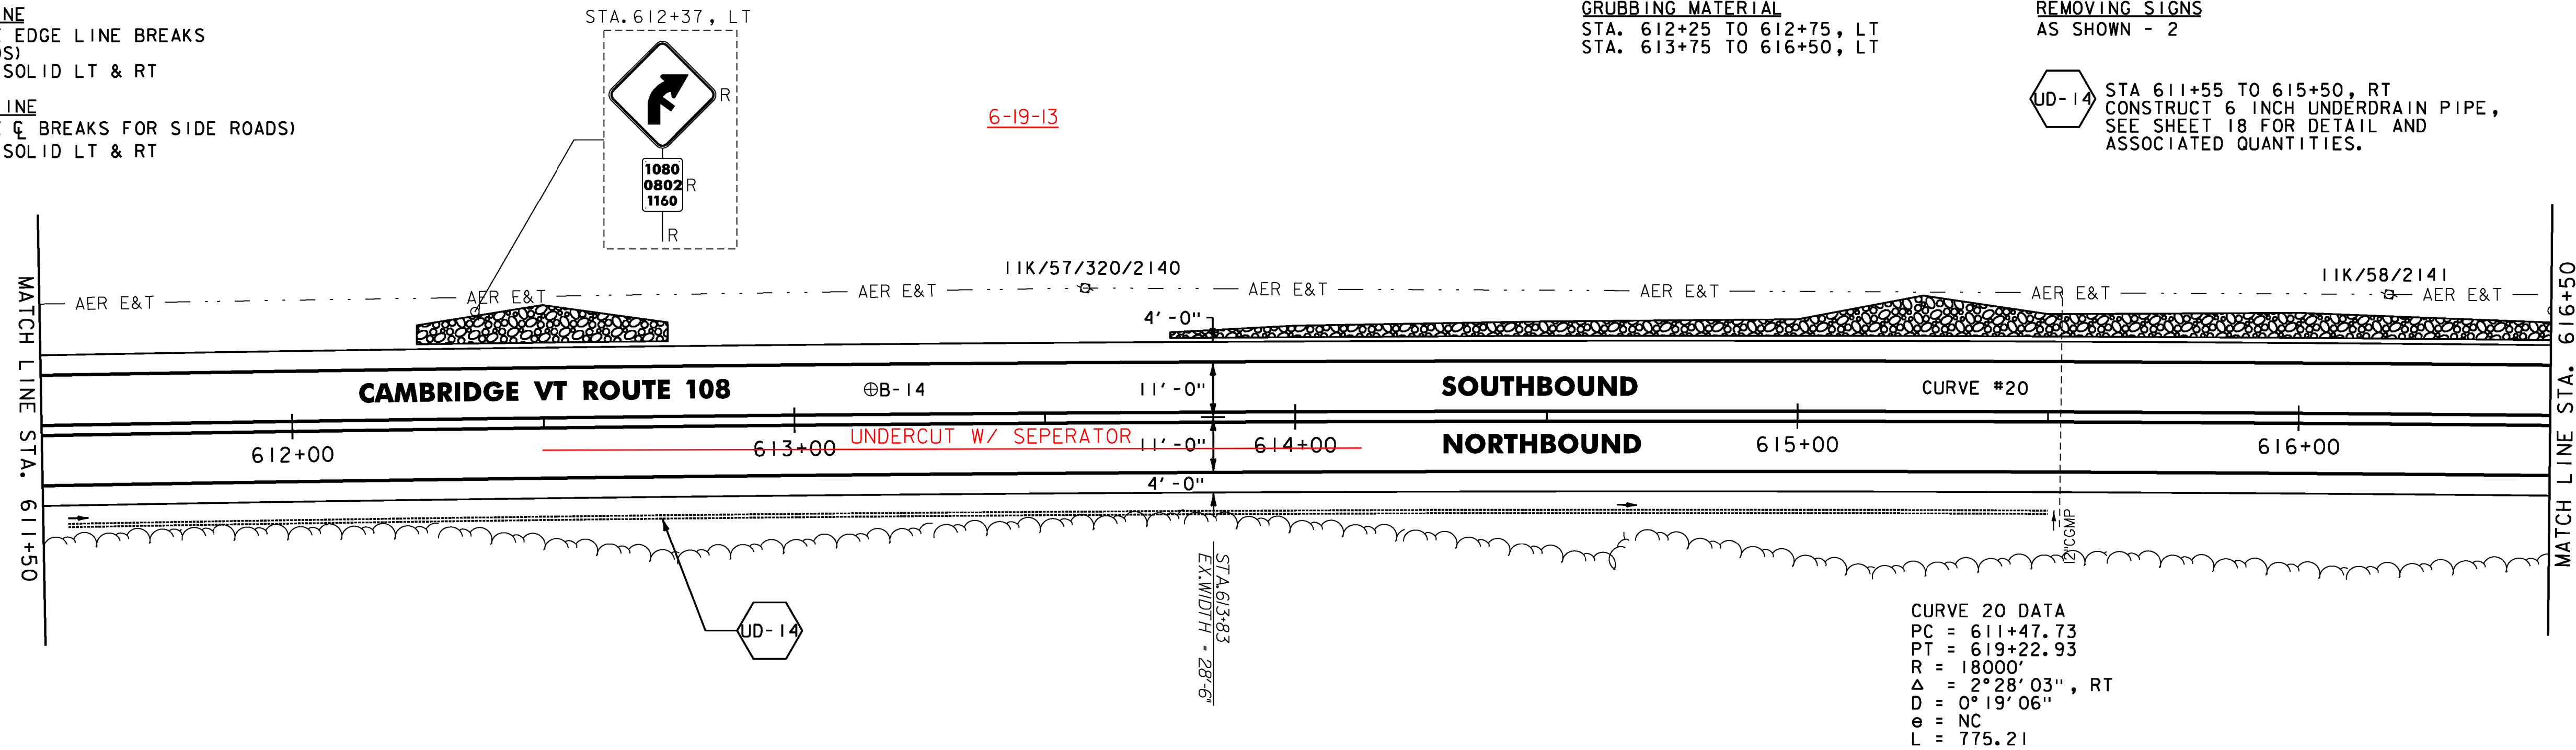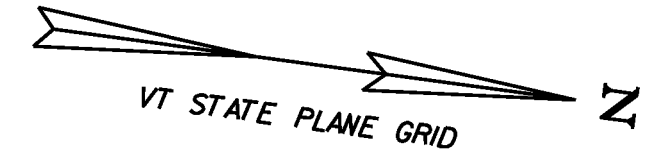

SOIL BORING DATA			
BORING#	DEPTH (FT.)	PCC	COMMENTS
B-14	5.0'	NO	

**ENVIRONMENTALLY SENSITIVE LOCATIONS:**

NO.	LIMITS	POSITION
8.	611+50 TO 616+50	LT


**CURVE 20 DATA**  
 PC = 611+47.73  
 PT = 619+22.93  
 R = 18000'  
 $\Delta$  = 2° 28' 03", RT  
 D = 0° 19' 06"  
 e = NC  
 L = 775.21

**THINNING AND TRIMMING FOR SIGNS**  
 STA. 617+00, RT

**STONE FILL, TYPE I**  
 STA. 616+50 TO 616+60, LT  
 STA. 618+60 TO 620+00, LT

**DURABLE 4 INCH WHITE LINE**  
 (ALL LINES WILL INCLUDE EDGE LINE BREAKS AND RADII FOR SIDE ROADS)  
 STA. 616+50 TO 620+00, SOLID LT & RT

**DURABLE 4 INCH YELLOW LINE**  
 (ALL LINES WILL INCLUDE  $\phi$  BREAKS FOR SIDE ROADS)  
 STA. 616+50 TO 620+00, SOLID LT & RT

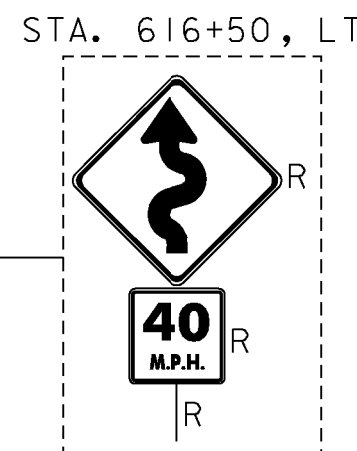

**TEMPORARY 4 INCH WHITE LINE, PAINT**  
 (ALL LINES WILL INCLUDE EDGE LINE BREAKS AND RADII FOR SIDE ROADS)  
 STA. 616+50 TO 620+00, SOLID LT & RT



**TEMPORARY 4 INCH YELLOW LINE, PAINT**  
 (ALL LINES WILL INCLUDE  $\phi$  BREAKS FOR SIDE ROADS)  
 STA. 616+50 TO 620+00, SOLID LT & RT

**GEOTEXTILE UNDER STONE FILL**  
 STA. 616+50 TO 616+75, LT  
 STA. 618+75 TO 620+00, LT

**GRUBBING MATERIAL**  
 STA. 616+50 TO 616+75, LT  
 STA. 618+75 TO 620+00, LT

**BARRIER FENCE**  
 STA. 616+50 TO 620+00, LT  
 (WITH BREAKS FOR DRIVES AND SIDEROADS)

**REMOVING SIGNS**  
 AS SHOWN - 2

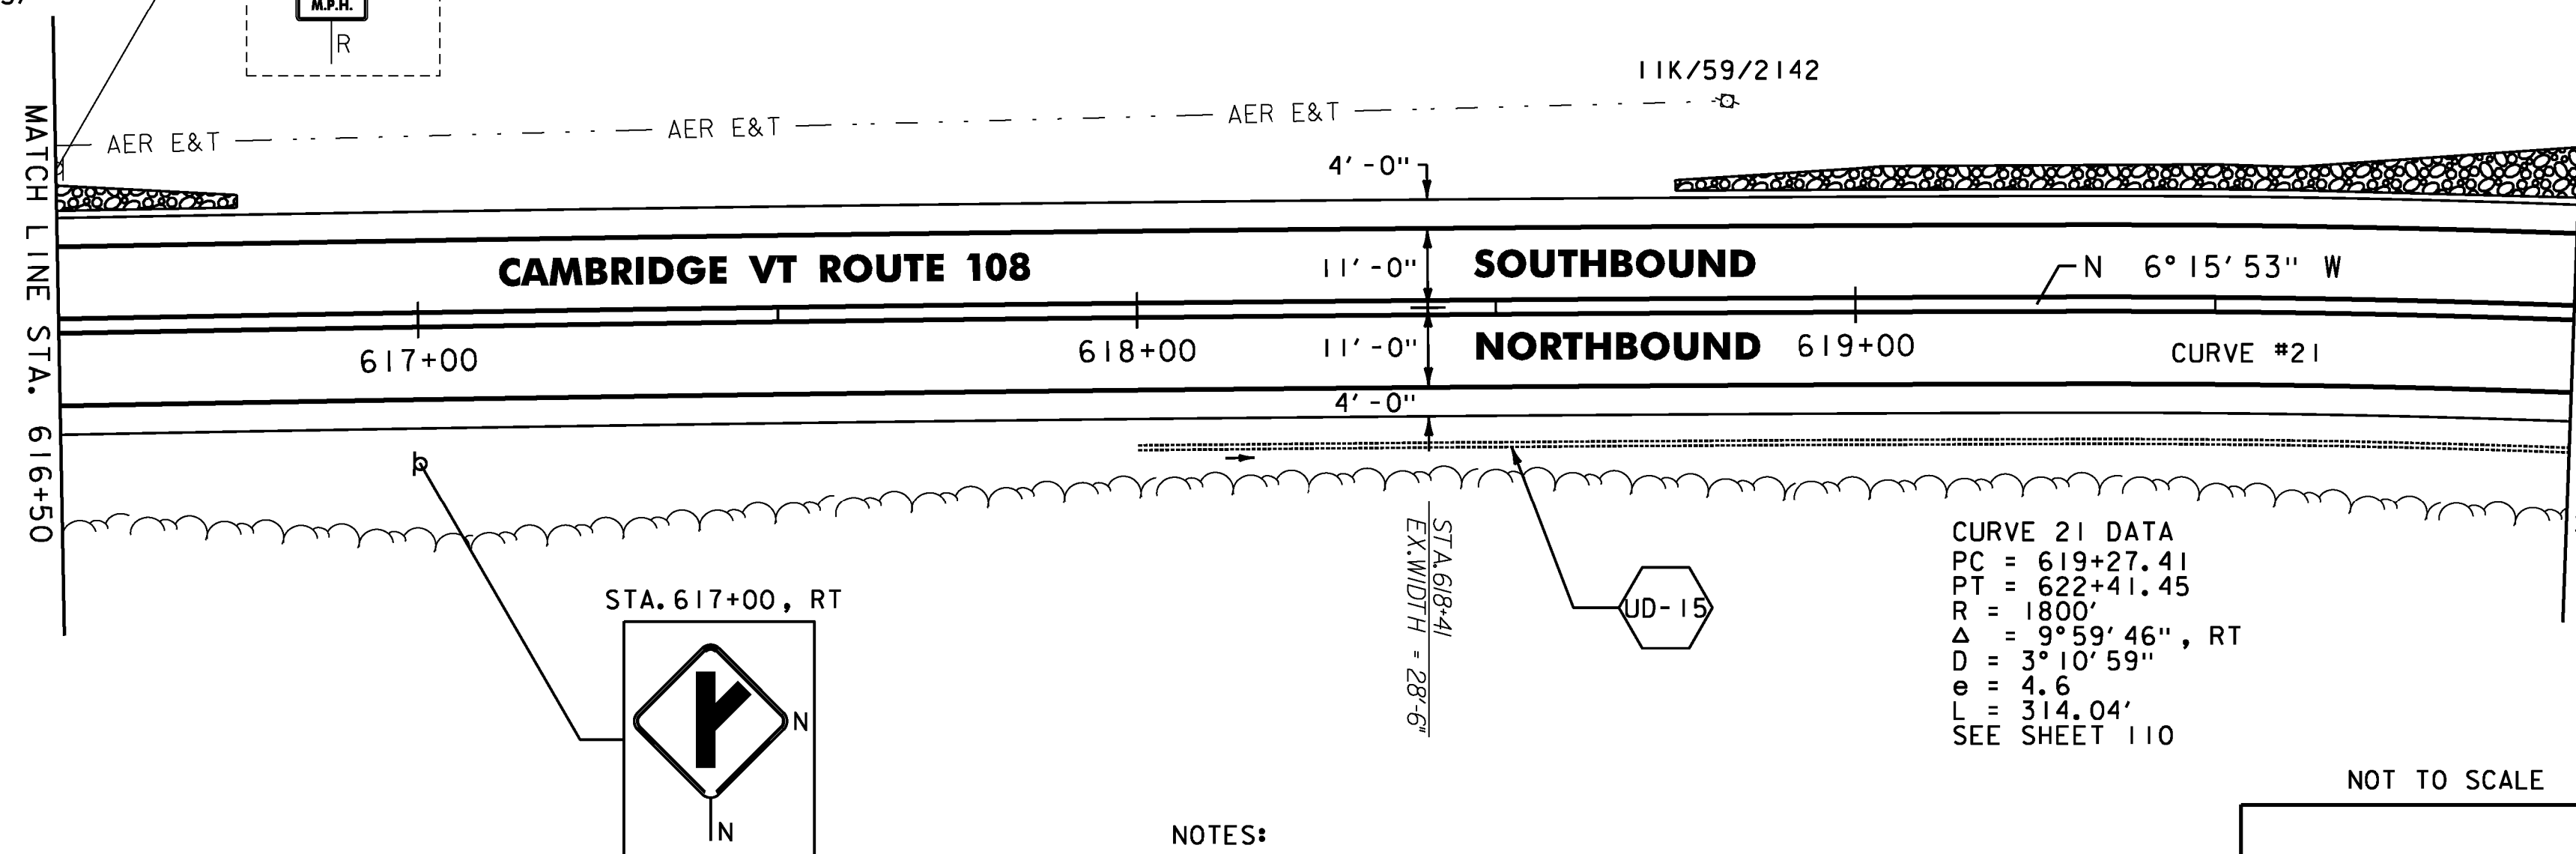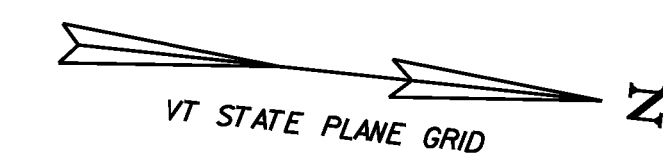

**CURVE 21 DATA**  
 PC = 619+27.41  
 PT = 622+41.45  
 R = 1800'  
 $\Delta$  = 9° 59' 46", RT  
 D = 3° 10' 59"  
 e = 4.6  
 L = 314.04'  
 SEE SHEET 110

**ENVIRONMENTALLY SENSITIVE LOCATIONS:**

NO.	LIMITS	POSITION
8.	616+50 TO 620+00	LT

**NOTES:**

- FOR LEGENDS, SEE SHEET 27.
- ALL EXISTING SIGNS NOT SHOWN SHALL BE RETAINED.
- DURABLE MARKINGS DETAILED ON THIS SHEET ARE OPTION BID ITEMS. SEE SHEET 14.



NOT TO SCALE

**PROJECT LAYOUT SHEET #14**

PROJECT NAME: CAMBRIDGE-BAKERSFIELD

PROJECT NUMBER: STP 2926(1)

FILE NAME: p10b258.dgn

PROJECT LEADER: JLL

DESIGNED BY: STANTEC

IPARM FILE: p10b258114.i

PLOT DATE: 11/15/2012

DRAWN BY: STANTEC

CHECKED BY: STANTEC

SHEET 40 OF 387