

STONE FILL, TYPE I  
 STA. 629+50 TO 630+25, RT OMIT  
 STA. 629+75 TO 634+50, LT

DURABLE 4 INCH WHITE LINE  
 (ALL LINES WILL INCLUDE EDGE LINE BREAKS  
 AND RADII FOR SIDE ROADS)  
 STA. 629+50 TO 634+50, SOLID LT & RT

DURABLE 4 INCH YELLOW LINE  
 (ALL LINES WILL INCLUDE C BREAKS FOR SIDE ROADS)  
 STA. 629+50 TO 634+50, SOLID LT & RT

TEMPORARY 4 INCH WHITE LINE, PAINT  
 (ALL LINES WILL INCLUDE EDGE LINE BREAKS  
 AND RADII FOR SIDE ROADS)  
 STA. 629+50 TO 634+50, SOLID LT & RT

TEMPORARY 4 INCH YELLOW LINE, PAINT  
 (ALL LINES WILL INCLUDE C BREAKS FOR SIDE ROADS)  
 STA. 629+50 TO 634+50, SOLID LT & RT

GEOTEXTILE UNDER STONE FILL  
 STA. 629+75 TO 634+50, LT



GRUBBING MATERIAL  
 STA. 629+75 TO 634+50, LT

BARRIER FENCE  
 STA. 629+50 TO 634+50, LT  
 (WITH BREAKS FOR DRIVES AND SIDEROADS)

REMOVING SIGNS  
 AS SHOWN - I

JD-16 STA 631+00 TO 634+00, RT  
 CONSTRUCT 6 INCH UNDERDRAIN PIPE,  
 SEE SHEET 18 FOR DETAIL AND  
 ASSOCIATED QUANTITIES.

JD-17 STA 634+10 TO 636+50, RT  
 CONSTRUCT 6 INCH UNDERDRAIN PIPE,  
 SEE SHEET 18 FOR DETAIL AND  
 ASSOCIATED QUANTITIES.

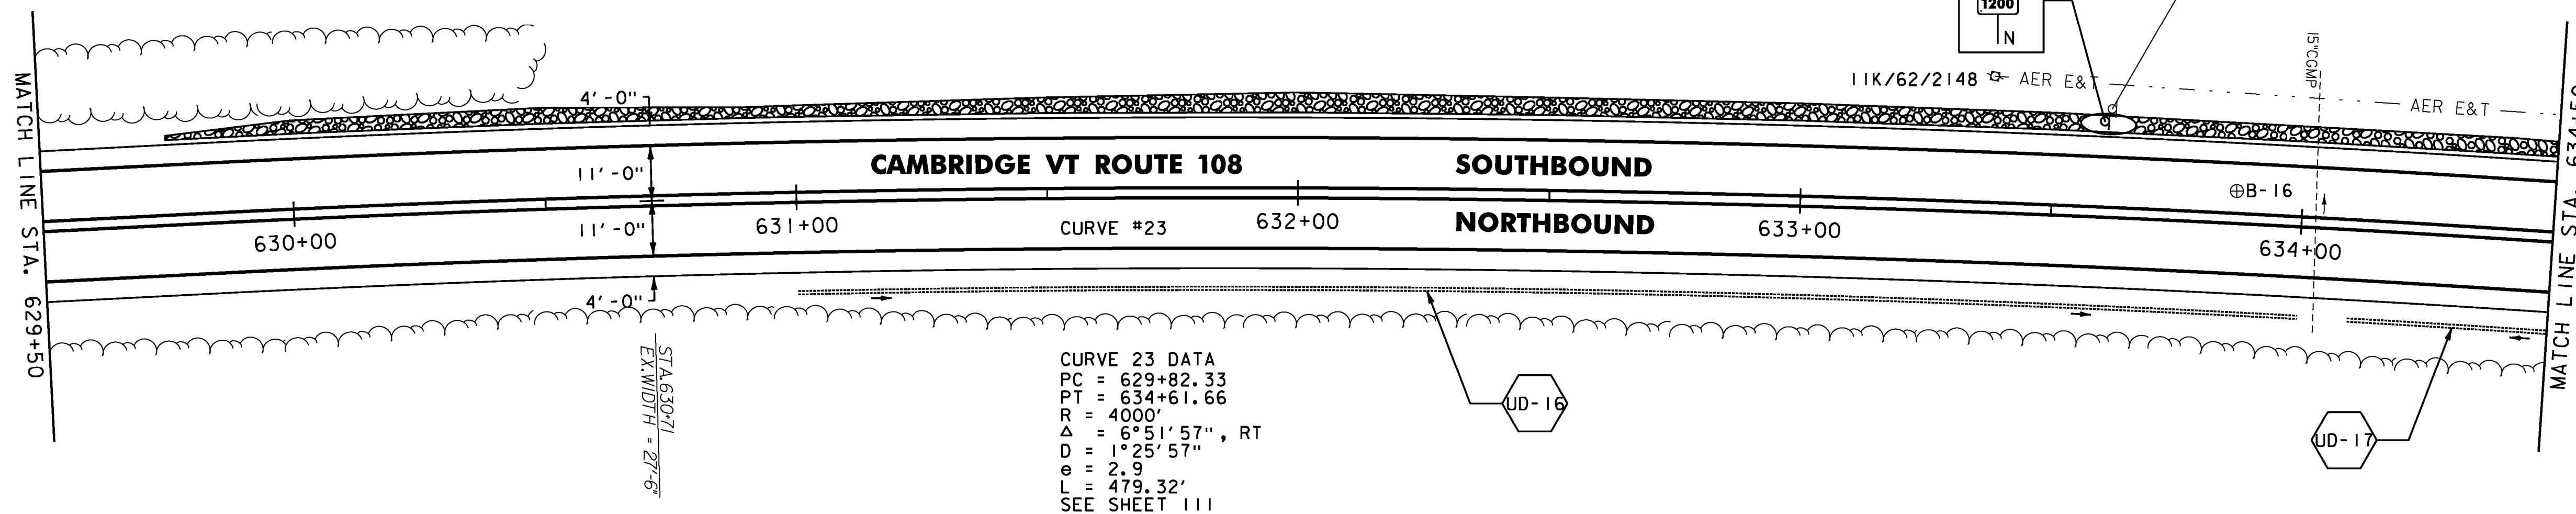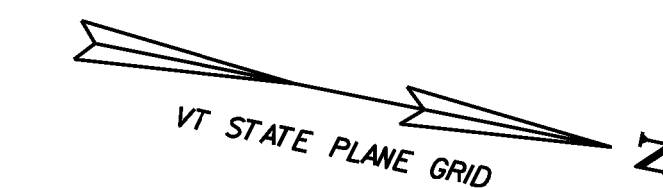

CURVE 23 DATA  
 PC = 629+82.33  
 PT = 634+61.66  
 R = 4000'  
 Δ = 6°51'57", RT  
 D = 1°25'57"  
 e = 2.9  
 L = 479.32'  
 SEE SHEET 111

**ENVIRONMENTALLY SENSITIVE LOCATIONS:**

NO.	LIMITS	POSITION
9.	629+50 TO 634+50	LT

SOIL BORING DATA			
BORING#	DEPTH (FT.)	PCC	COMMENTS
B-16	5.0'	NO	

STONE FILL, TYPE I  
 STA. 634+50 TO 635+25, LT  
 STA. 636+75 TO 638+25, LT  
 STA. 638+75 TO 639+50, LT

DURABLE 4 INCH WHITE LINE  
 (ALL LINES WILL INCLUDE EDGE LINE BREAKS  
 AND RADII FOR SIDE ROADS)  
 STA. 634+50 TO 639+50, SOLID LT & RT

DURABLE 4 INCH YELLOW LINE  
 (ALL LINES WILL INCLUDE C BREAKS FOR SIDE ROADS)  
 STA. 634+50 TO 639+50, SOLID LT & RT

TEMPORARY 4 INCH WHITE LINE, PAINT  
 (ALL LINES WILL INCLUDE EDGE LINE BREAKS  
 AND RADII FOR SIDE ROADS)  
 STA. 634+50 TO 639+50, SOLID LT & RT



TEMPORARY 4 INCH YELLOW LINE, PAINT  
 (ALL LINES WILL INCLUDE C BREAKS FOR SIDE ROADS)  
 STA. 634+50 TO 639+50, SOLID LT & RT

GEOTEXTILE UNDER STONE FILL  
 STA. 634+50 TO 634+75, LT  
 STA. 636+75 TO 637+75, LT

GRUBBING MATERIAL  
 STA. 634+50 TO 634+75, LT  
 STA. 636+75 TO 637+75, LT

BARRIER FENCE  
 STA. 634+50 TO 639+50, LT  
 (WITH BREAKS FOR DRIVES AND SIDEROADS)

JD-18 STA 637+00 TO 639+50, RT  
 CONSTRUCT 6 INCH UNDERDRAIN PIPE,  
 SEE SHEET 18 FOR DETAIL AND  
 ASSOCIATED QUANTITIES.

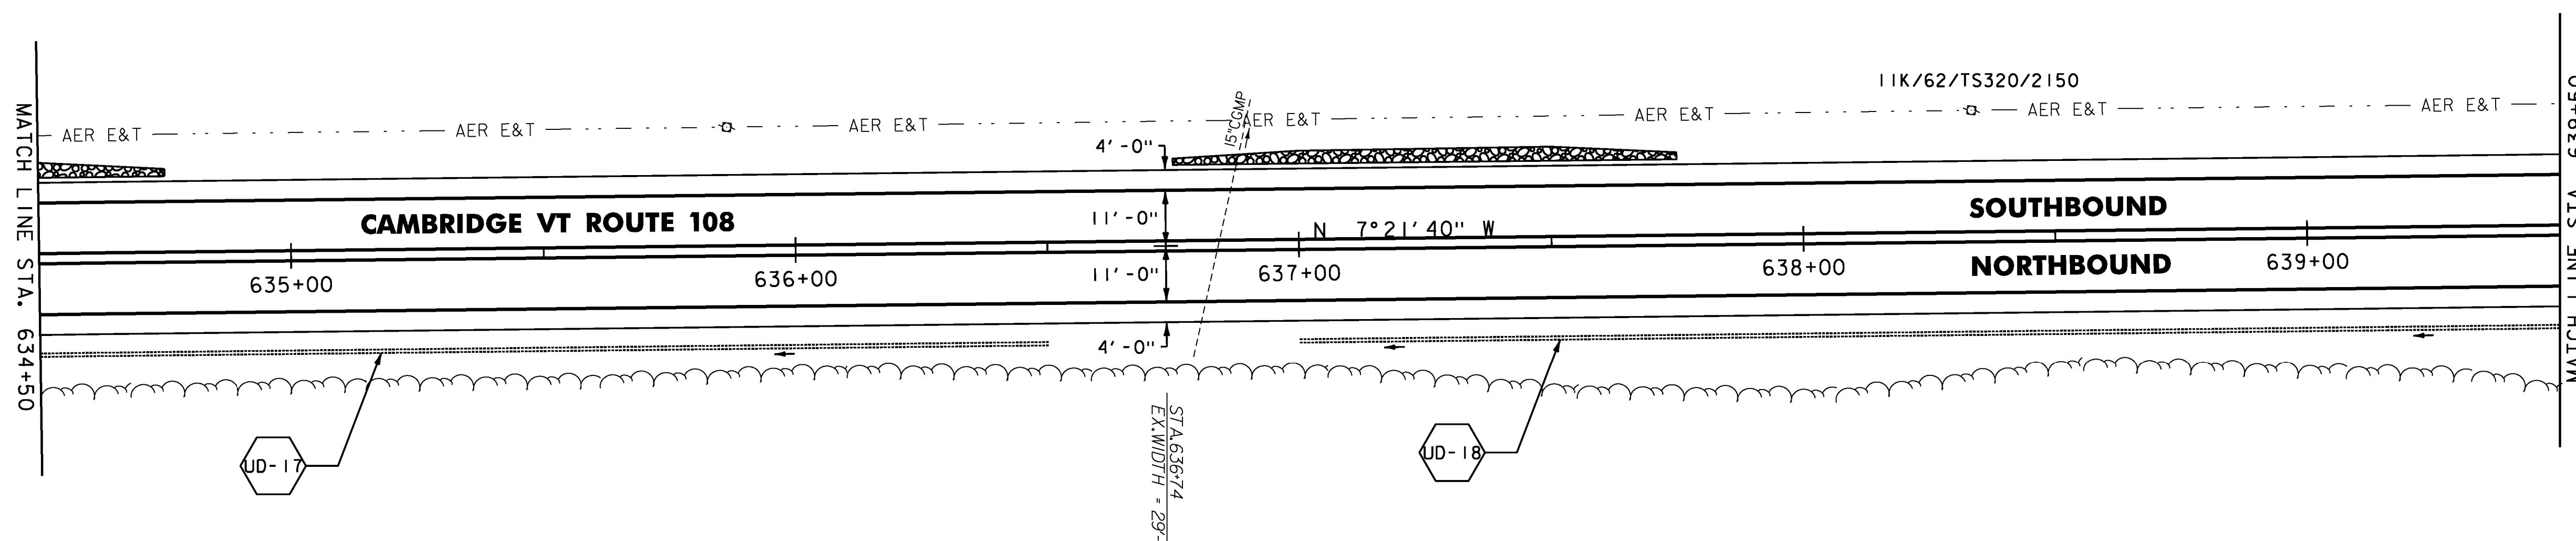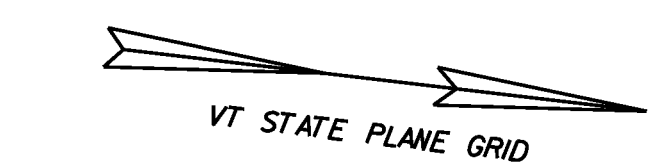

**NOTES:**

- FOR LEGENDS, SEE SHEET 27.
- ALL EXISTING SIGNS NOT SHOWN SHALL BE RETAINED.
- DURABLE MARKINGS DETAILED ON THIS SHEET ARE OPTION BID ITEMS. SEE SHEET 14.

**ENVIRONMENTALLY SENSITIVE LOCATIONS:**

NO.	LIMITS	POSITION
9.	634+50 TO 639+50	LT

NOT TO SCALE

**PROJECT LAYOUT SHEET #16**



PROJECT NAME: CAMBRIDGE-BAKERSFIELD

PROJECT NUMBER: STP 2926(I)

FILE NAME: pl0b258.dgn

PROJECT LEADER: JLL

DESIGNED BY: STANTEC

IPARM FILE: p10b258i16.i

PLOT DATE: 11/15/2012

DRAWN BY: STANTEC

CHECKED BY: STANTEC

SHEET 42 OF 387