


STONE FILL, TYPE J
 STA. 18+19 TO 18+83, LT
 RELOCATE MAILBOX, SINGLE SUPPORT
 STA. 18+71, LT
 STA. 18+75, LT
 STEEL BEAM GUARDRAIL, GALVANIZED W/8 FEET POSTS
 STA. 18+16.4 TO 19+00.0, LT 18+03.9
 ANCHOR FOR STEEL BEAM RAIL
 STA. 18+16.4, LT

DURABLE 4 INCH WHITE LINE
 (ALL LINES WILL INCLUDE EDGE LINE BREAKS
 AND RADII FOR SIDE ROADS)
 STA. 14+50 TO 19+00, SOLID LT & RT
 DURABLE 4 INCH YELLOW LINE
 (ALL LINES WILL INCLUDE ϕ BREAKS FOR SIDE ROADS)
 STA. 14+50 TO 19+00, SOLID LT, DASHED RT

TEMPORARY 4 INCH WHITE LINE, PAINT
 (ALL LINES WILL INCLUDE EDGE LINE BREAKS
 AND RADII FOR SIDE ROADS)
 STA. 14+50 TO 19+00, SOLID LT & RT
 TEMPORARY 4 INCH YELLOW LINE, PAINT
 (ALL LINES WILL INCLUDE ϕ BREAKS FOR SIDE ROADS)
 STA. 14+50 TO 19+00, SOLID LT, DASHED RT

BARRIER FENCE
 STA. 14+50 TO 19+00, LT
 STA. 14+50 TO 19+00, RT
 (WITH BREAKS FOR DRIVES AND SIDEROADS)

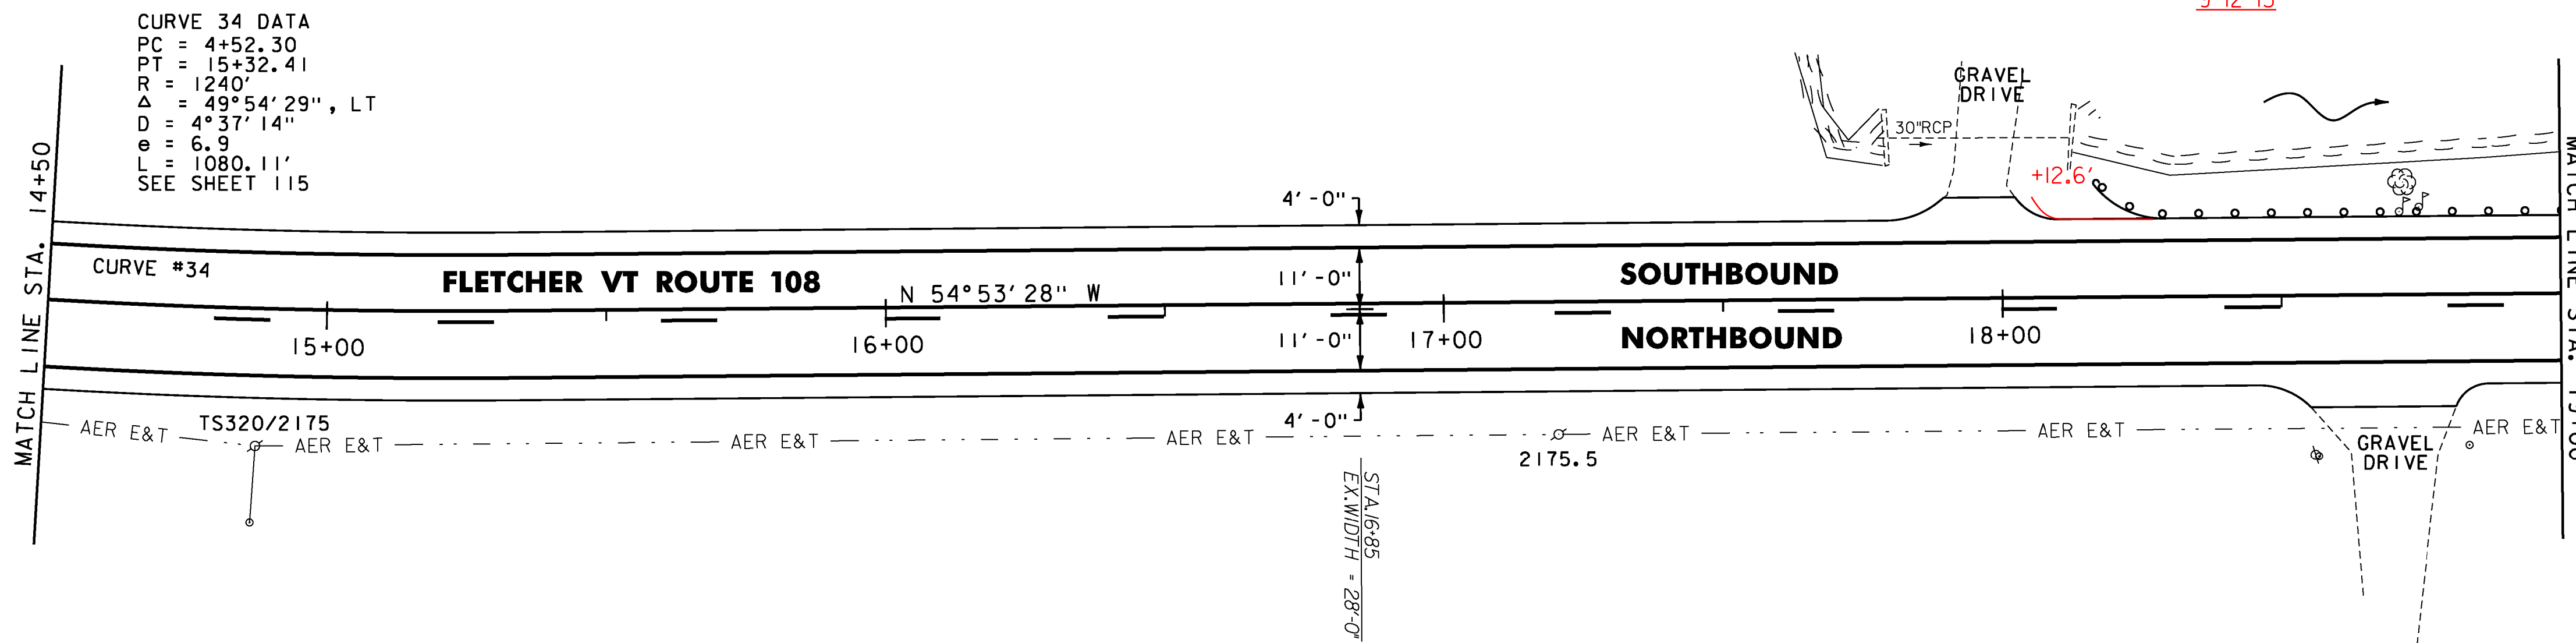

ENVIRONMENTALLY SENSITIVE LOCATIONS:

NO.	LIMITS	POSITION
15.	14+50 TO 19+00	LT
16.	14+50 TO 19+00	RT

STONE FILL, TYPE J
 STA. 19+25 TO 21+75, LT
 STA. 23+25 TO 23+50, LT
 STEEL BEAM GUARDRAIL, GALVANIZED W/8 FEET POSTS
 STA. 19+00 TO 22+41.4, LT
 STA. 20+85.1 TO 22+35.1, RT
 STA. 22+72.6 TO 23+50, RT
 STA. 22+78.9 TO 23+50, LT
 HD STEEL BEAM GUARDRAIL, GALVANIZED/NESTED W/8 FEET POSTS
 STA. 22+35.1 TO 22+72.6, RT
 STA. 22+41.4 TO 22+78.9, LT
 ANCHOR FOR STEEL BEAM RAIL
 STA. 20+85.1, RT


REMOVAL AND DISPOSAL OF GUARDRAIL
 STA. 19+33 TO 23+50, LT
 STA. 20+95 TO 23+50, RT
 DURABLE 4 INCH WHITE LINE
 (ALL LINES WILL INCLUDE EDGE LINE BREAKS
 AND RADII FOR SIDE ROADS)
 STA. 19+00 TO 23+50, SOLID LT & RT
 DURABLE 4 INCH YELLOW LINE
 (ALL LINES WILL INCLUDE ϕ BREAKS FOR SIDE ROADS)
 STA. 19+00 TO 20+59, SOLID LT, DASHED RT
 STA. 20+59 TO 21+65, DASHED ϕ
 STA. 21+65 TO 23+50, DASHED LT, SOLID RT

TEMPORARY 4 INCH WHITE LINE, PAINT
 (ALL LINES WILL INCLUDE EDGE LINE BREAKS
 AND RADII FOR SIDE ROADS)
 STA. 19+00 TO 23+50, SOLID LT & RT
 TEMPORARY 4 INCH YELLOW LINE, PAINT
 (ALL LINES WILL INCLUDE ϕ BREAKS FOR SIDE ROADS)
 STA. 19+00 TO 20+59, SOLID LT, DASHED RT
 STA. 20+59 TO 21+65, DASHED ϕ
 STA. 21+65 TO 23+50, DASHED LT, SOLID RT

GEOTEXTILE UNDER STONE FILL
 STA. 19+75 TO 21+75, LT
 STA. 23+25 TO 23+50, LT
 GRUBBING MATERIAL
 STA. 19+75 TO 21+75, LT
 STA. 23+25 TO 23+50, LT

BARRIER FENCE
 STA. 19+00 TO 23+50, LT
 STA. 19+00 TO 23+50, RT
 (WITH BREAKS FOR DRIVES AND SIDEROADS)

REMOVING SIGNS
 AS SHOWN - 1

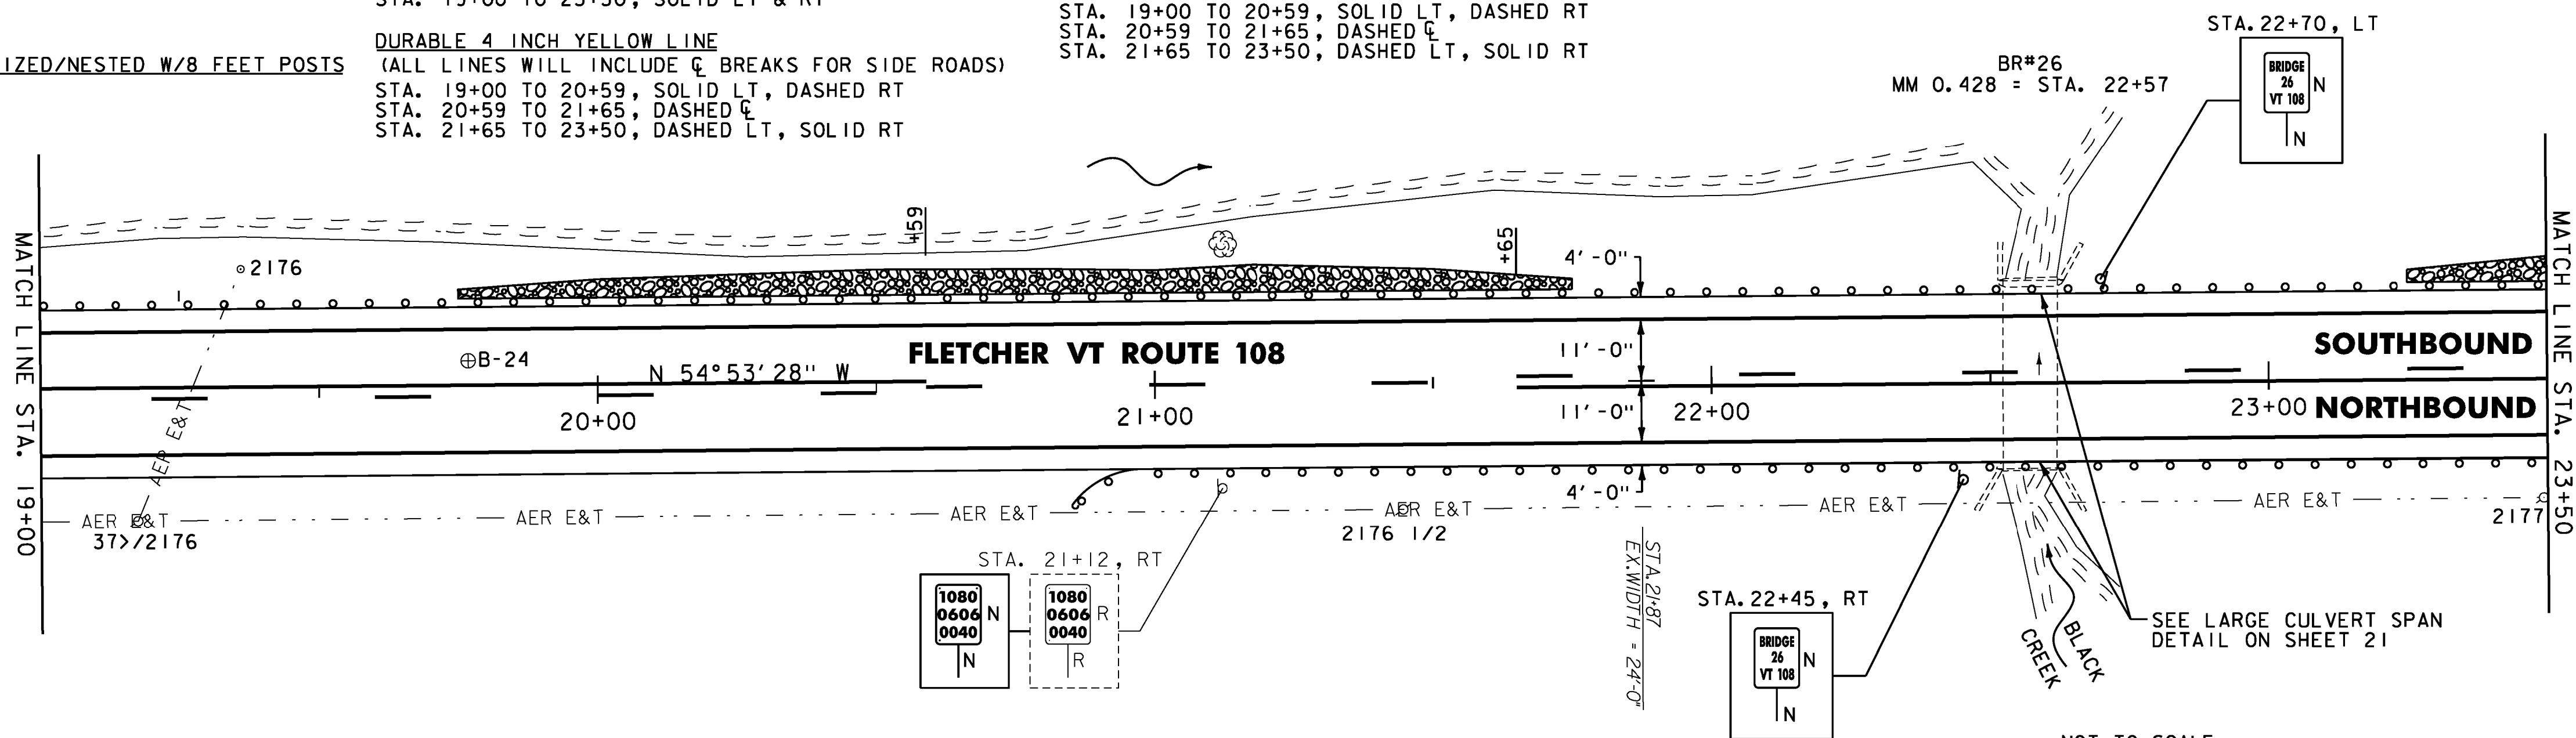

ENVIRONMENTALLY SENSITIVE LOCATIONS:

NO.	LIMITS	POSITION
15.	19+00 TO 23+50	LT
16.	19+00 TO 23+50	RT

NOTES:

- FOR LEGENDS, SEE SHEET 27.
- ALL EXISTING SIGNS NOT SHOWN SHALL BE RETAINED.
- DURABLE MARKINGS DETAILED ON THIS SHEET ARE OPTION BID ITEMS. SEE SHEET 14.

SOIL BORING DATA			
BORING#	DEPTH (FT.)	PCC	COMMENTS
B-24	5.0'	NO	



PROJECT LAYOUT SHEET #24

PROJECT NAME: CAMBRIDGE-BAKERSFIELD

PROJECT NUMBER: STP 2926(1)

FILE NAME: p10b258.dgn
 PROJECT LEADER: JLL
 DESIGNED BY: STANTEC
 IPARM FILE: p10b258124.i

PLOT DATE: 11/15/2012
 DRAWN BY: STANTEC
 CHECKED BY: STANTEC
 SHEET 50 OF 387