


STONE FILL, TYPE J  
 STA. 17+50 TO 20+00, RT  
 RELOCATE MAILBOX, SINGLE SUPPORT  
 STA. 21+60, LT

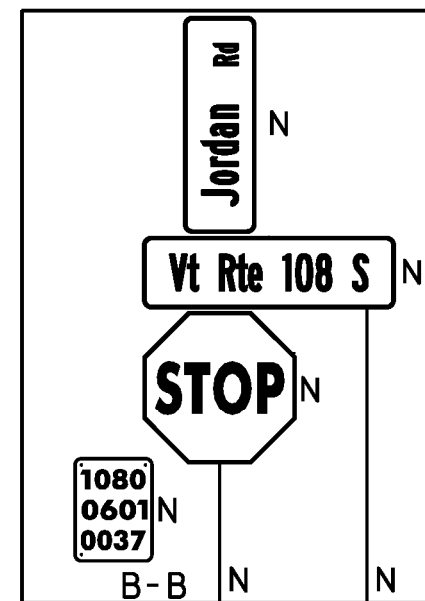



DURABLE 4 INCH WHITE LINE  
 (ALL LINES WILL INCLUDE EDGE LINE BREAKS  
 AND RADII FOR SIDE ROADS)  
 STA. 17+50 TO 22+50, SOLID LT & RT

DURABLE 4 INCH YELLOW LINE  
 (ALL LINES WILL INCLUDE  $\phi$  BREAKS FOR SIDE ROADS)  
 STA. 17+50 TO 19+54, DASHED LT, SOLID RT  
 STA. 19+54 TO 22+50, SOLID LT & RT

TEMPORARY 4 INCH WHITE LINE, PAINT  
 (ALL LINES WILL INCLUDE EDGE LINE BREAKS  
 AND RADII FOR SIDE ROADS)  
 STA. 17+50 TO 22+50, SOLID LT & RT

TEMPORARY 4 INCH YELLOW LINE, PAINT  
 (ALL LINES WILL INCLUDE  $\phi$  BREAKS FOR SIDE ROADS)  
 STA. 17+50 TO 19+54, DASHED LT, SOLID RT  
 STA. 19+54 TO 22+50, SOLID LT & RT

GEOTEXTILE UNDER STONE FILL  
 STA. 18+75 TO 19+75, RT  
 GRUBBING MATERIAL  
 STA. 18+75 TO 19+75, RT  
 REMOVING SIGNS  
 AS SHOWN - 4

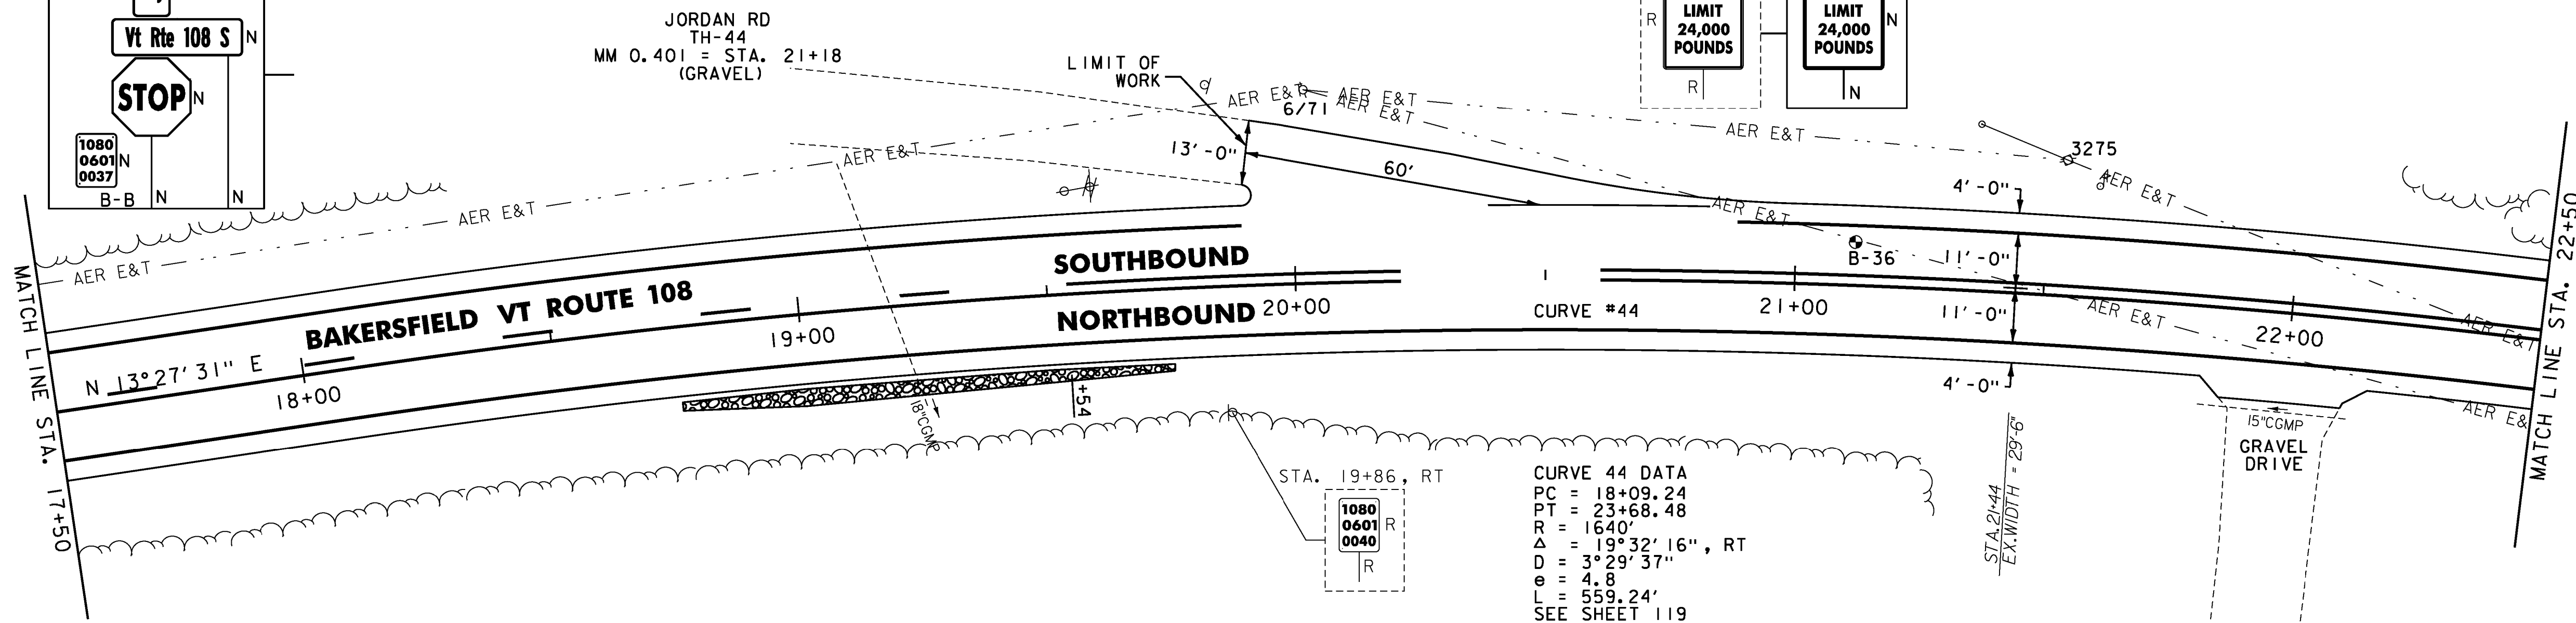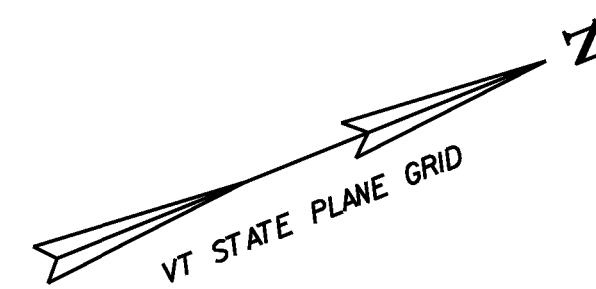

CURVE 44 DATA  
 PC = 18+09.24  
 PT = 23+68.48  
 R = 1640'  
 $\Delta$  = 19°32'16", RT  
 D = 3°29'37"  
 e = 4.8  
 L = 559.24'  
 SEE SHEET 119

SOIL BORING DATA			
BORING#	DEPTH (FT.)	PCC	COMMENTS
B-36	5.0'	NO	LEDGE @ 4.0'



STONE FILL, TYPE J  
 STA. 24+32 TO 24+75, LT  
 STA. 25+40 TO 27+50, LT  
 RELOCATE MAILBOX, SINGLE SUPPORT  
 STA. 23+29, LT

DURABLE 4 INCH YELLOW LINE  
 (ALL LINES WILL INCLUDE  $\phi$  BREAKS FOR SIDE ROADS)  
 STA. 22+50 TO 27+50, SOLID LT & RT

TEMPORARY 4 INCH WHITE LINE, PAINT  
 (ALL LINES WILL INCLUDE EDGE LINE BREAKS  
 AND RADII FOR SIDE ROADS)  
 STA. 22+50 TO 27+50, SOLID LT & RT

TEMPORARY 4 INCH YELLOW LINE, PAINT  
 (ALL LINES WILL INCLUDE  $\phi$  BREAKS FOR SIDE ROADS)  
 STA. 22+50 TO 27+50, SOLID LT & RT

GEOTEXTILE UNDER STONE FILL  
 STA. 24+32 TO 24+75, LT  
 STA. 25+25 TO 27+25, LT  
 GRUBBING MATERIAL  
 STA. 24+32 TO 24+75, LT  
 STA. 25+25 TO 27+25, LT

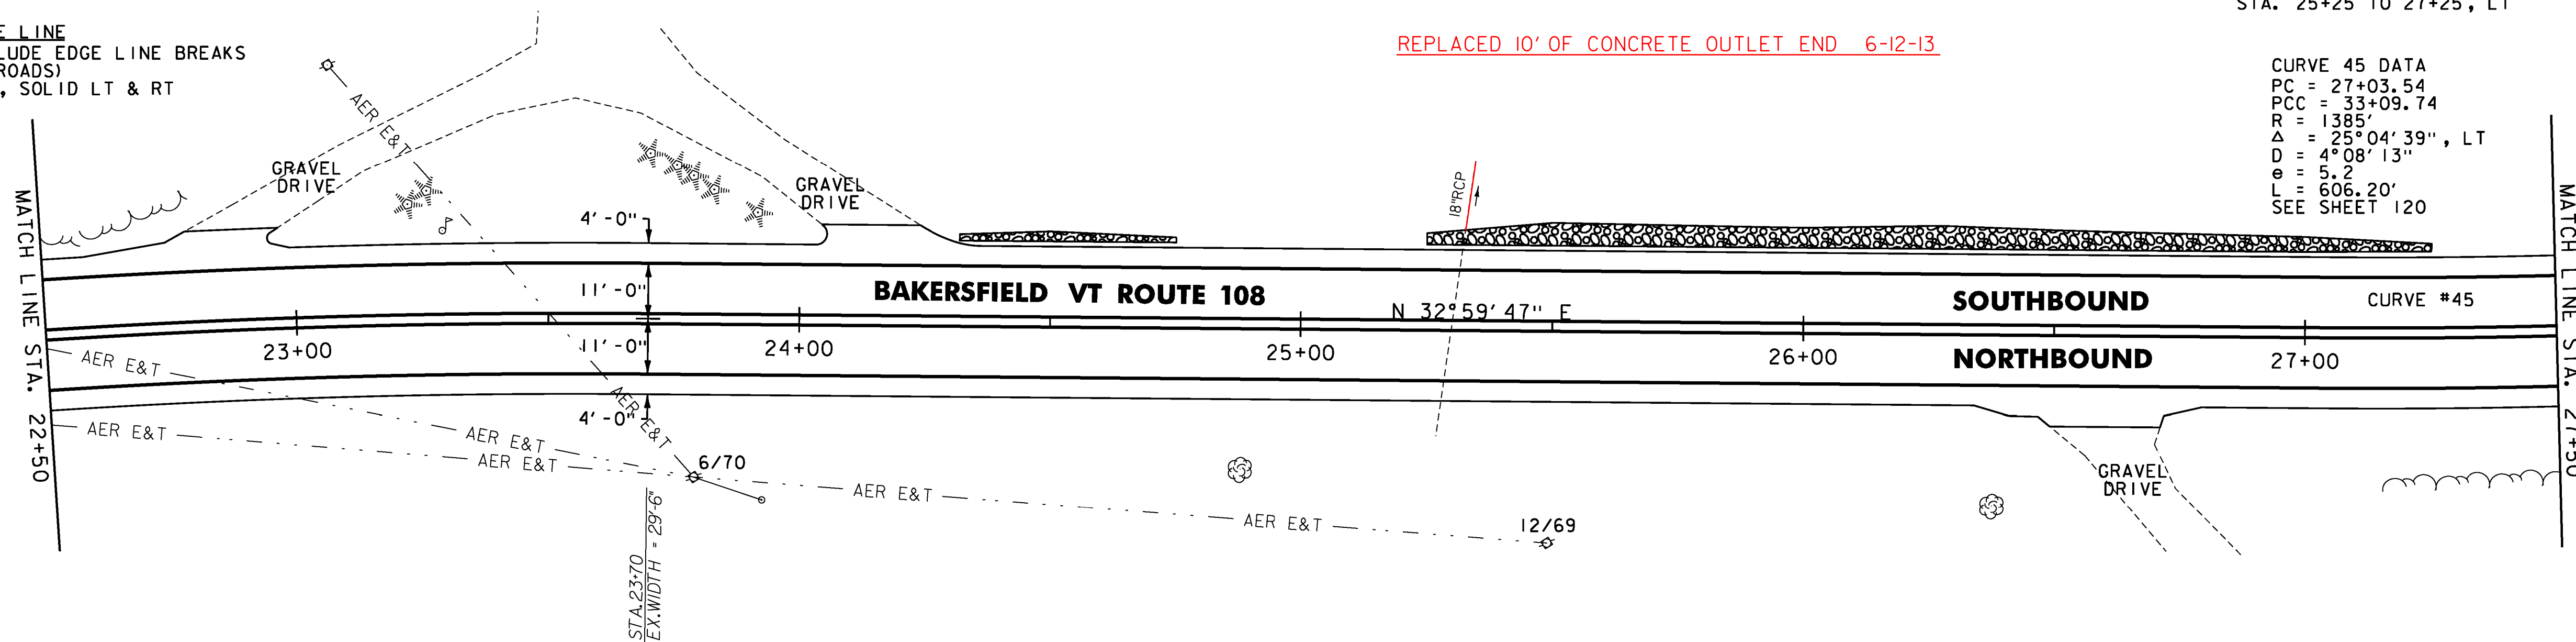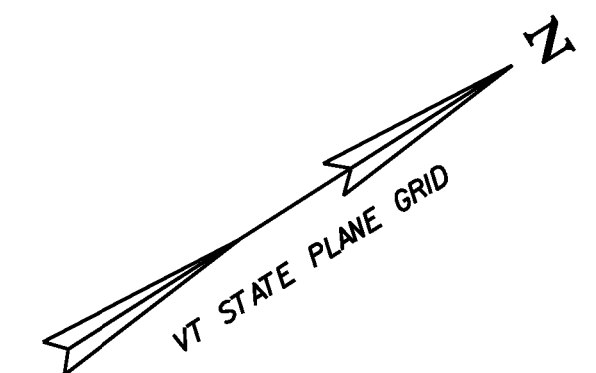

CURVE 45 DATA  
 PC = 27+03.54  
 PCC = 33+09.74  
 R = 1385'  
 $\Delta$  = 25°04'39", LT  
 D = 4°08'13"  
 e = 5.2  
 L = 606.20'  
 SEE SHEET 120

NOTES:

- FOR LEGENDS, SEE SHEET 27.
- ALL EXISTING SIGNS NOT SHOWN SHALL BE RETAINED.
- DURABLE MARKINGS DETAILED ON THIS SHEET ARE OPTION BID ITEMS. SEE SHEET 14.



NOT TO SCALE

**PROJECT LAYOUT SHEET #38**

PROJECT NAME: CAMBRIDGE-BAKERSFIELD  
 PROJECT NUMBER: STP 2926(I)

FILE NAME: p10b258.dgn  
 PROJECT LEADER: JLL  
 DESIGNED BY: STANTEC  
 IPARM FILE: p10b258138.i

PLOT DATE: 11/15/2012  
 DRAWN BY: STANTEC  
 CHECKED BY: STANTEC  
 SHEET 64 OF 387