


STONE FILL, TYPE I
 STA. 46+50 TO 47+37, LT
 RELOCATE MAILBOX, SINGLE SUPPORT
 STA. 47+94, LT
 DURABLE 4 INCH WHITE LINE
 (ALL LINES WILL INCLUDE EDGE LINE BREAKS
 AND RADII FOR SIDE ROADS)
 STA. 46+50 TO 51+00, SOLID LT & RT
 DURABLE 4 INCH YELLOW LINE
 (ALL LINES WILL INCLUDE ϕ BREAKS FOR SIDE ROADS)
 STA. 46+50 TO 51+00, SOLID LT & RT
 STA. 47+84, DOUBLE SOLID RT (GAMBLER RD, TH-7)

DURABLE 24 INCH STOP BAR
 STA. 47+84, RT (GAMBLER RD, TH-7)
 DURABLE LETTER OR SYMBOL
 STA. 47+84, RT (GAMBLER RD, TH-7) "STOP"
 TEMPORARY 4 INCH WHITE LINE, PAINT
 (ALL LINES WILL INCLUDE EDGE LINE BREAKS
 AND RADII FOR SIDE ROADS)
 STA. 46+50 TO 51+00, SOLID LT & RT
 TEMPORARY 4 INCH YELLOW LINE, PAINT
 (ALL LINES WILL INCLUDE ϕ BREAKS FOR SIDE ROADS)
 STA. 46+50 TO 51+00, SOLID LT & RT
 STA. 47+84, DOUBLE SOLID RT (GAMBLER RD, TH-7)

CURVE 47 DATA
 PC = 46+38.58
 PT = 47+57.11
 R = 22000'
 Δ = 0° 18' 31", LT
 D = 0° 15' 38"
 θ = NC
 L = 118.53

TEMPORARY 24 INCH STOP BAR, PAINT
 STA. 47+84, RT (GAMBLER RD, TH-7)
 TEMPORARY LETTER OR SYMBOL, PAINT
 STA. 47+84, RT (GAMBLER RD, TH-7) "STOP"

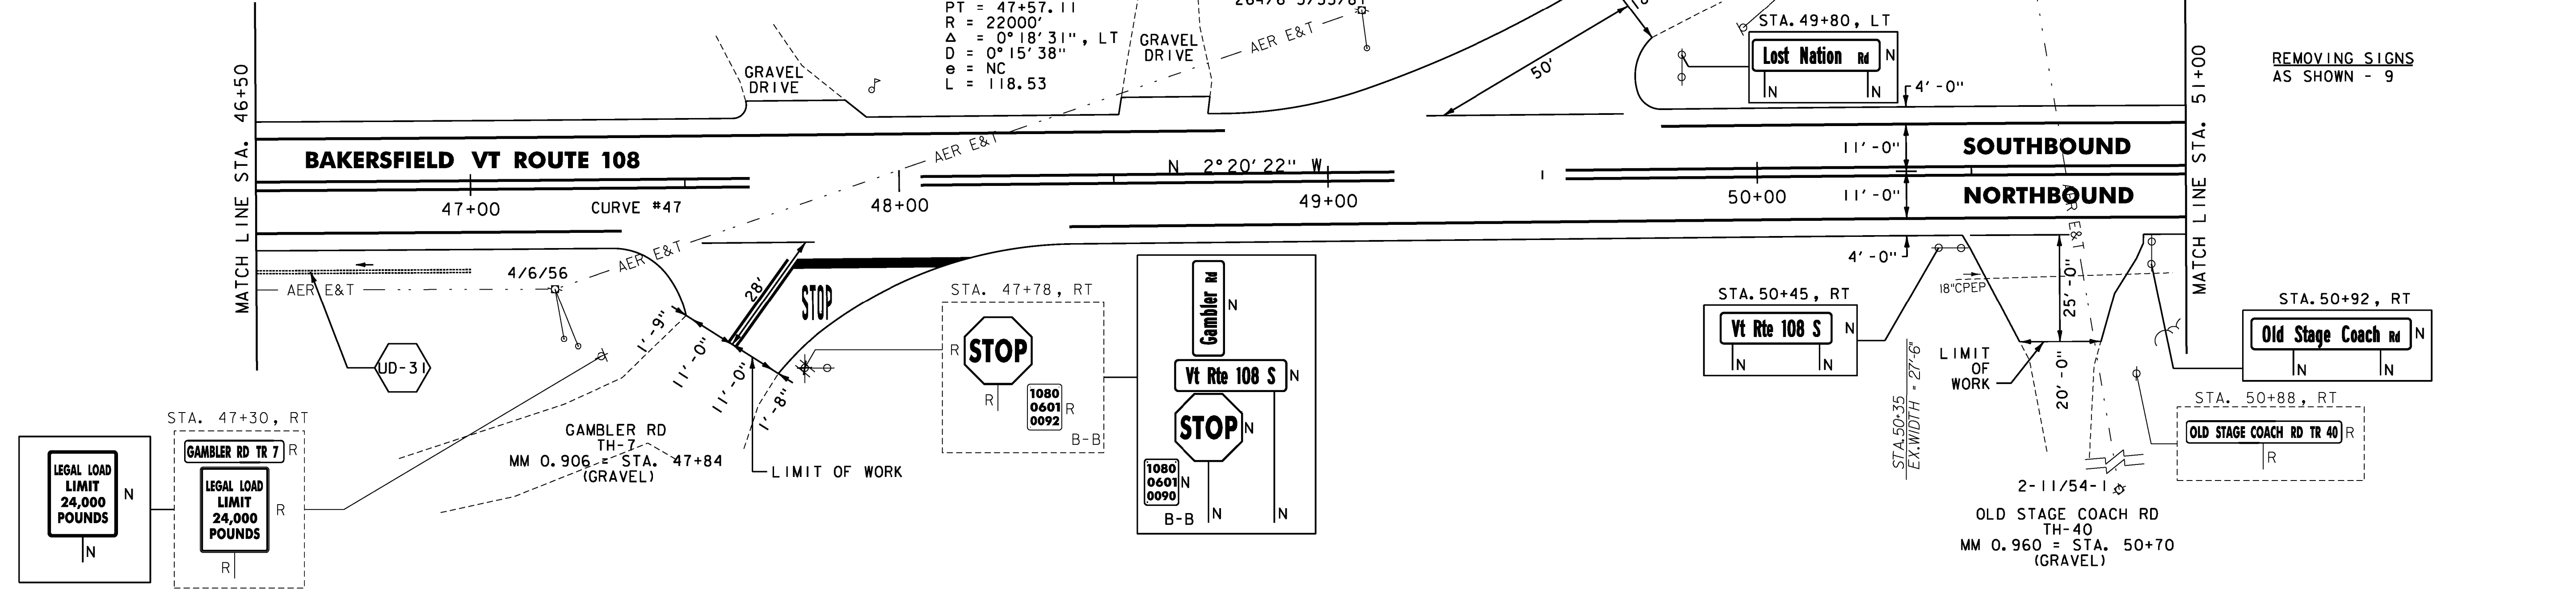


STONE FILL, TYPE I
 STA. 51+50 TO 54+25, LT
 STA. 52+50 TO 53+00, RT
 RELOCATE MAILBOX, SINGLE SUPPORT
 STA. 54+59, RT
 STEEL BEAM GUARDRAIL, GALVANIZED W/8 FEET POSTS
 STA. 51+21 TO 55+50, LT
 STA. 51+67.5 TO 53+30, RT
 ANCHOR FOR STEEL BEAM RAIL
 STA. 51+21, LT
 STA. 51+67.5, RT
 STA. 53+30, RT
 REMOVAL AND DISPOSAL OF GUARDRAIL
 STA. 51+21 TO 55+50, LT
 STA. 51+68 TO 53+31, RT

DURABLE 4 INCH WHITE LINE
 (ALL LINES WILL INCLUDE EDGE LINE BREAKS
 AND RADII FOR SIDE ROADS)
 STA. 51+00 TO 55+50, SOLID LT & RT

DURABLE 4 INCH YELLOW LINE
 (ALL LINES WILL INCLUDE ϕ BREAKS FOR SIDE ROADS)
 STA. 51+00 TO 55+50, SOLID LT & RT

TEMPORARY 4 INCH WHITE LINE, PAINT
 (ALL LINES WILL INCLUDE EDGE LINE BREAKS
 AND RADII FOR SIDE ROADS)
 STA. 51+00 TO 55+50, SOLID LT & RT

TEMPORARY 4 INCH YELLOW LINE, PAINT
 (ALL LINES WILL INCLUDE ϕ BREAKS FOR SIDE ROADS)
 STA. 51+00 TO 55+50, SOLID LT & RT

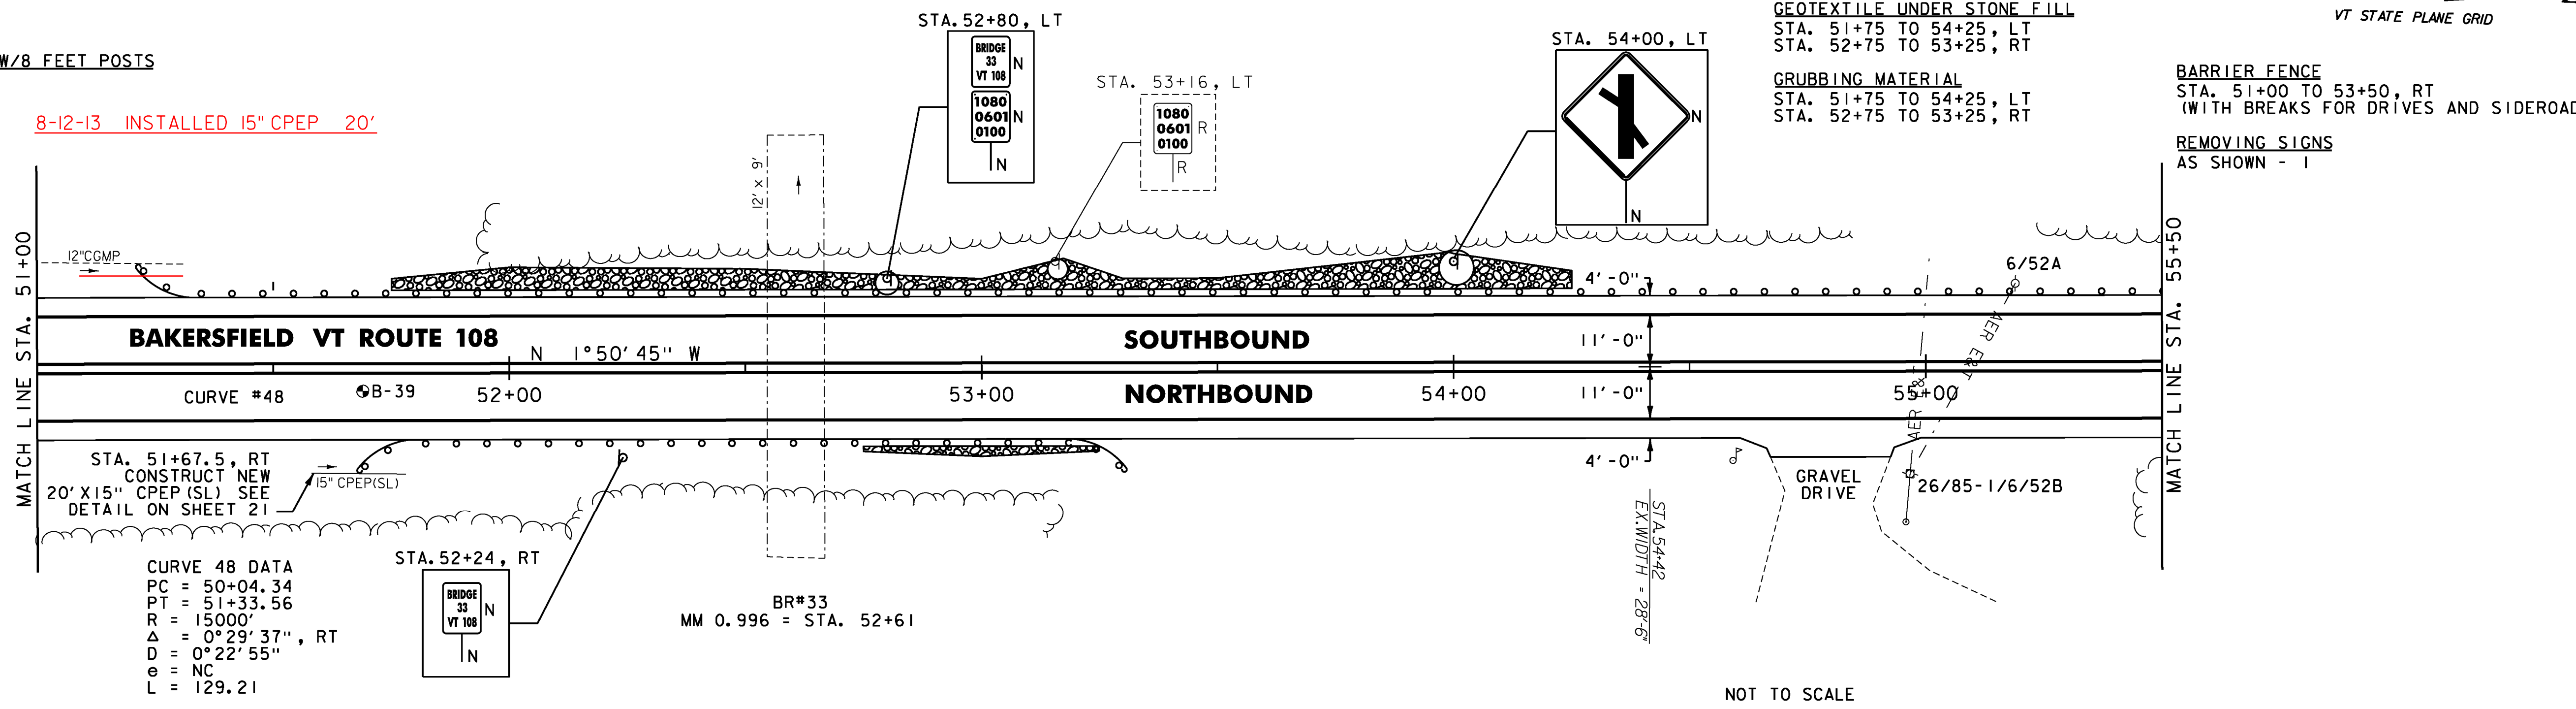

SOIL BORING DATA			
BORING#	DEPTH (FT.)	PCC	COMMENTS
B-39	5.0'	NO	

ENVIRONMENTALLY SENSITIVE LOCATIONS:
 NO. 24. LIMITS 51+00 TO 53+50 POSITION RT

- NOTES:
- FOR LEGENDS, SEE SHEET 27.
 - ALL EXISTING SIGNS NOT SHOWN SHALL BE RETAINED.
 - DURABLE MARKINGS DETAILED ON THIS SHEET ARE OPTION BID ITEMS. SEE SHEET 14.



NOT TO SCALE
PROJECT LAYOUT SHEET #41

PROJECT NAME: CAMBRIDGE-BAKERSFIELD
 PROJECT NUMBER: STP 2926(I)
 FILE NAME: p10b258.dgn
 PROJECT LEADER: JLL
 DESIGNED BY: STANTEC
 IPARM FILE: p10b258141.i
 PLOT DATE: 11/15/2012
 DRAWN BY: STANTEC
 CHECKED BY: STANTEC
 SHEET 67 OF 387