

STEEL BEAM GUARDRAIL, GALVANIZED W/8 FEET POSTS
STA. 55+50 TO 57+71, LT

STEEL BEAM GUARDRAIL, GALVANIZED
STA. 57+71 TO 60+50, LT

REMOVAL AND DISPOSAL OF GUARDRAIL
STA. 55+50 TO 60+50, LT


DURABLE 4 INCH WHITE LINE
(ALL LINES WILL INCLUDE EDGE LINE BREAKS
AND RADII FOR SIDE ROADS)
STA. 55+50 TO 60+50, SOLID LT & RT

DURABLE 4 INCH YELLOW LINE
(ALL LINES WILL INCLUDE ϕ BREAKS FOR SIDE ROADS)
STA. 55+50 TO 60+50, SOLID LT & RT

TEMPORARY 4 INCH WHITE LINE, PAINT
(ALL LINES WILL INCLUDE EDGE LINE BREAKS
AND RADII FOR SIDE ROADS)
STA. 55+50 TO 60+50, SOLID LT & RT

TEMPORARY 4 INCH YELLOW LINE, PAINT
(ALL LINES WILL INCLUDE ϕ BREAKS FOR SIDE ROADS)
STA. 55+50 TO 60+50, SOLID LT & RT

UD-32 STA 56+50 TO 60+50, RT
CONSTRUCT 6 INCH UNDERDRAIN PIPE,
SEE SHEET 18 FOR DETAIL AND
ASSOCIATED QUANTITIES.

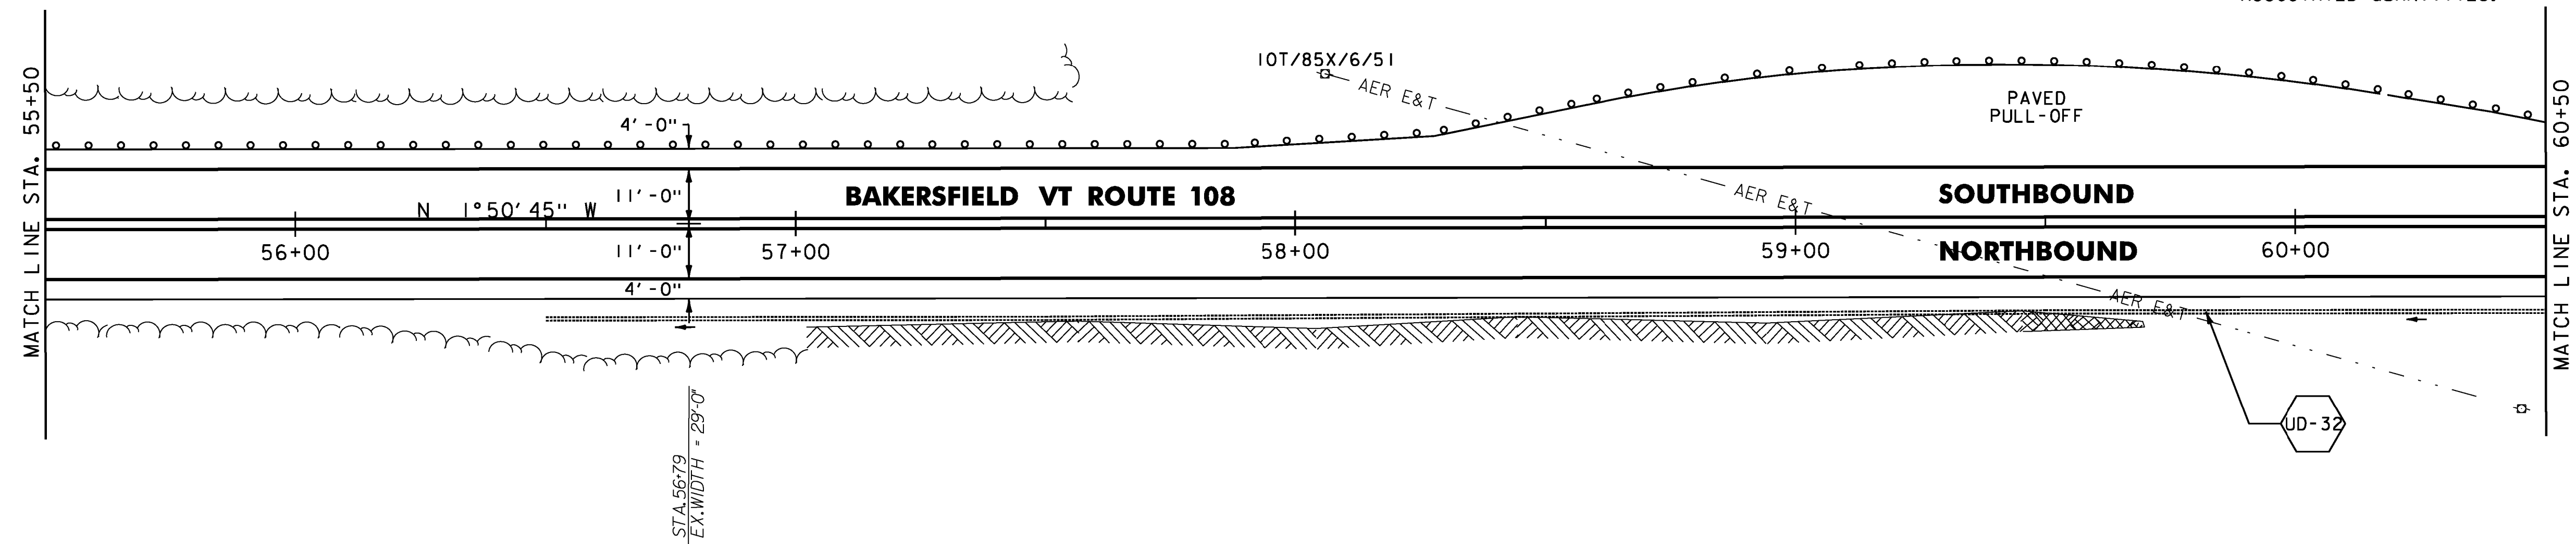

STONE FILL, TYPE I
STA. 60+81 TO 63+25, RT
STA. 63+75 TO 64+84, RT

STEEL BEAM GUARDRAIL, GALVANIZED
STA. 60+50 TO 62+83.5, LT

STEEL BEAM GUARDRAIL, GALVANIZED W/8 FEET POSTS
STA. 63+12.5 TO 65+50, LT
ANCHOR FOR STEEL BEAM RAIL
STA. 62+83.5, LT
STA. 63+12.5, LT

REMOVAL AND DISPOSAL OF GUARDRAIL
STA. 60+50 TO 62+81, LT
STA. 63+12 TO 65+50, LT

DURABLE 4 INCH WHITE LINE
(ALL LINES WILL INCLUDE EDGE LINE BREAKS
AND RADII FOR SIDE ROADS)
STA. 60+50 TO 65+50, SOLID LT & RT


DURABLE 4 INCH YELLOW LINE
(ALL LINES WILL INCLUDE ϕ BREAKS FOR SIDE ROADS)
STA. 60+50 TO 64+15, SOLID LT & RT
STA. 64+15 TO 65+50, SOLID LT, DASHED RT

TEMPORARY 4 INCH WHITE LINE, PAINT
(ALL LINES WILL INCLUDE EDGE LINE BREAKS
AND RADII FOR SIDE ROADS)
STA. 60+50 TO 65+50, SOLID LT & RT

TEMPORARY 4 INCH YELLOW LINE, PAINT
(ALL LINES WILL INCLUDE ϕ BREAKS FOR SIDE ROADS)
STA. 60+50 TO 64+15, SOLID LT & RT
STA. 64+15 TO 65+50, SOLID LT, DASHED RT

GEOTEXTILE UNDER STONE FILL
STA. 60+75 TO 61+25, RT
STA. 62+25 TO 62+75, RT
GRUBBING MATERIAL
STA. 60+75 TO 61+25, RT
STA. 62+25 TO 62+75, RT

REMOVING SIGNS
AS SHOWN - 5

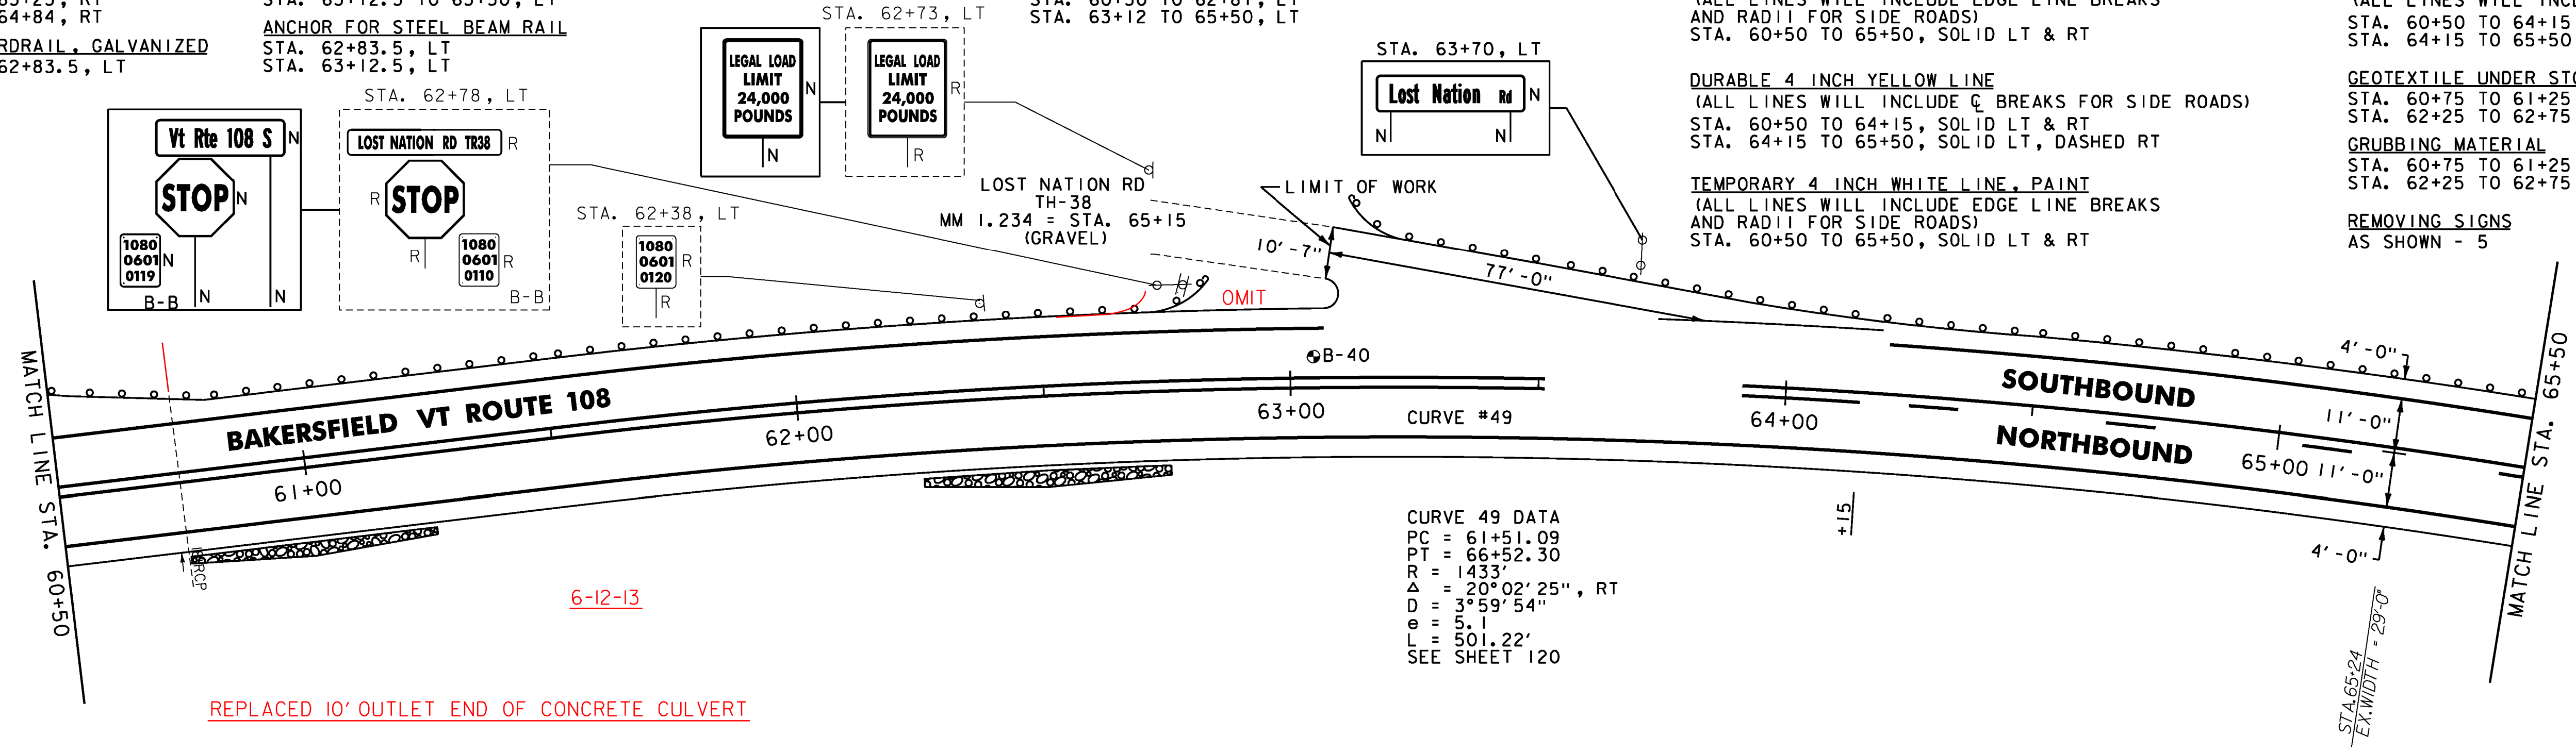

CURVE 49 DATA
PC = 61+51.09
PT = 66+52.30
R = 1433'
 $\Delta = 20^{\circ}02'25''$, RT
D = 3°59'54"
e = 5.1
L = 501.22'
SEE SHEET 120

REPLACED 10' OUTLET END OF CONCRETE CULVERT

NOTES:

- FOR LEGENDS, SEE SHEET 27.
- ALL EXISTING SIGNS NOT SHOWN SHALL BE RETAINED.
- DURABLE MARKINGS DETAILED ON THIS SHEET ARE OPTION BID ITEMS. SEE SHEET 14.

SOIL BORING DATA			
BORING#	DEPTH (FT.)	PCC	COMMENTS
B-40	5.0'	NO	



NOT TO SCALE

PROJECT LAYOUT SHEET #42

PROJECT NAME: CAMBRIDGE-BAKERSFIELD

PROJECT NUMBER: STP 2926(I)

FILE NAME: p10b258.dgn

PROJECT LEADER: JLL

DESIGNED BY: STANTEC

IPARM FILE: p10b258142.i

PLOT DATE: 11/15/2012

DRAWN BY: STANTEC

CHECKED BY: STANTEC

SHEET 68 OF 387