

THINNING AND TRIMMING FOR SIGNS
STA. 168+96, RT

DURABLE 4 INCH WHITE LINE
(ALL LINES WILL INCLUDE EDGE LINE BREAKS AND RADII FOR SIDE ROADS)
STA. 165+50 TO 170+50, SOLID LT & RT

DURABLE 4 INCH YELLOW LINE
(ALL LINES WILL INCLUDE C BREAKS FOR SIDE ROADS)
STA. 165+50 TO 166+32, DASHED C
STA. 166+32 TO 170+50, DASHED LT, SOLID RT

DURABLE 8 INCH WHITE LINE
STA. 170+21 TO 170+33, RT (HYDRANT)
(SEE DETAIL ON SHEET 25)

TEMPORARY 4 INCH WHITE LINE, PAINT
(ALL LINES WILL INCLUDE EDGE LINE BREAKS AND RADII FOR SIDE ROADS)
STA. 165+50 TO 170+50, SOLID LT & RT


TEMPORARY 4 INCH YELLOW LINE, PAINT
(ALL LINES WILL INCLUDE C BREAKS FOR SIDE ROADS)
STA. 165+50 TO 166+32, DASHED C
STA. 166+32 TO 170+50, DASHED LT, SOLID RT

TEMPORARY 8 INCH WHITE LINE, PAINT
STA. 170+21 TO 170+33, RT (HYDRANT)
(SEE DETAIL ON SHEET 25)

REMOVING SIGNS
AS SHOWN - 4

JD-46 STA 169+00 TO 174+00, LT
CONSTRUCT 6 INCH UNDERDRAIN PIPE,
SEE SHEETS 18 & 19 FOR DETAIL AND
ASSOCIATED QUANTITIES.

INSTALLED 15" CPEP 29' 8-20-13

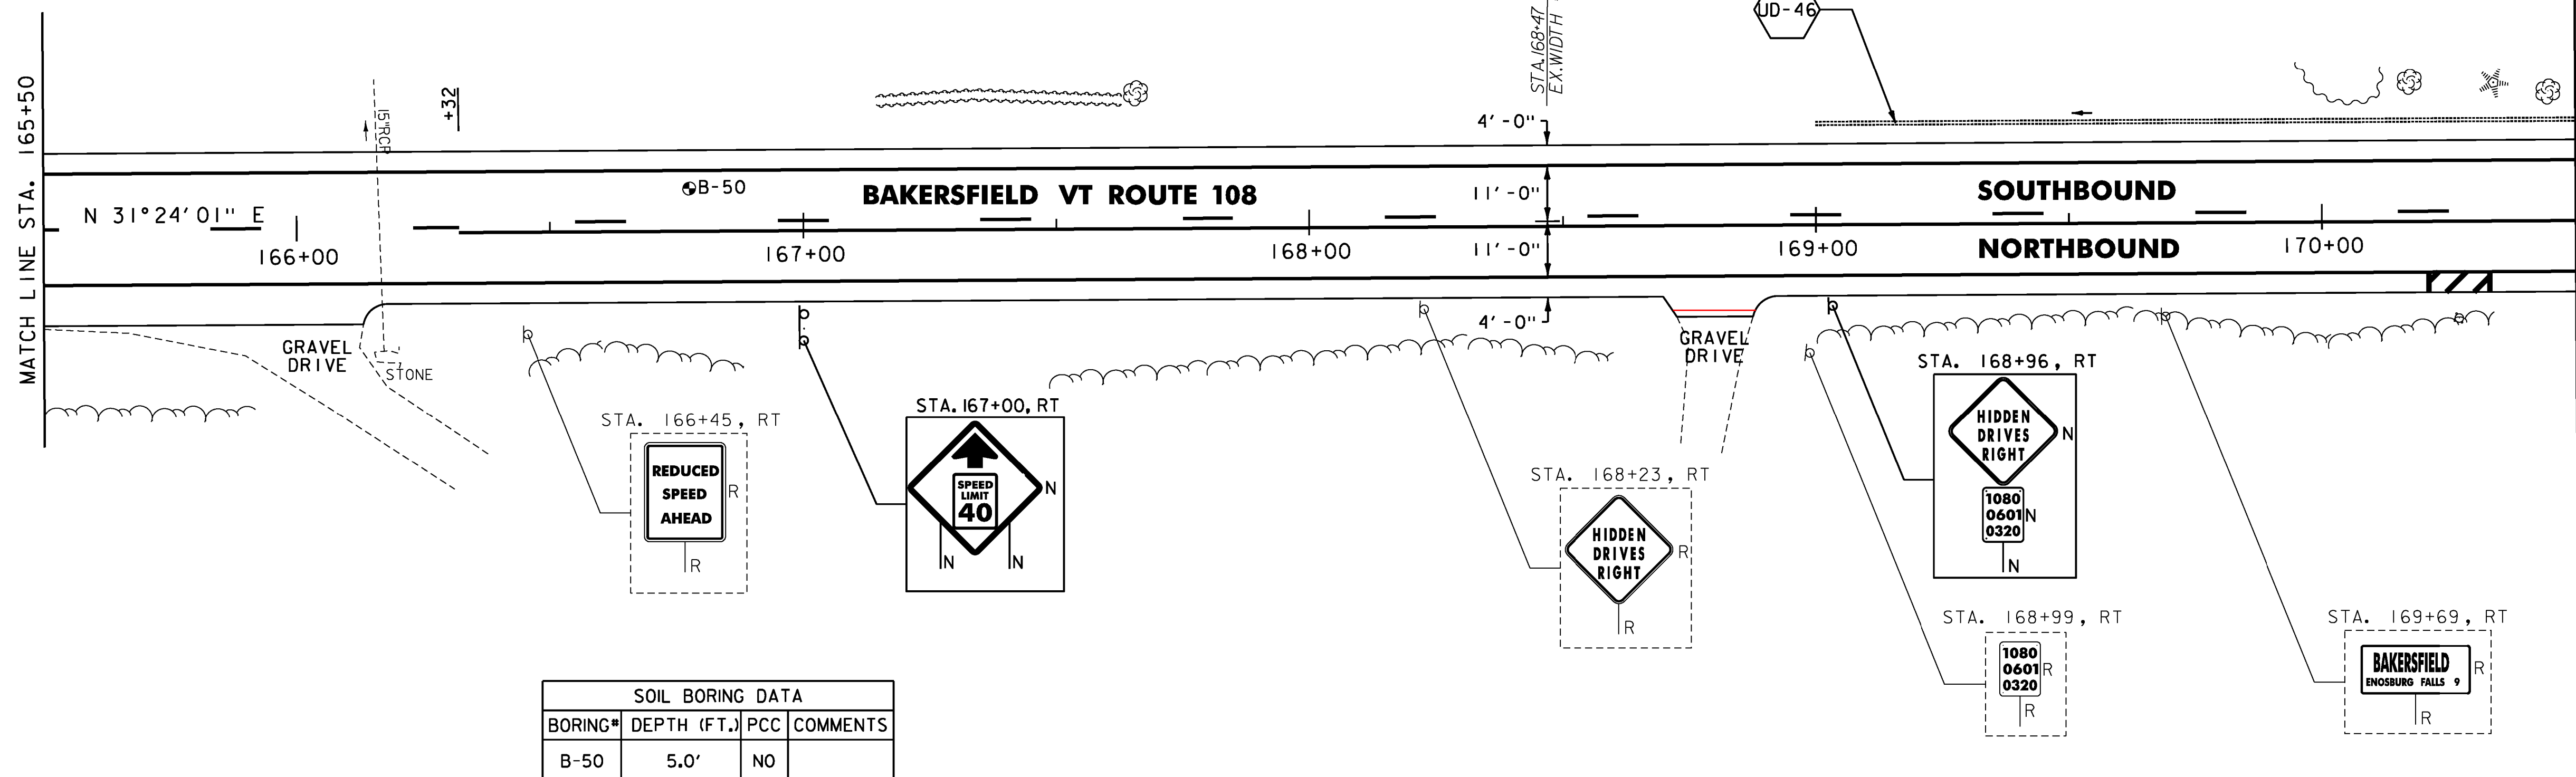

SOIL BORING DATA			
BORING#	DEPTH (FT.)	PCC	COMMENTS
B-50	5.0'	NO	

RELOCATE MAILBOX, SINGLE SUPPORT
STA. 172+34, RT


DURABLE 4 INCH WHITE LINE
(ALL LINES WILL INCLUDE EDGE LINE BREAKS AND RADII FOR SIDE ROADS)
STA. 170+50 TO 175+50, SOLID LT & RT

DURABLE 4 INCH YELLOW LINE
(ALL LINES WILL INCLUDE C BREAKS FOR SIDE ROADS)
STA. 170+50 TO 173+45, DASHED LT, SOLID RT
STA. 173+45 TO 175+50, SOLID LT & RT

TEMPORARY 4 INCH WHITE LINE, PAINT
(ALL LINES WILL INCLUDE EDGE LINE BREAKS AND RADII FOR SIDE ROADS)
STA. 170+50 TO 175+50, SOLID LT & RT

TEMPORARY 4 INCH YELLOW LINE, PAINT
(ALL LINES WILL INCLUDE C BREAKS FOR SIDE ROADS)
STA. 170+50 TO 173+45, DASHED LT, SOLID RT
STA. 173+45 TO 175+50, SOLID LT & RT

REMOVING SIGNS
AS SHOWN - 2

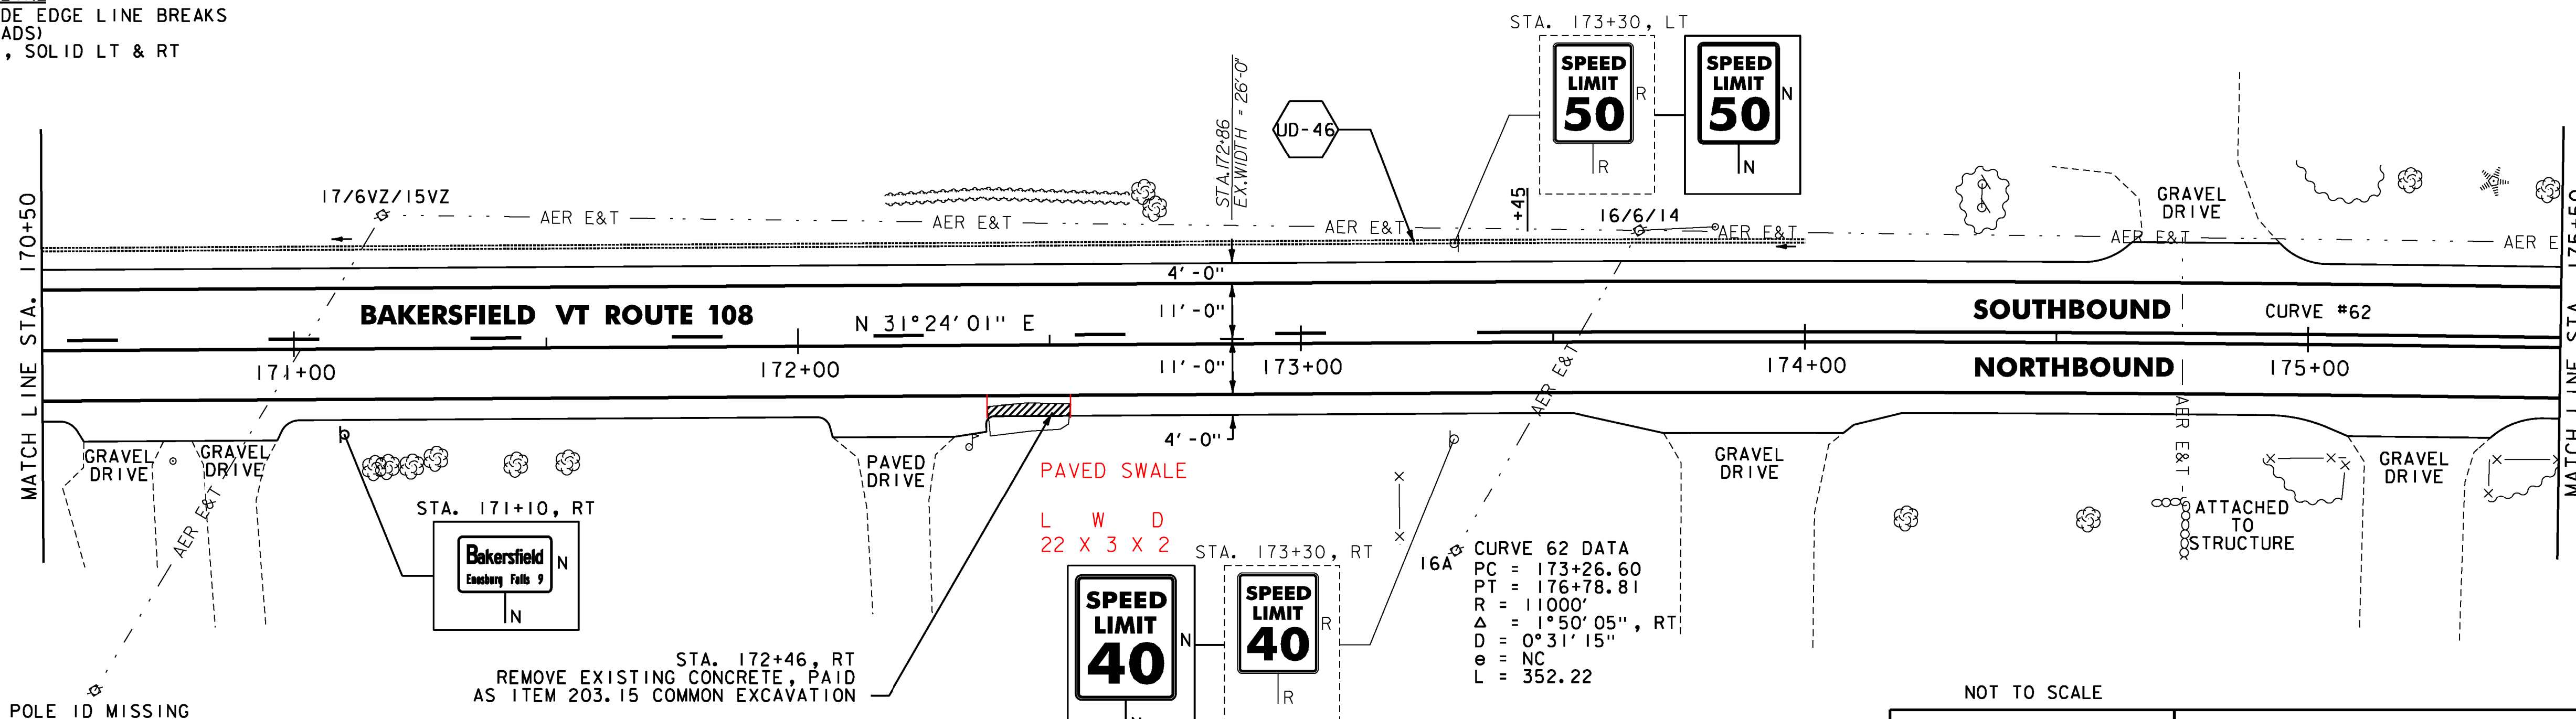

CURVE 62 DATA	
PC	= 173+26.60
PT	= 176+78.81
R	= 11000'
Δ	= 1°50'05", RT
D	= 0°31'15"
e	= NC
L	= 352.22

- NOTES:
- FOR LEGENDS, SEE SHEET 27.
 - ALL EXISTING SIGNS NOT SHOWN SHALL BE RETAINED.
 - DURABLE MARKINGS DETAILED ON THIS SHEET ARE OPTION BID ITEMS. SEE SHEET 14.

NOT TO SCALE

PROJECT LAYOUT SHEET #53



PROJECT NAME: CAMBRIDGE-BAKERSFIELD

PROJECT NUMBER: STP 2926(I)

FILE NAME: p10b258.dgn

PROJECT LEADER: JLL

DESIGNED BY: STANTEC

IPARM FILE: p10b258153.i

PLOT DATE: 11/15/2012

DRAWN BY: STANTEC

CHECKED BY: STANTEC

SHEET 79 OF 387