

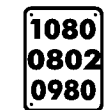




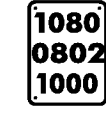





# TRAFFIC SIGN SUMMARY SHEET 04

MILEMARKER, STATION, OR SIGN NUMBER	SIGN LEGEND	SIGN DIMENSIONS		NEW & SALVAGED SIGNS				EXIST POST RETAIN	NO. OF POSTS	NEW SIGN POSTS																REMARKS	SIGN DETAIL					
				"A"	"B"	SALV SIGN	SALV TIS			FLANGED CHANNEL			SQUARE STEEL (in)				TUBULAR ALUMINUM Ø (in)			TUBULAR STEEL Ø (in)				W-SHAPE STEEL			DETAIL IN SHSM BOOK	DETAIL ON SHEET NUMBER	STD. SHEET NUMBER			
		EA	WIDTH (in)							HEIGHT (in)	1.75	2.0	2.5	ANCHOR	SLEEVE	3.0	4.0	4.0 MOD	FOUND-ATION	3.0	3.5	4.0	5.0	FTG. SIZE						WEIGHT	POST SIZE	REQUIRE FRAME
					lb/ft	lb/ft	lb/ft															24"	30"									
CAMBRIDGE CONT.																																
514+00, RT	 	I	30	30	6.25				I																				WI-5	X		
		I	18	18	2.25																								WI3-IP	X		
517+44, RT		I	6	10	0.42				I		X																		VD-700			E-138
523+48, RT		I	30	30	6.25				I				X																WII-10	X		
525+96, RT		I	30	30	6.25				I				X																WII-6H INSTALL IN CLOSED POSITION (TYP.)			E-153
527+02, RT		I	6	8	0.33				I		X																		VD-701			E-134
527+35, LT		I	6	8	0.33				I		X																		VD-701			E-134
528+00, LT		I	6	10	0.42				I		X																		VD-700			E-138
533+00, LT		I	30	30	6.25				I			X																	WII-6H INSTALL IN CLOSED POSITION (TYP.)			E-153
534+92, LT		I	30	30	6.25				I			X																	WII-10	X		
537+00, LT		I	30	30	6.25				I		X																		WI-5	X		

*SHSM*-STANDARD HIGHWAY SIGNS AND MARKINGS										FT	FT	FT	FT	FT	FT	EA	LB	LB	LB	LB	EA	EA	LB	<p><b>TRAFFIC SIGN SUMMARY SHEET #4</b></p> <p>PROJECT NAME: CAMBRIDGE-BAKERSFIELD PROJECT NUMBER: STP 2926(I) FILE NAME: p10b258.dgn PROJECT LEADER: JLL DESIGNED BY: STANTEC IPARM FILE: p10b258tss04.i</p> <p>PLOT DATE: 11/15/2012 DRAWN BY: STANTEC CHECKED BY: STANTEC SHEET 84 OF 387</p>
FINAL POST LENGTHS ARE TO BE DETERMINED IN THE FIELD. POST SIZES ARE COMPUTED BASED ON INFORMATION FURNISHED ON THE STANDARD SHEETS AND THE VTRANS "SIGN POST DESIGN GUIDELINE."										50		50		60		EA		LB		EA		LB		
<b>TOTALS</b>										41.25		160												