


STA. 521+50.00 TO STA. 523+00.00

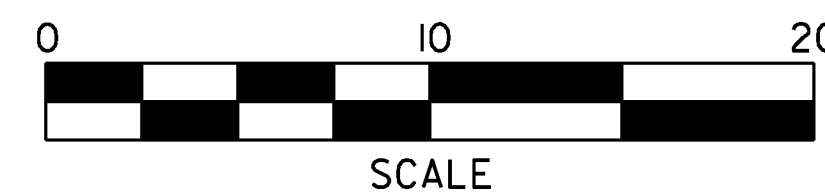

**CAMBRIDGE  
 CROSS  
 SECTIONS  
 SHEET #12**

PROJECT NAME: CAMBRIDGE-BAKERSFIELD  
 PROJECT NUMBER: STP 2926(I)

FILE NAME: p10b258.dgn  
 PROJECT LEADER: JLL  
 DESIGNED BY: STANTEC  
 IPARM FILE: p10b258xs12.i

PLOT DATE: 11/15/2012  
 DRAWN BY: STANTEC  
 CHECKED BY: STANTEC  
 SHEET 147 OF 387