


STA. 525+50.00 TO STA. 527+00.00

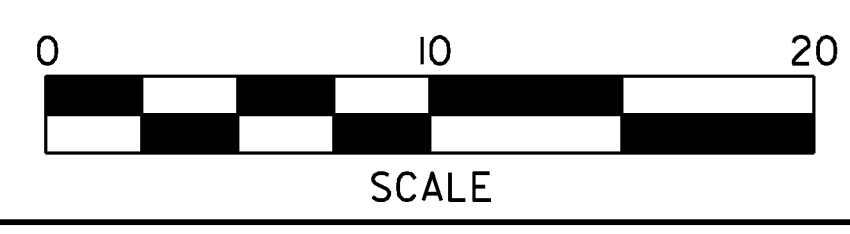

**CAMBRIDGE  
CROSS  
SECTIONS  
SHEET #14**

PROJECT NAME: CAMBRIDGE-BAKERSFIELD	PLOT DATE: 11/15/2012
PROJECT NUMBER: STP 2926(1)	DRAWN BY: STANTEC
FILE NAME: p10b258.dgn	CHECKED BY: STANTEC
DESIGNED BY: STANTEC	SHEET 149 OF 387
IPARM FILE: p10b258xs14.i	