


STA. 547+50.00 TO STA. 549+00.00

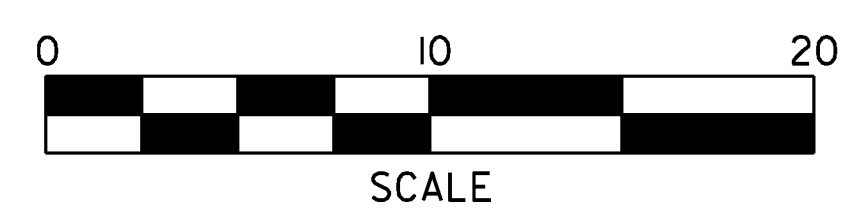

**CAMBRIDGE
CROSS
SECTIONS
SHEET #23**

PROJECT NAME:	CAMBRIDGE-BAKERSFIELD
PROJECT NUMBER:	STP 2926(I)
FILE NAME:	p10b258.dgn
PROJECT LEADER:	JLL
DESIGNED BY:	STANTEC
IPARM FILE:	p10b258xs23.i
PLOT DATE:	11/15/2012
DRAWN BY:	STANTEC
CHECKED BY:	STANTEC
SHEET	158 OF 387