


STA. 561+50.00 TO STA. 563+50.00

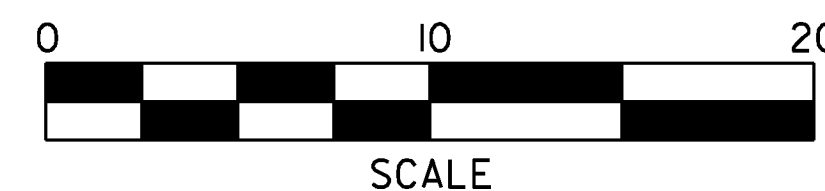

**CAMBRIDGE  
CROSS  
SECTIONS  
SHEET #29**

PROJECT NAME: CAMBRIDGE-BAKERSFIELD  
PROJECT NUMBER: STP 2926(1)

FILE NAME: p10b258.dgn  
PROJECT LEADER: JLL  
DESIGNED BY: STANTEC  
IPARM FILE: p10b258xs29.i

PLOT DATE: 11/15/2012  
DRAWN BY: STANTEC  
CHECKED BY: STANTEC  
SHEET 164 OF 387