


STA. 575+00.00 TO STA. 576+50.00

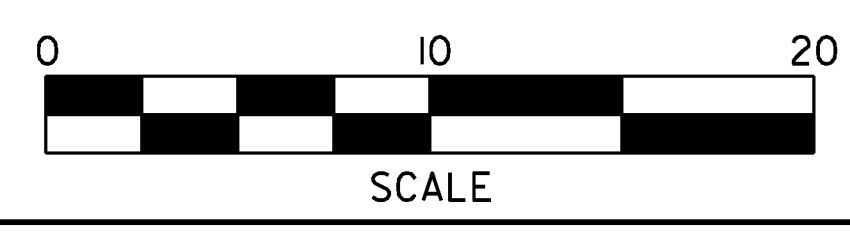

**CAMBRIDGE  
CROSS  
SECTIONS  
SHEET #35**

|                                     |                       |
|-------------------------------------|-----------------------|
| PROJECT NAME: CAMBRIDGE-BAKERSFIELD | PLOT DATE: 11/15/2012 |
| PROJECT NUMBER: STP 2926(I)         | DRAWN BY: STANTEC     |
| FILE NAME: p10b258.dgn              | CHECKED BY: STANTEC   |
| DESIGNED BY: STANTEC                | SHEET 170 OF 387      |
| IPARM FILE: p10b258xs35.i           |                       |