


STA. 586+50.00 TO STA. 589+00.00

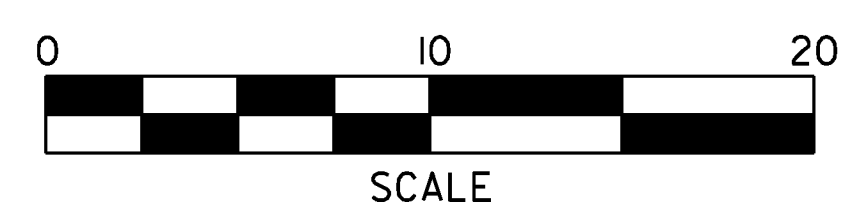

**CAMBRIDGE
CROSS
SECTIONS
SHEET #40**

PROJECT NAME: CAMBRIDGE-BAKERSFIELD	PLOT DATE: 11/15/2012
PROJECT NUMBER: STP 2926(1)	DRAWN BY: STANTEC
FILE NAME: p10b258.dgn	CHECKED BY: STANTEC
PROJECT LEADER: JLL	SHEET 175 OF 387
DESIGNED BY: STANTEC	
IPARM FILE: p10b258xs40.i	