


STA. 592+00.00 TO STA. 594+50.00

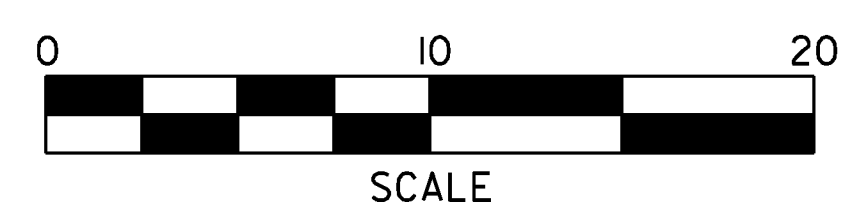

**CAMBRIDGE
CROSS
SECTIONS
SHEET #42**

PROJECT NAME: CAMBRIDGE-BAKERSFIELD	PLOT DATE: 11/15/2012
PROJECT NUMBER: STP 2926(1)	DRAWN BY: STANTEC
FILE NAME: p10b258.dgn	CHECKED BY: STANTEC
PROJECT LEADER: JLL	SHEET 177 OF 387
DESIGNED BY: STANTEC	
IPARM FILE: p10b258xs42.i	