


STA. 616+00.00 TO STA. 617+50.00

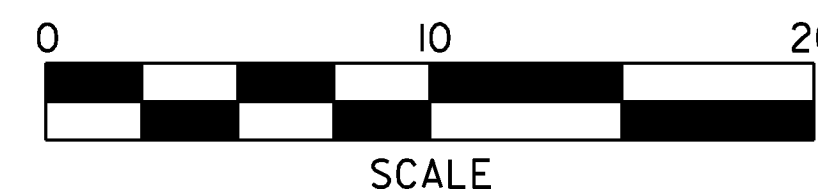

**CAMBRIDGE  
CROSS  
SECTIONS  
SHEET #52**

PROJECT NAME: CAMBRIDGE-BAKERSFIELD  
PROJECT NUMBER: STP 2926(I)

FILE NAME: p10b258.dgn  
PROJECT LEADER: JLL  
DESIGNED BY: STANTEC  
IPARM FILE: p10b258xs52.i

PLOT DATE: 11/15/2012  
DRAWN BY: STANTEC  
CHECKED BY: STANTEC  
SHEET 187 OF 387