


STA. 645+50.00 TO STA. 647+00.00

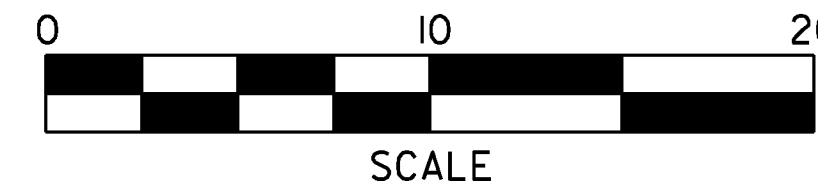

**CAMBRIDGE
 CROSS
 SECTIONS
 SHEET #65**

PROJECT NAME: CAMBRIDGE-BAKERSFIELD	PLOT DATE: 11/15/2012
PROJECT NUMBER: STP 2926(1)	DRAWN BY: STANTEC
FILE NAME: p10b258.dgn	CHECKED BY: STANTEC
DESIGNED BY: STANTEC	SHEET 200 OF 387
IPARM FILE: p10b258xs65.i	