


STA. 661+50.00 TO STA. 663+00.00

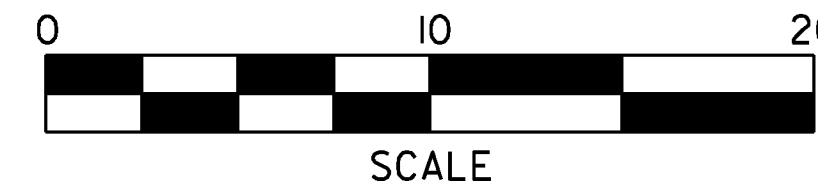

**CAMBRIDGE
CROSS
SECTIONS
SHEET #72**

| | |
|-------------------------------------|-----------------------|
| PROJECT NAME: CAMBRIDGE-BAKERSFIELD | PLOT DATE: 11/15/2012 |
| PROJECT NUMBER: STP 2926(1) | DRAWN BY: STANTEC |
| FILE NAME: p10b258.dgn | CHECKED BY: STANTEC |
| PROJECT LEADER: JLL | SHEET 207 OF 387 |
| DESIGNED BY: STANTEC | |
| IPARM FILE: p10b258xs72.i | |