


STA. 674+00.00 TO STA. 676+00.00

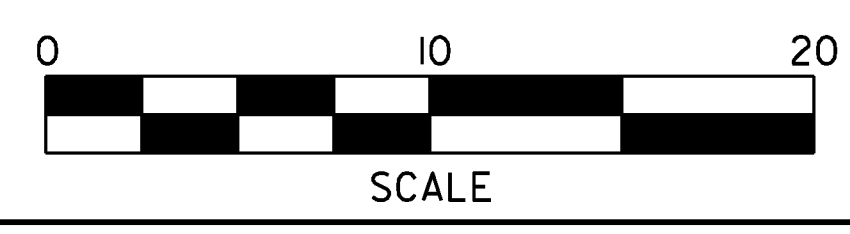

**CAMBRIDGE
CROSS
SECTIONS
SHEET #78**

PROJECT NAME: CAMBRIDGE-BAKERSFIELD	PLOT DATE: 11/15/2012
PROJECT NUMBER: STP 2926(I)	DRAWN BY: STANTEC
FILE NAME: p10b258.dgn	CHECKED BY: STANTEC
PROJECT LEADER: JLL	SHEET 213 OF 387
DESIGNED BY: STANTEC	
IPARM FILE: p10b258xs78.i	