


STA. 693+50.00

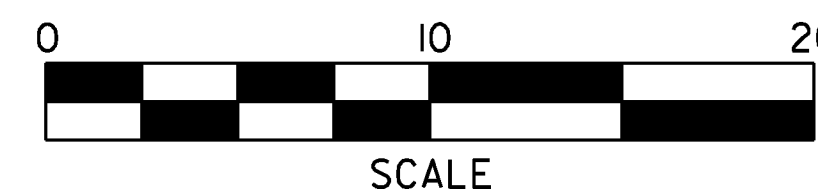

**CAMBRIDGE
CROSS
SECTIONS
SHEET #87**

PROJECT NAME: CAMBRIDGE-BAKERSFIELD	PLOT DATE: 11/15/2012
PROJECT NUMBER: STP 2926(1)	DRAWN BY: STANTEC
FILE NAME: p10b258.dgn	CHECKED BY: STANTEC
DESIGNED BY: STANTEC	SHEET 222 OF 387
IPARM FILE: p10b258xs87.i	