


STA. 3+00.00 TO STA. 5+50.00

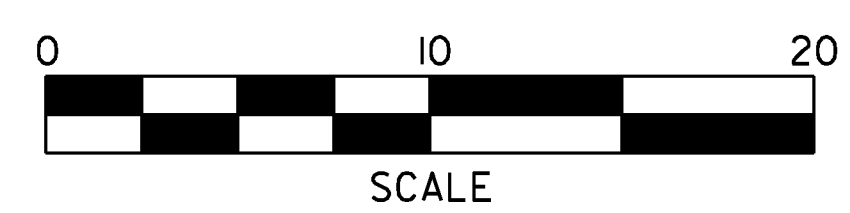

**FLETCHER  
CROSS  
SECTIONS  
SHEET #2**

PROJECT NAME:	CAMBRIDGE-BAKERSFIELD
PROJECT NUMBER:	STP 2926(1)
FILE NAME:	p10b258.dgn
PROJECT LEADER:	JLL
DESIGNED BY:	STANTEC
IPARM FILE:	p10b258xs02.i
PLOT DATE:	11/15/2012
DRAWN BY:	STANTEC
CHECKED BY:	STANTEC
SHEET	224 OF 387