


STA. 6+00.00 TO STA. 8+50.00

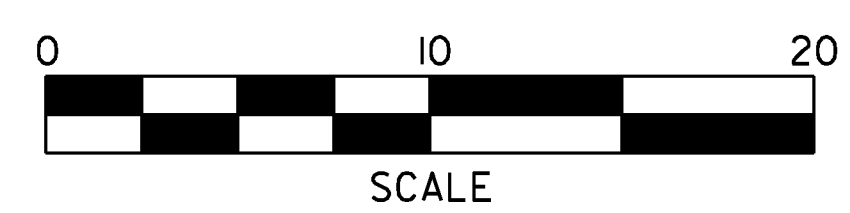

**FLETCHER
CROSS
SECTIONS
SHEET #3**

PROJECT NAME: CAMBRIDGE-BAKERSFIELD	PLOT DATE: 11/15/2012
PROJECT NUMBER: STP 2926(I)	DRAWN BY: STANTEC
FILE NAME: p10b258.dgn	CHECKED BY: STANTEC
PROJECT LEADER: JLL	SHEET 225 OF 387
DESIGNED BY: STANTEC	
IPARM FILE: p10b258xs03.i	